


PLAN	SURVEYED	DATE
	NOTED	BY
	ALIGNED CHECKED	
	BY	

PROFILE	SURVEYED	DATE
	NOTED	BY
	STRUCTURE NOTATIONS	
	BY	



RECORD DRAWING

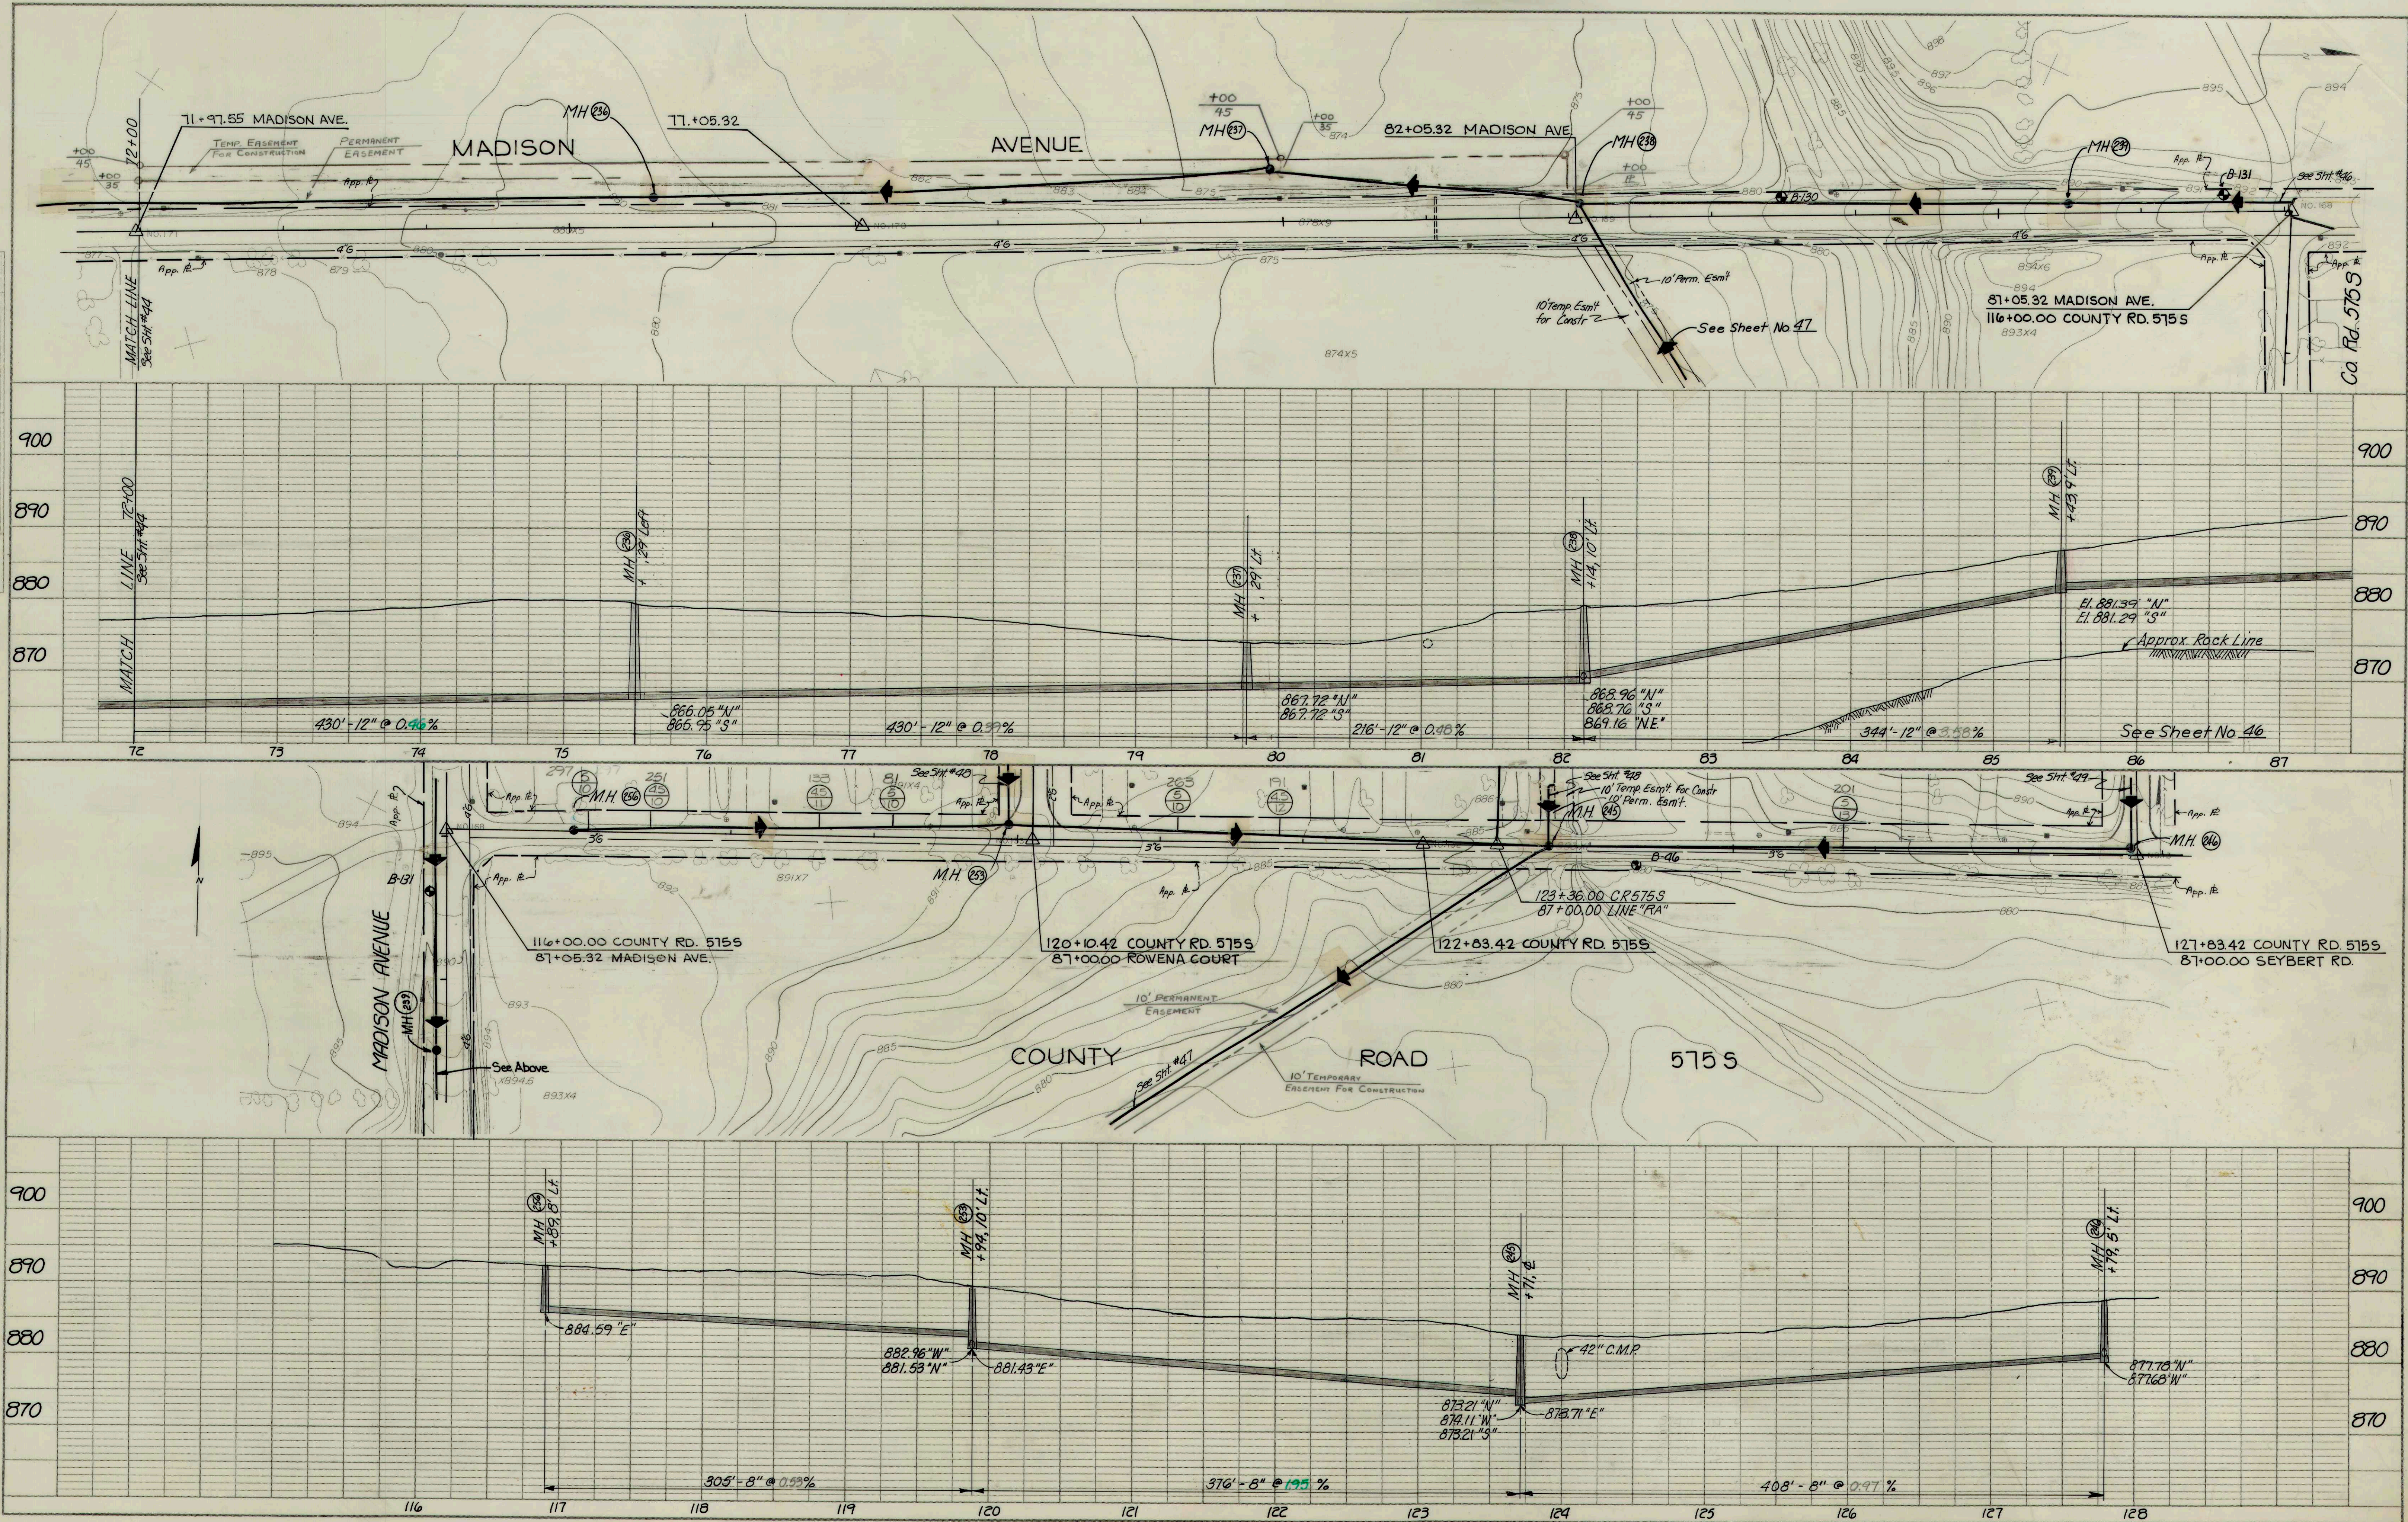

MADISON AVE / Co. Rd. 575S	
FALL CREEK R.W.D. PLAN & PROFILE	SHEET
HORIZ. 1"=50'	BEAM, LONGEST & NEFF, INC.
VERT. 1"=10'	CONSULTING ENGINEERS
	INDIANAPOLIS, INDIANA
	45