

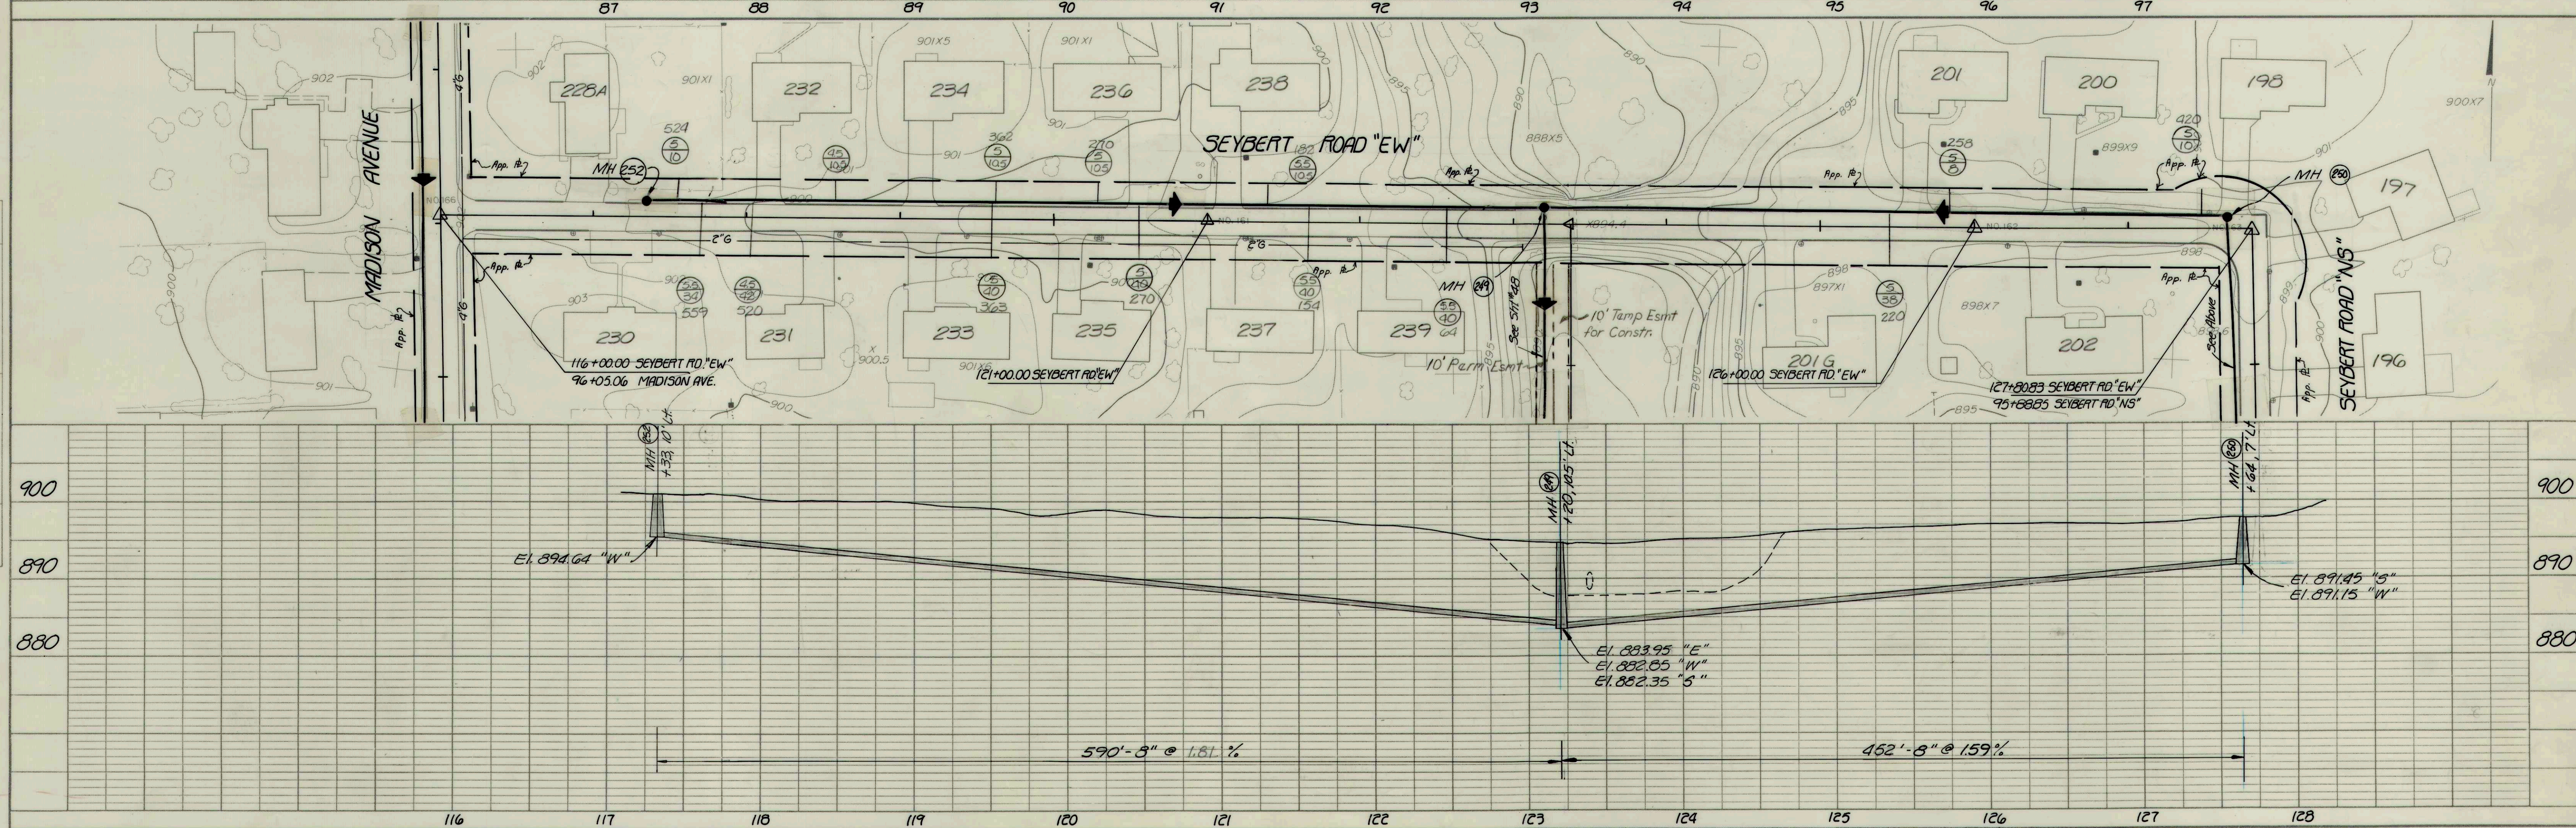


PLAN	SURVEYED	DATE
	PLOTTED	BY
	NOTE BOOK	ALIGNED CHECKED
	NO.	REL. OF WAY CHECKED

PROFILE	SURVEYED	DATE
	PLOTTED	BY
	NOTE BOOK	GRADES CHECKED
	NO.	STRUCTURE NOTATION CHECKED

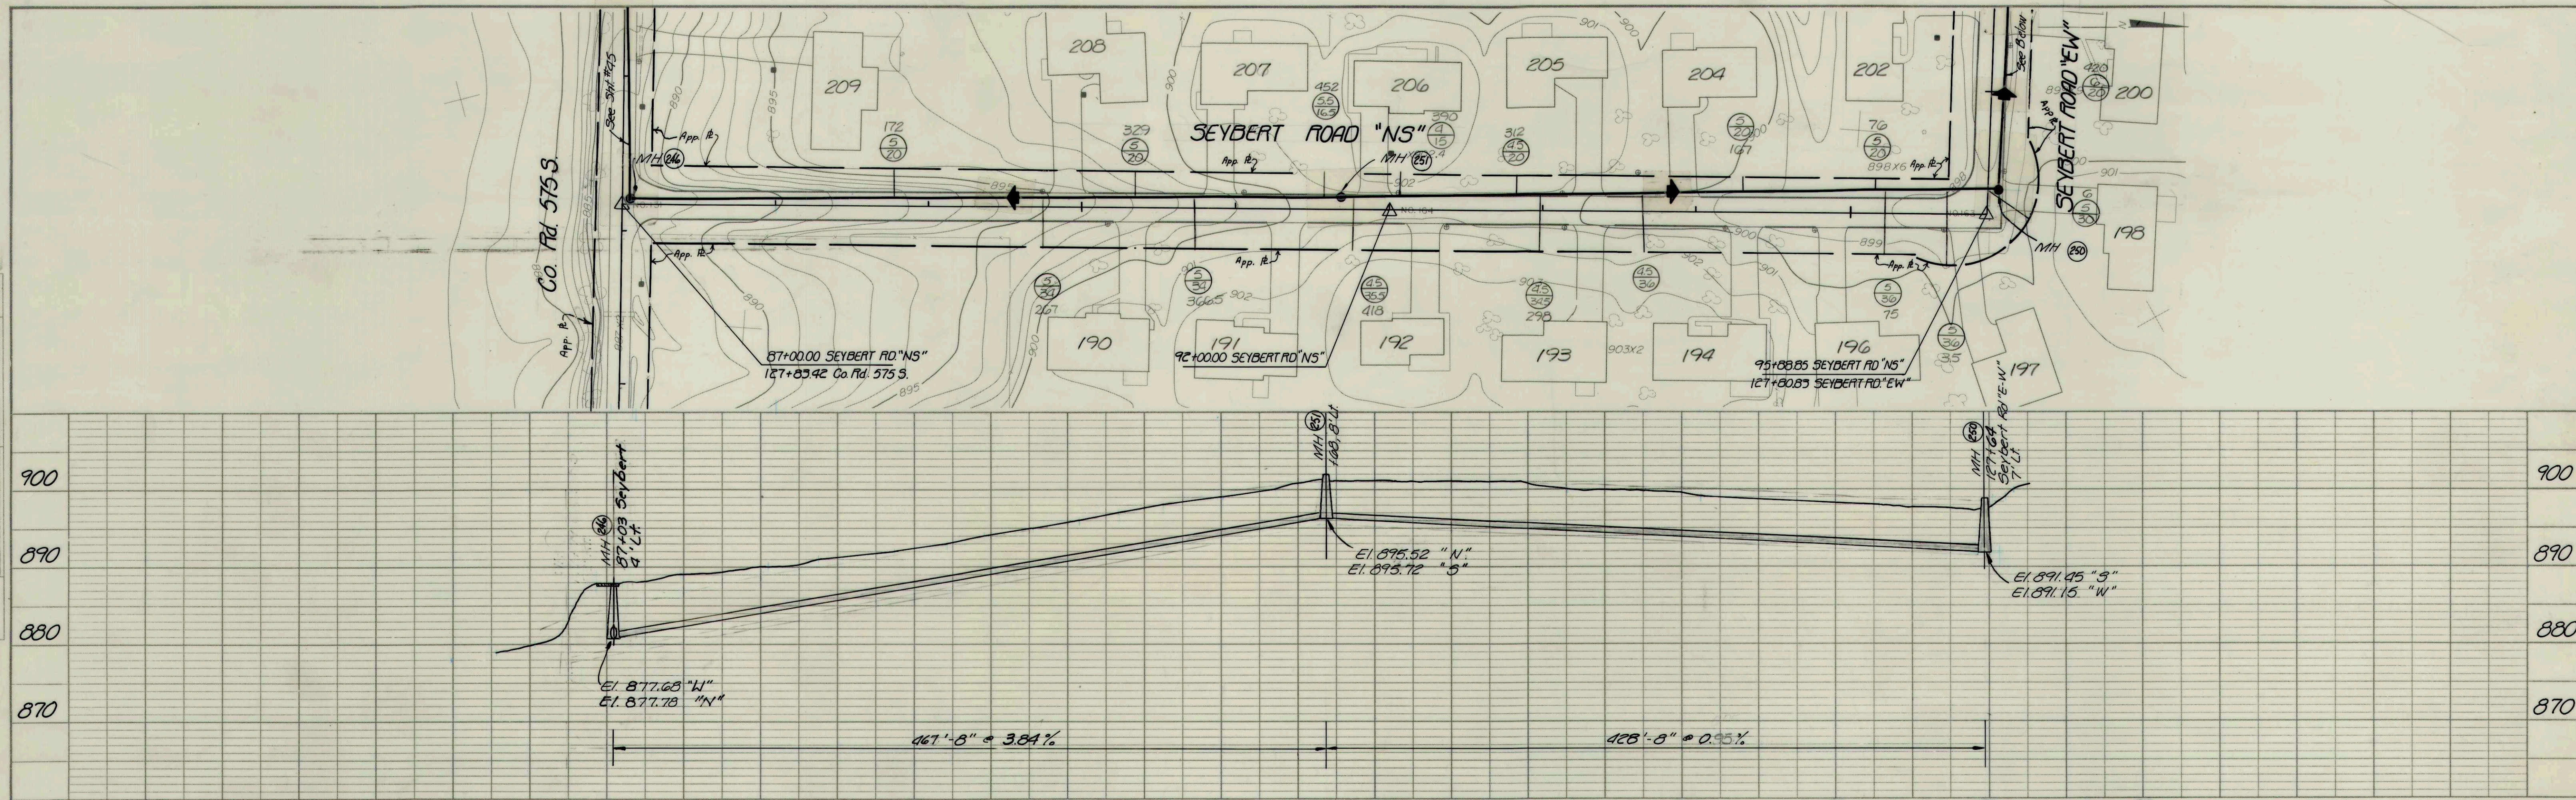

RECORD DRAWING

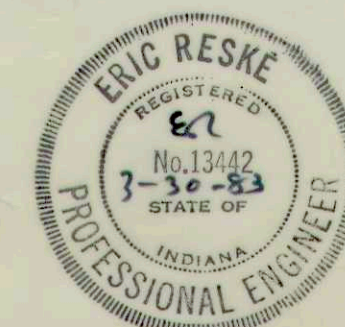

SEYBERT ROAD "NS" & "EW"	
FALL CREEK R.W.D. PLAN & PROFILE SHEET	
HORIZ. 1"=50'	BEAM, LONGEST & NEFF, INC.
VERT. 1"=10'	CONSULTING ENGINEERS
	INDIANAPOLIS, INDIANA
	49