

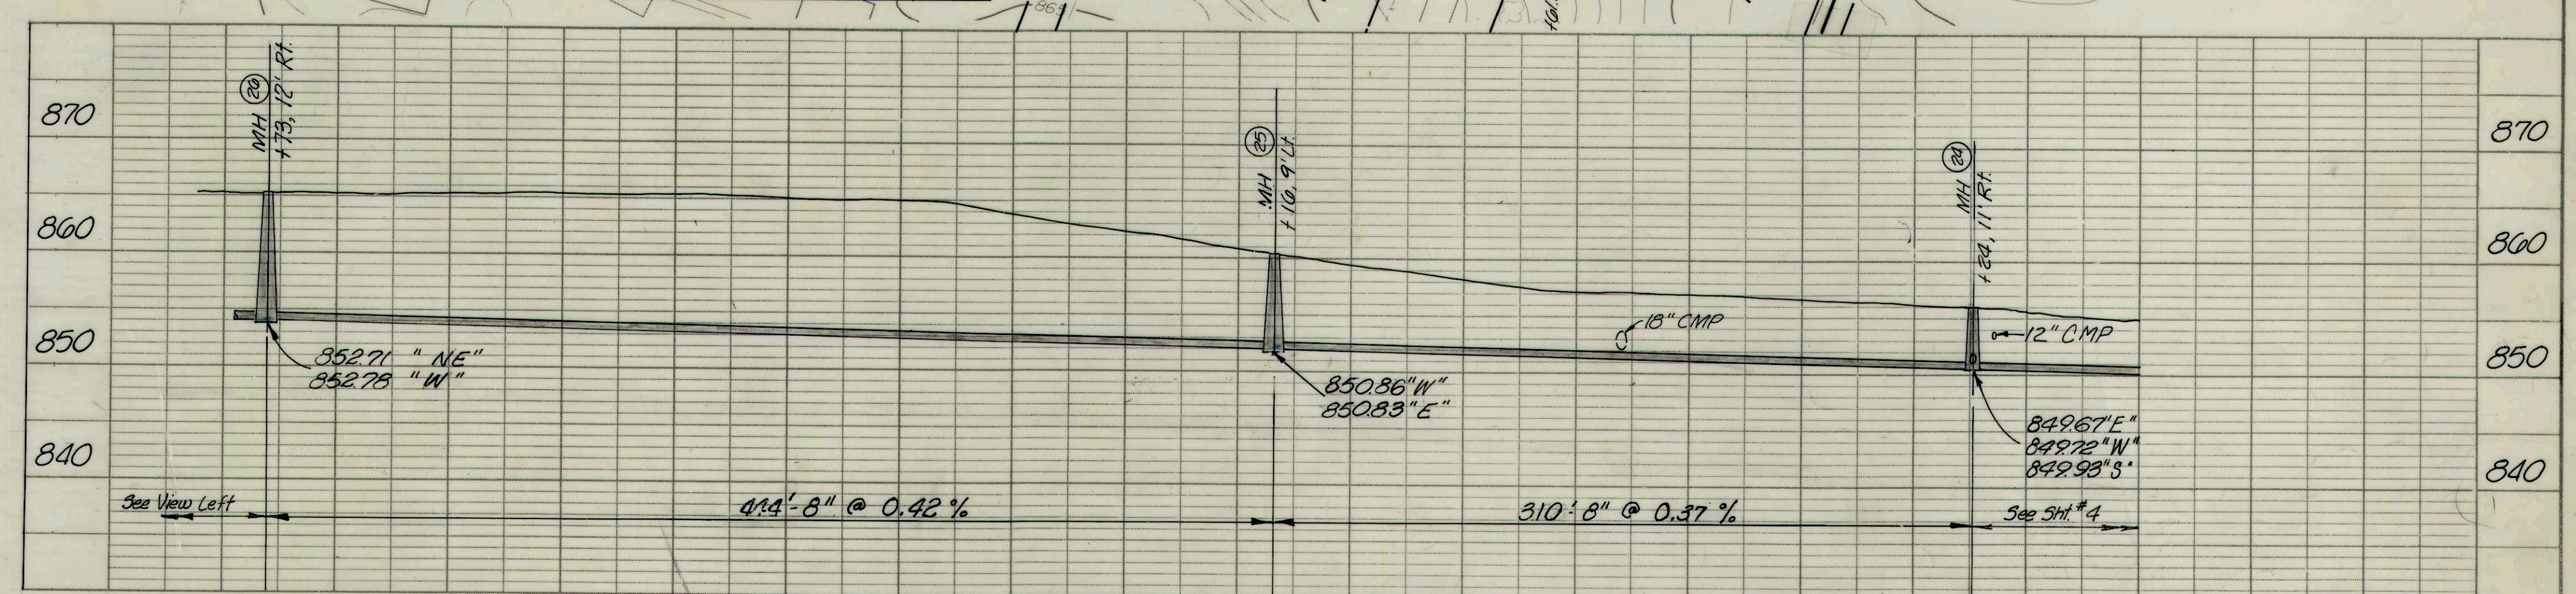
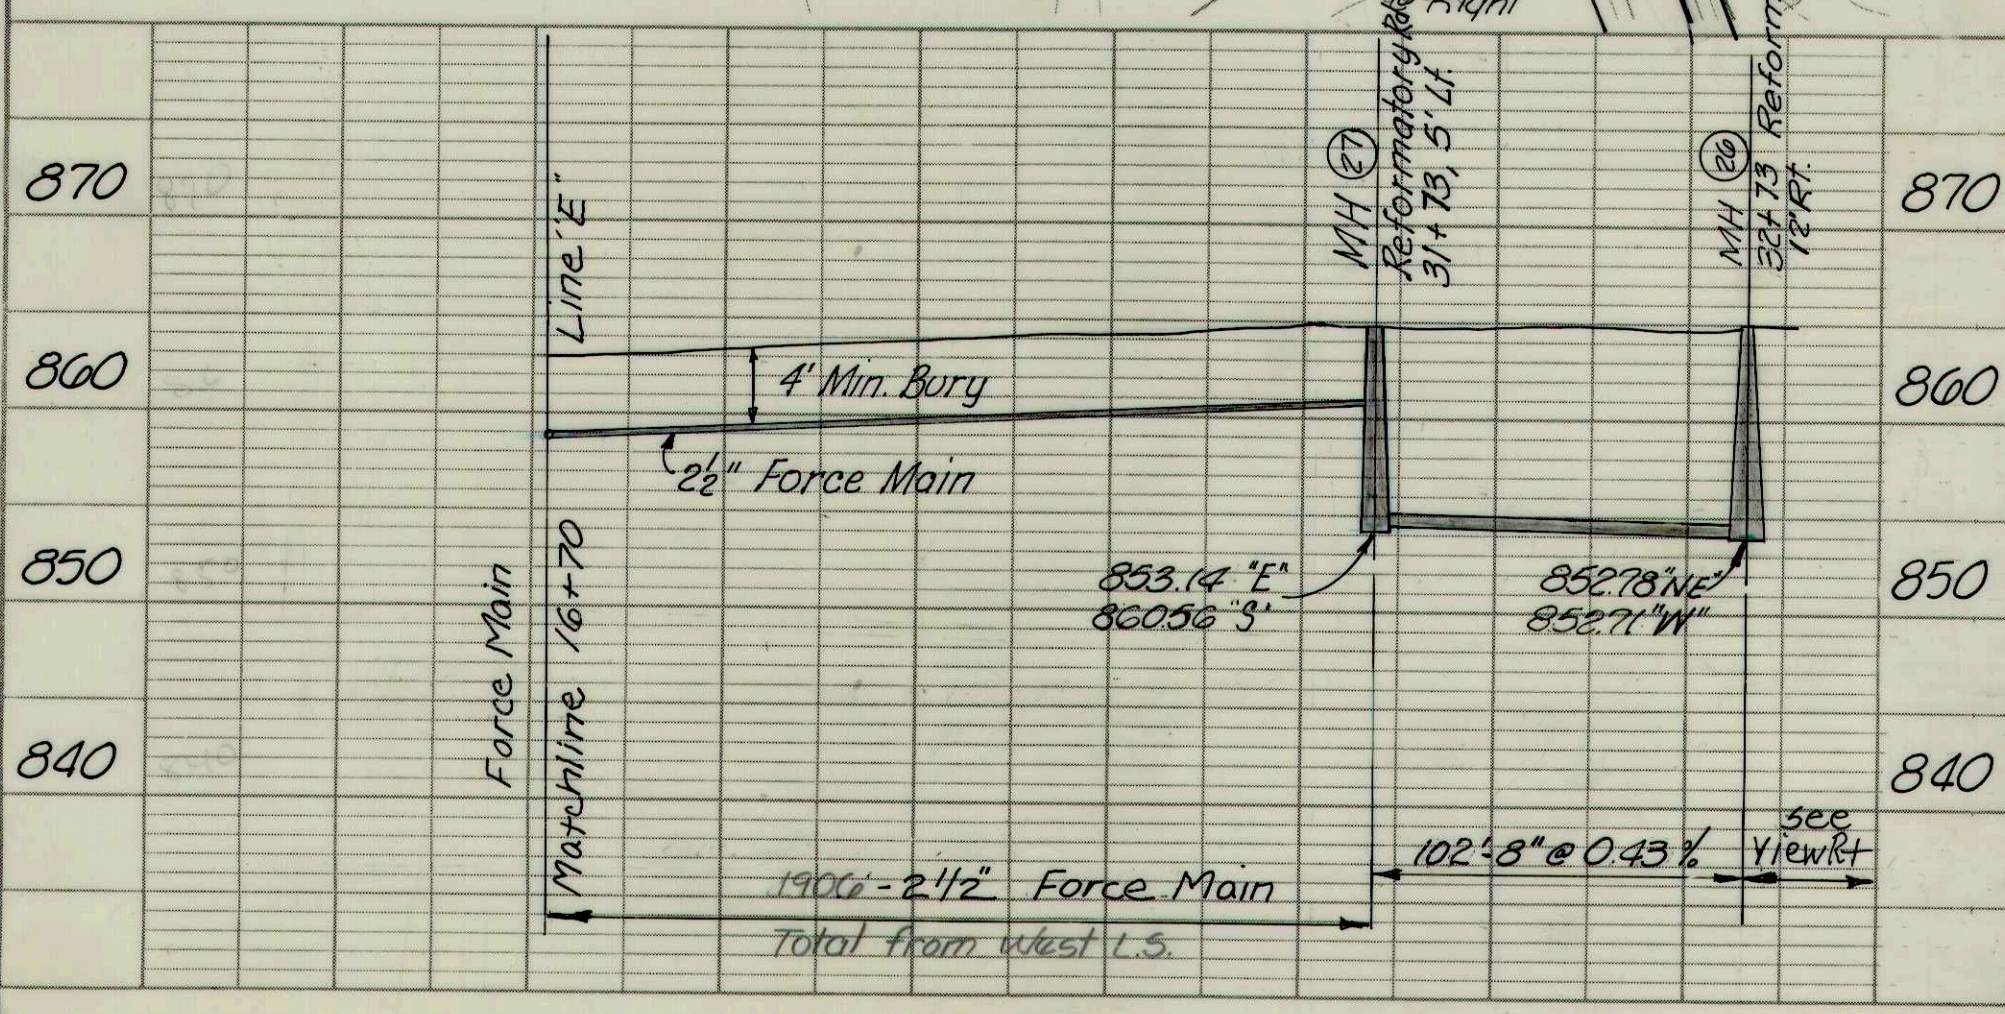
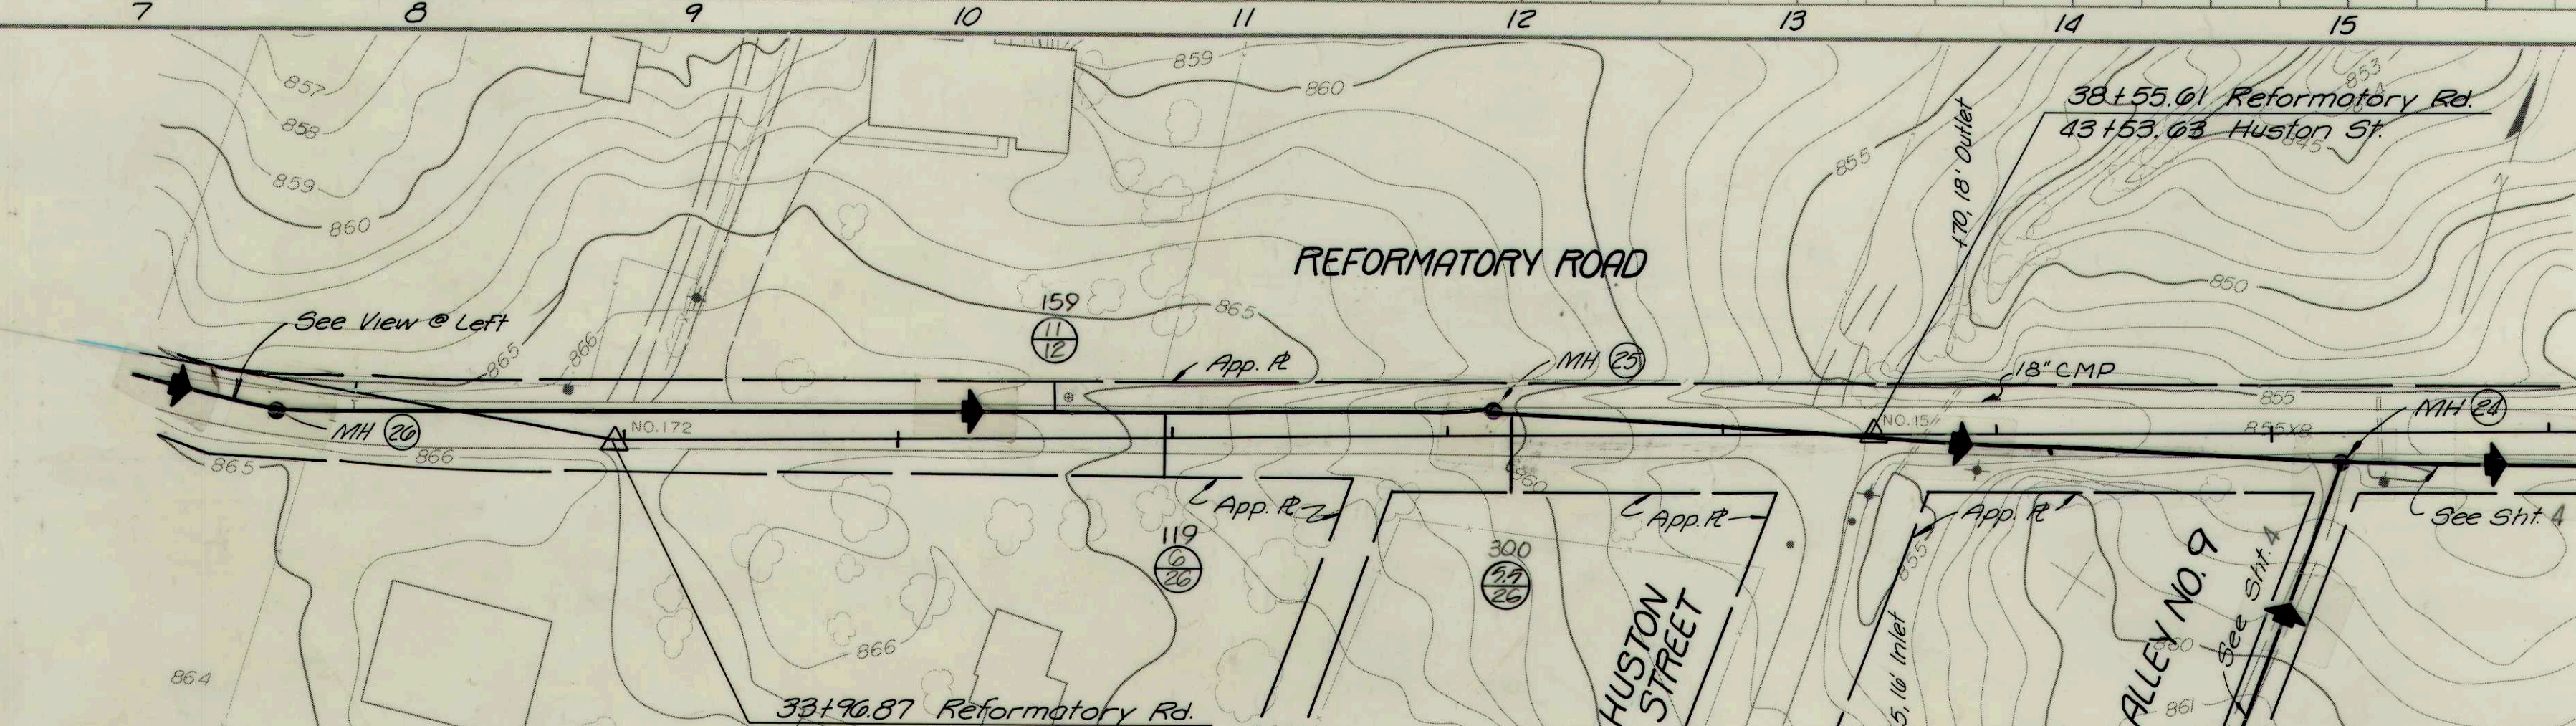
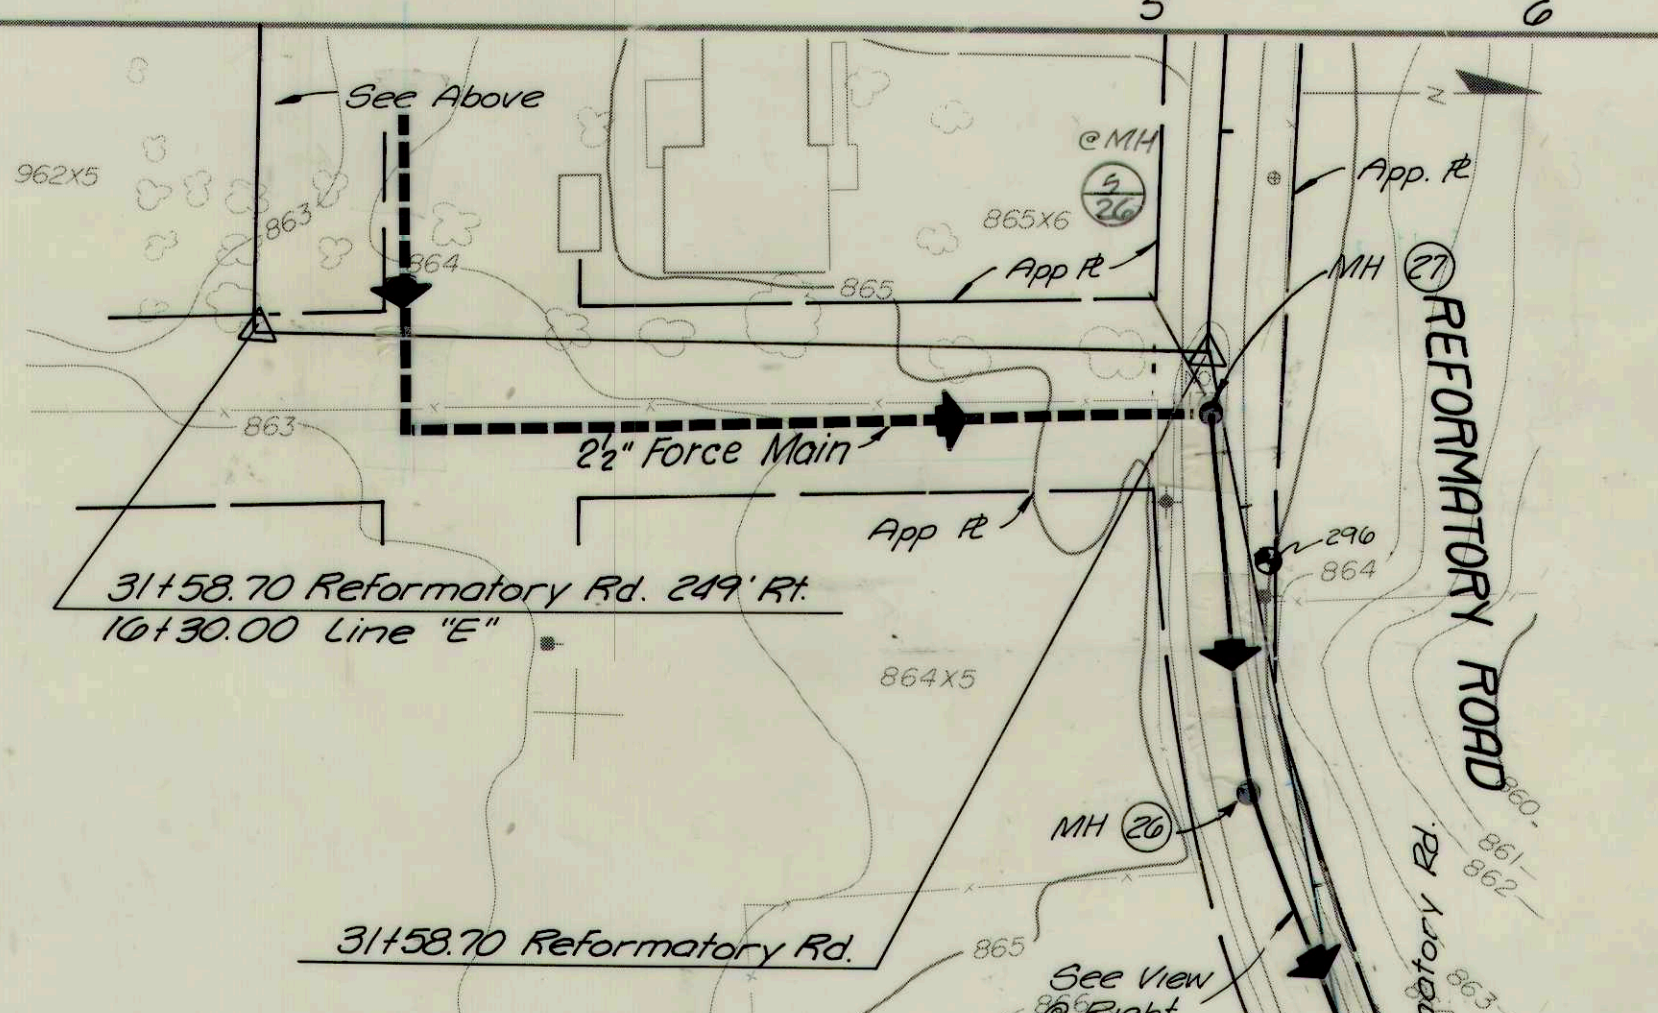


PLAN	DATE	BY
	SURVEYED	BY
	PLANNED	BY
	NOTED	BY

PROFILE	DATE	BY
	SURVEYED	BY
	PLANNED	BY
	NOTED	BY

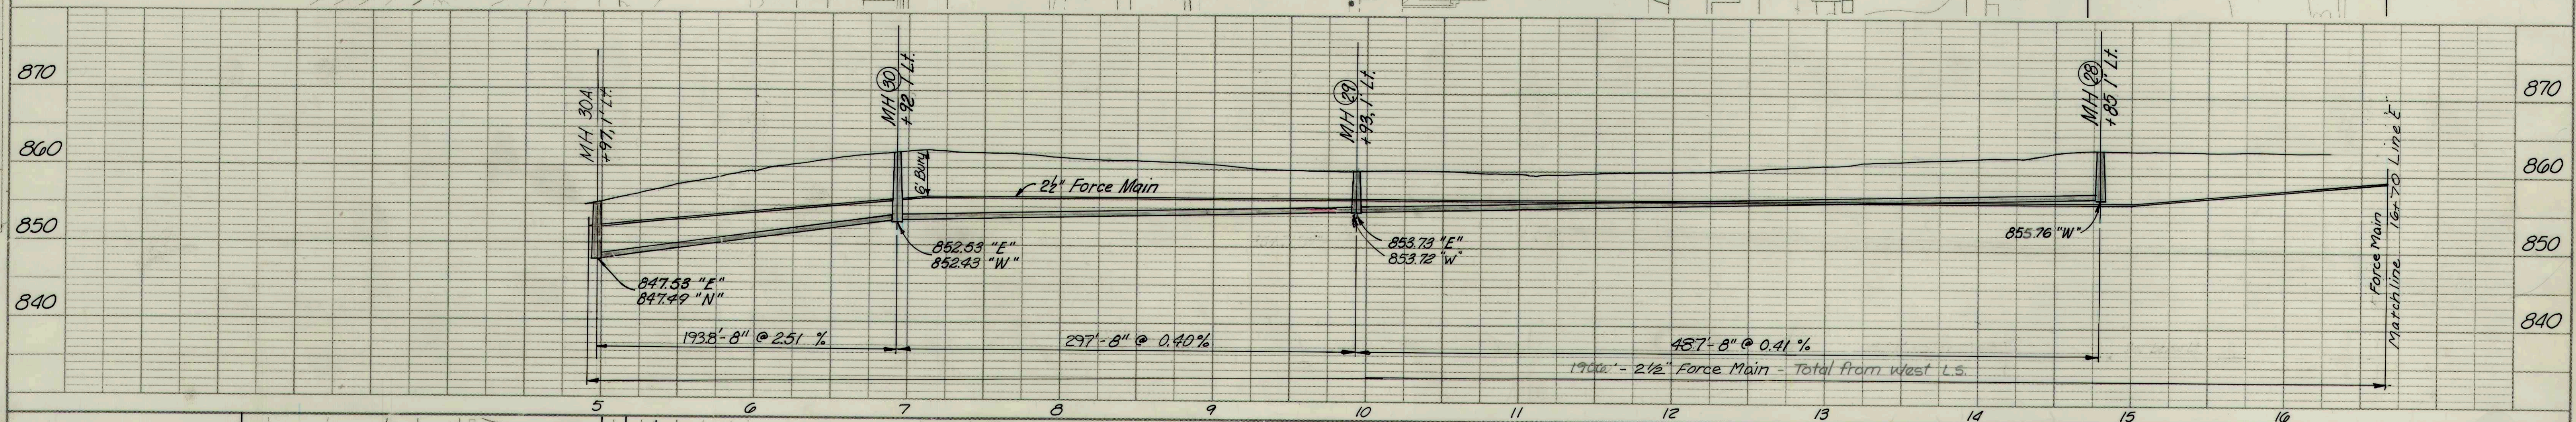

RECORD DRAWING

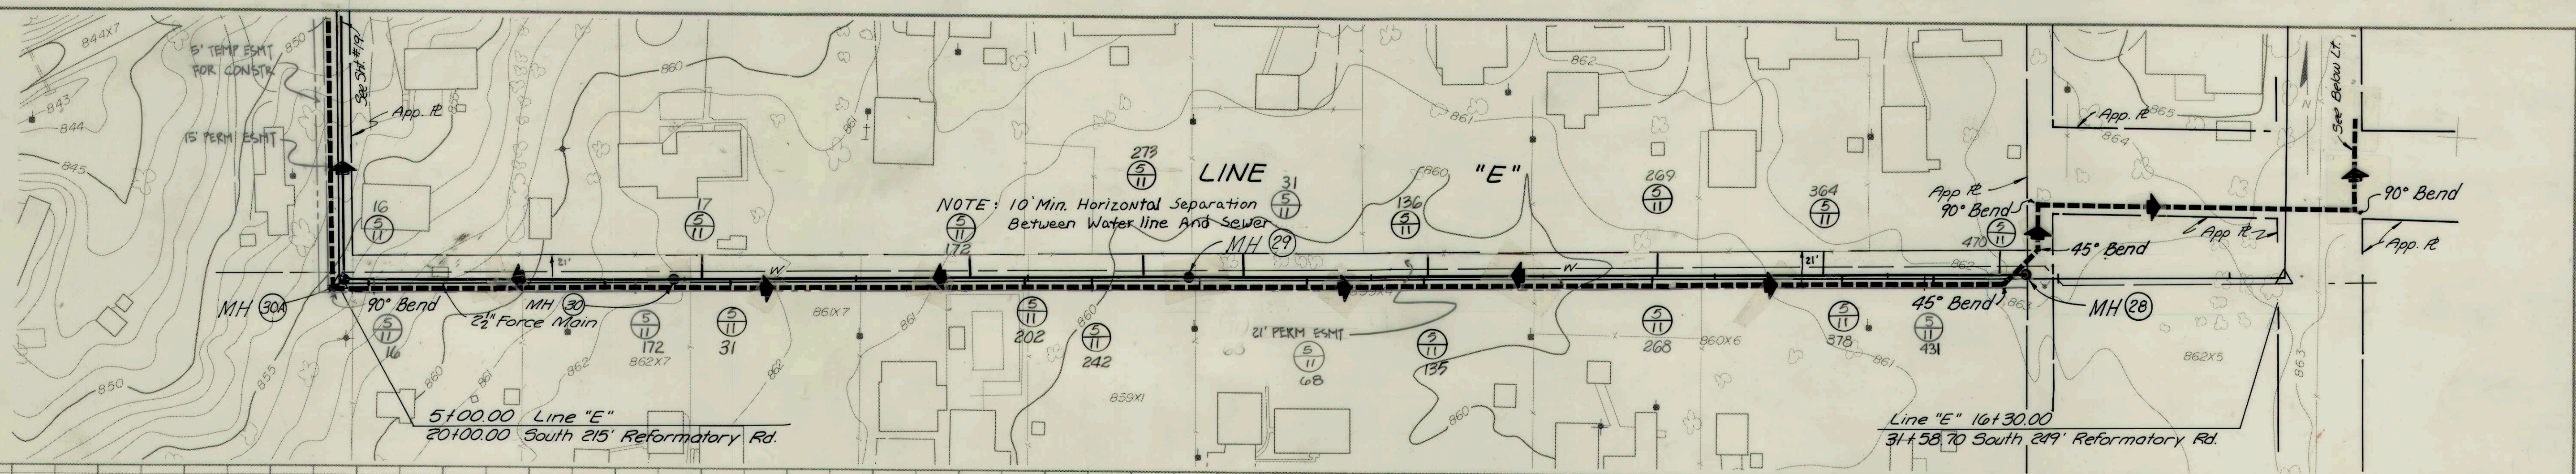

REFORMATORY RD. LINE "E"

FALL CREEK R.W.D. PLAN & PROFILE SHEET

HORIZ. 1"=50'

VERT. 1"=10'

BEAM, LONGEST & NEFF, INC.
CONSULTING ENGINEERS
INDIANAPOLIS, INDIANA

18