




RECORD DRAWING

Dennis D. Olmstead
Professional Land Surveyor
9/10/2025

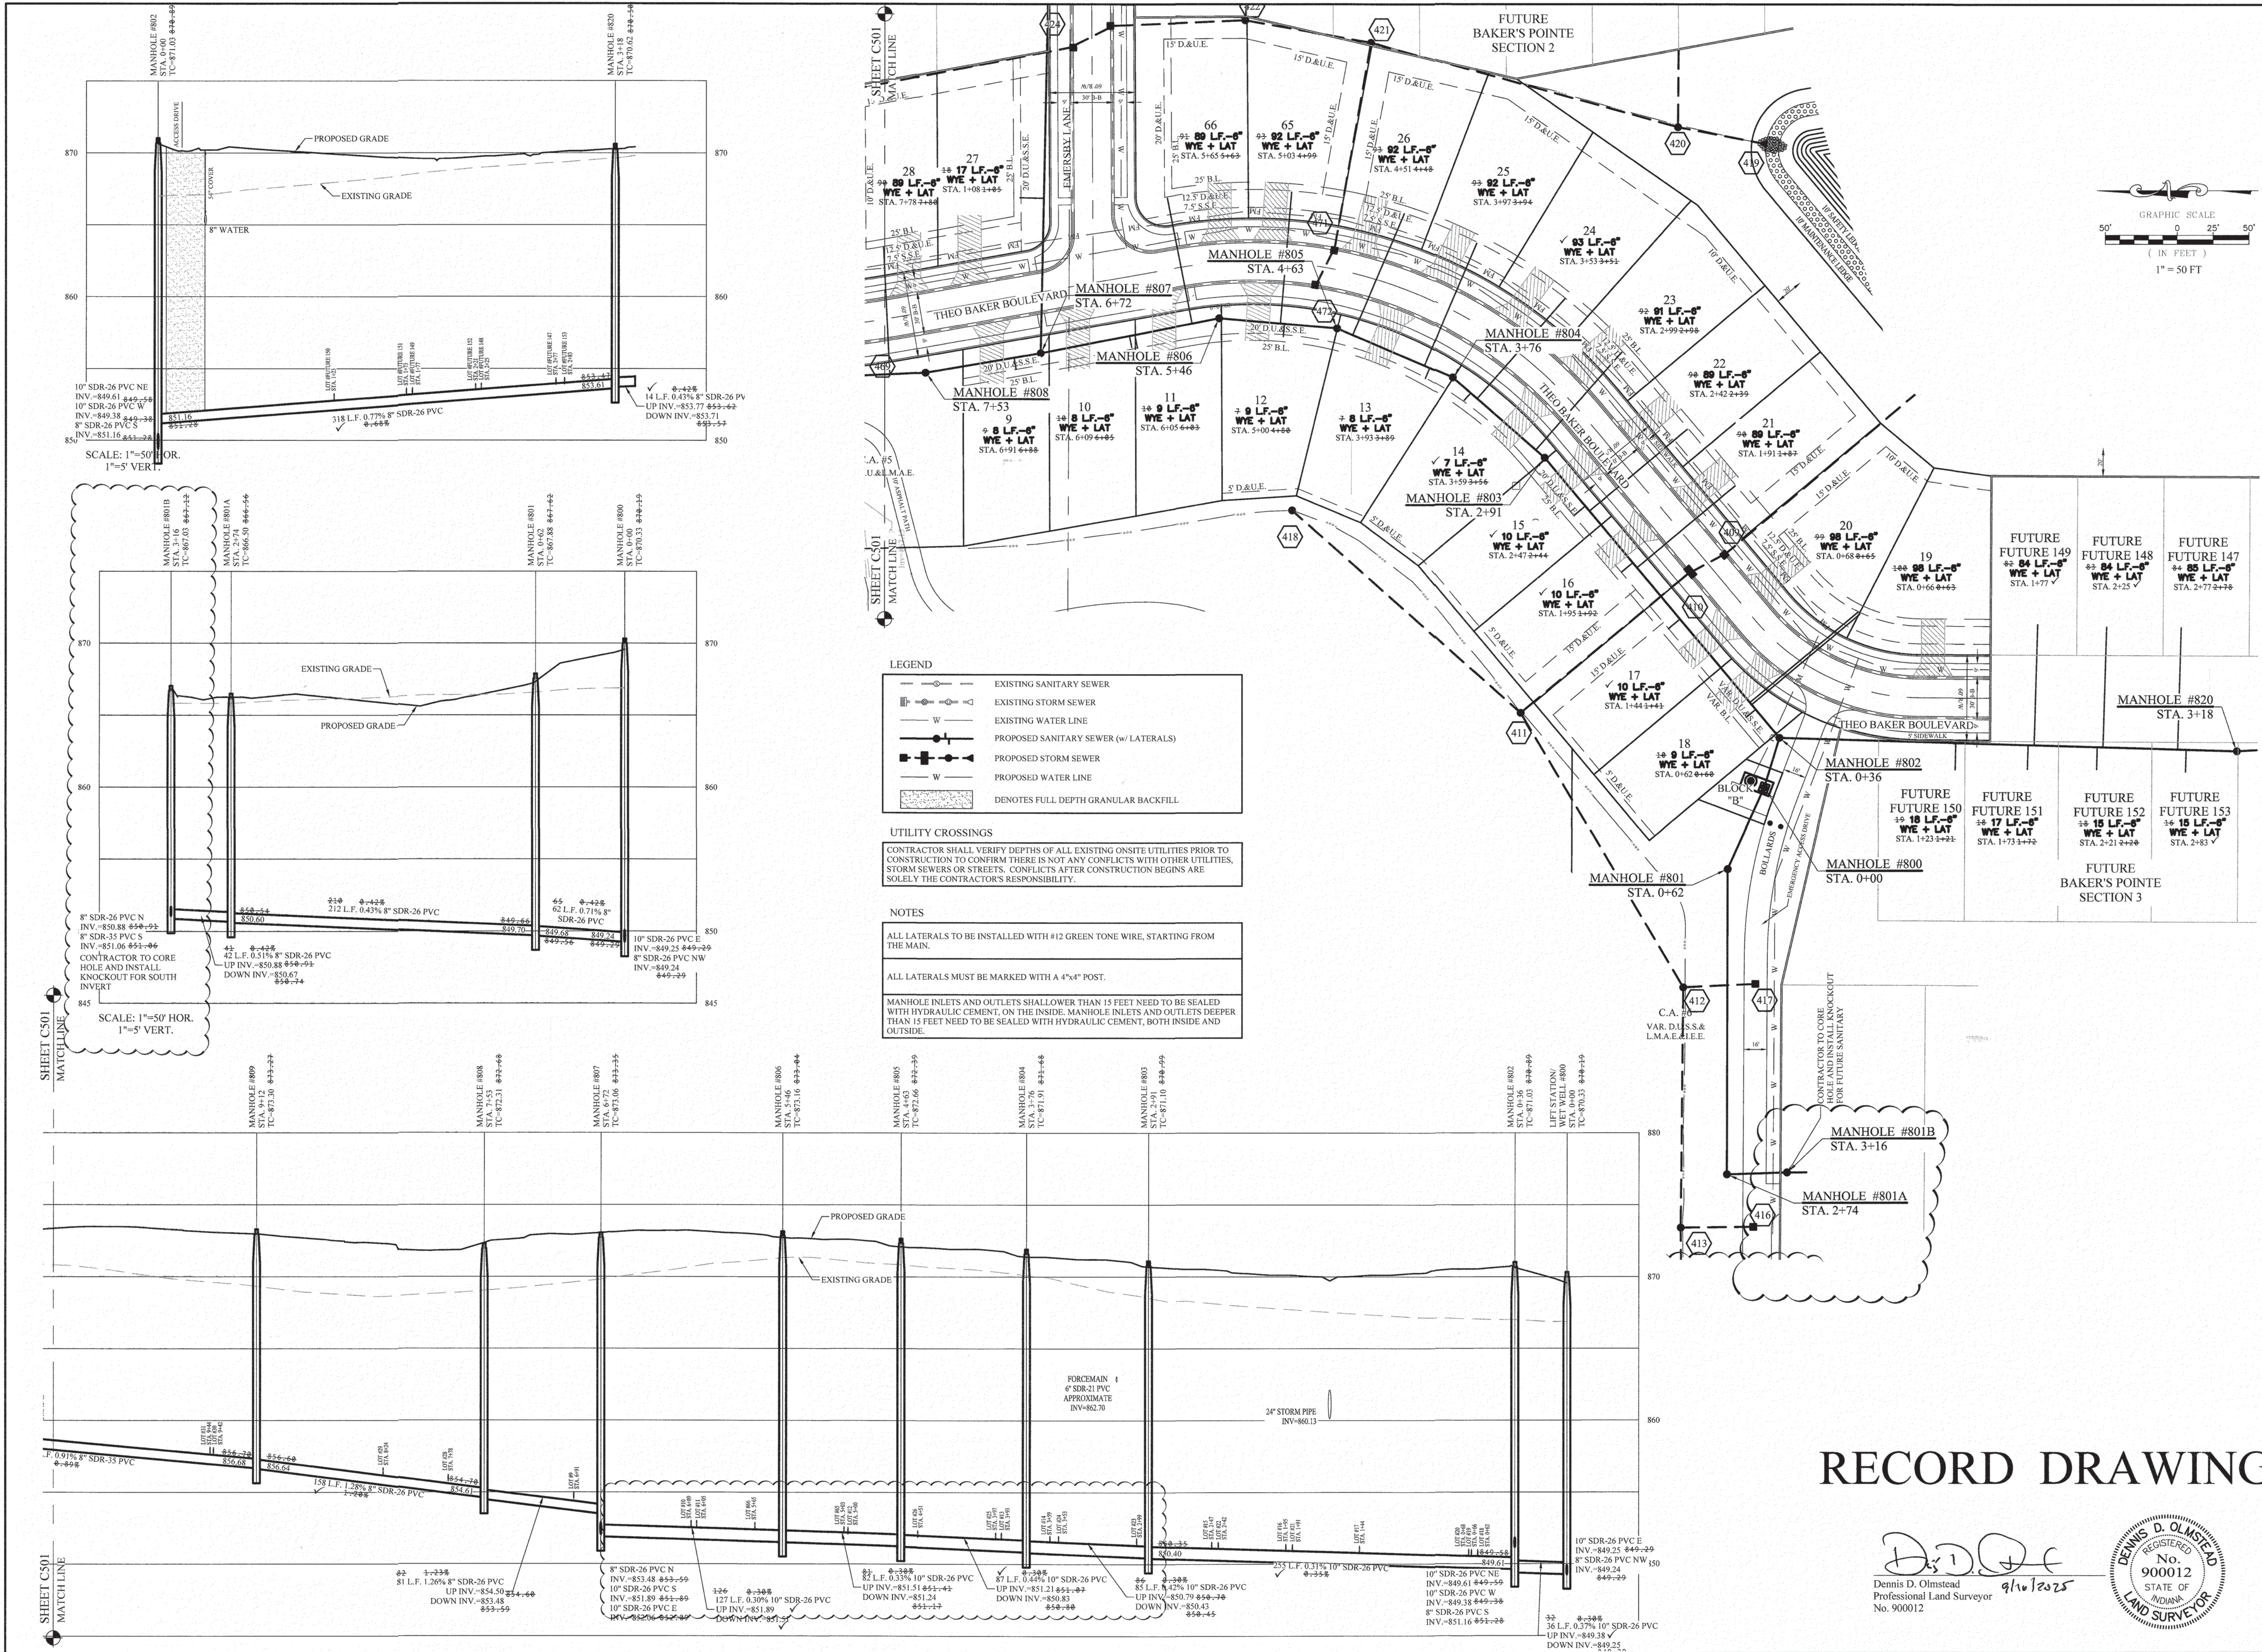

STOEPPELWERTH

ALWAYS ON

7945 East 104th Street, Fishers, IN 46038-2505
phone 317.497.5935 fax 317.497.5942

SANITARY SEWER PLAN & PROFILES

BAKER'S POINTE

SECTIONS 1A & AB

PENDLETON, FALL CREEK TOWNSHIP

MADISON COUNTY, INDIANA

M/E	AS BUILT	09/09/25	DATE	MARK	REVISIONS
KRG	ADDED SANITARY MANHOLE	03/20/25			
GH	REVISED PERHAPS FOR SHORTRUN IMPROVEMENTS	10/09/24			
GH	REVISED PERHAPS FOR ENTRANCE TO S.B. BRIDGED FILL	08/25/24			
GH	REVISED PER REVIEW COMMENTS	08/27/24			
GH	REVISED PER REVIEW COMMENTS	07/09/24			
REGEN	UPDATED TO NEW DRAINAGE ORDINANCE	06/06/24			

THIS DRAWING IS NOT INTENDED TO BE REPRESENTED AS A RETRACEMENT OR ORIGINAL BOUNDARY SURVEY. A ROUTE REPORT OR A SURVEYOR LOCATION REPORT.

CERTIFIED: 05/06/24

DRAWN BY: KJ/M/GEM

CHECKED BY: KRG

SHEET NO. C500

S & A JOB NO. 105263DRH-S1