
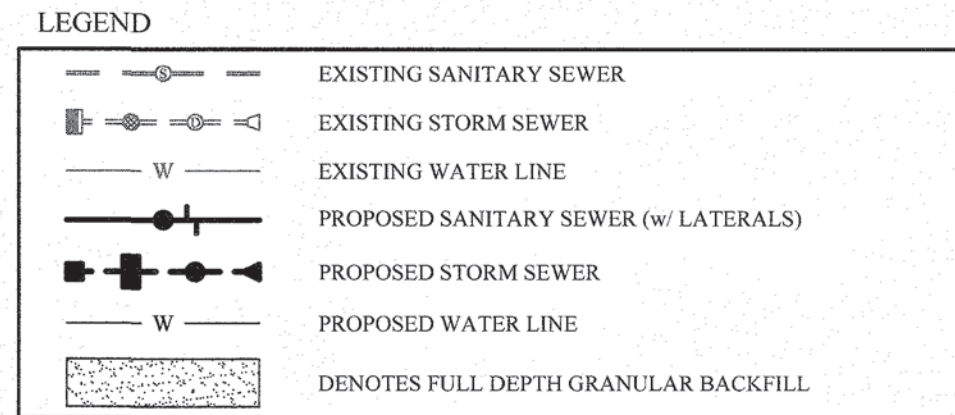
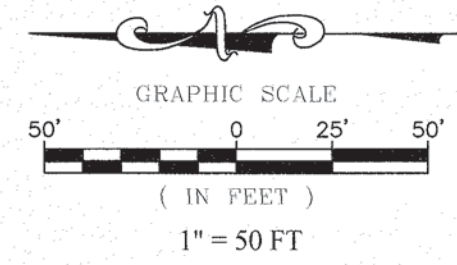


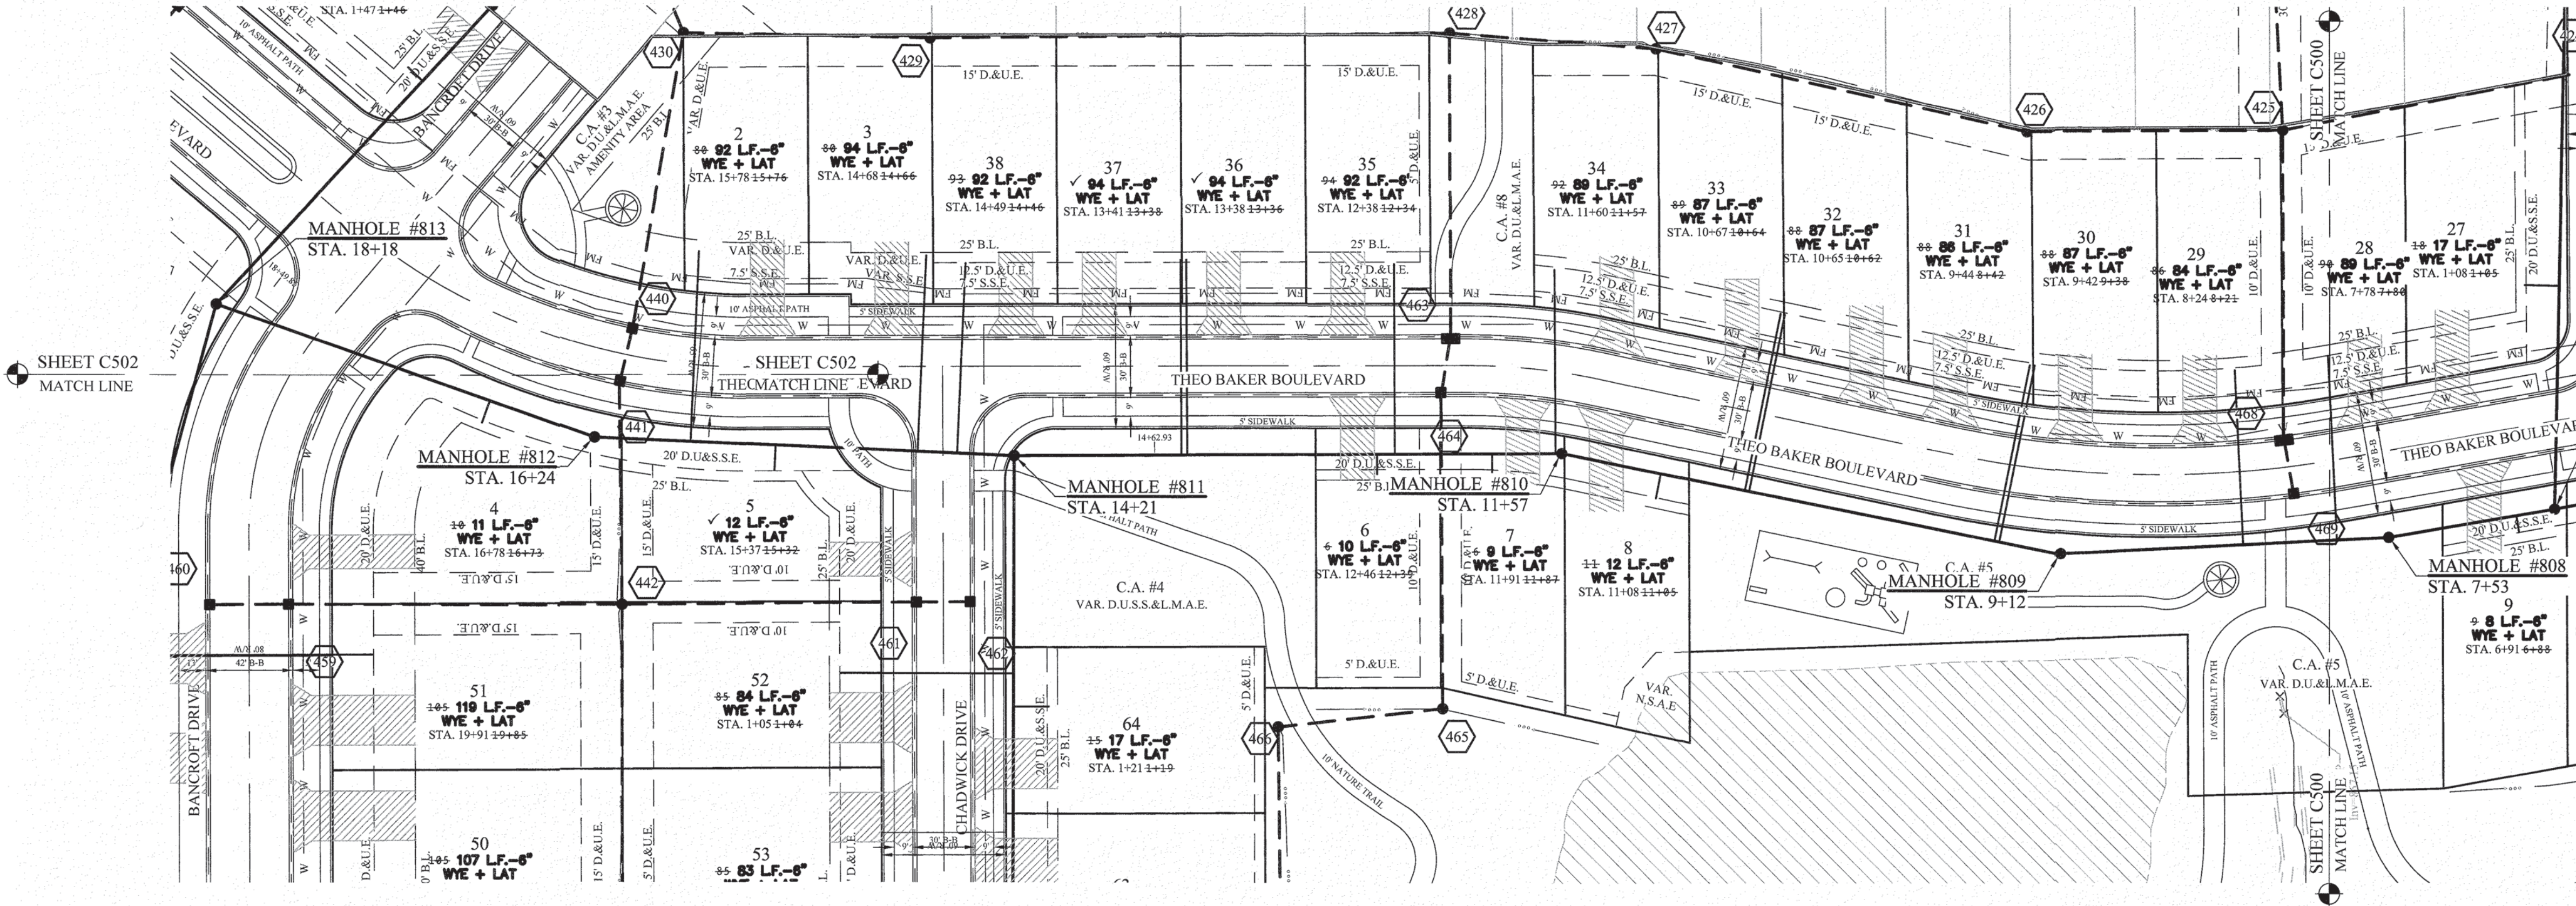

UTILITY CROSSINGS


CONTRACTOR SHALL VERIFY DEPTHS OF ALL EXISTING ONSITE UTILITIES PRIOR TO CONSTRUCTION TO CONFIRM THERE IS NOT ANY CONFLICTS WITH OTHER UTILITIES, STORM SEWERS OR STREETS. CONFLICTS AFTER CONSTRUCTION BEGINS ARE SOLELY THE CONTRACTOR'S RESPONSIBILITY.

NOTES

ALL LATERALS TO BE INSTALLED WITH #12 GREEN TONE WIRE, STARTING FROM THE MAIN.

ALL LATERALS MUST BE MARKED WITH A 4"x4" POST.

MANHOLE INLETS AND OUTLETS SHALLower THAN 15 FEET NEED TO BE SEALED WITH HYDRAULIC CEMENT, ON THE INSIDE. MANHOLE INLETS AND OUTLETS DEEPER THAN 15 FEET NEED TO BE SEALED WITH HYDRAULIC CEMENT, BOTH INSIDE AND OUTSIDE.

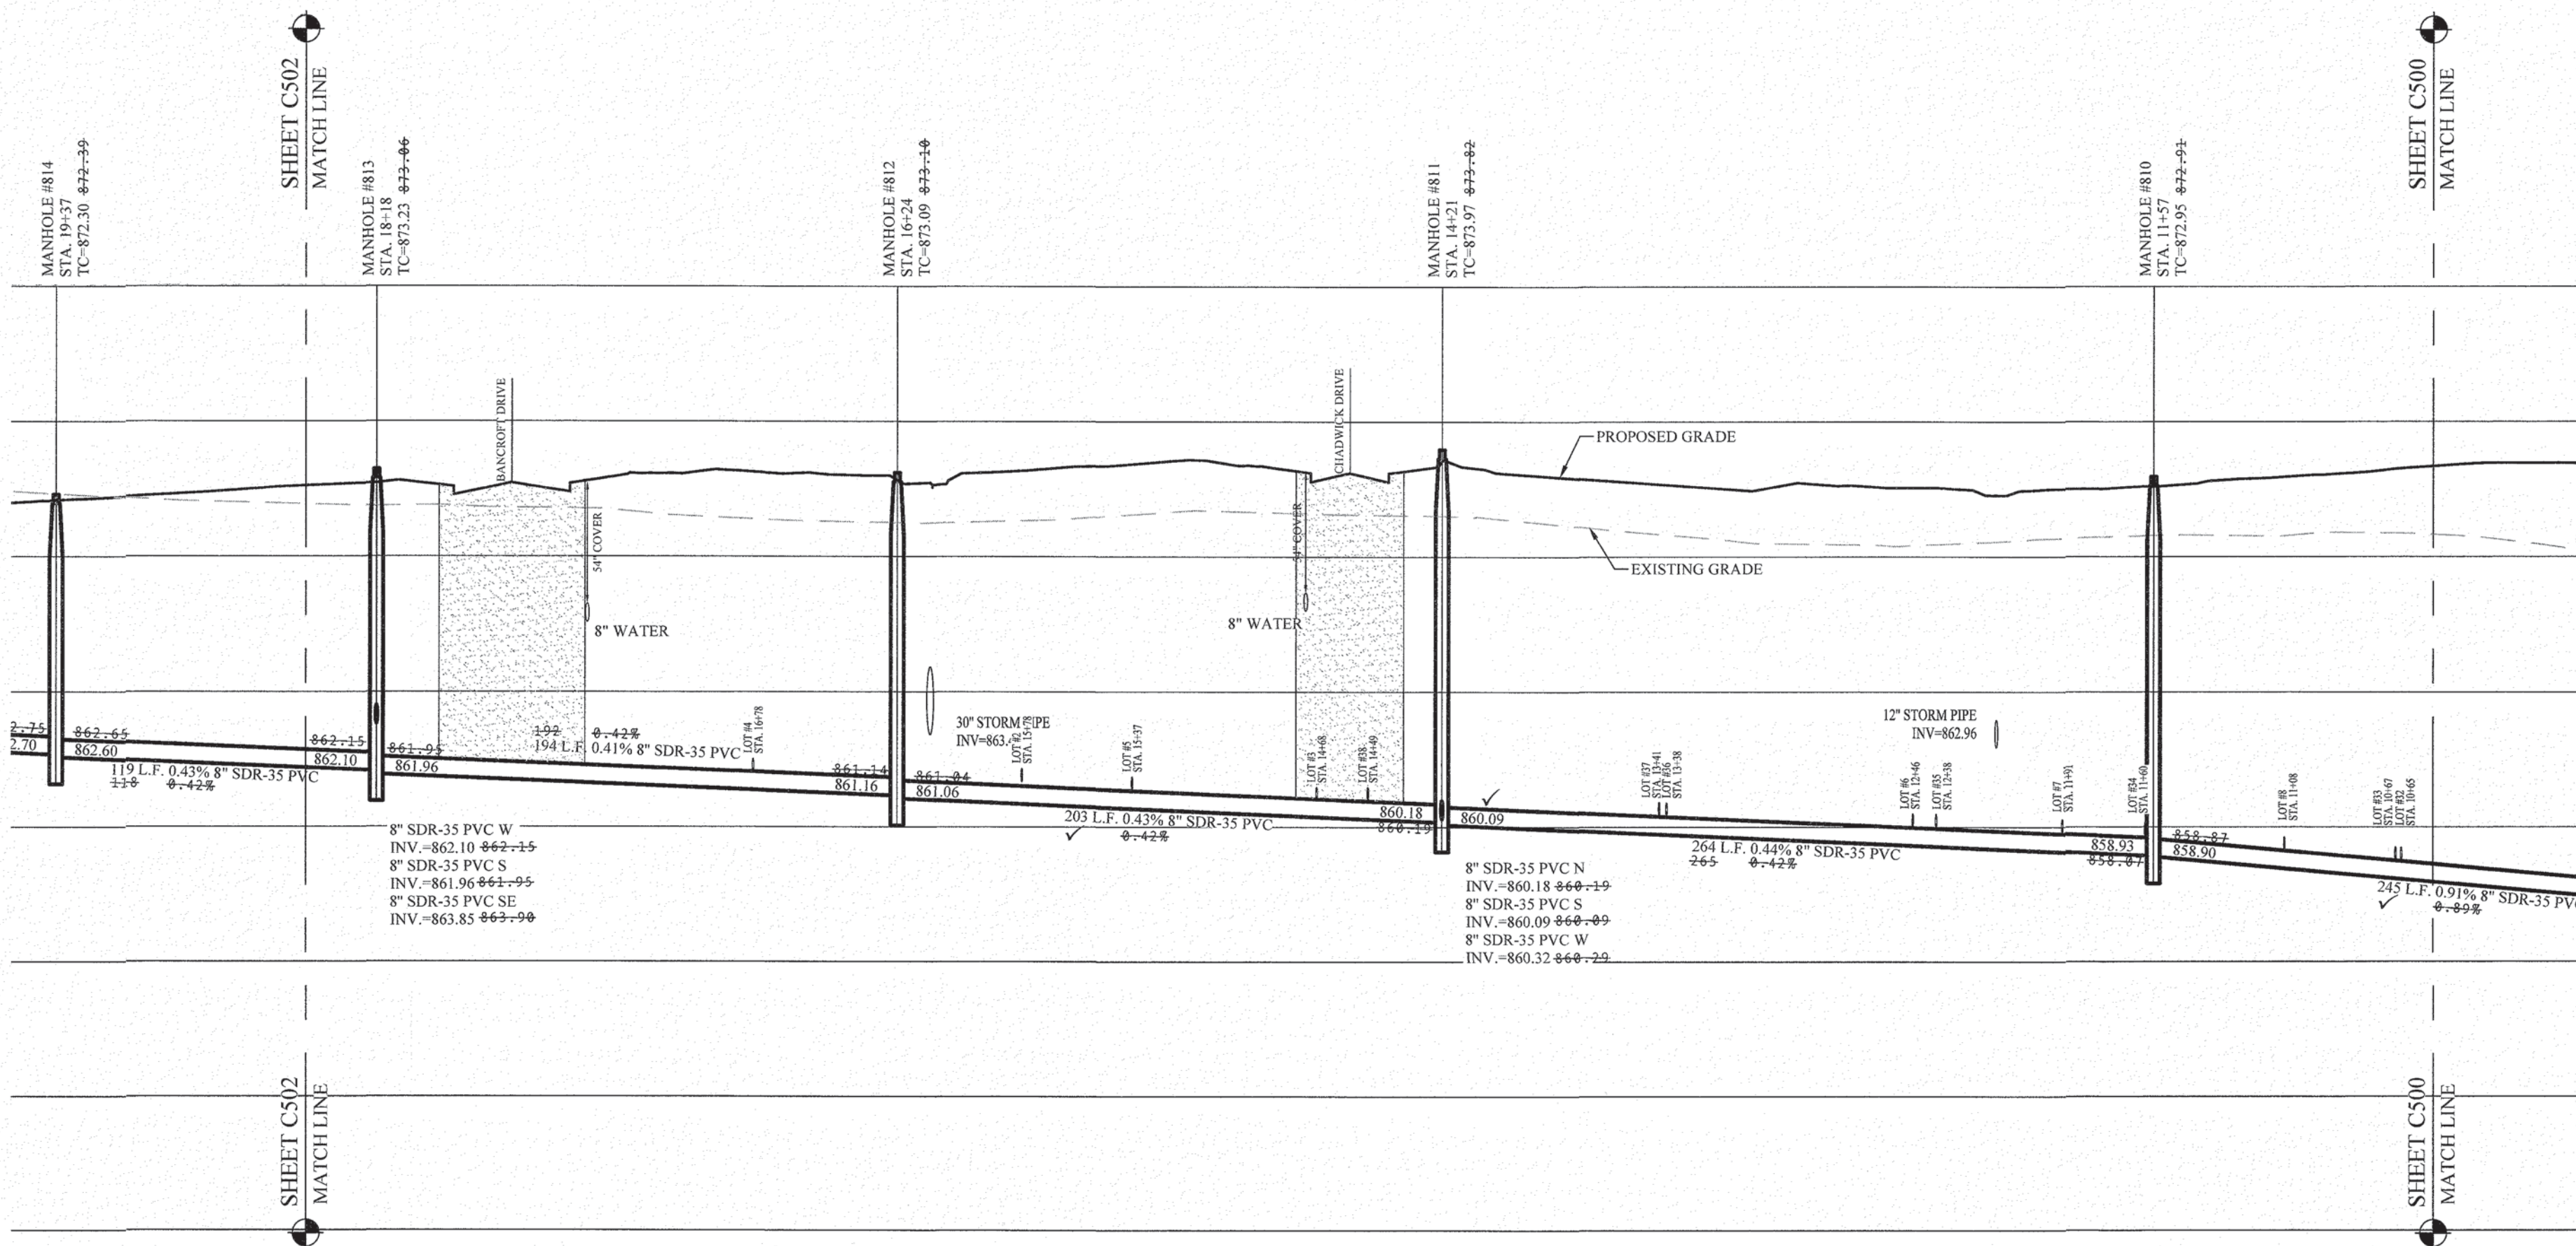

RECORD DRAWING

Dennis D. Olmstead
Professional Land Surveyor
No. 900012
9/10/2025



STOEPPELWERTH

ALWAYS ON

7905 East 100th Street, Fishers, IN 46038-2505
phone: 317.849.5985 fax: 317.849.5942

SANITARY SEWER PLAN & PROFILES

BAKER'S POINTE

SECTIONS 1A & AB

PENDLETON, FALL CREEK TOWNSHIP
MADISON COUNTY, INDIANA

DRAWN BY: KJ/M/GEM

CHECKED BY: KRG

SHEET NO. C501

S&A JOB NO. 105263DRH-S1

AS BUILTS

09/09/25

REVISIONS

DATE

MARK

BY

THIS DRAWING IS NOT INTENDED TO BE REPRESENTED AS A RETRACEMENT OR ORIGINAL BOUNDARY SURVEY. A ROUTE SURVEY OR A SURVEY OR LOCATION REPORT.

05/06/24

REGISTERED PROFESSIONAL ENGINEER

PE1200386

STATE OF INDIANA

NO. 105263DRH-S1

REVISIONS

DATE

MARK

BY