


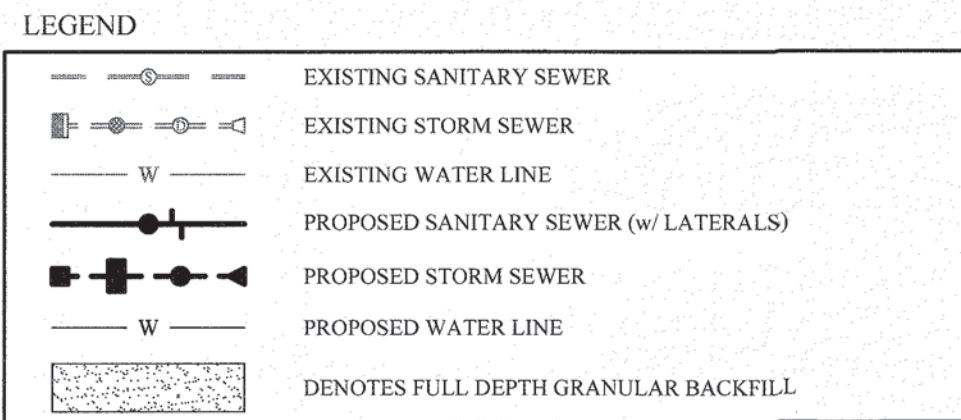


CONTRACTOR SHALL VERIFY DEPTHS OF ALL EXISTING ONSITE UTILITIES PRIOR TO CONSTRUCTION TO CONFIRM THERE IS NOT ANY CONFLICTS WITH OTHER UTILITIES, STORM SEWERS OR STREETS. CONFLICTS AFTER CONSTRUCTION BEGINS ARE SOLELY THE CONTRACTOR'S RESPONSIBILITY.

ALL LATERALS TO BE INSTALLED WITH #12 GREEN TONE WIRE, STARTING FROM THE MAIN.

ALL LATERALS MUST BE MARKED WITH A 4"x4" POST.

MANHOLE INLETS AND OUTLETS SHALLOWER THAN 15 FEET NEED TO BE SEALED WITH HYDRAULIC CEMENT, ON THE INSIDE. MANHOLE INLETS AND OUTLETS DEEPER THAN 15 FEET NEED TO BE SEALED WITH HYDRAULIC CEMENT, BOTH INSIDE AND OUTSIDE.

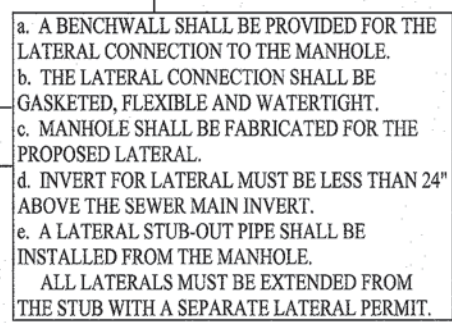

EPPELWE

ALWAYSON

7965 East 106th Street, Fishers, IN 46038-2505
phone: 317.849.5935 fax: 317.849.5942

BAKER'S POINTE
SECTIONS 1A & ABPENDLETON, FALL CREEK TOWNSHIP
MADISON COUNTY, INDIANA

REPORT: 
CERTIFIED: 05/06/24

DATE	MARKS	REVISIONS	BY
06/06/24	07/06/24	UPDATED TO NEW DRAINAGE ORDINANCE	KROGEM
07/09/24		REVISED PER REVIEW COMMENTS	GEM
08/27/24		REVISED PER REVIEW COMMENTS	GEM
09/25/24		REVISED HANDICAP RAMPS AT ENTRANCE TO S.R. 35/DAVID P.H.	GEM
02/26/25		REVISED PER FUTURE C.R. W. 600 S. IMPROVEMENTS	GEM
09/09/25		AS BUILT	MIE


Dennis D. Olmstead
Professional Land Surveyor
No. 900012



DRAWN BY: KJJM/GEM	CHECKED BY: KRG
SHEET NO. C502	
S & A JOB NO. 105263DRH-S1	