
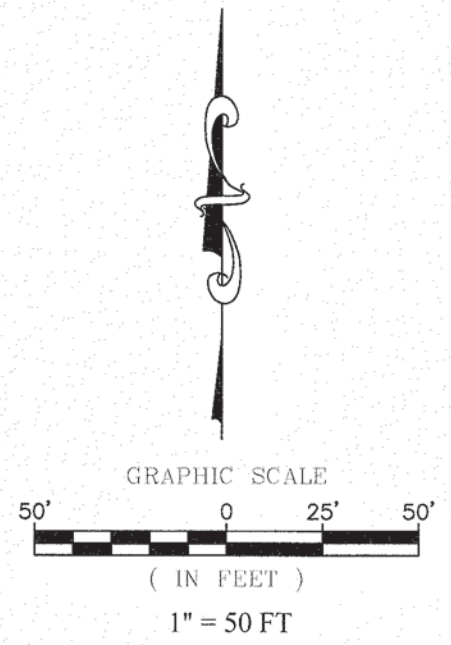




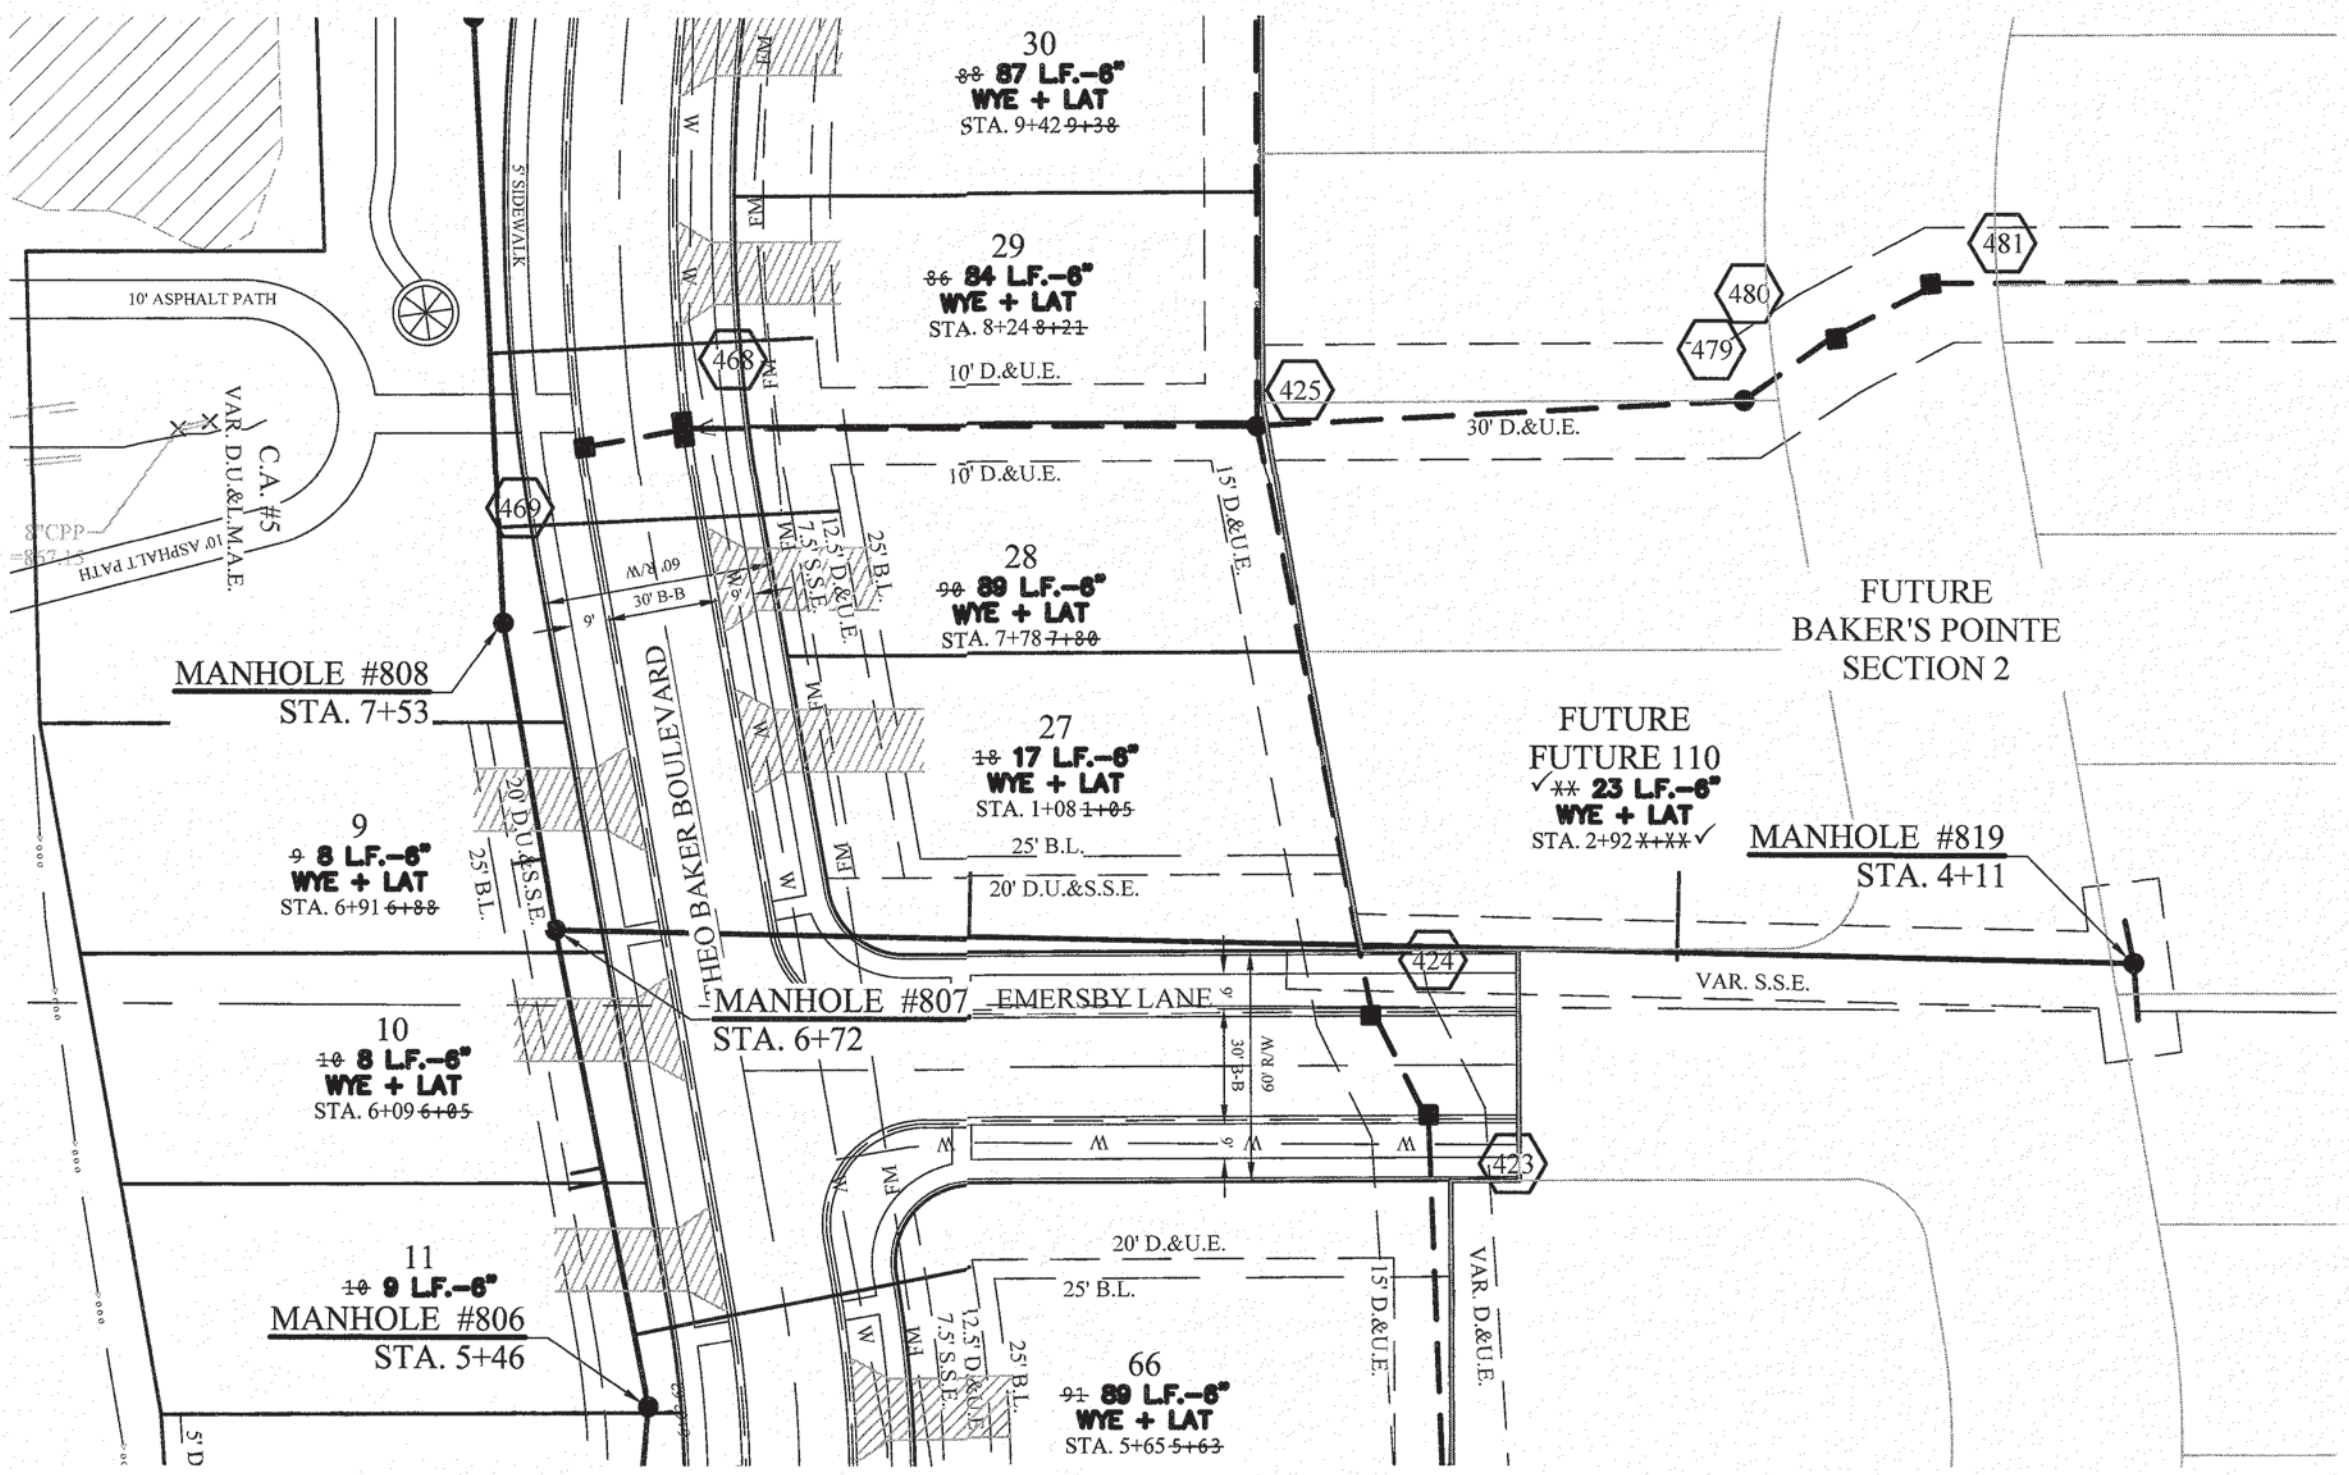


- LEGEND**
- EXISTING SANITARY SEWER
 - EXISTING STORM SEWER
 - EXISTING WATER LINE
 - PROPOSED SANITARY SEWER (w/ LATERALS)
 - PROPOSED STORM SEWER
 - PROPOSED WATER LINE
 - DENOTES FULL DEPTH GRANULAR BACKFILL

UTILITY CROSSINGS

CONTRACTOR SHALL VERIFY DEPTHS OF ALL EXISTING ONSITE UTILITIES PRIOR TO CONSTRUCTION TO CONFIRM THERE IS NOT ANY CONFLICTS WITH OTHER UTILITIES, STORM SEWERS OR STREETS. CONFLICTS AFTER CONSTRUCTION BEGINS ARE SOLELY THE CONTRACTOR'S RESPONSIBILITY.

- NOTES**
- ALL LATERALS TO BE INSTALLED WITH #12 GREEN TONE WIRE, STARTING FROM THE MAIN.
 - ALL LATERALS MUST BE MARKED WITH A 4"x4" POST.
 - MANHOLE INLETS AND OUTLETS SHALL BE SEALED WITH HYDRAULIC CEMENT, ON THE INSIDE. MANHOLE INLETS AND OUTLETS DEEPER THAN 15 FEET NEED TO BE SEALED WITH HYDRAULIC CEMENT, BOTH INSIDE AND OUTSIDE.

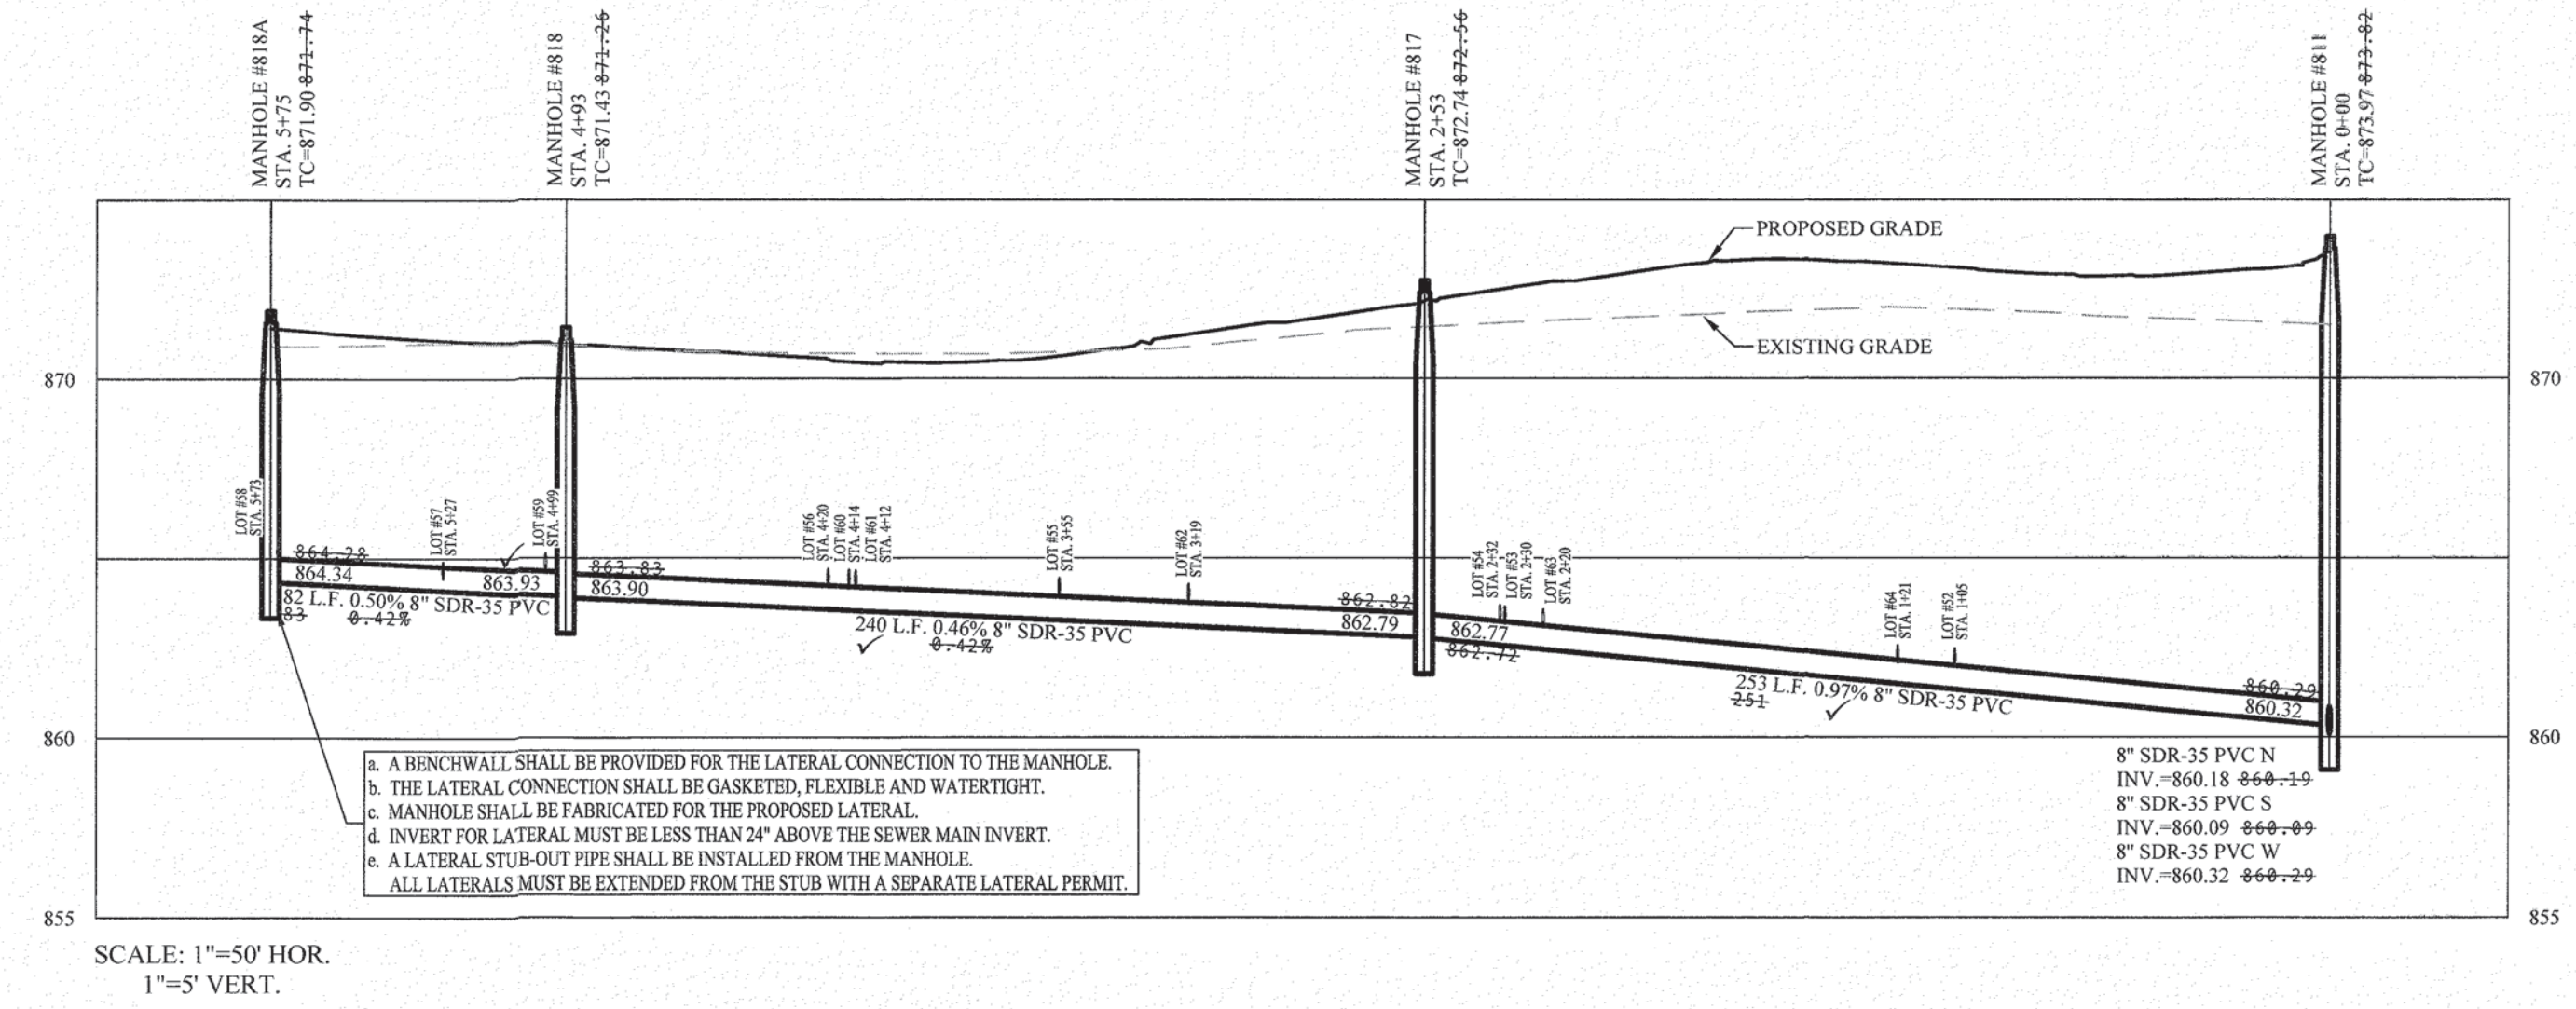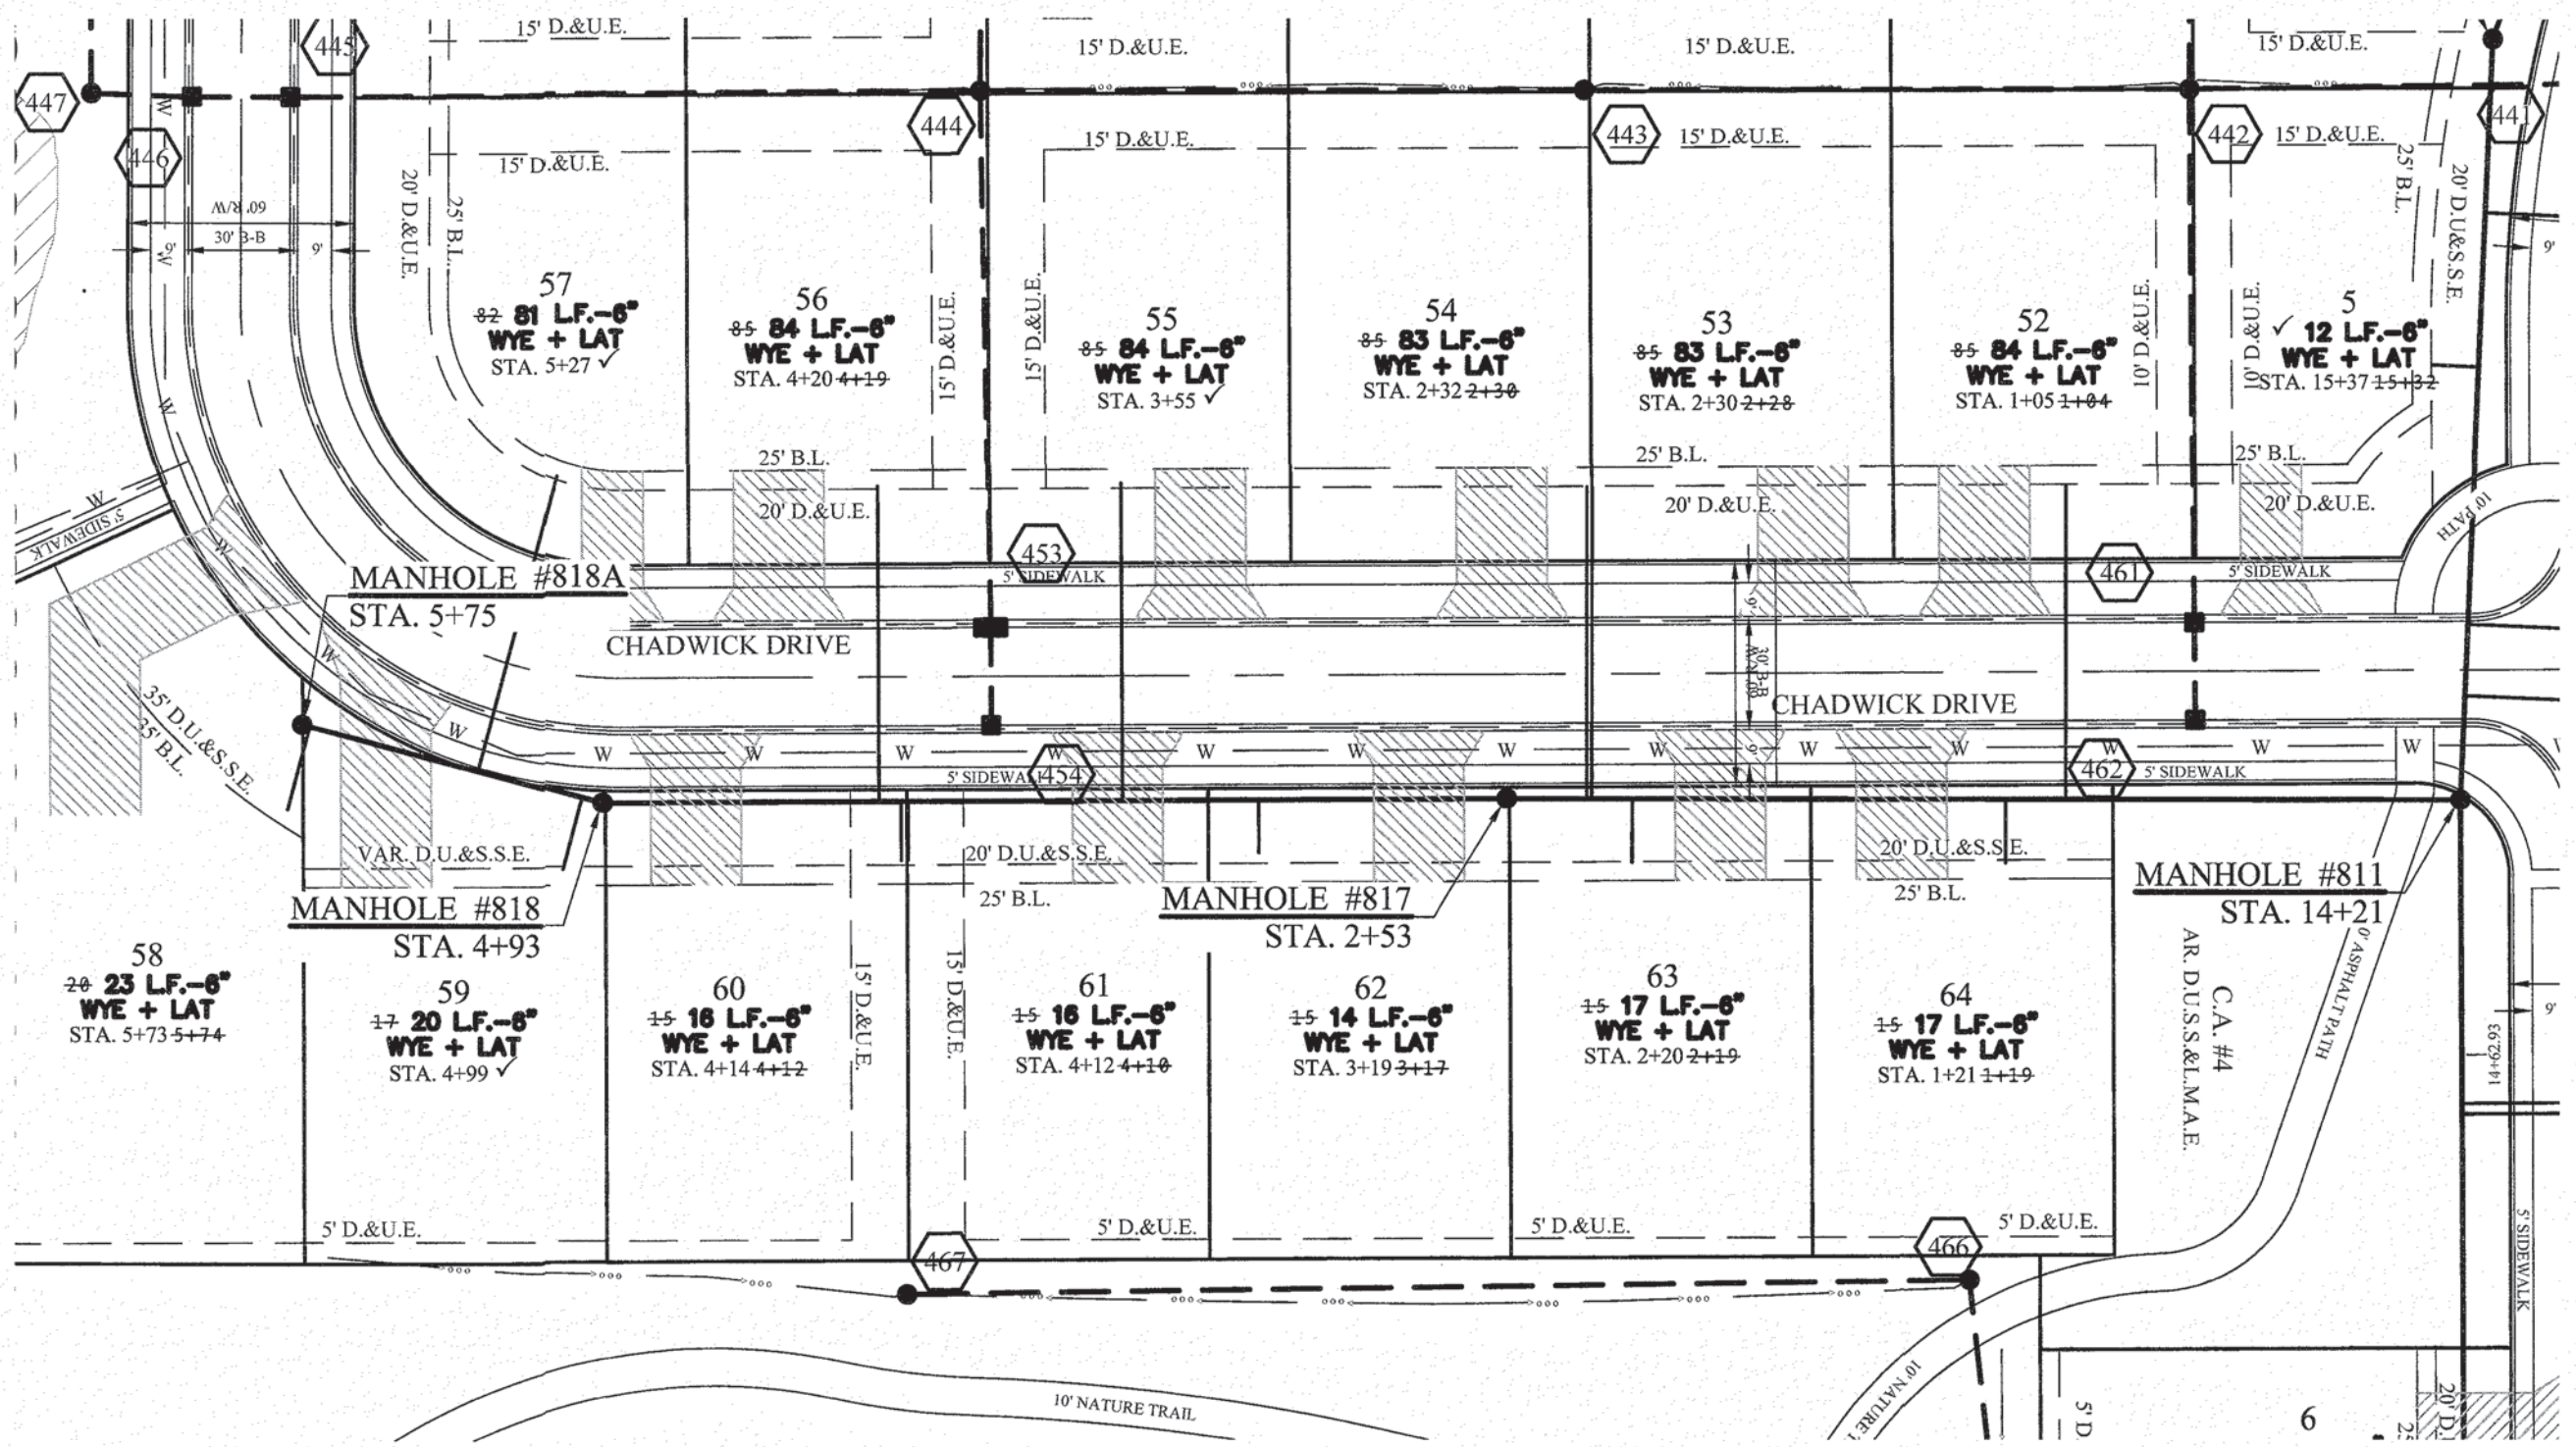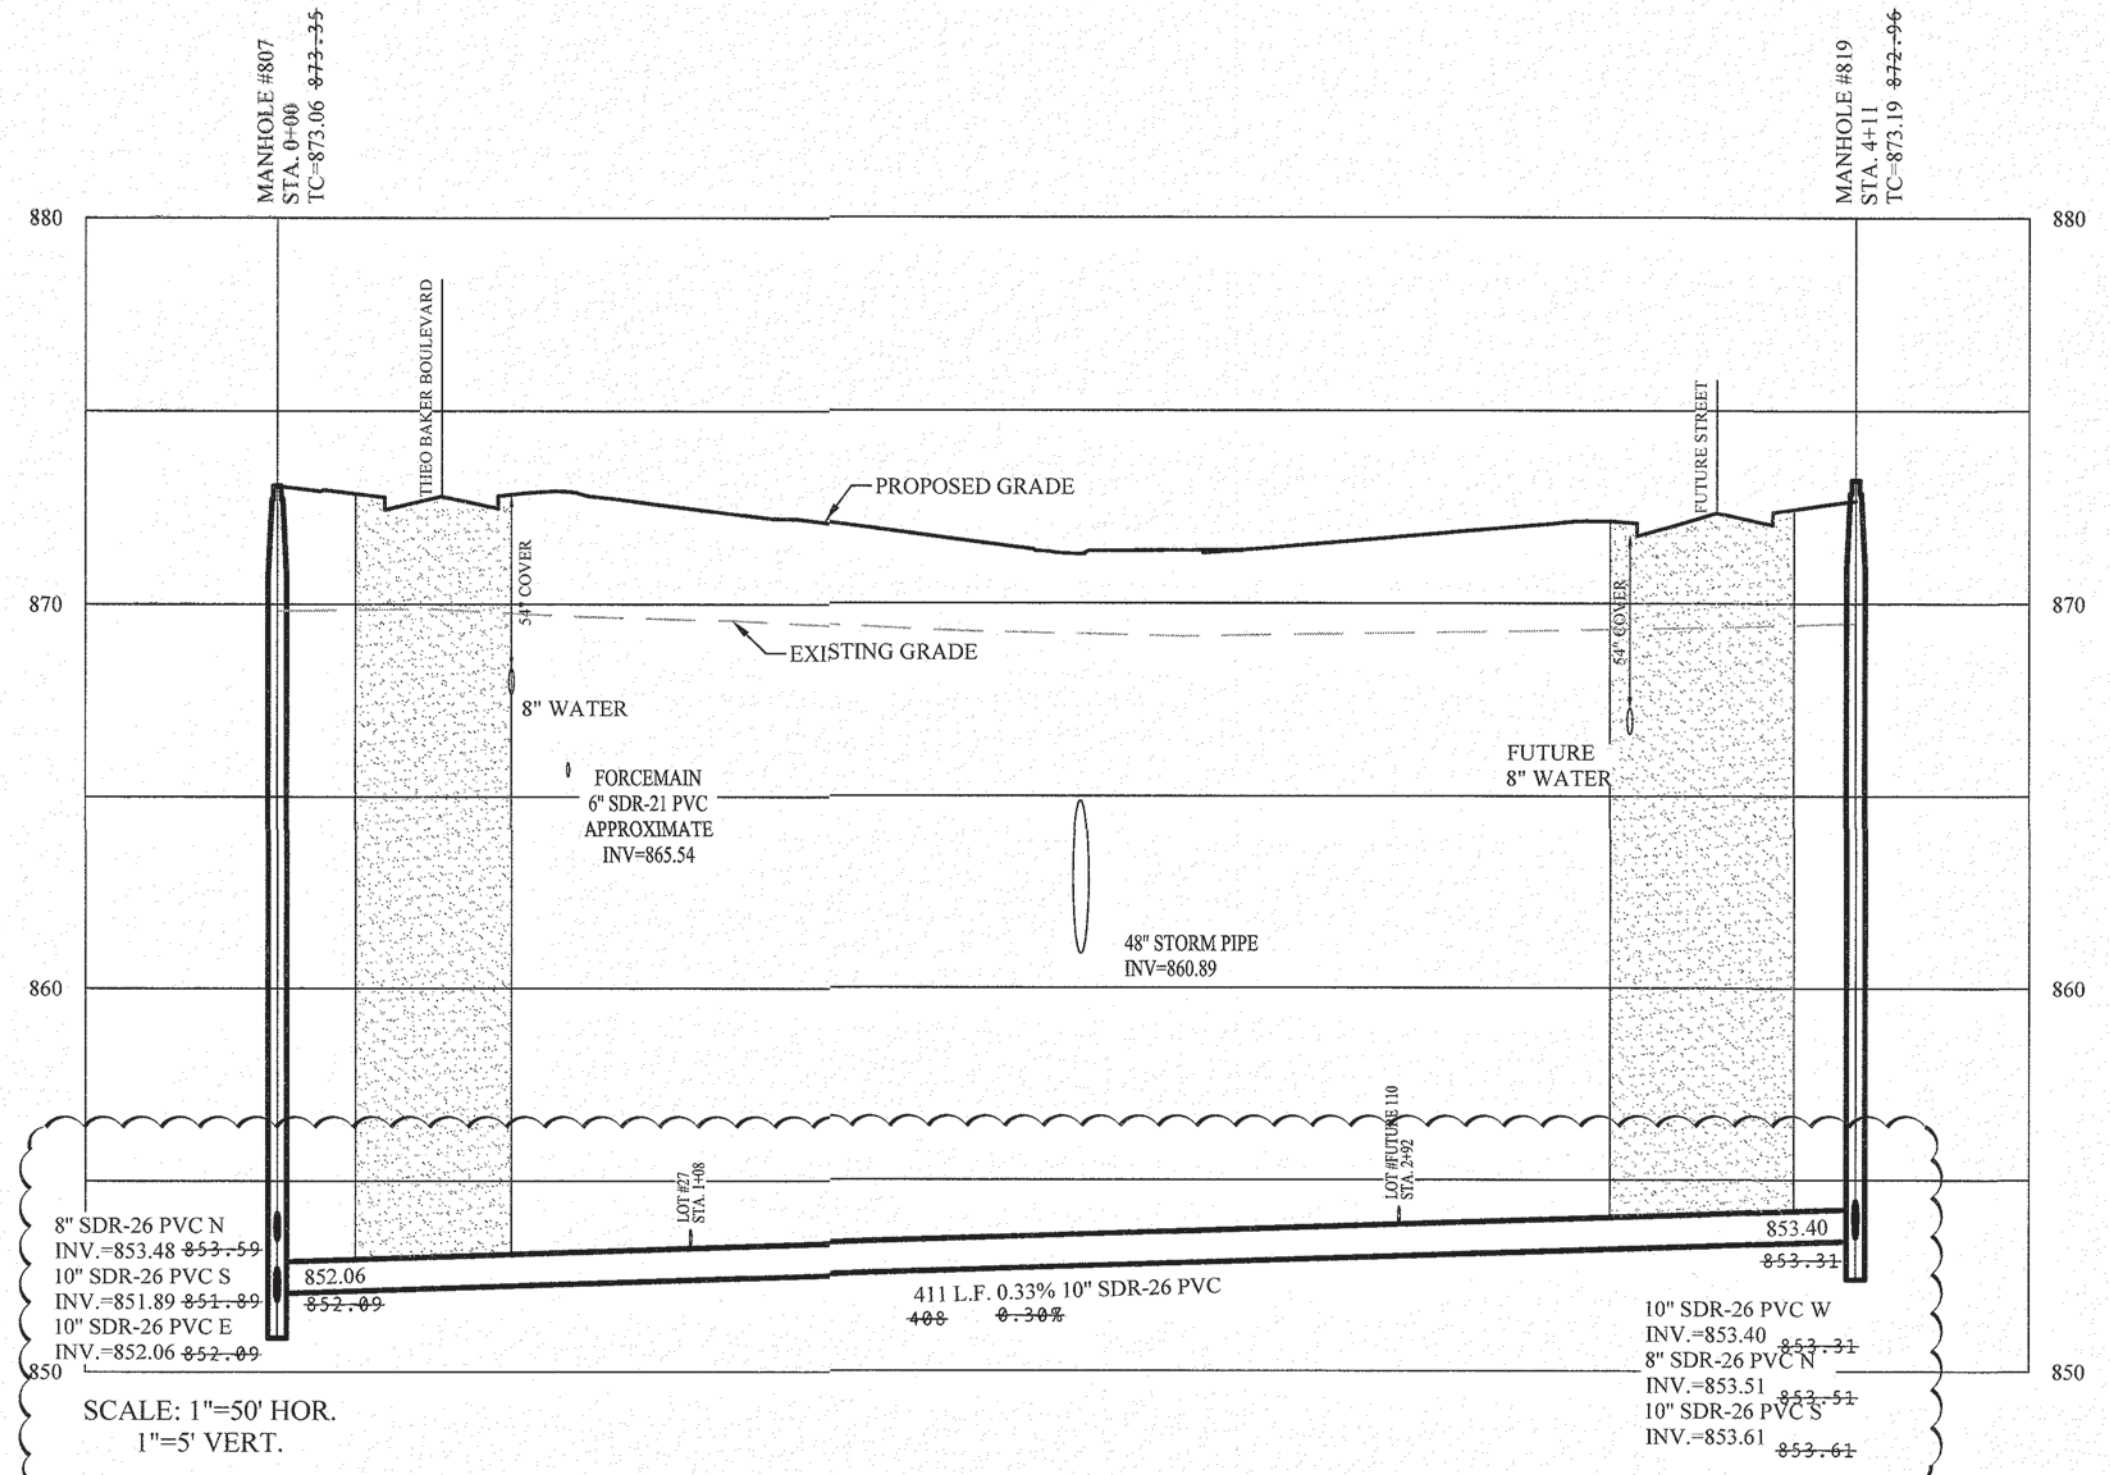

RECORD DRAWING

D.D. Olmstead
Dennis D. Olmstead
Professional Land Surveyor
No. 900012



STOEPPELWERTH

ALWAYS ON

7905 East 108th Street, Fishers, IN 46038-2505
phone: 317.845.5955 fax: 317.845.5942

SANITARY SEWER PLAN & PROFILES

BAKER'S POINTE
SECTIONS 1A & AB

PENDLETON, FALL CREEK TOWNSHIP MADISON COUNTY, INDIANA

DRAWN BY: KJM/GEM

CHECKED BY: KRG

SHEET NO. C503

S.D.A. FOR NO. 105263DRH-S1

THIS DRAWING IS NOT INTENDED TO BE REPRESENTED BY ANY OTHER ORIGINAL BOUNDARY SURVEY A ROUTE SURVEY OR A SURVEYOR LOCATION REPORT.

CERTIFIED: 05/06/24

S. Miller

REGISTERED PROFESSIONAL ENGINEER
No. PE1200386
STATE OF INDIANA

REVISIONS
DATE MARK BY

08/06/25 AS BUILT'S

08/06/25
09/25/24
08/27/24
07/09/24
06/06/24

REVISED PER NEW DRAINAGE ORDINANCE
REVISED PER REVIEW COMMENTS
REVISED PER REVIEW COMMENTS
REVISED PER REVIEW COMMENTS
REVISED PER REVIEW COMMENTS

REVISIONS
DATE MARK BY

08/06/25 AS BUILT'S

08/06/25
09/25/24
08/27/24
07/09/24
06/06/24

REVISED PER NEW DRAINAGE ORDINANCE
REVISED PER REVIEW COMMENTS
REVISED PER REVIEW COMMENTS
REVISED PER REVIEW COMMENTS
REVISED PER REVIEW COMMENTS