
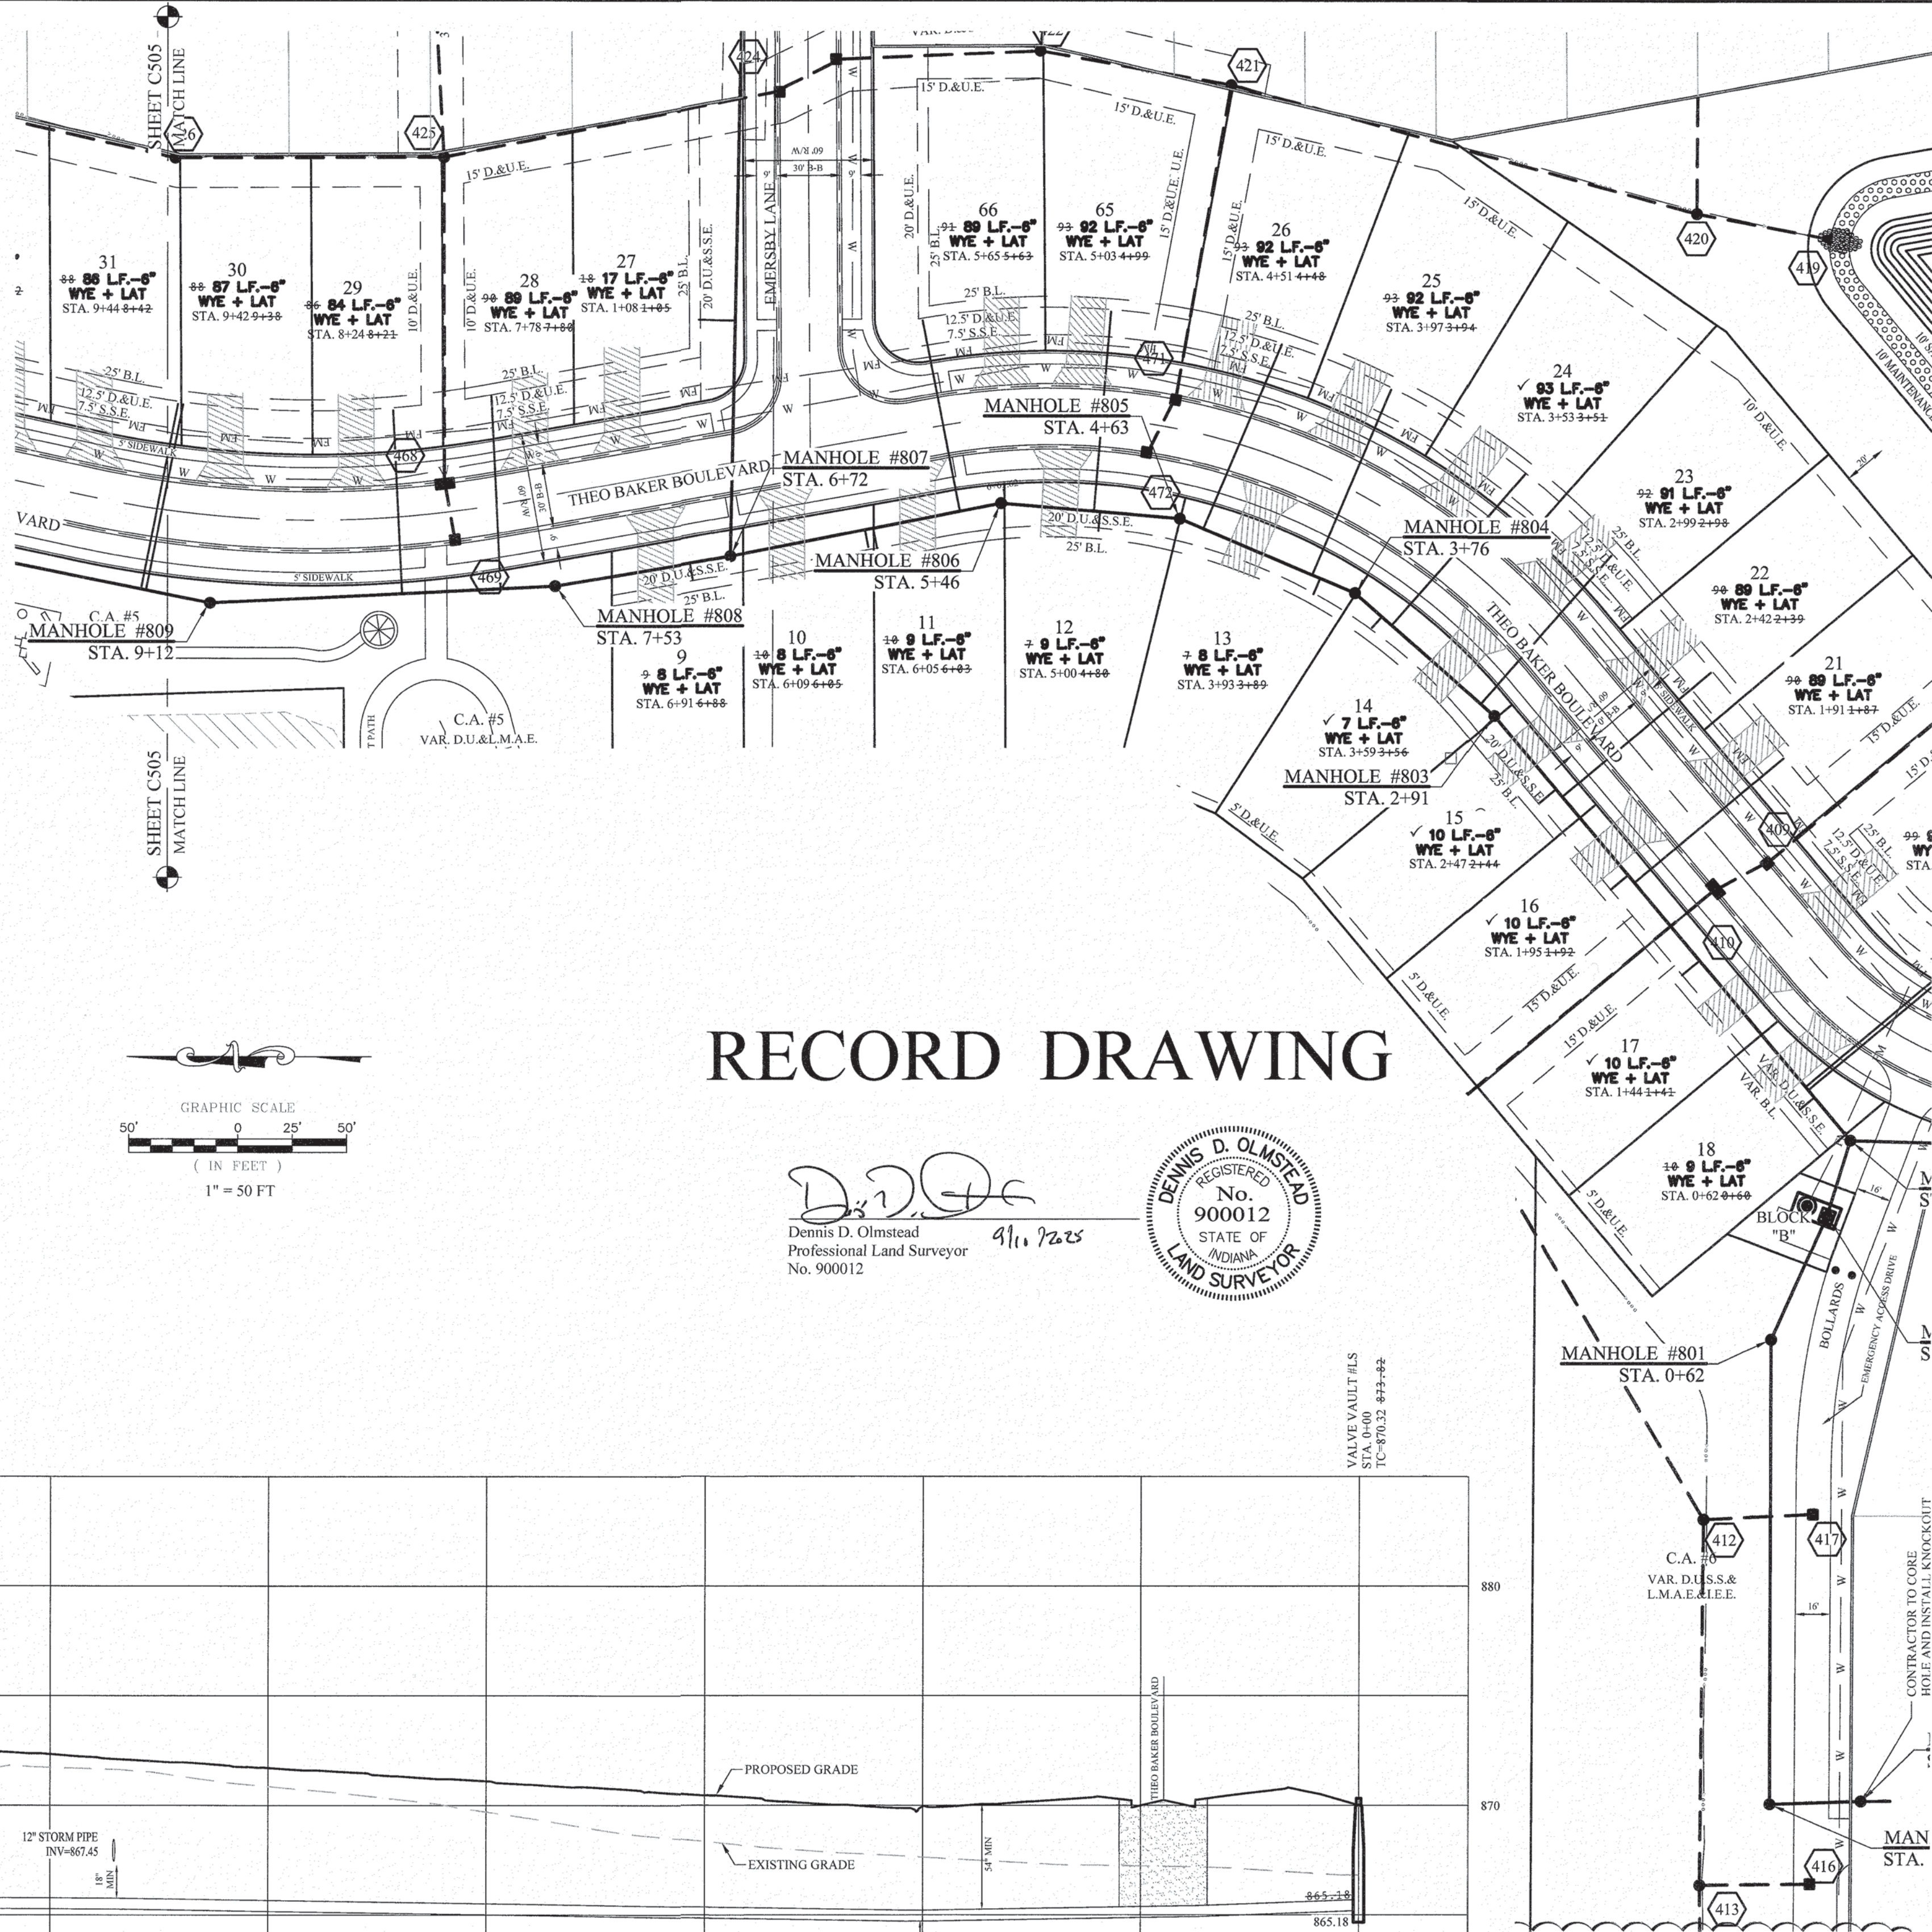


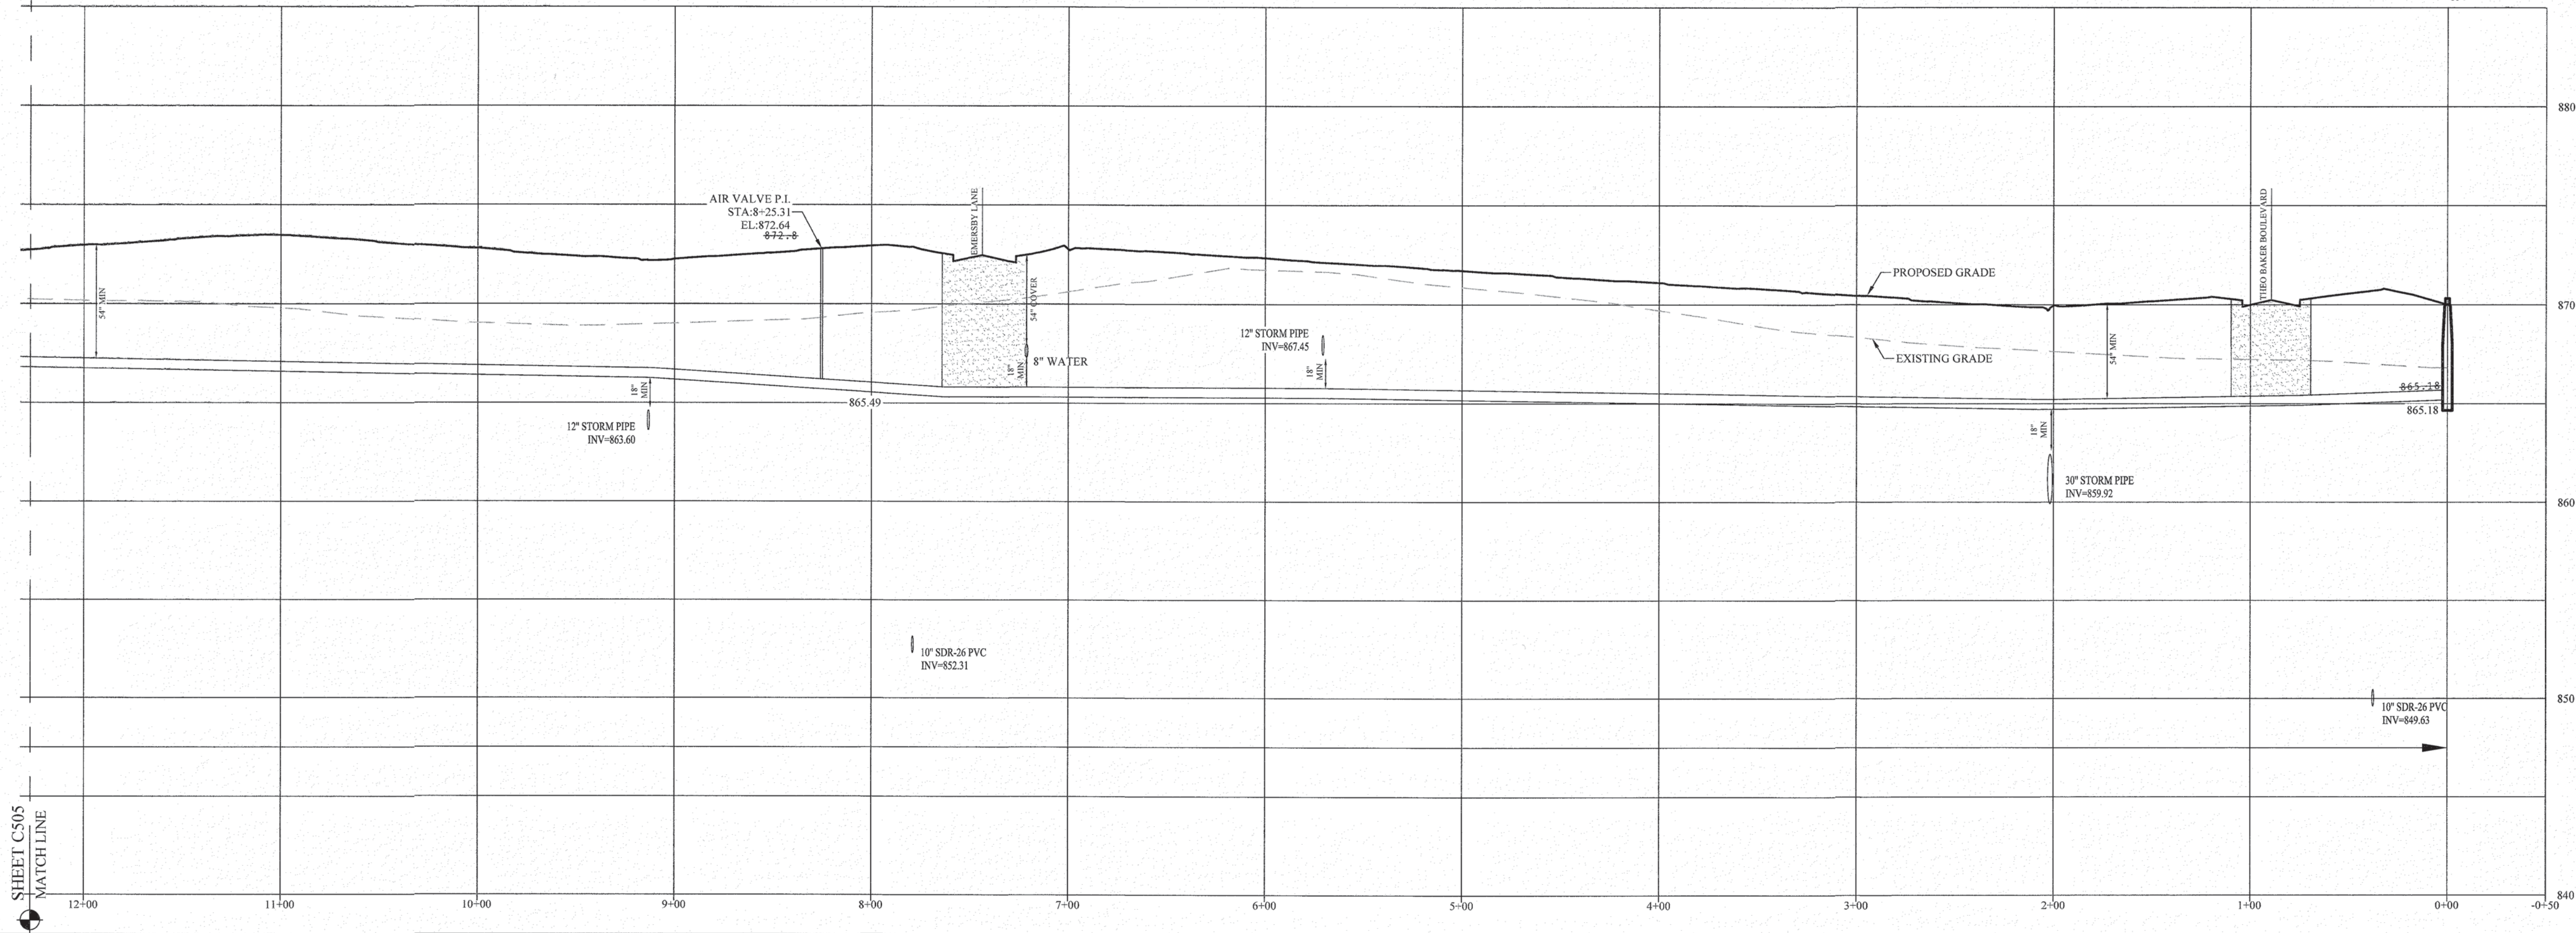

	EXISTING SANITARY SEWER
	EXISTING STORM SEWER
	EXISTING WATER LINE
	PROPOSED SANITARY SEWER (w/ LATERALS)
	PROPOSED STORM SEWER
	PROPOSED WATER LINE
	DENOTES FULL DEPTH GRANULAR BACKFILL

CONTRACTOR SHALL VERIFY DEPTHS OF ALL EXISTING ONSITE UTILITIES PRIOR TO CONSTRUCTION TO CONFIRM THERE IS NOT ANY CONFLICTS WITH OTHER UTILITIES, STORM SEWERS OR STREETS. CONFLICTS AFTER CONSTRUCTION BEGINS ARE SOLELY THE CONTRACTOR'S RESPONSIBILITY.

ALL LATERALS TO BE INSTALLED WITH #12 GREEN TONE WIRE, STARTING FROM THE MAIN.
ALL LATERALS MUST BE MARKED WITH A 4"x4" POST.

MANHOLE INLETS AND OUTLETS SHALLower THAN 15 FEET NEED TO BE SEALED WITH HYDRAULIC CEMENT, ON THE INSIDE. MANHOLE INLETS AND OUTLETS DEEPER THAN 15 FEET NEED TO BE SEALED WITH HYDRAULIC CEMENT, BOTH INSIDE AND OUTSIDE.

RECORD DRAWING


Dennis D. Olmstead
Professional Land Surveyor
No. 900012



SANITARY SEWER PLAN & PROFILES

**BAKER'S POINTE
SECTIONS 1A & AB**

PENDLETON, FALL CREEK TOWNSHIP
MADISON COUNTY, INDIANA

THIS DRAWING IS NOT INTENDED TO BE REPRESENTED AS A RETACEMENT OR ORIGINAL BOUNDARY SURVEY, A ROUTE SURVEY OR A SURVEYOR LOCATION

CERTIFIED: 05/06/24

STOEPPELWERTH

ALWAYS ON

965 East 106th Street, Fishers, IN 46038-2505

AS BUILTS	DATE	MARK	REVISIONS	BY	M/E
	09/09/25				
	22/26/25		REVISED PER FUTURE C.R. W. 400 S. IMPROVEMENTS		GEM
	09/25/24		REVISED HANDICAP RAMPS AT ENTRANCE TO S.R. 36/400D F.H.		GEM
	28/27/24		REVISED PER REVIEW COMMENTS		GEM
	27/09/24		REVISED PER REVIEW COMMENTS		GEM
	06/06/24		UPDATED TO NEW DRAINAGE ORDINANCE		KROGEM
	DATE	MARK	REVISIONS	BY	



THIS DRAWING IS NOT INTENDED TO BE REPRESENTED AS A RETRACEMENT OR ORIGINAL BOUNDARY SURVEY, A ROUTE SURVEY OR A SURVEYOR LOCATION REPORT.

CERTIFIED: 05/06/24

[Signature]