


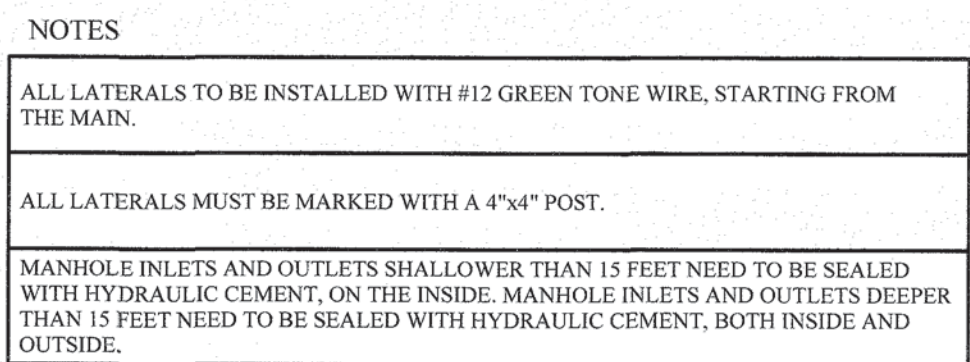

PENDLETON, FALL CREEK TOWNSHIP

ALWAYSON
1965 East 106th Street, Fishers, IN 46038-2505
phone: 317.849.5935 fax: 317.849.5942

CERTIFIED: 05/06/24

[illegible]