



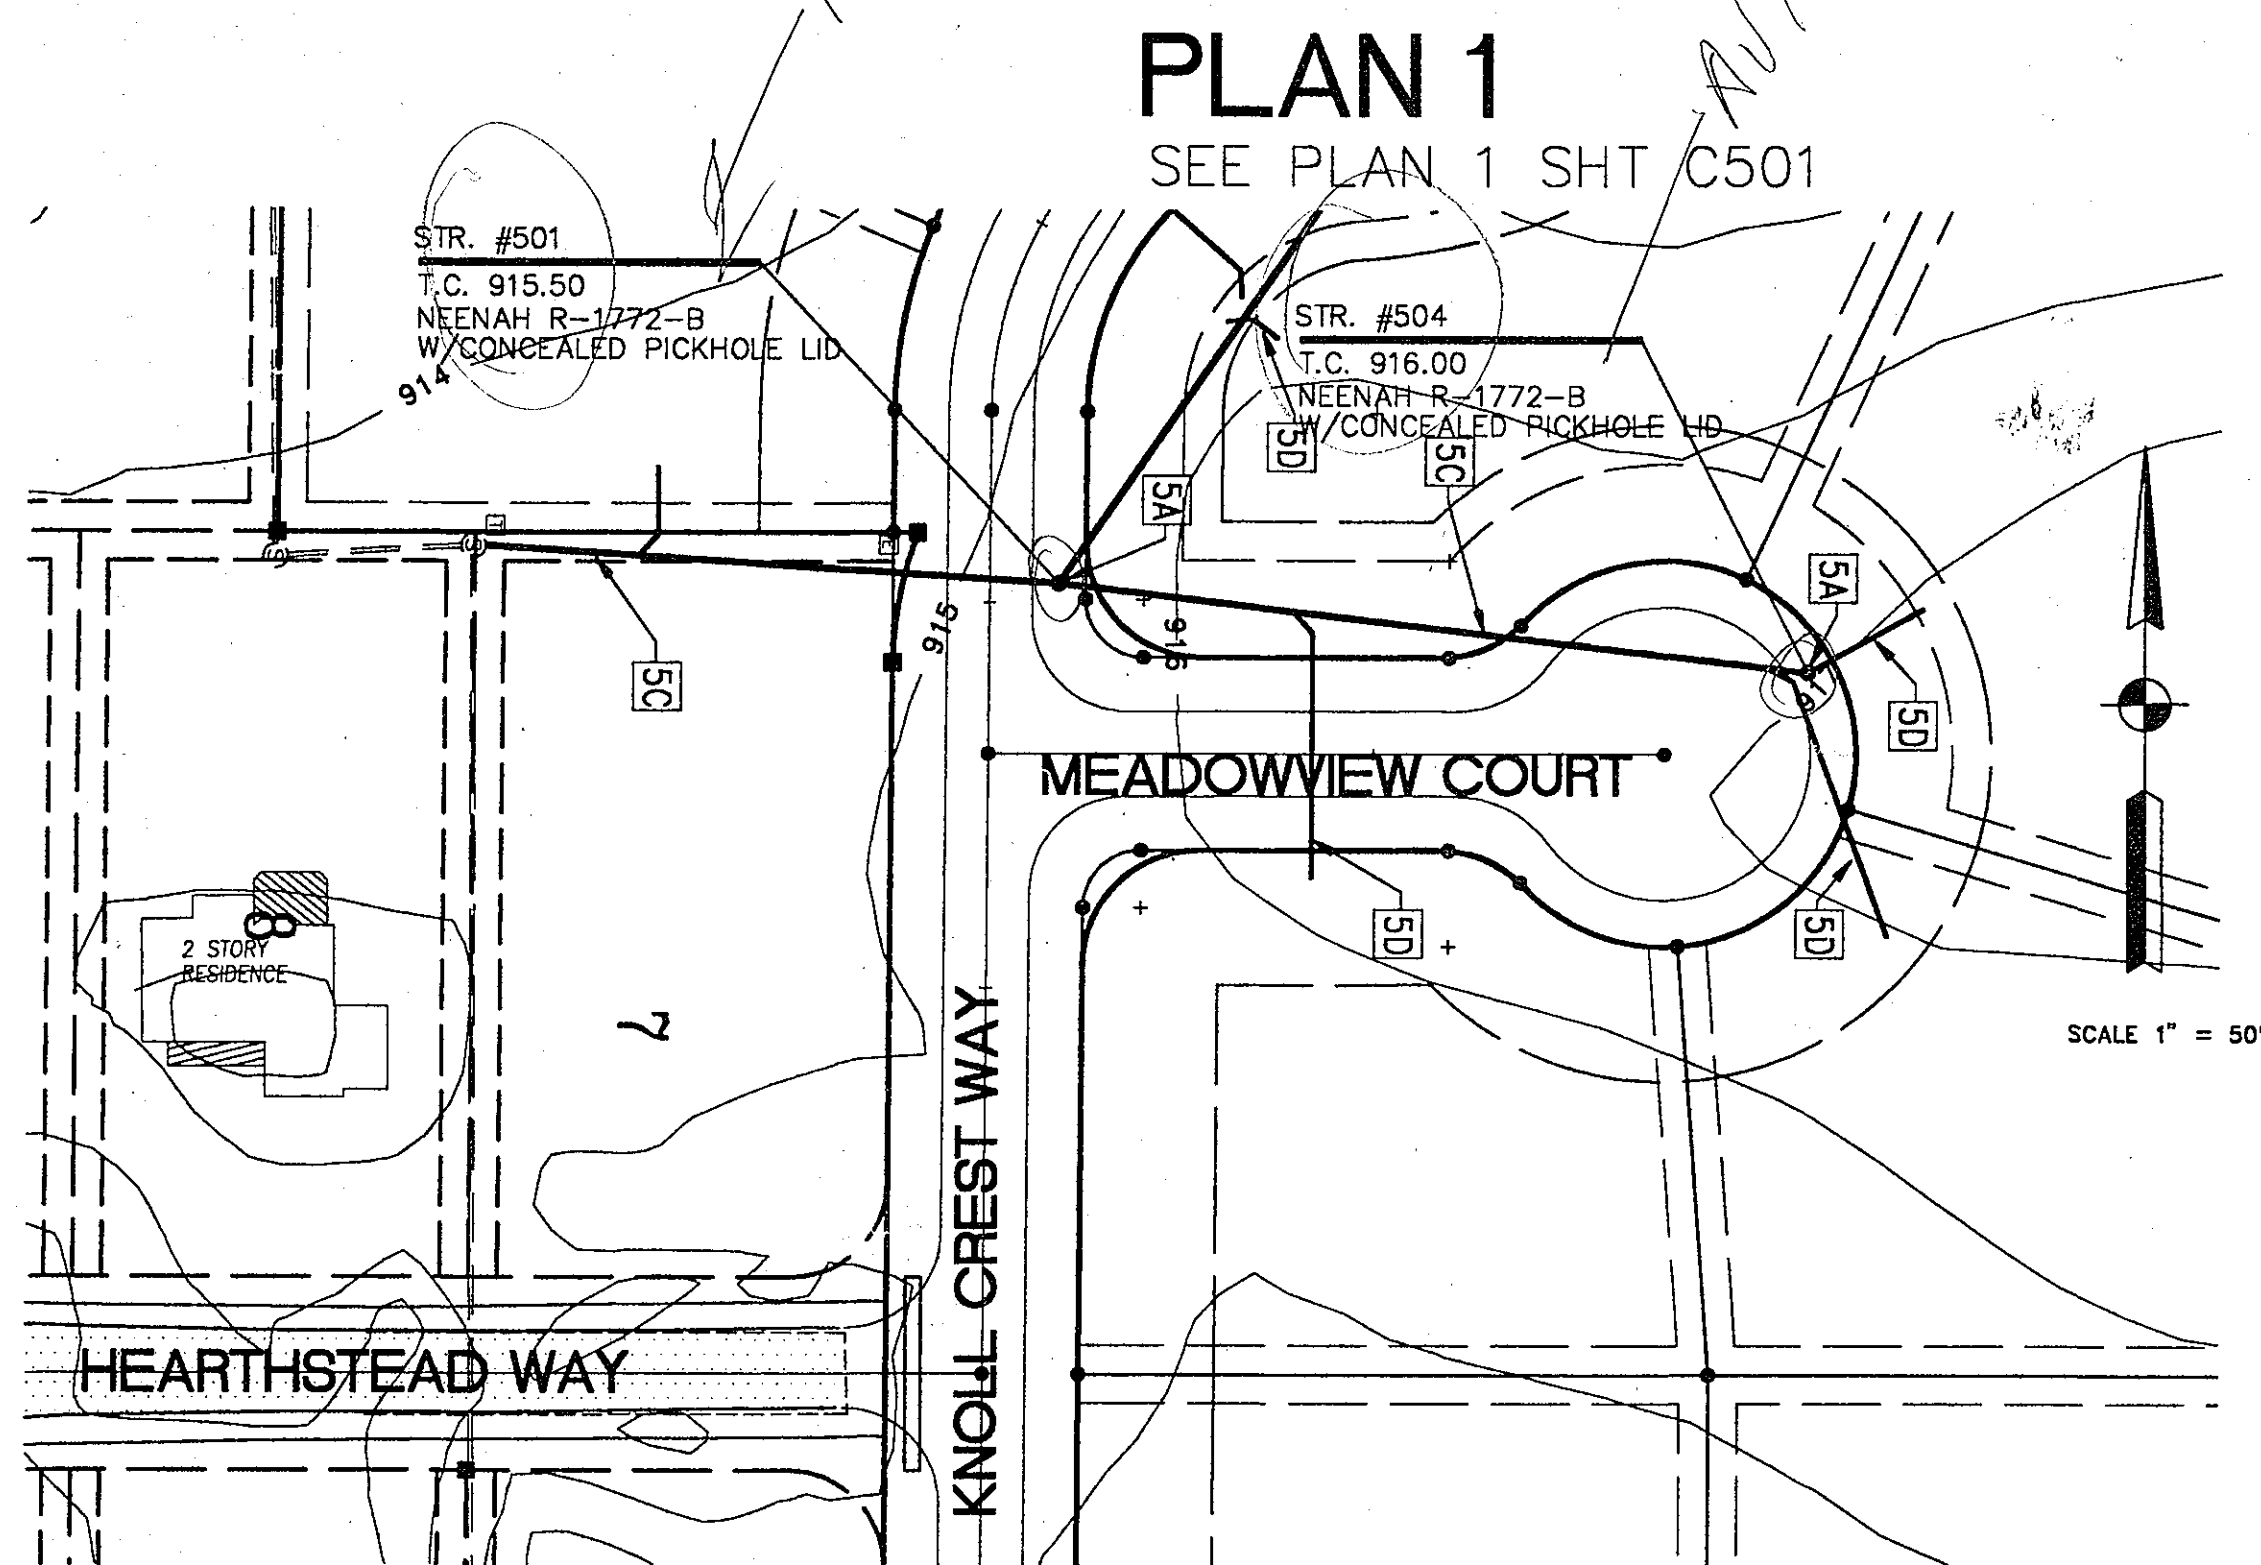


PLAN 2

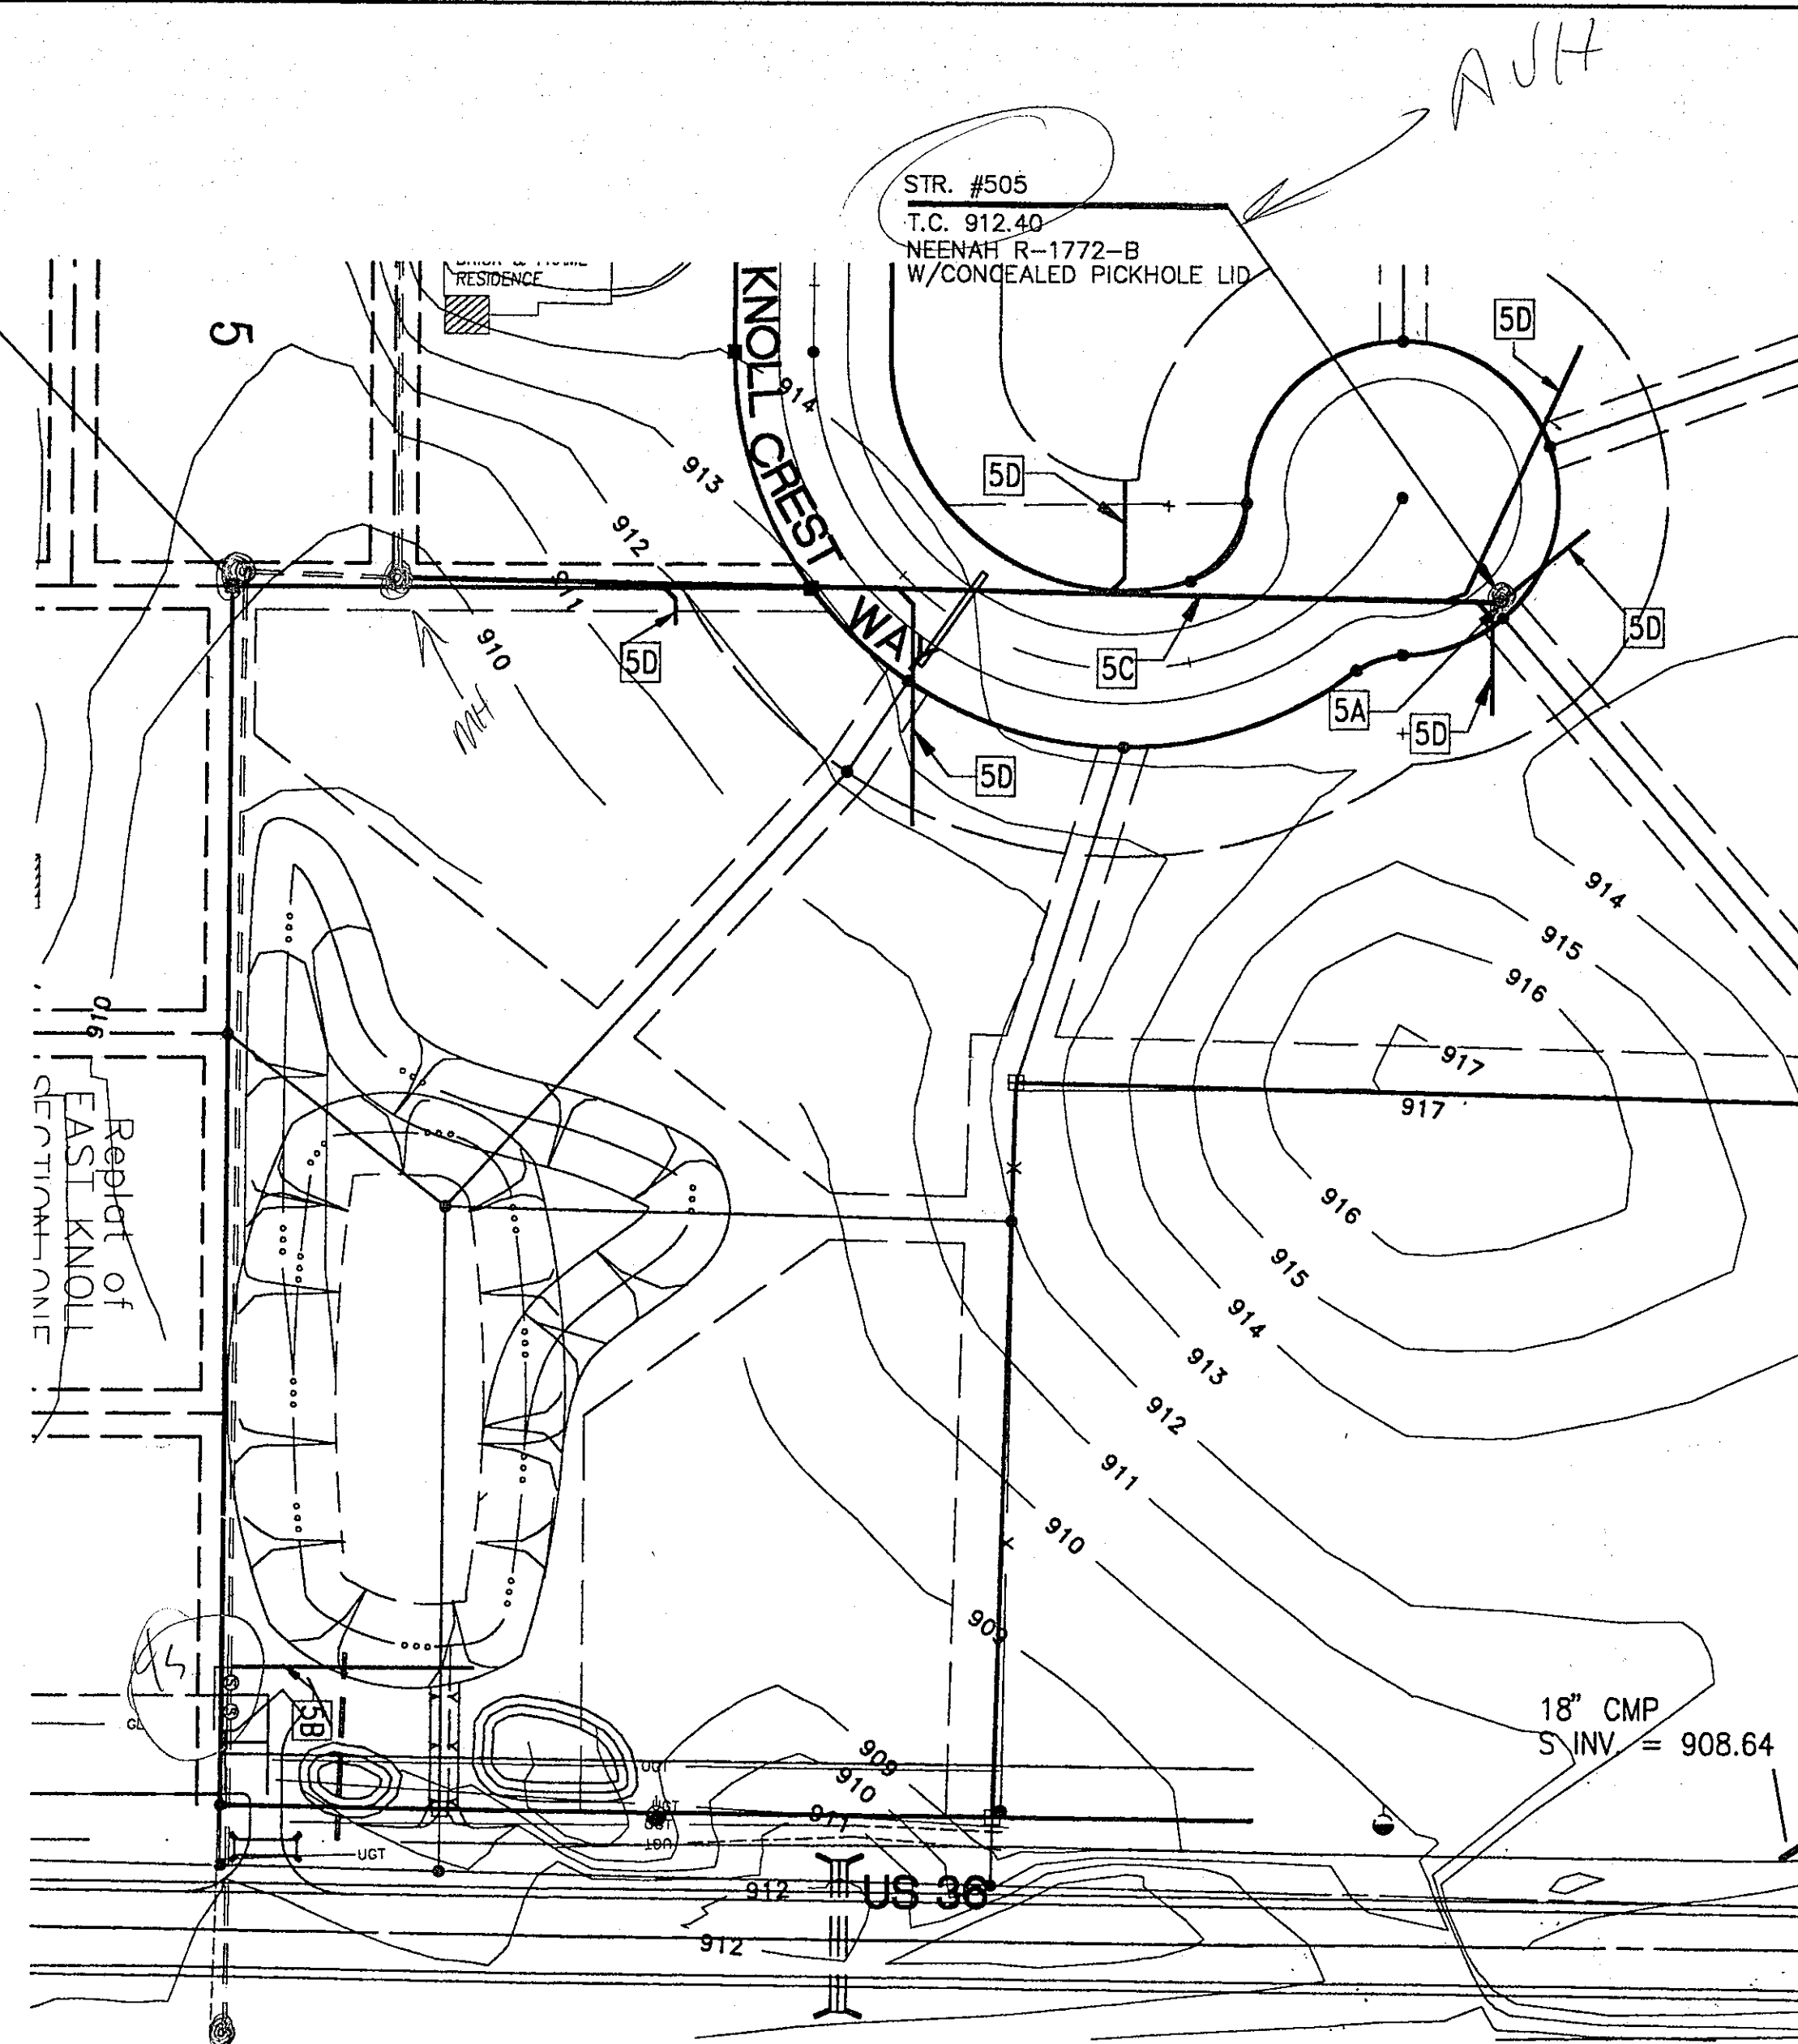


PLAN 3


- MINIMUM STANDARDS FOR SANITARY SEWER INSTALLATION**
1. Contractor shall maintain a minimum of 0.40% slope for all 8" sanitary sewer lines.
 2. Contractor shall maintain a maximum spacing between manholes of 500'.
 3. All castings shall be Neenah R-1772-AVH with concealed pick-hole lid.
 4. Contractor shall maintain a minimum depth of 5'-0" for all sanitary sewer line.
 5. Contractor shall maintain a 0.10' drop across manholes.
 6. All stationing shown on Plans is from the nearest downstream manhole.
 7. See Details for pipe bedding sections.
 8. Contractor shall be responsible for notifying engineer of any discrepancies prior to commencement of work.
 9. Contractor shall verify that all permits have been obtained prior to commencement of work.
 10. Contractor shall give 24hr notice to Flood Dept + Start up.

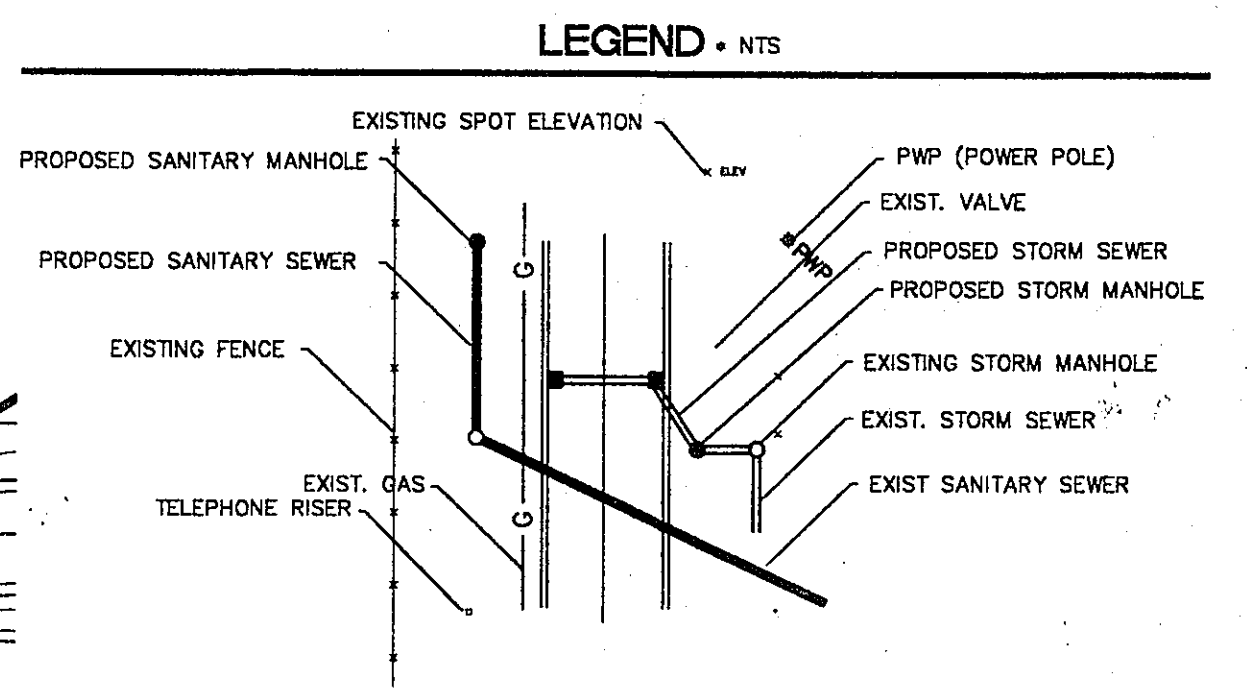



- KEYNOTES**
- 1A LANDSCAPE MOUNDING (TYP.)
 - 1B EMERGENCY SPILLWAY (SEE DETAIL 3B SHT C801)
 - 1C AGGREGATE PAVEMENT (SEE DETAIL 1A C801)
 - 2A RIP-RAP (SEE DETAIL 2A SHT C802)
 - 2B TYPICAL SWALE (SEE DETAIL THIS SHT)
 - 2C SPECIAL SWALE (SEE DETAIL THIS SHT)
 - 3A STANDARD H.A.C. PAVEMENT (SEE DETAIL 1A C801)
 - 3B LIFT STATION ACCESS ROAD (SEE DETAIL 3B SHT C801)
 - 4A STANDARD STORM MANHOLE (SEE DETAIL 4A SHT C801)
 - 4B 12" C.M.P.
 - 4C 15" C.M.P.
 - 4D 24" X 42" CMP (SEE DETAIL 4B SHT C901)
 - 5A STANDARD SANITARY MANHOLE (SEE DETAIL 5A SHT C801)
 - 5B 6" PVC LATERAL INTO EXISTING SEWER (SEE DETAIL 5B SHT C801)
 - 5C 8" PVC SEWER (SEE DETAIL SHT C901)
 - 5D 6" PVC LATERAL (SEE DETAIL 5D SHT C801)
 - 5E EXTERIOR CLEANOUT (SEE DETAIL 5D SHT C801)

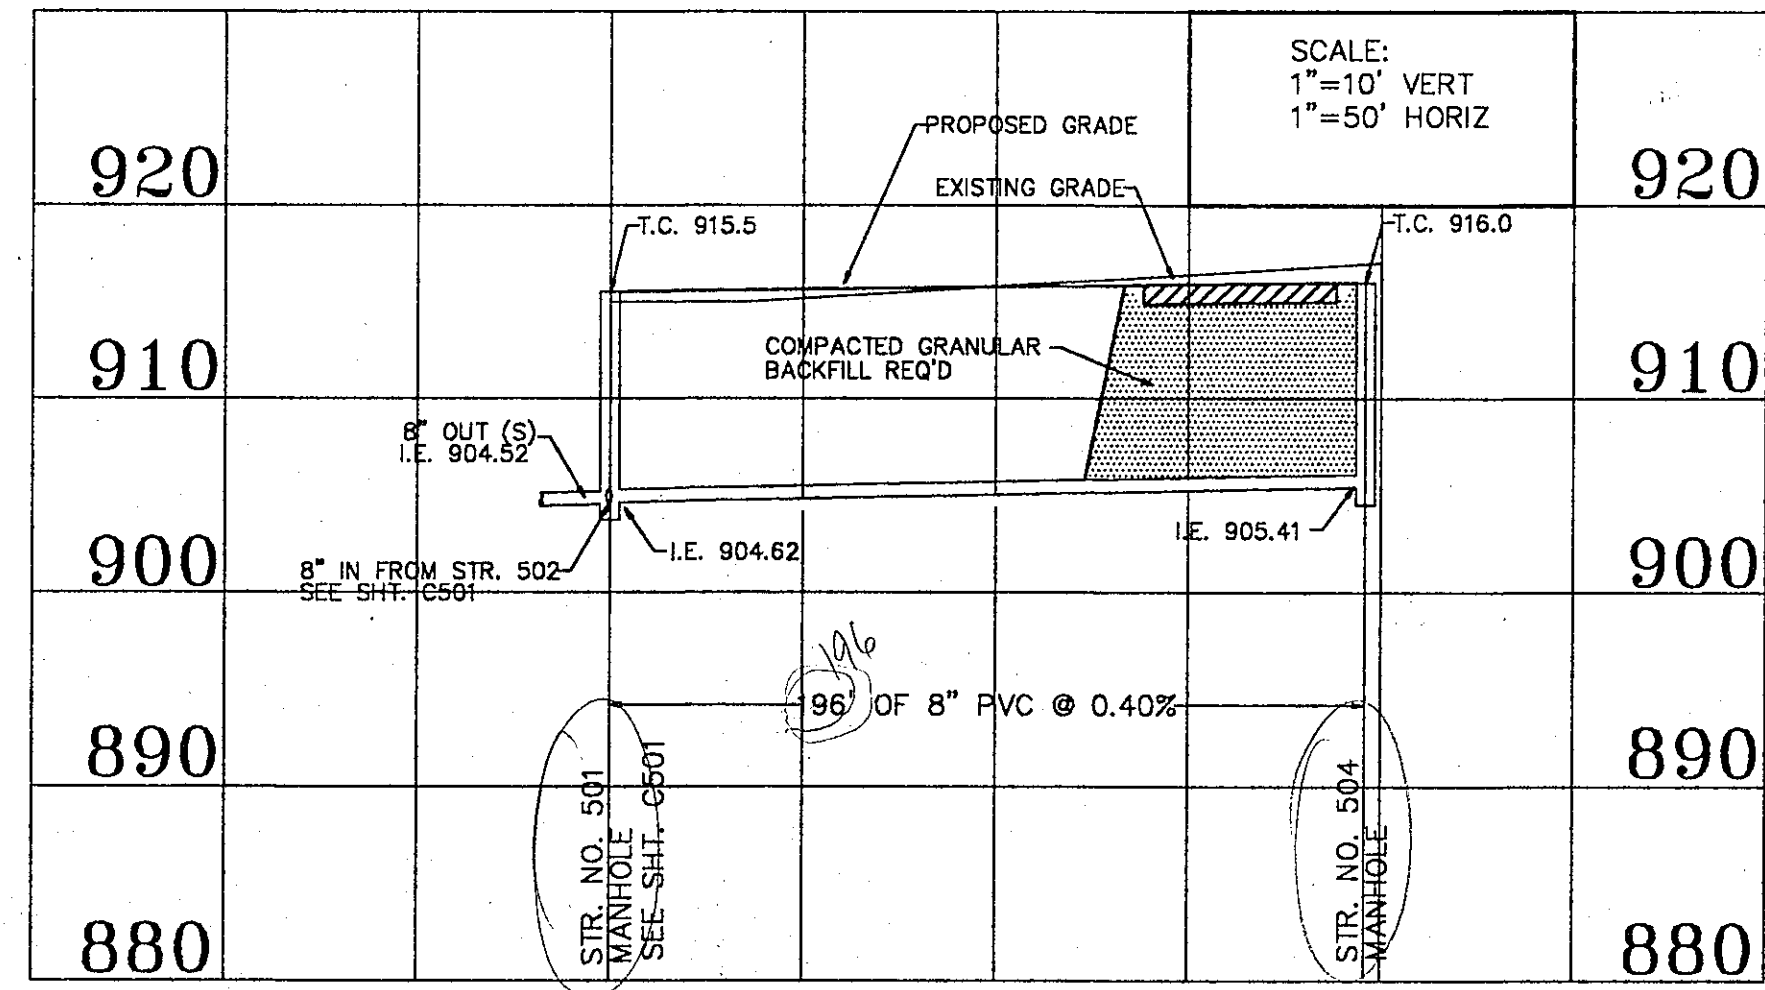

PROFILE 2

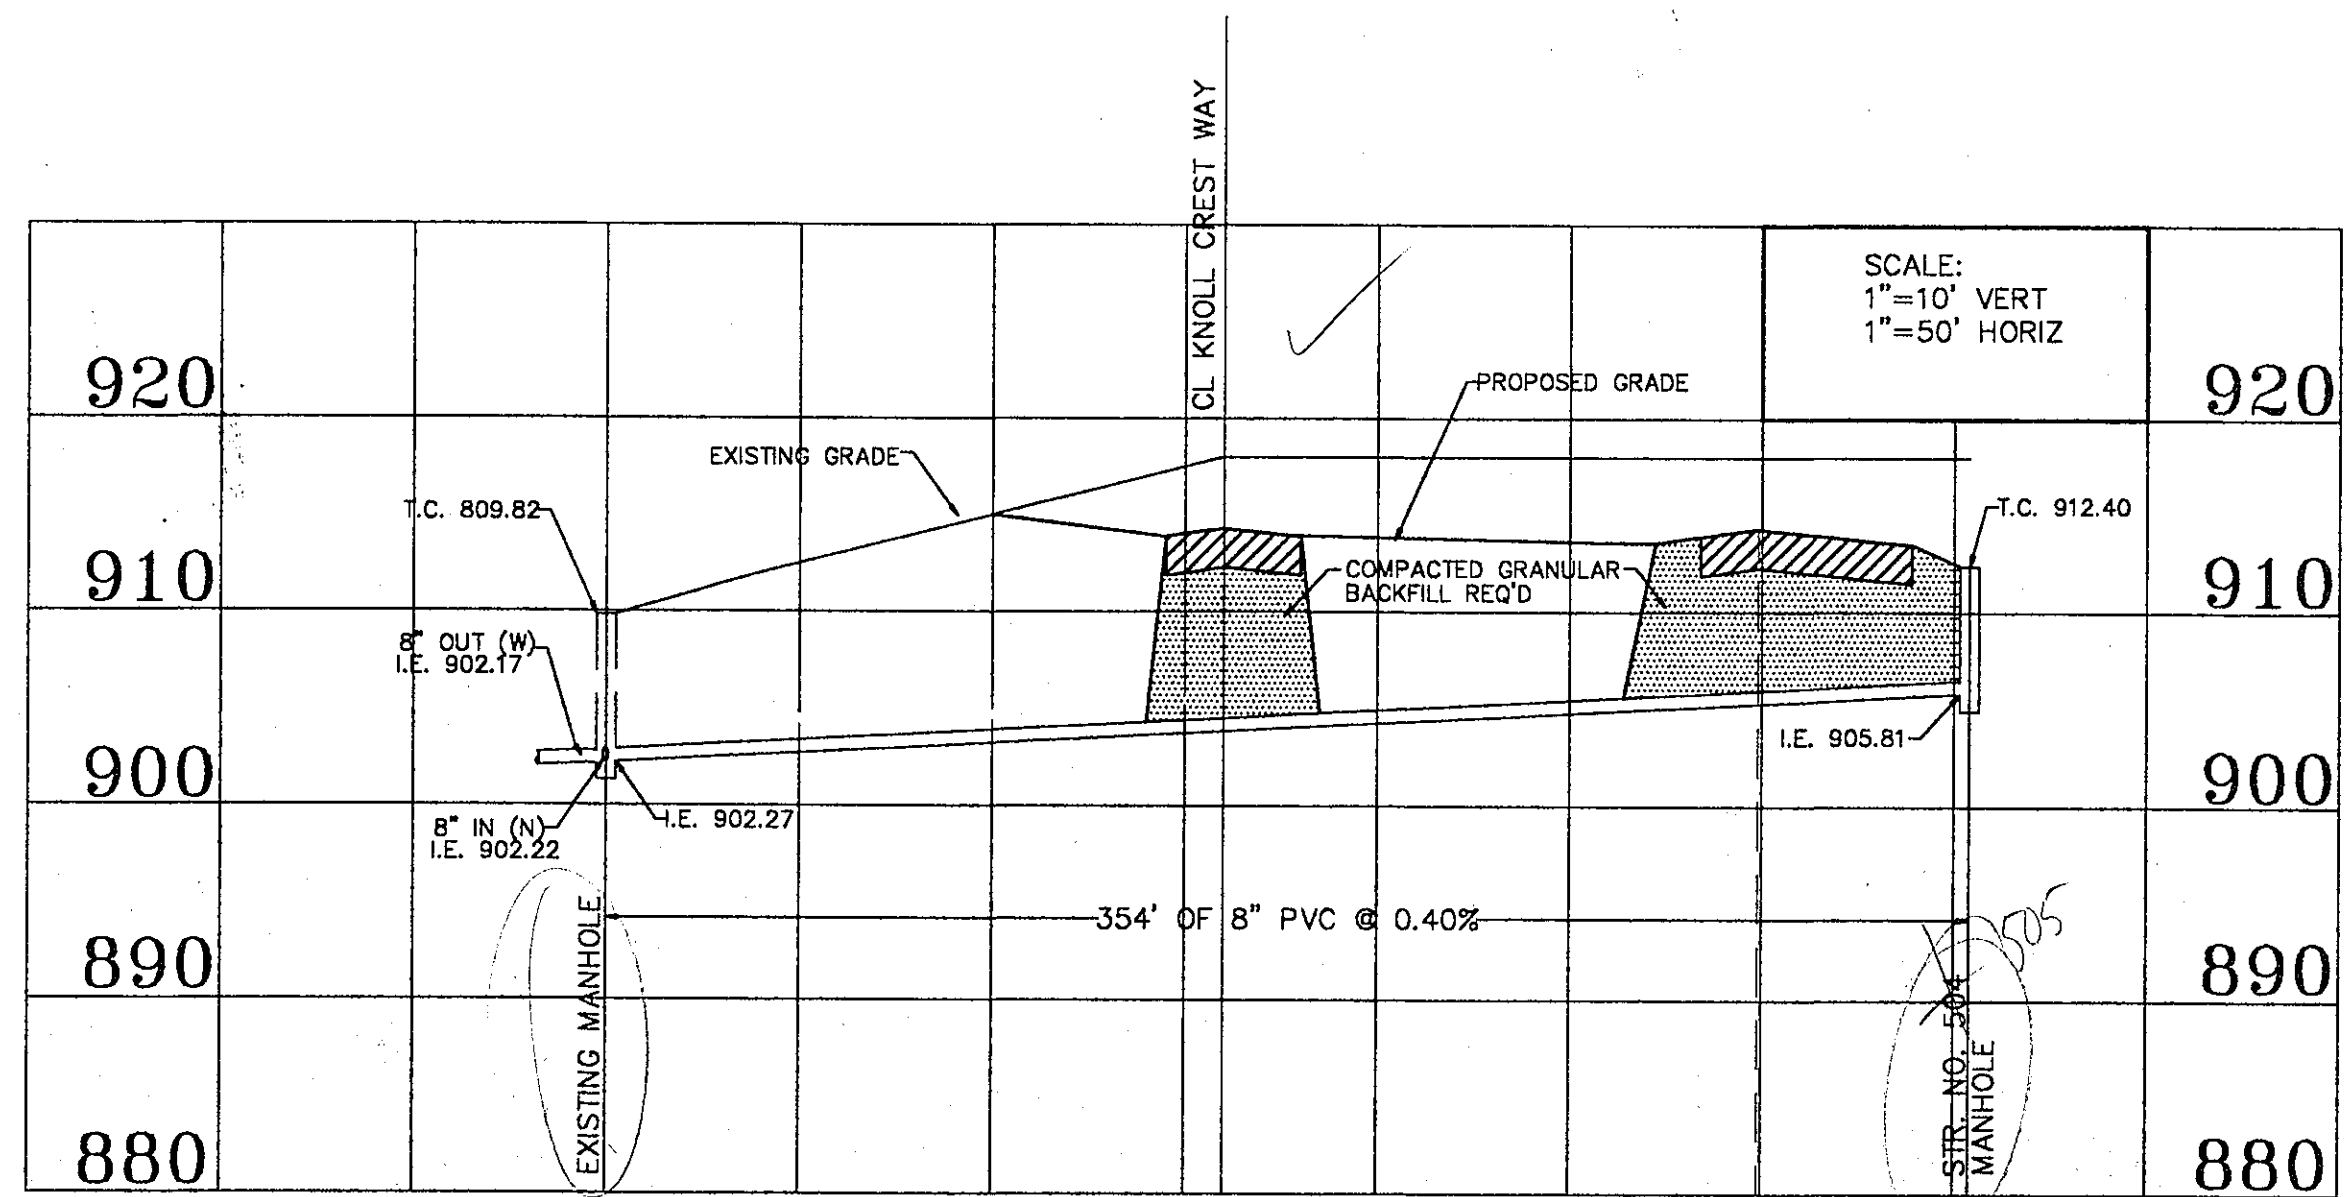

PROFILE 3

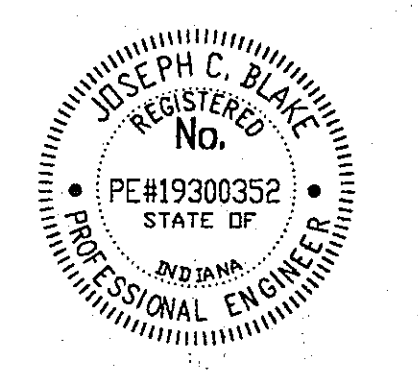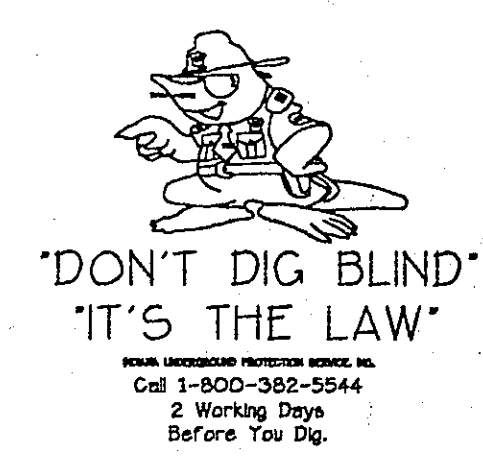

SANITARY SEWER PLAN + PROFILE

Architectural Services And Permits
P.O. BOX 414
PENDELTON, IN 46084
(317) 778-4070
(317) 778-4085 (FAX)
DRAFTING CONSULTING PERMITS

Pendleton Consulting
P.O. Box 67 Indiana 46084-0067
Pendleton, IN 46084
Phone/Fax (317) 778-4646

DEVELOPED BY:
BLAKE DEVELOPERS
6569 West 100 South
New Palestine, IN 46163

REVISION LOG

1	DATE: 4-07-95
2	FILE: 95506502
3	SHEET NO.
4	C502
5	JOB NO. 95506

DATE: 4-07-95
FILE: 95506502
SHEET NO.
C502
JOB NO. 95506