




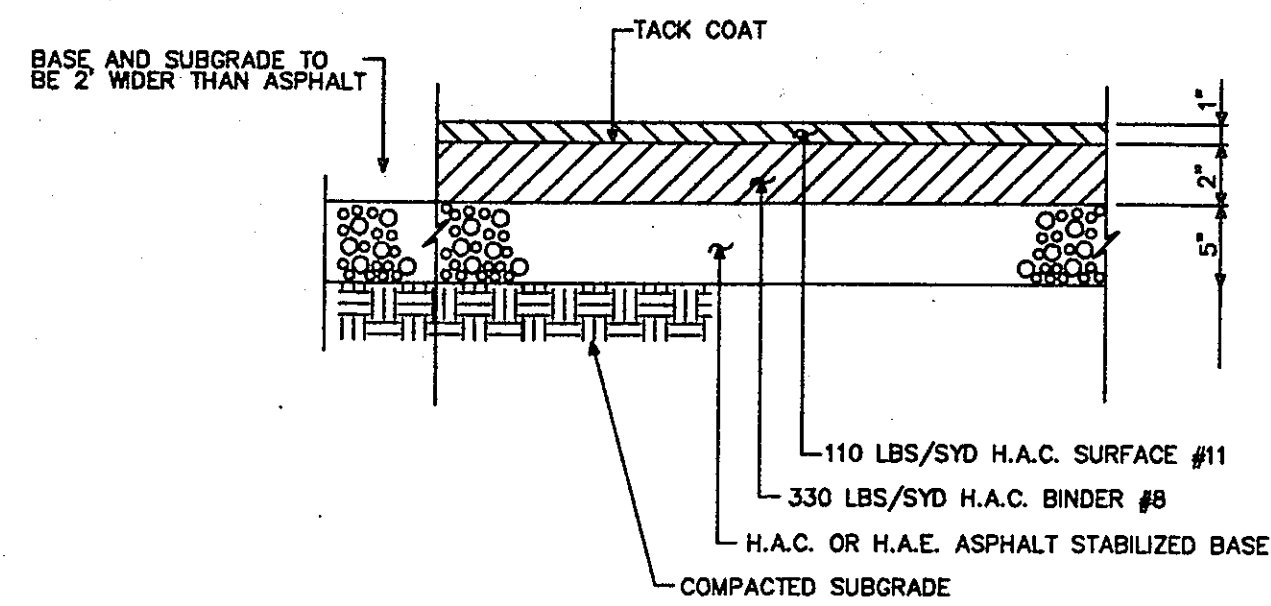

STANDARD H.A.C. PAVEMENT
NOT TO SCALE

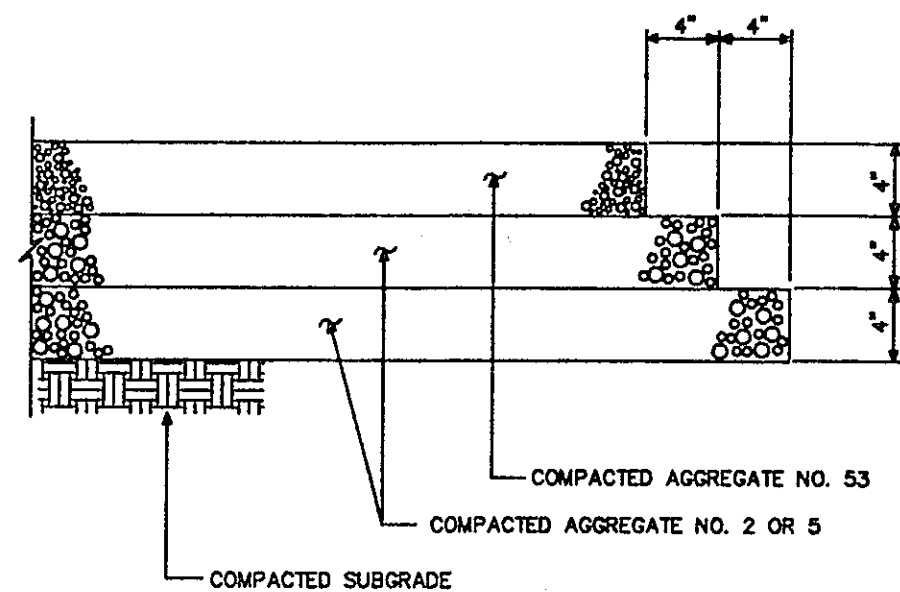


AGGREGATE PAVEMENT
NOT TO SCALE

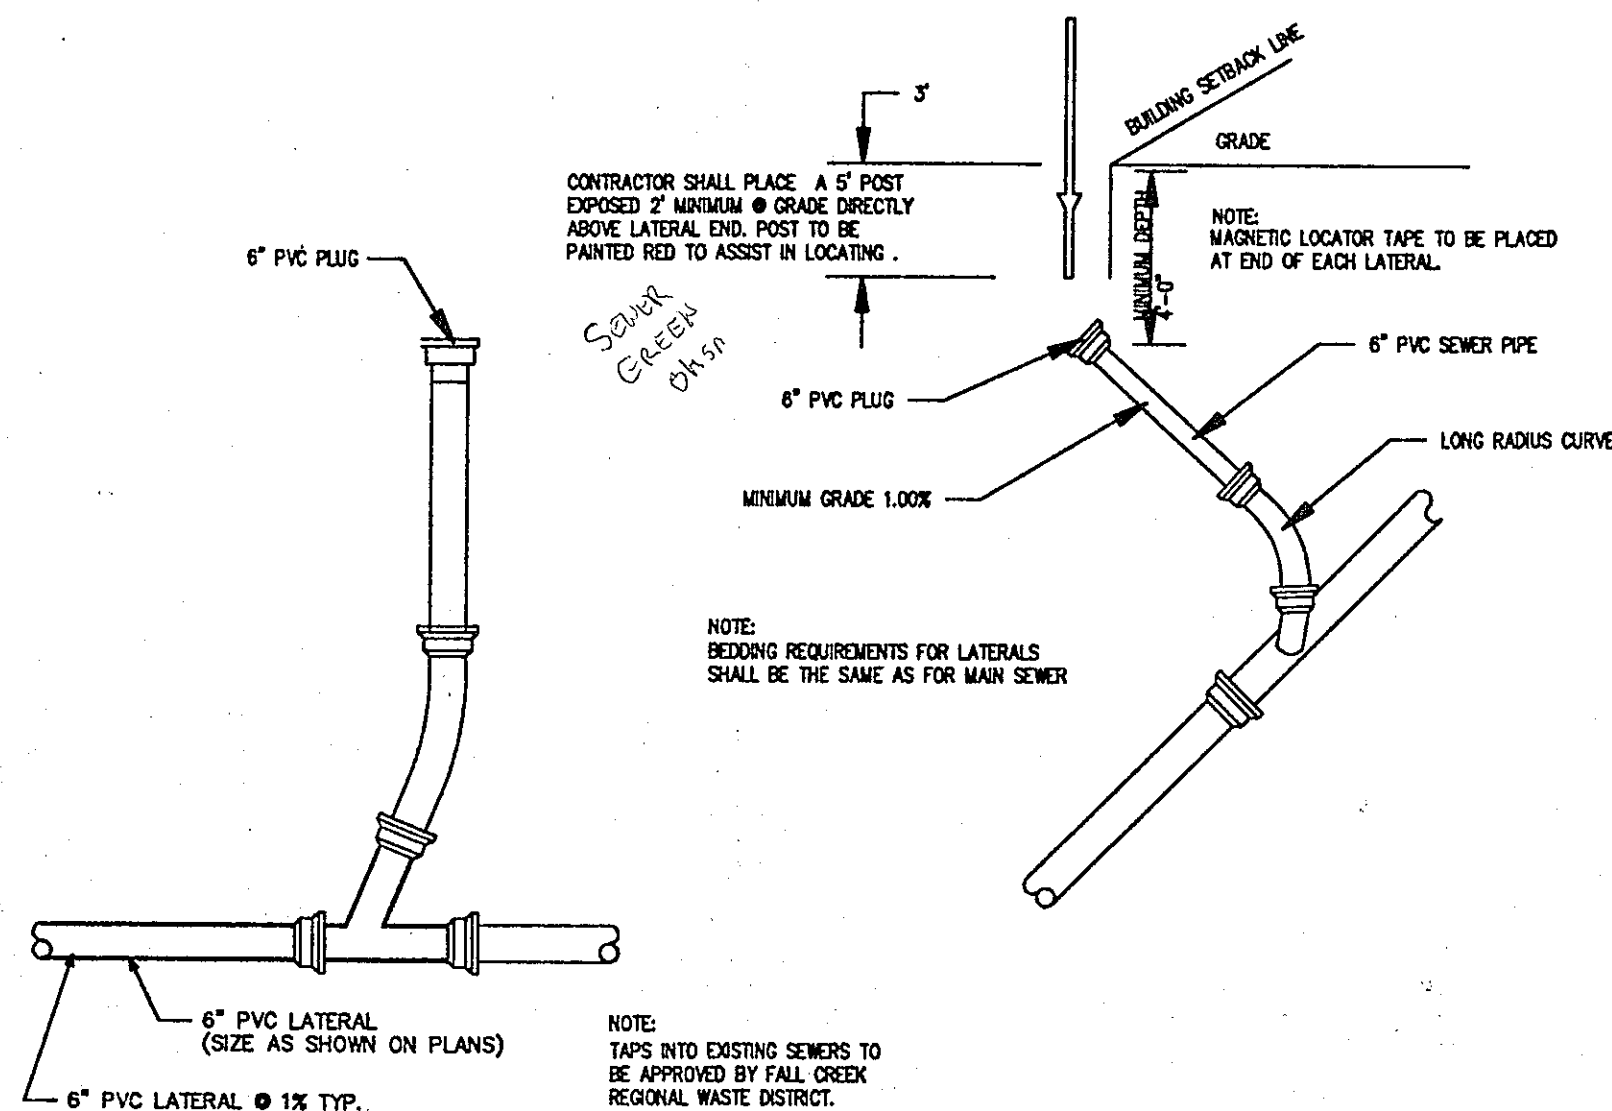


PLAN

ISOMETRIC

DETAIL
NOT TO SCALE

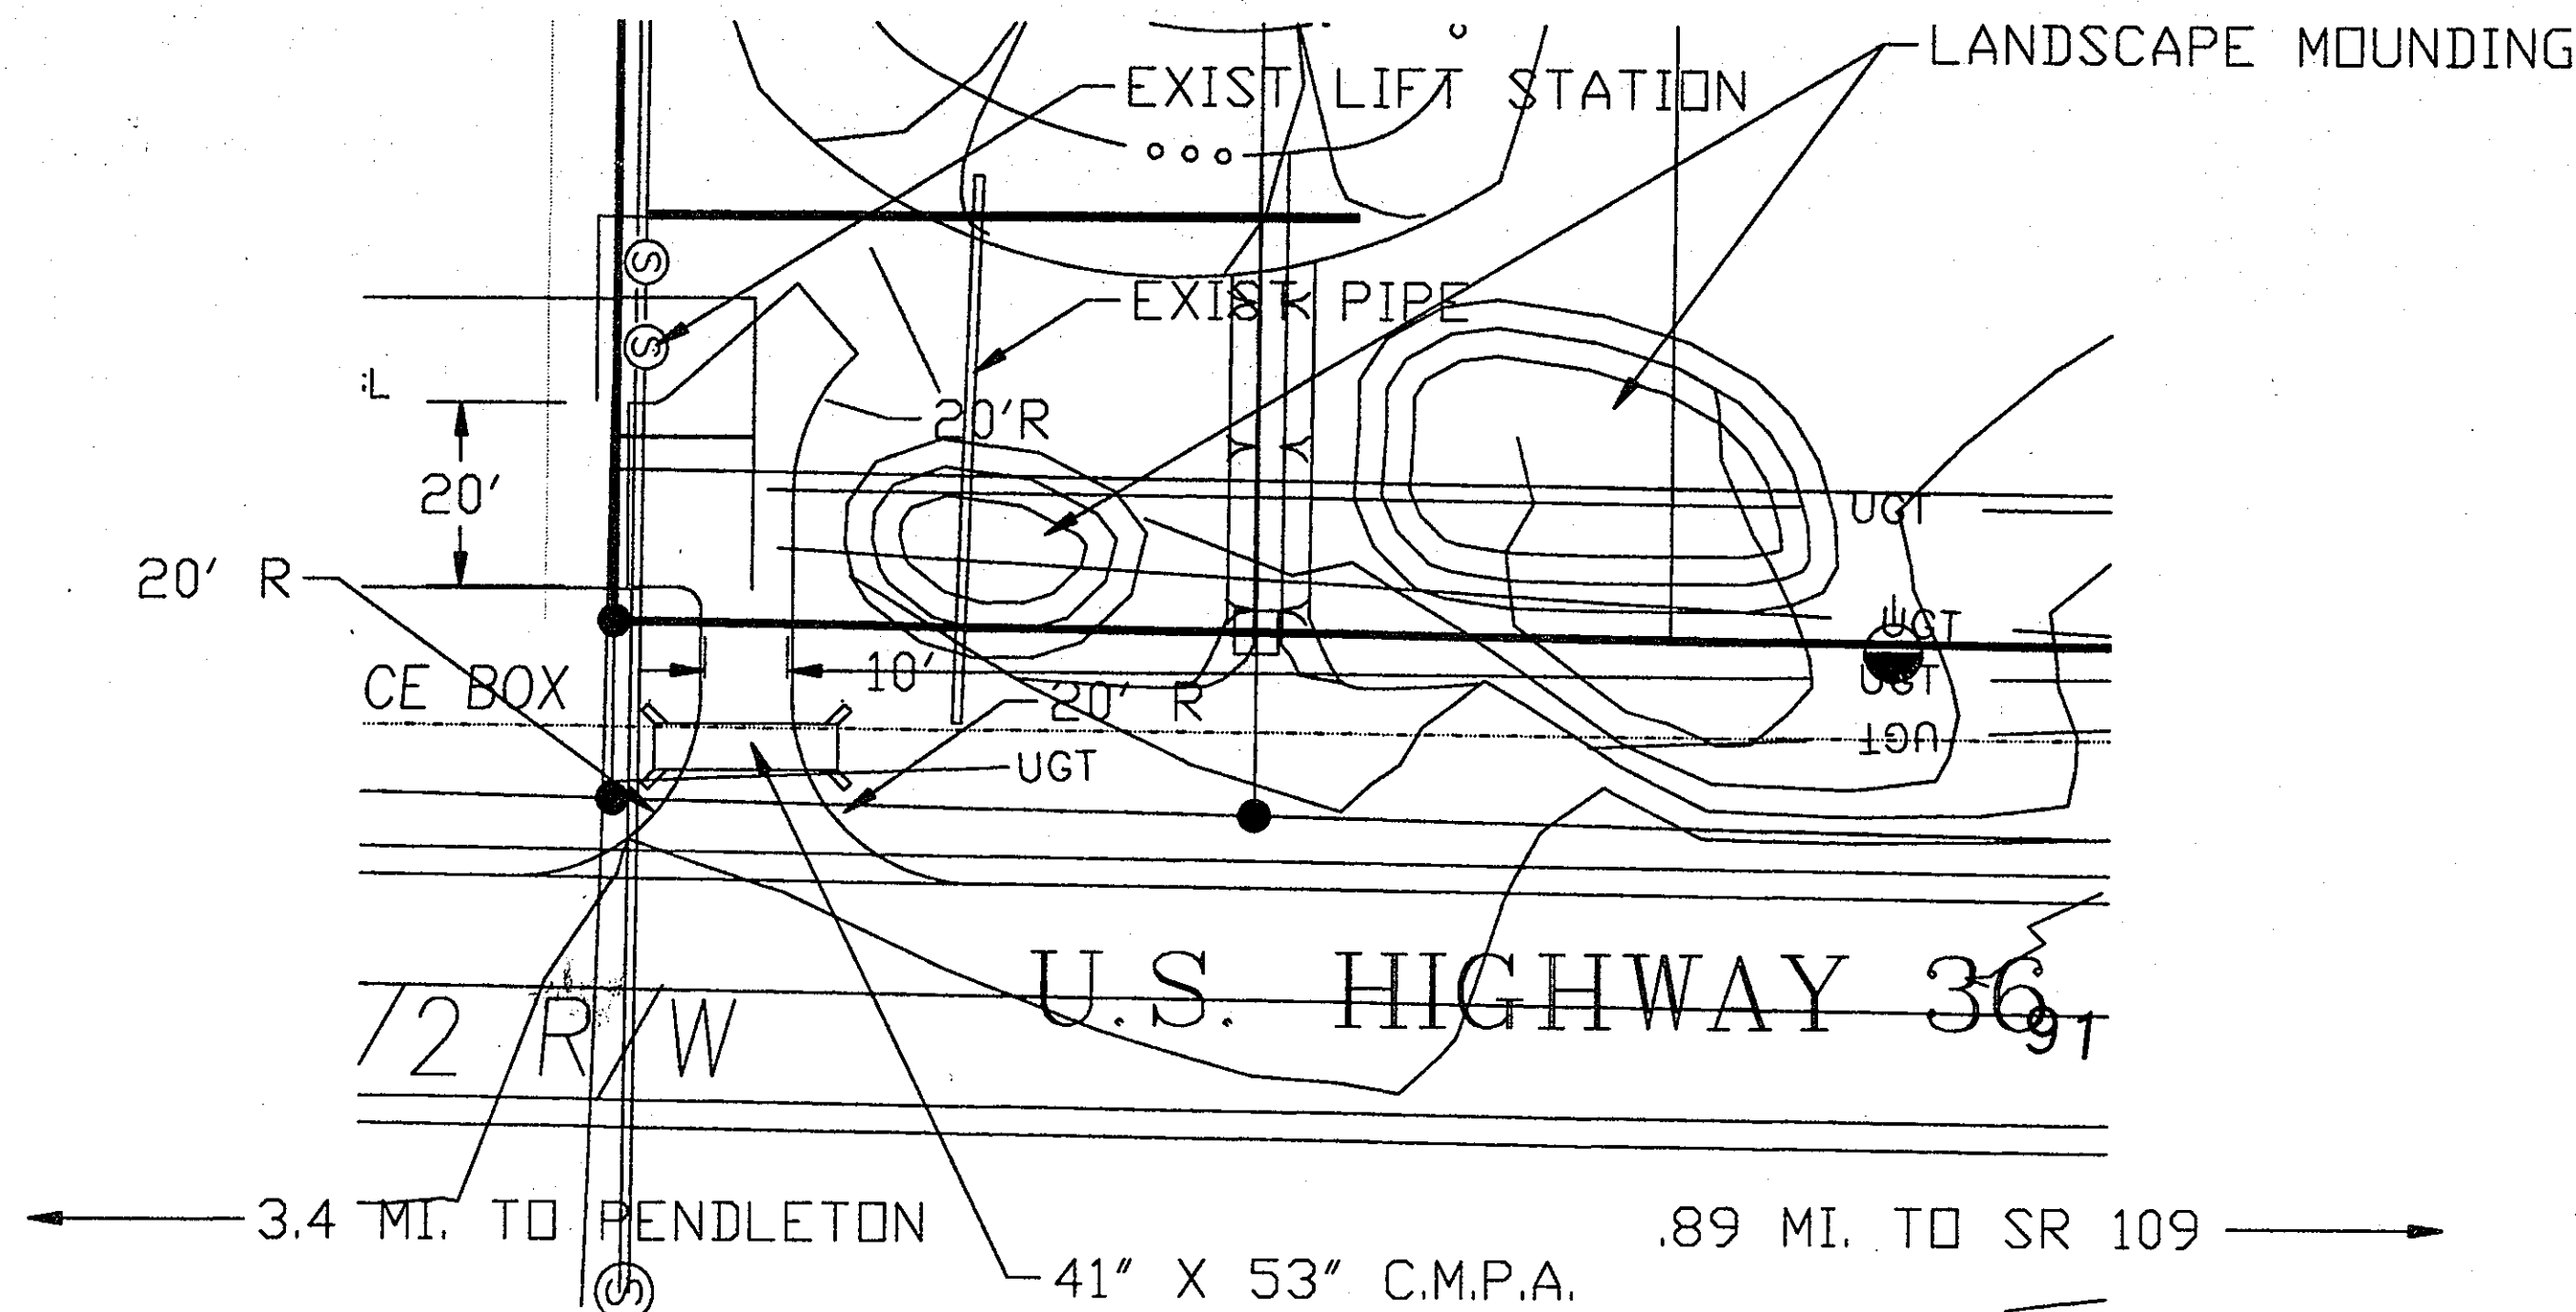

LIFT STATION ACCESS ROAD
NOT TO SCALE

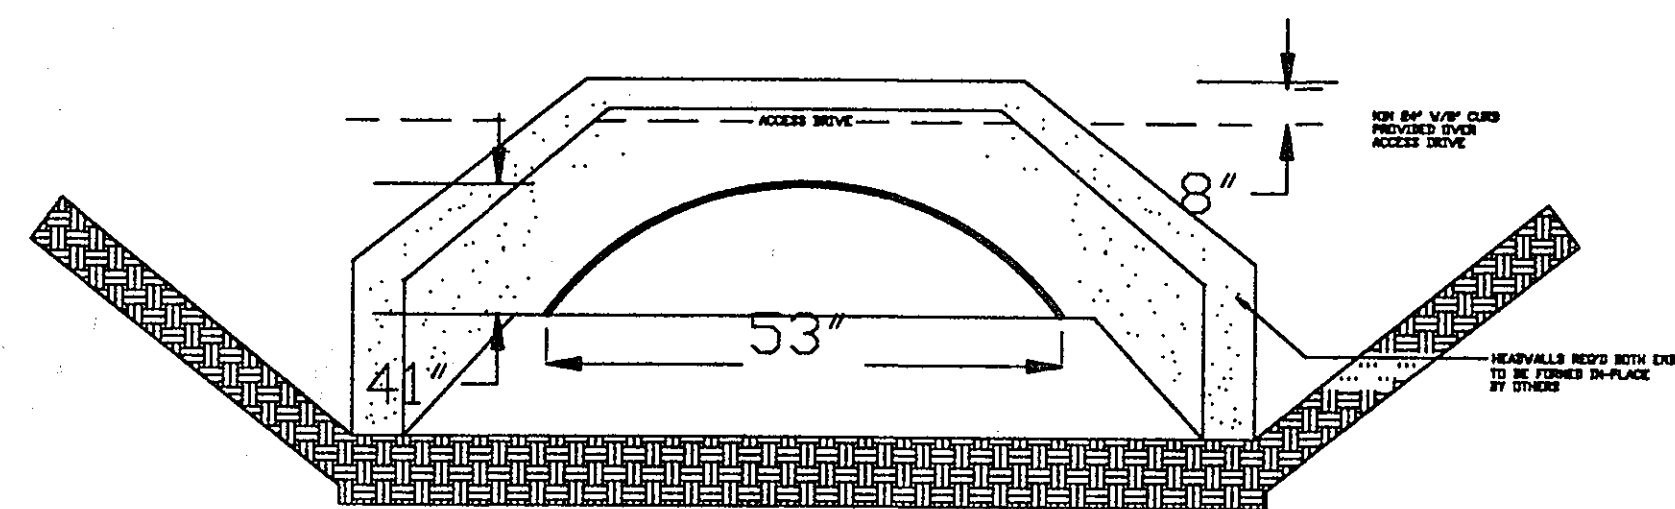

CORRUGATED METAL PIPE ARCH
NOT TO SCALE



**R-1772 Series
Manhole Frames, Solid Lids**

Heavy Duty.
Specify:
1. Machined or non-racking bearing surfaces.

Catalog No.	Standard Design	Machined Horizontal Vertical Bearing	D	Wt. Lbs.
R-1772			25	250
R-1772-A			25	285
R-1772-B			25	325
R-1772-C			24	355


*Machined with plates h.d. - similar to R-1700-1

NEENAH
FOUNDRY COMPANY

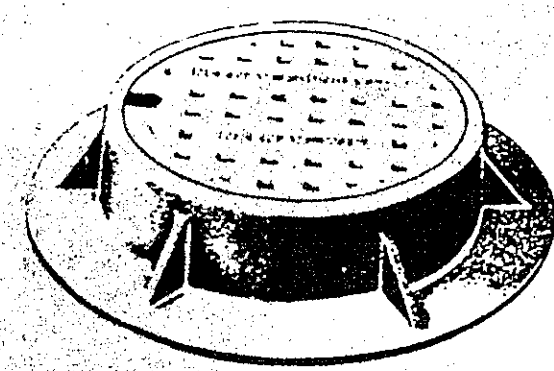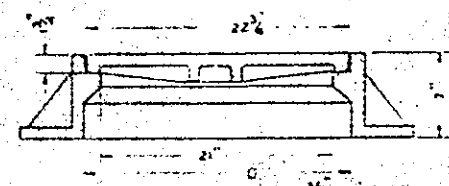


Machined Horizontal Vertical Bearing Surface
NEENAH R-1772-AVH

NEENAH R-1772-AVH
NOT TO SCALE

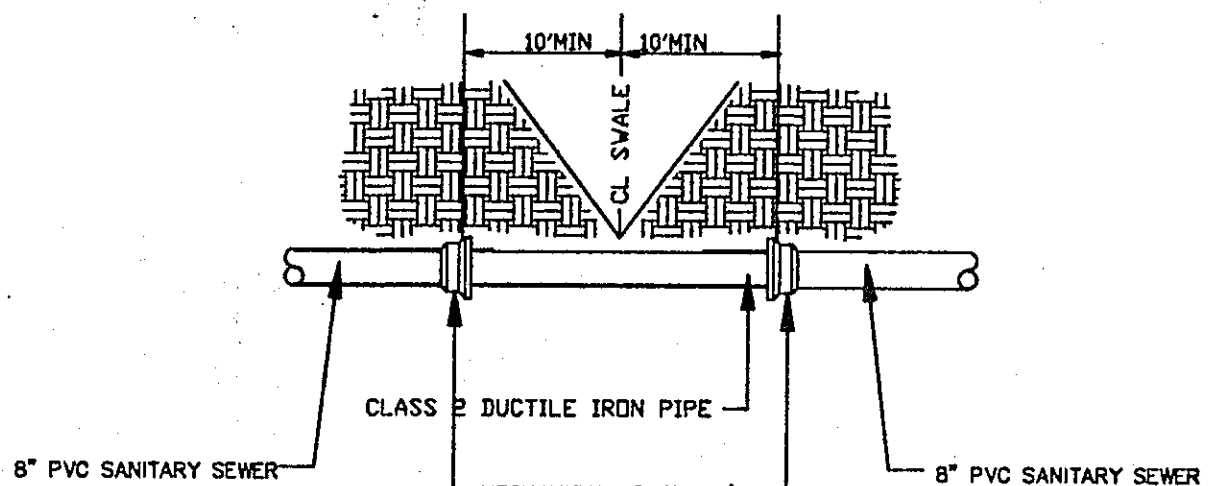


PROFILE



DUCTILE IRON PIPE
NOT TO SCALE

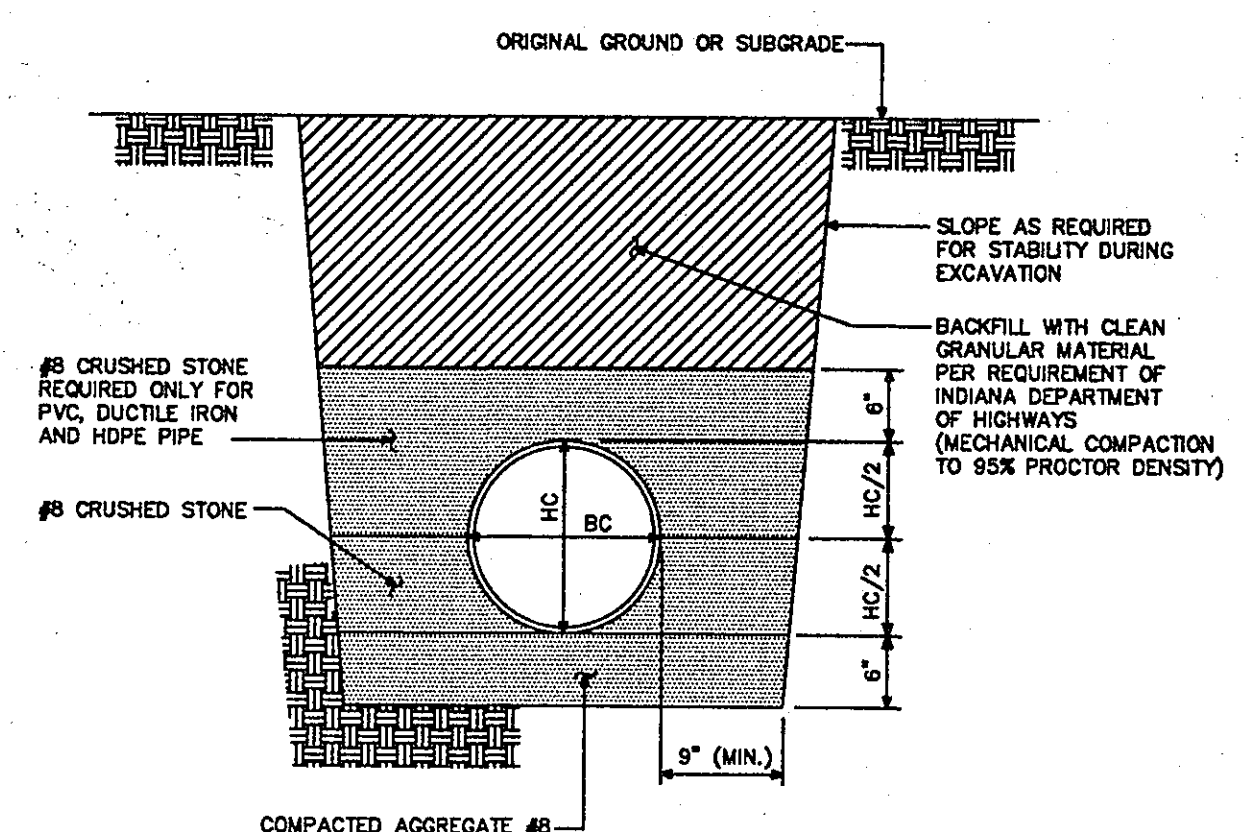

PIPE TRENCH DETAIL
NOT TO SCALE

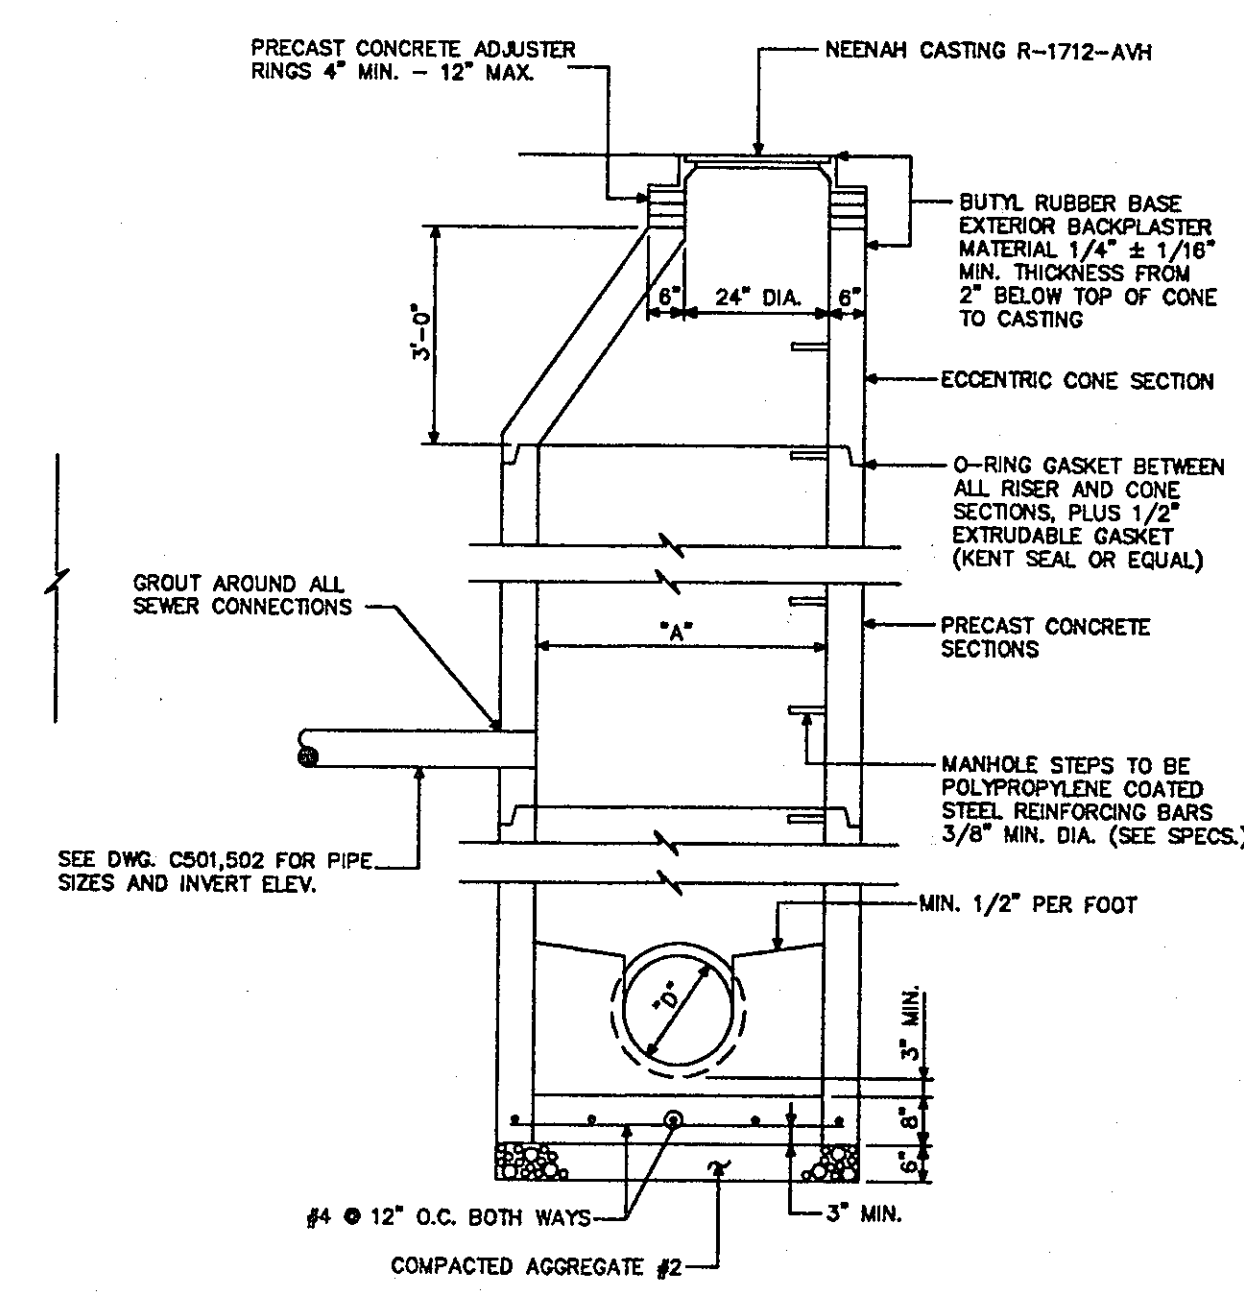

SANITARY MANHOLE
NOT TO SCALE

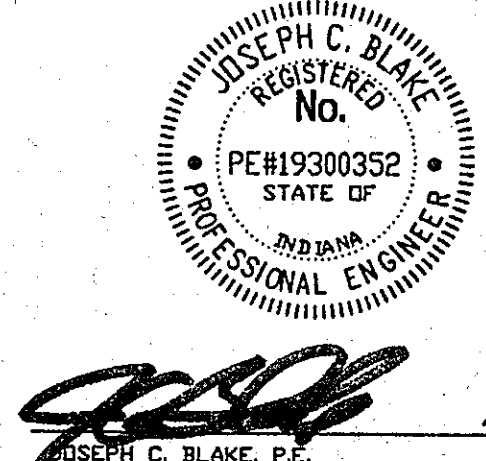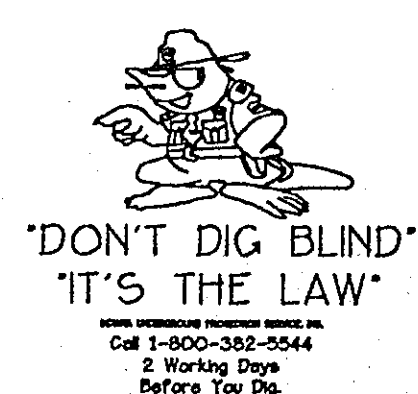

8/25/95

REVISION LOG

8-08-95 ADD DUCTILE IRON PIPE DETAIL

DEVELOPED BY:
BLAKE DEVELOPERS
6569 West 100 South
New Palestine, IN 46163

DATE: 4-07-95
file: 95506801
SHEET NO.
C801
JOB NO.
95506

ANNEKING/ARCHITECTURAL
IDEAL OFFICE OF

Architectural Services
P.O. Box 87
Pendleton, Indiana 46064-0087
Phone/Fax (317) 778-4640

Pendleton Consulting Engineers
P.O. Box 87
Pendleton, Indiana 46064-0087
Phone/Fax (317) 778-4640

DRAFTING CONSULTING PERMITS