

FV-TBM #1 - NORTH FLANGE BOLT WITH "Y" NOTCH OF FIRE
HYDRANT AT INTERSECTION OF PENDLETON AVENUE
AND MARCY AVENUE ELEV. - 878.51

FV-TBM #2 - FLANGE BOLT UNDER AROW OF FIRE HYDRANT
AT INTERSECTION OF PENDLETON AVENUE
AND BESS BOULEVARD ELEV. - 875.94

FV-TBM #3 - FLANGE BOLT UNDER AROW OF FIRE HYDRANT
AT 5862 PENDLETON AVENUE
ELEV. - 878.09

FV-TBM #4 - FLANGE BOLT WITH CUT LINES OF FIRE HYDRANT
ACROSS FROM HOUSE 640(?)
ELEV. - 875.62

FV-TBM #5 - SOUTHEAST FLANGE BOLT WITH TAG LINES OF
FIRE HYDRANT AT NORTHEAST CORNER OF
CEMETARY ELEV. - 876.20

ANDERSON LIGHT AND POWER		GTE	
550 BAXTER ROAD		P.O. BOX 1406	
ANDERSON, INDIANA	46016	RICHMOND, INDIANA	47375
1 (765) 648-6187		1 (800) 483-5600	
CYNERGY/PSI		INDIANA GAS COMPANY, INC.	
100 S. MILL CREEK ROAD		2001 LOUISE STREET	
NORBLESVILLE, INDIANA	46060	ANDERSON, INDIANA	46016
1 (800) 521-2232		1 (800) 777-2050	
PENDLETON MUNICIPAL WATER UTILITY		335 E. CENTRAL INDIANA	
P.O. BOX 239		TOWNS OF 10TH STREET	
ANDERSON, INDIANA	46064	ANDERSON, INDIANA	46016
1 (765) 778-2173		1 (765) 649-0407	

4


- SHEET DESIGNATION
- PROPOSED GRAVITY SEWER
- PROPOSED SANITARY MANHOLE
- PROPOSED SANITARY FORCEMAIN

NOTE:
ADDITIONAL RIGHT-OF-WAY OR EASEMENTS MAY
NEED TO BE ACQUIRED FOR INSTALLATION OF SEWER.




PER INDIANA STATE LAW IS-69-1991, IT IS AGAINST THE LAW TO EXCAVATE WITHOUT NOTIFYING THE UNDERGROUND LOCATION SERVICE TWO (2) WORKING DAYS BEFORE COMMENCING WORK.

NOTE: CONTRACTOR TO VERIFY ALL UTILITY LOCATIONS PRIOR TO THE START OF CONSTRUCTION

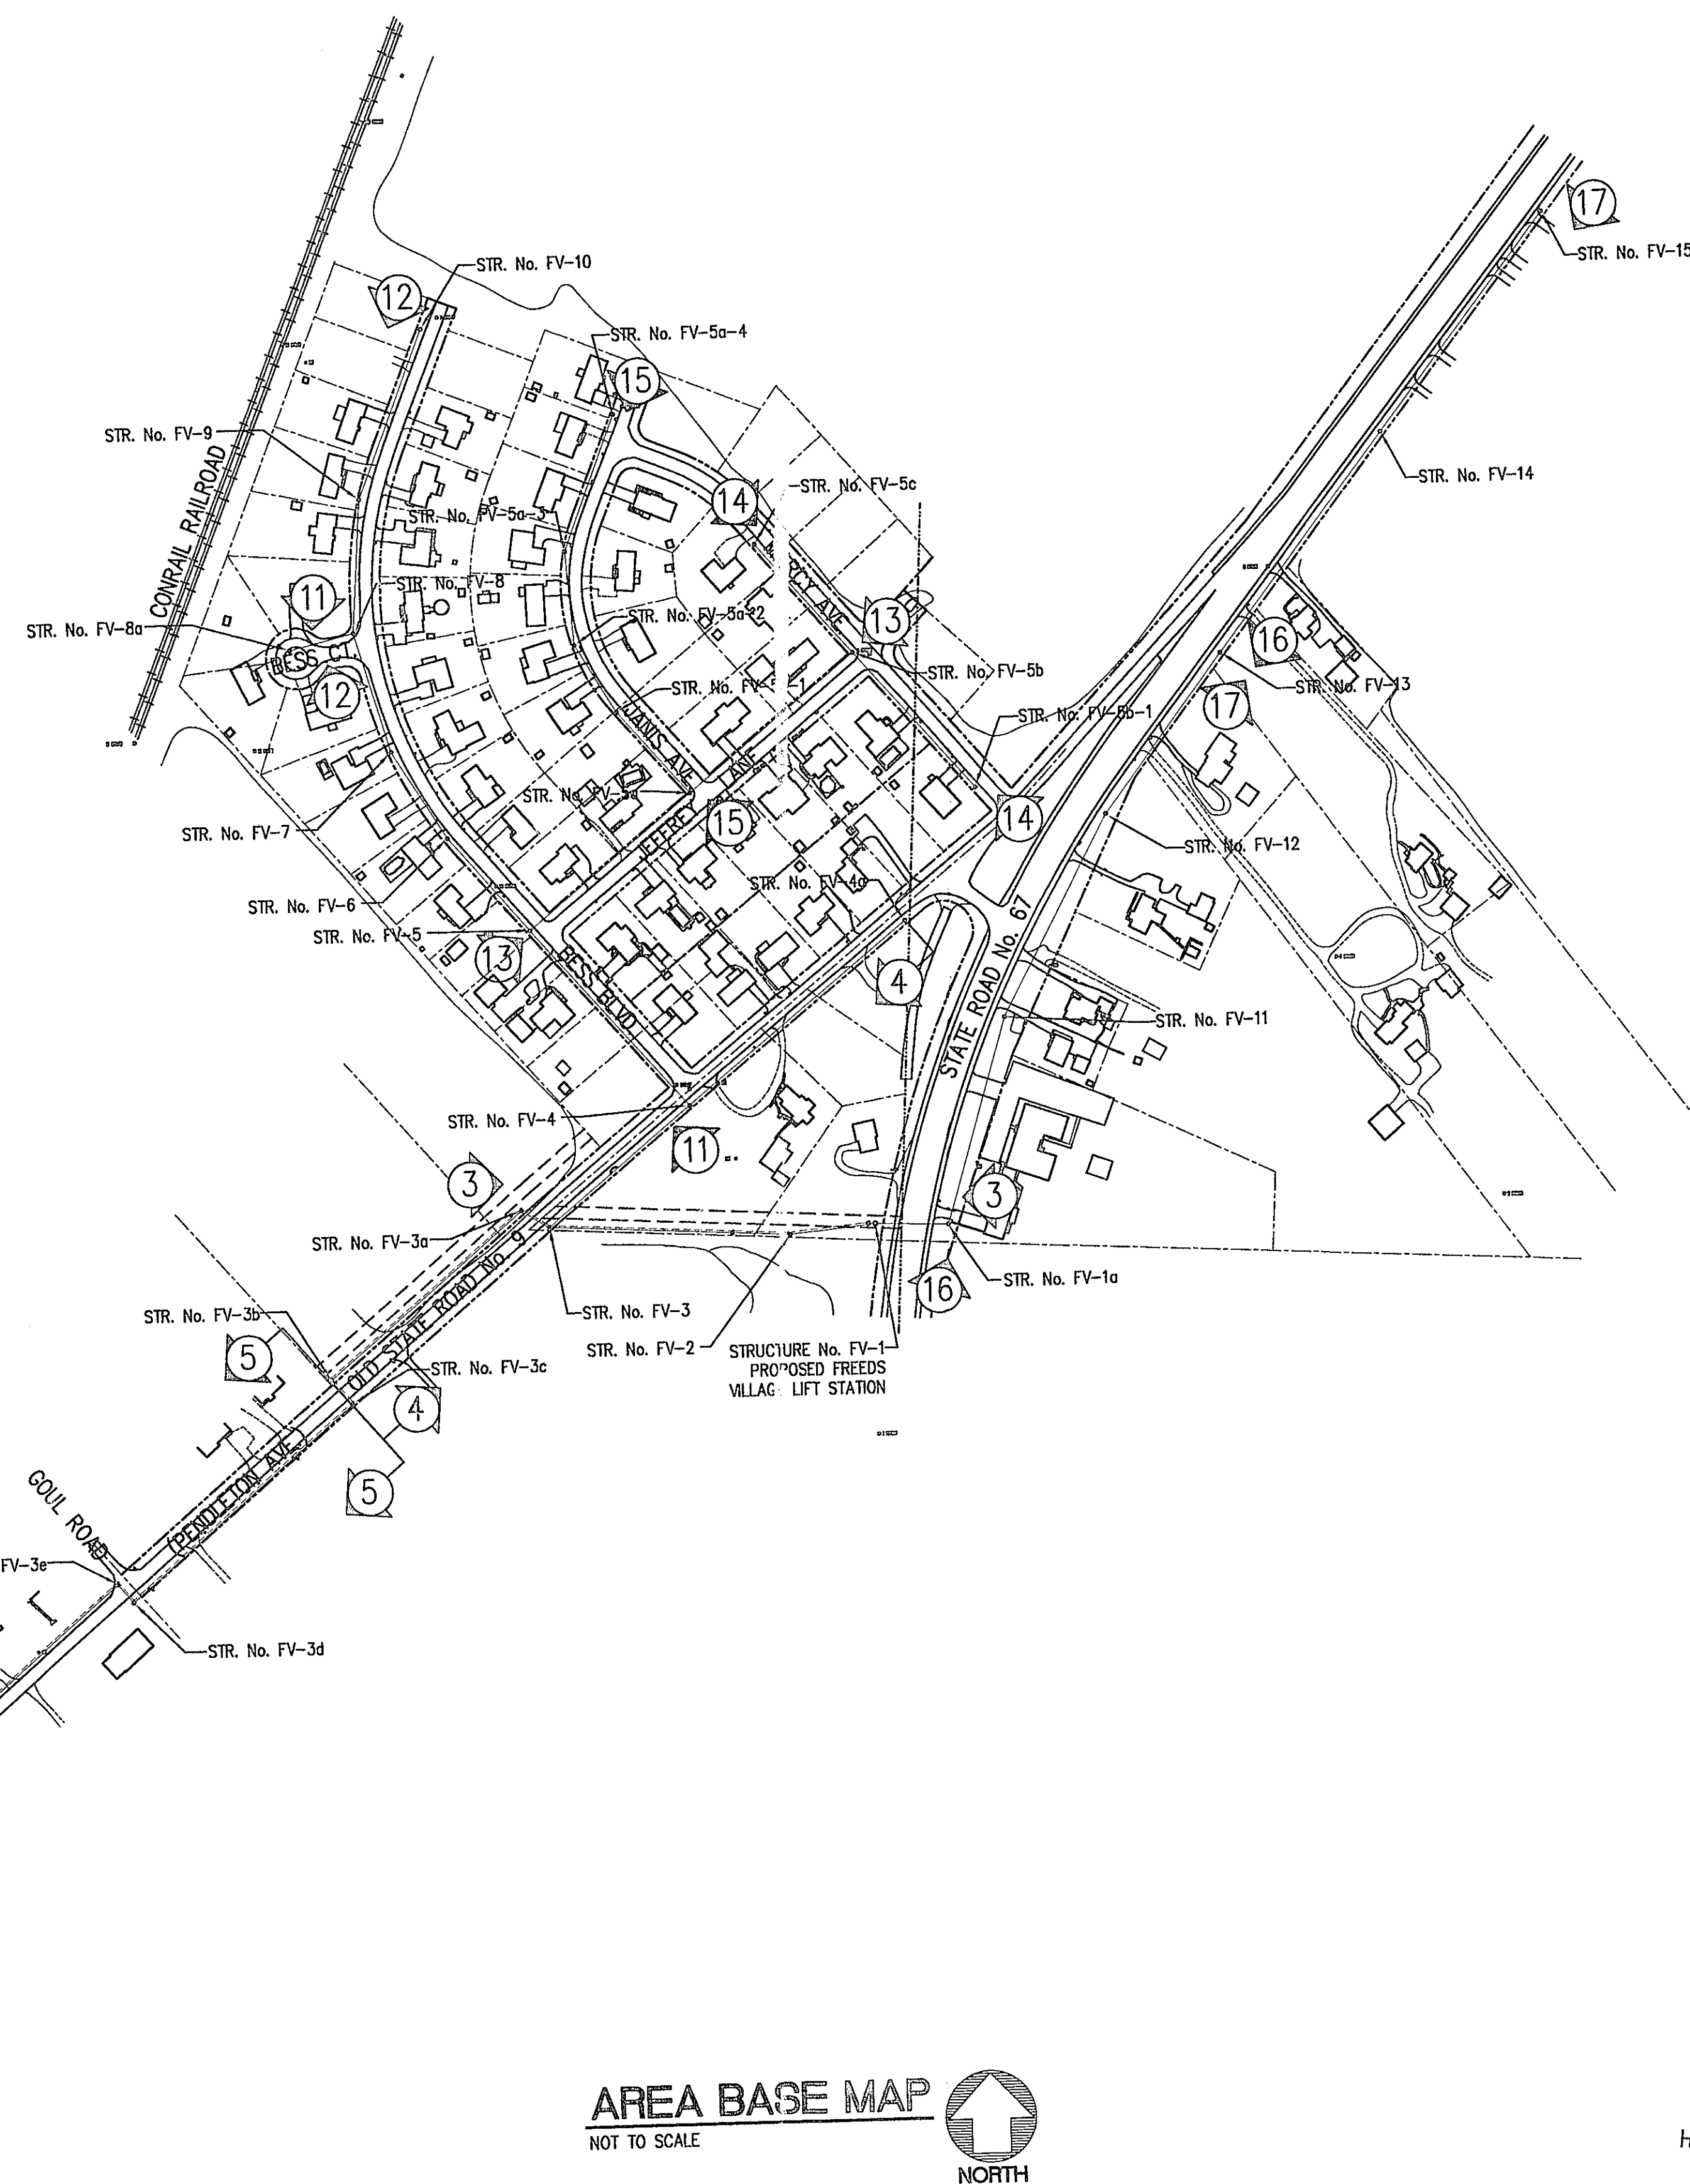

AREA BASE MAP
NOT TO SCALE

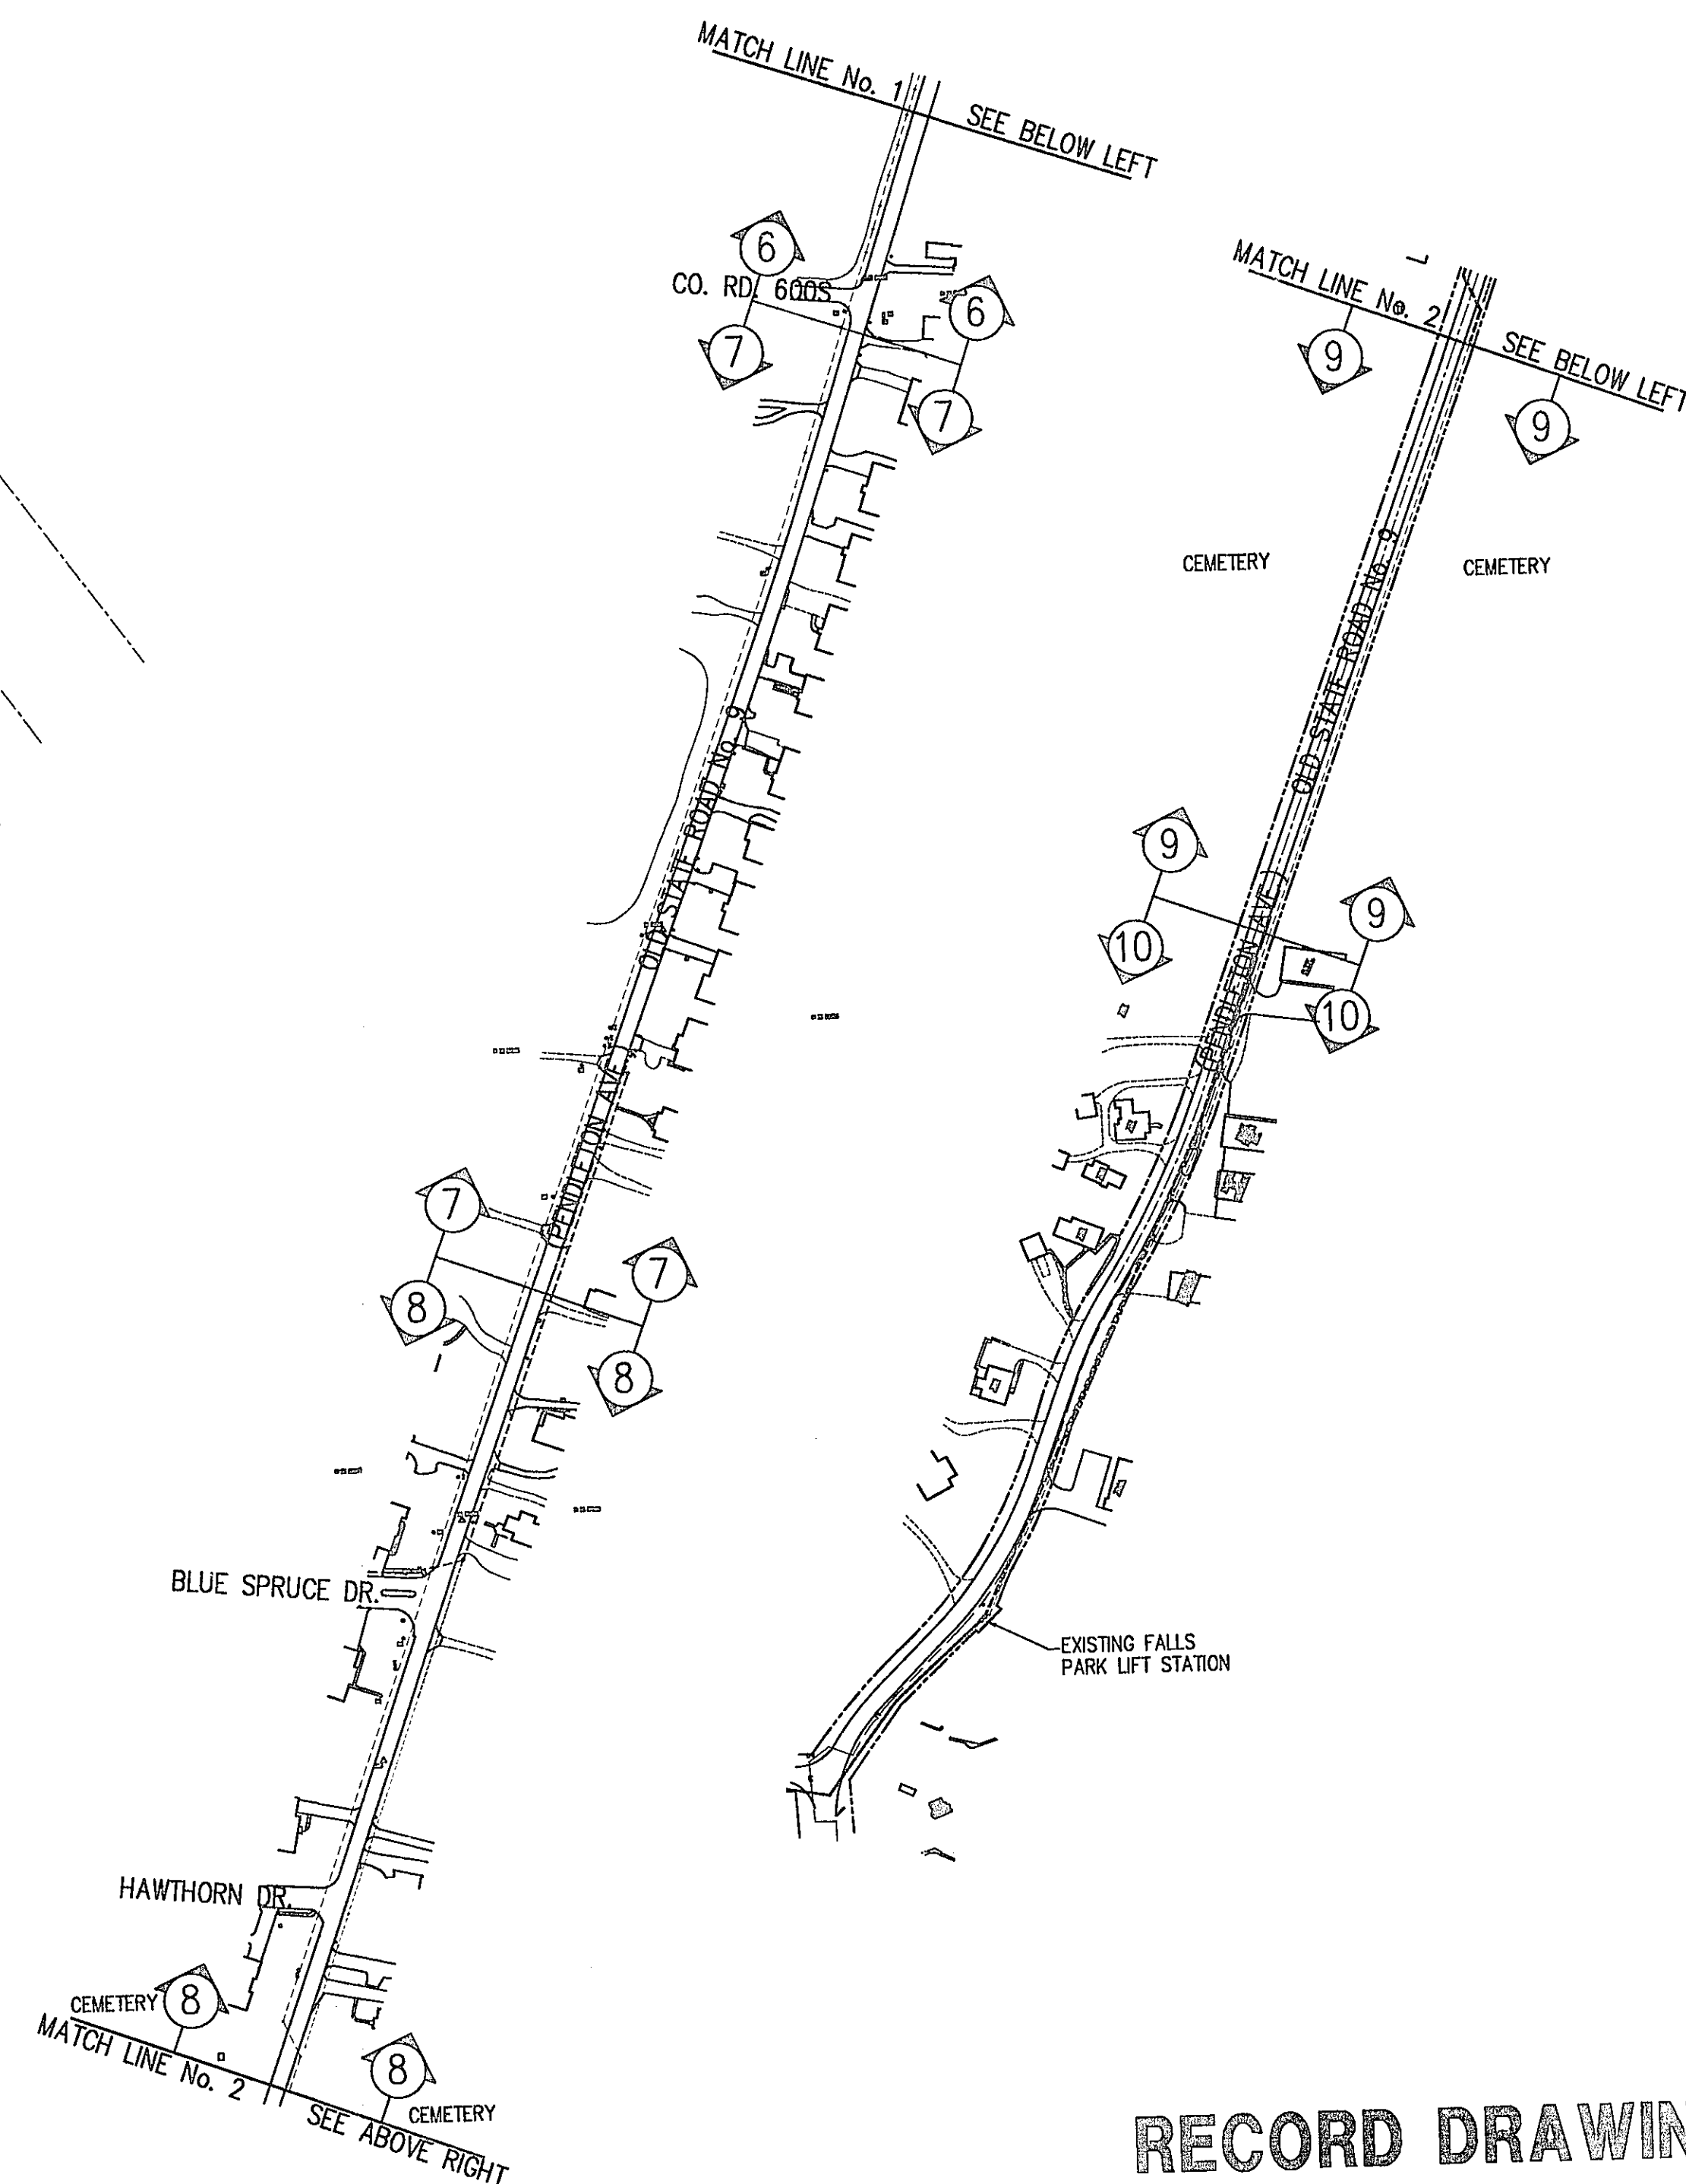

RECORD DRAWING
APRIL 2001

FREEDS VILLAGE SUBDIVISION
FALL CREEK REGIONAL WASTE DISTRICT


PROJECT BASE MAP

DRAWN BY: DAP	DATE 04/12/98	PROJECT No. 98008A	SHEET No. 2
DESIGNED BY: D.A. Pauling		CHECKED BY: James W. Frazell, P.E.	

[illegible]

TRIAD ASSOCIATES INC.

INDIANAPOLIS, INDIANA

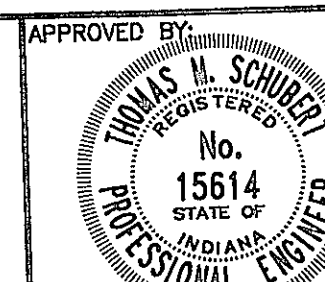

Thomas M. Schubert, P.E.

CHECKED BY: James W. Frozell, P.E.

1

OF