


CASTING ELEVATIONS TO BE ADJUSTED IN THE FIELD
AT THE TIME OF CONSTRUCTION STAKING

CONTRACTOR TO VERIFY THE LOCATION OF ALL EXISTING UTILITIES PRIOR TO COMMENCEMENT OF CONSTRUCTION.



DON'T DIG BLIND
CALL BEFORE YOU DIG
WITHIN INDIANA
1-800-382-5544
FROM OUTSIDE INDIANA
1-800-428-5200

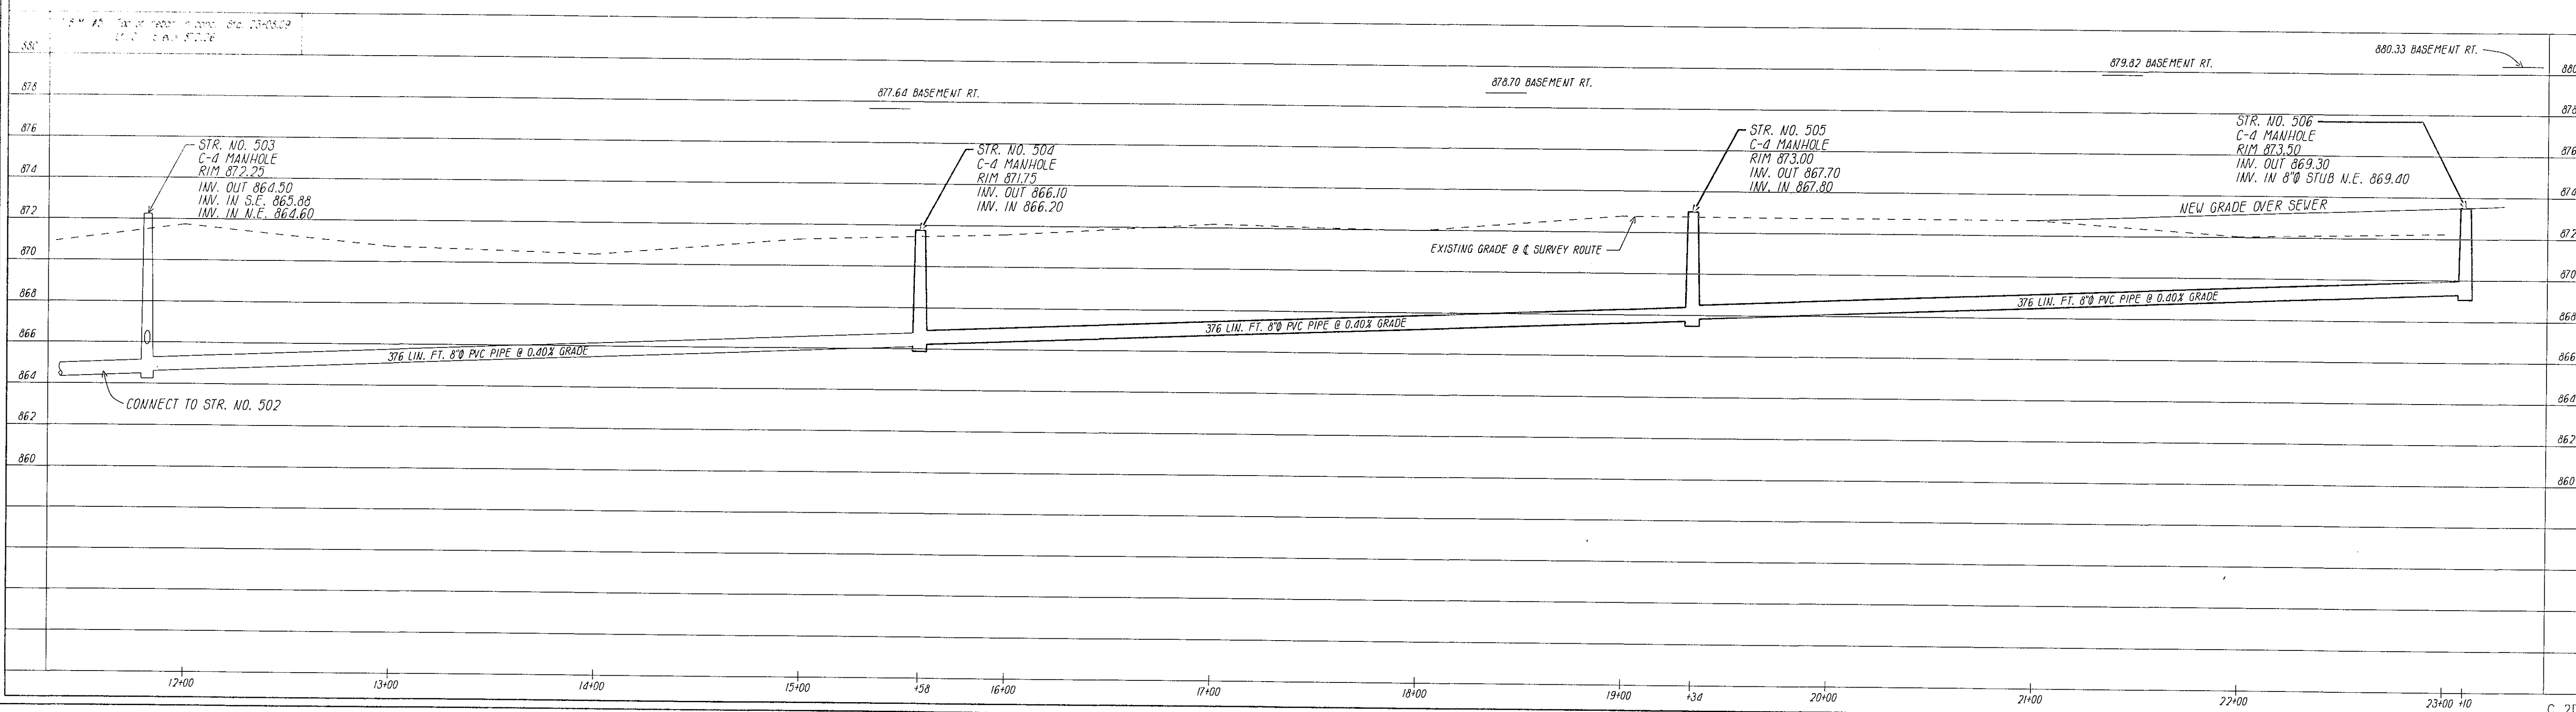


BRADLEY A. RAYL
SURVEYING & ENGINEERING
2036 MELODY LANE
ANDERSON IN. 46002
(317) 643-5614

SANITARY SEWER PLAN AND PROFILES

REVISIONS: July 29, 2003 Change: Change of Filing Address. No.

HICKORY HILLS EAST
FALL CREEK TOWNSHIP
MADISON COUNTY, INDIANA

DRAWN BY: Penny A. Narum DATE: May 17, 1993

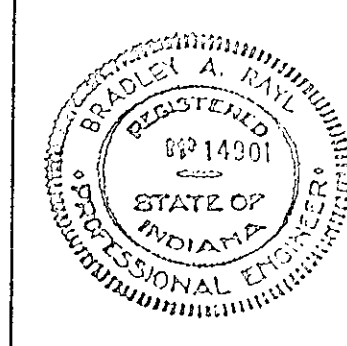

BY: Bradley A. Ray
DATE: 6-4-93

SHEET

5/