




T.B.M. #4: RAIL ROAD SPIKE IN PAVEMENT
STA. 12+00 RIGHT 9' ELEV. = 888.87


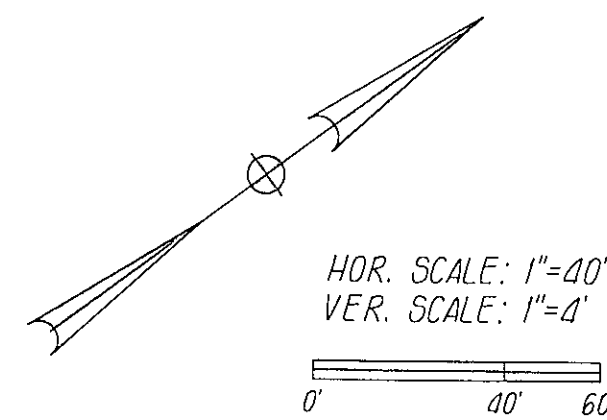


CASTING ELEVATIONS TO BE ADJUSTED IN THE FIELD
AT THE TIME OF CONSTRUCTION STAKING.

CONTRACTOR TO VERIFY THE LOCATION OF ALL EXISTING
UTILITIES PRIOR TO COMMENCEMENT OF CONSTRUCTION.

(SEE SHEET NO. 6)
STR. NO. 516
C-4 MANHOLE
STA. 8+27.17' RT.
400 L.F. 8" P.V.C. PIPE @ 0.80% GRADE
CONNECT TO STR. NO. 515

STR. NO. 517
C-4 MANHOLE
STA. 12+27.17' RT.
400 L.F. 8" P.V.C. PIPE @ 0.80% GRADE
CONNECT TO STR. NO. 516

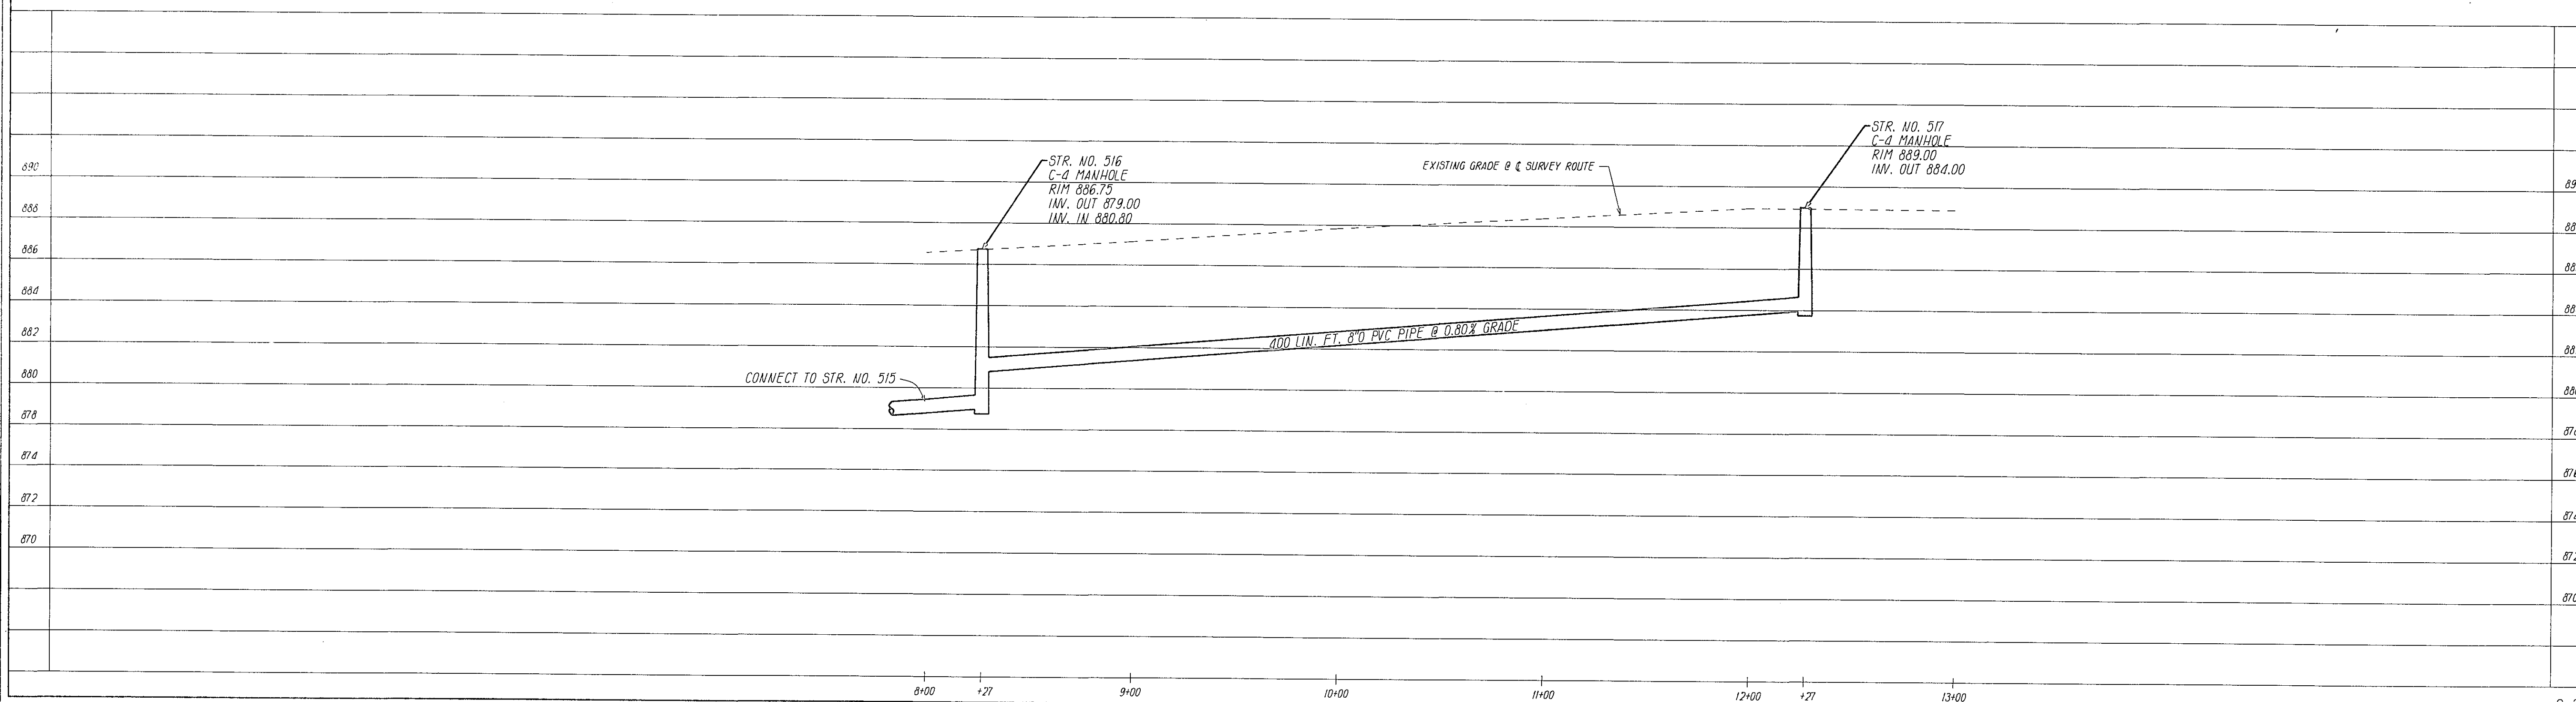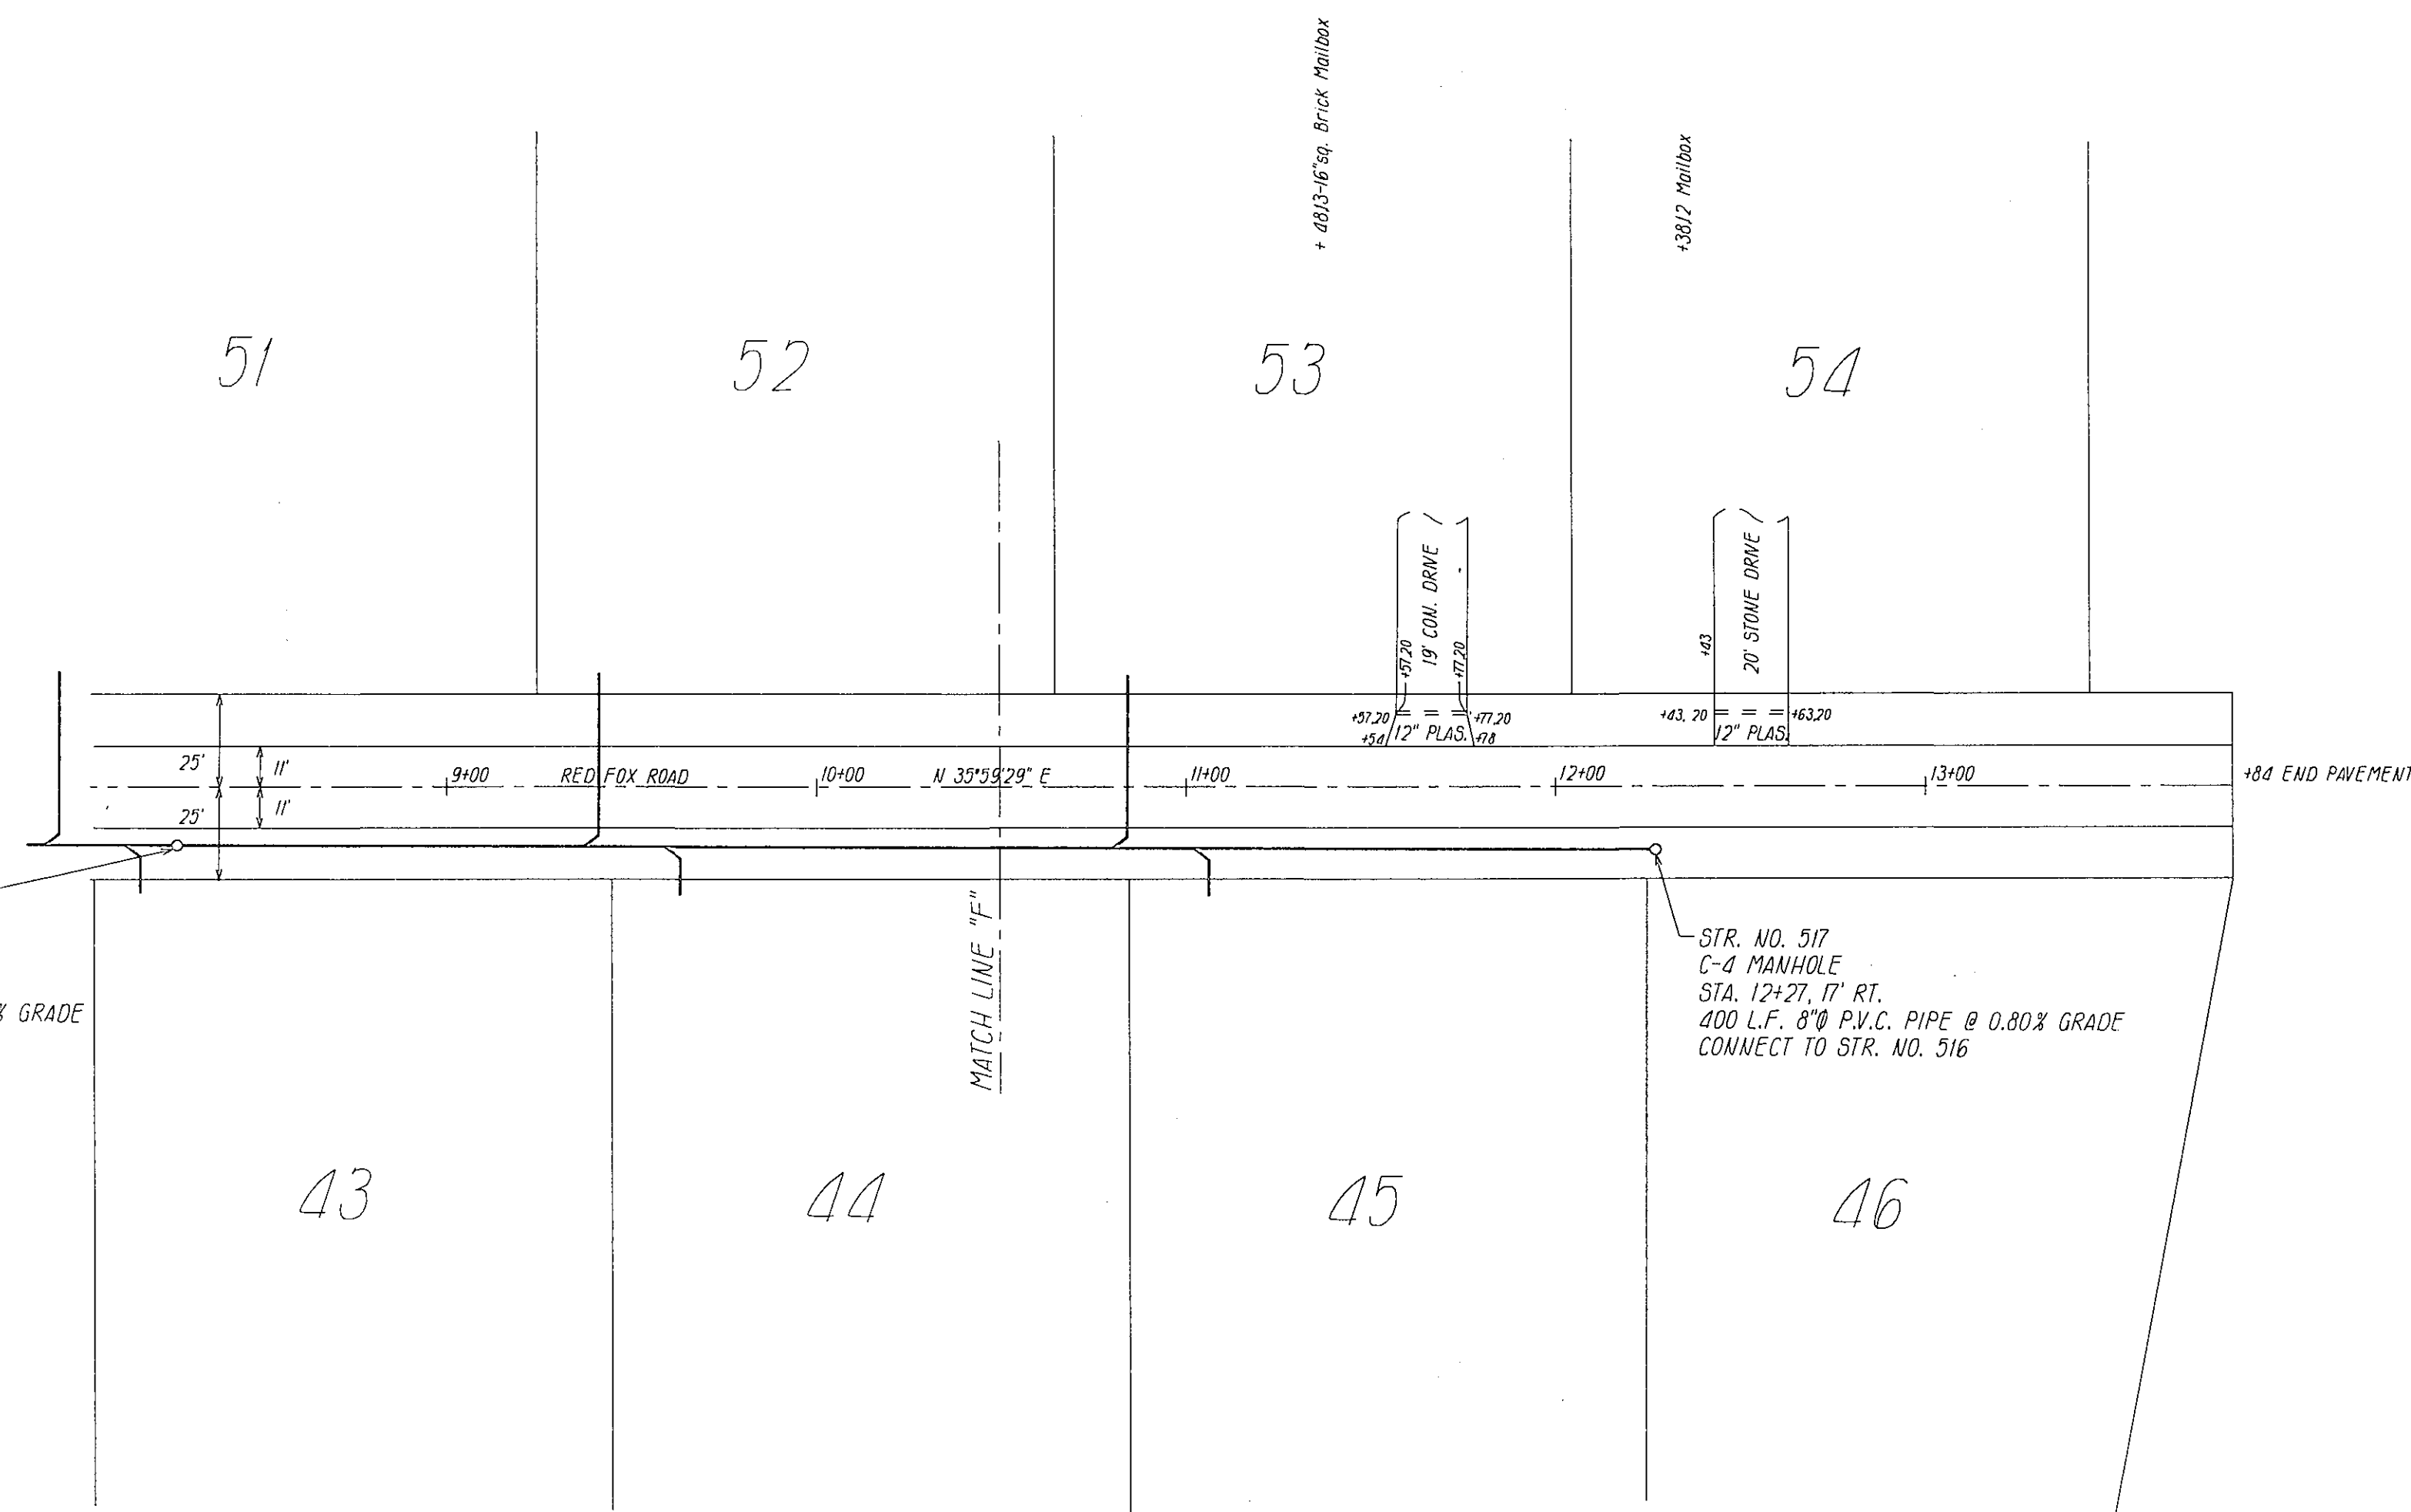

BRADLEY A. RAYL
SURVEYING & ENGINEERING
2036 MELODY LANE
ANDERSON, IN 46012
(317) 643-5614

SANITARY SEWER PLAN AND PROFILES

REV. 3/03

HICKORY HILLS EAST
FALL CREEK TOWNSHIP
MADISON COUNTY, INDIANA

DRAWN BY: Perry A. Narum DATE: MAY 11, 1993

BY: [Signature]
DATE: 6-4-00

SHEET

7/

7/27/00 10:00

F-30