


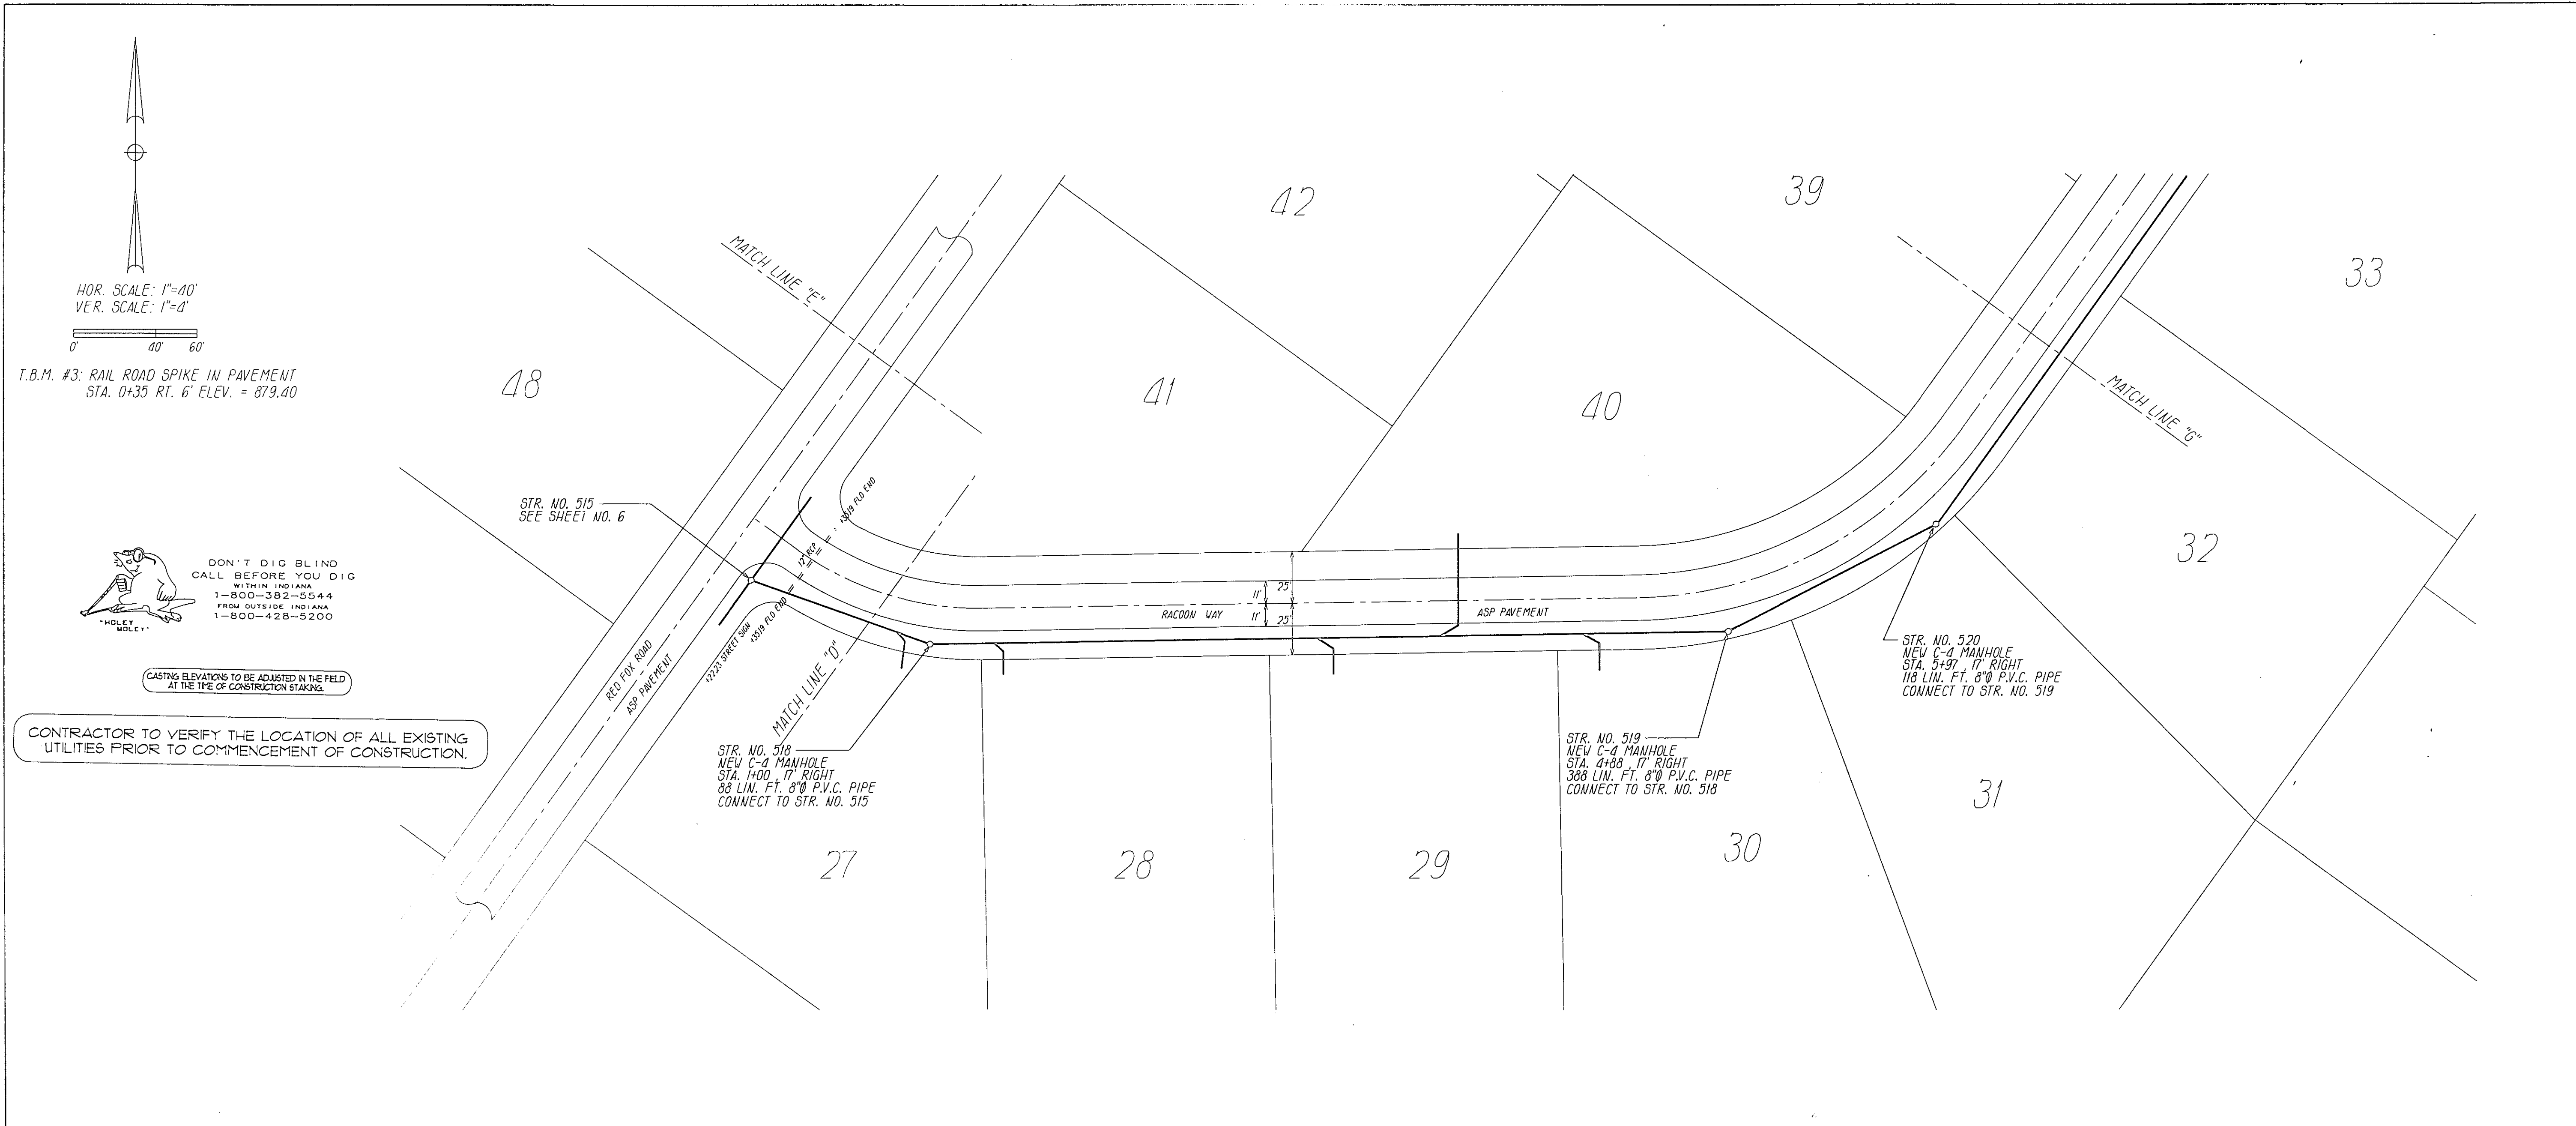


BRADLEY A. RAYL
SURVEYING & ENGINEERING
2036 MELODY LANE
ANDERSON IN. 46012
(317) 643-5614

SANITARY SEWER PLAN AND PROFILES

REVISIONS: JULY 23, 1993 Adjust rim elevations (drawn in error) Str. No. 515 & 518 (P.A.N.)

HICKORY HILLS EAST
FALL CREEK TOWNSHIP
MADISON COUNTY, INDIANA

DRAWN BY BRIAN DATE: MAY 14, 1993

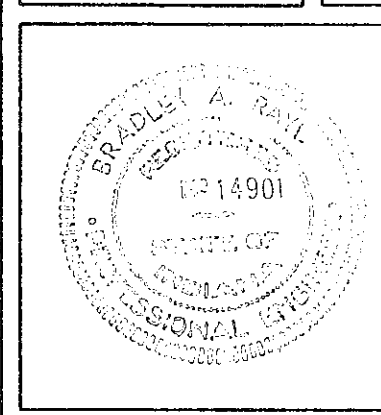

BY: *Bradley A. Rayl*
DATE: 6-4-93

SHEET
81