


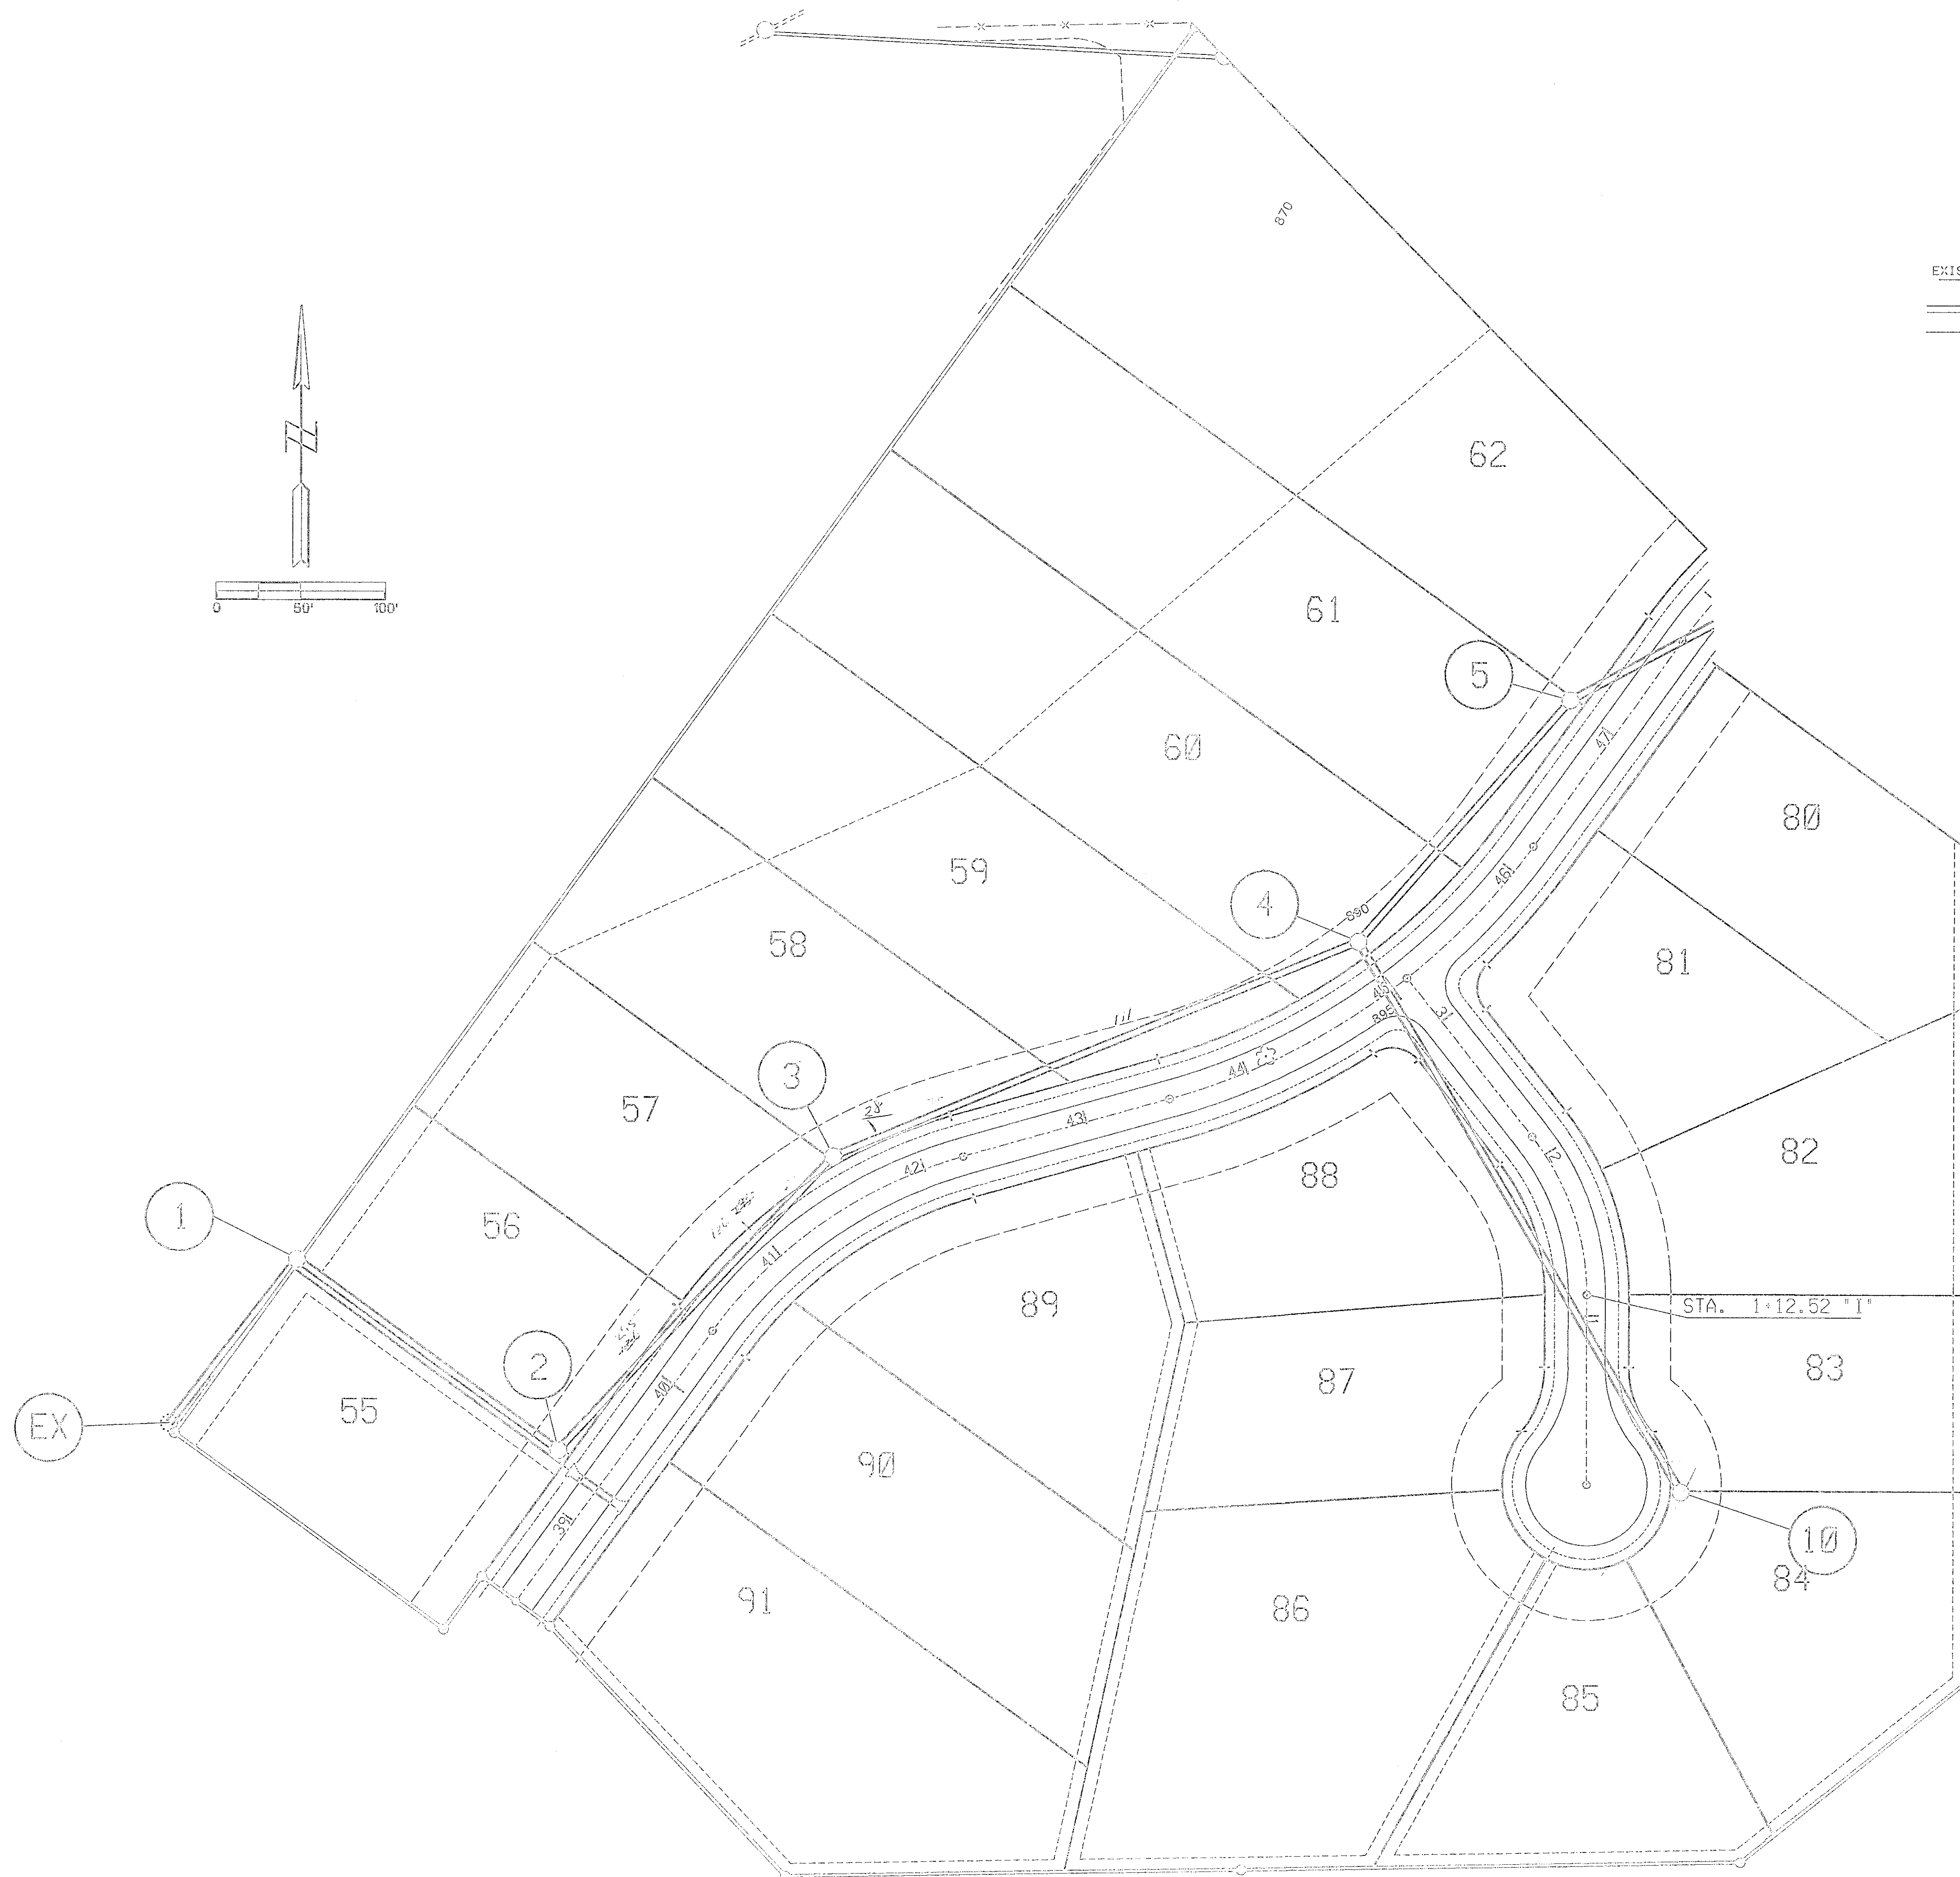

LEGEND	
EXISTING	PROPOSED
	STORM SEWER
	SANITARY SEWER
	MANHOLE
	INLET
	END SECTION
	STRUCTURE NO. 21 (STORM)
	STRUCTURE NO. 9 (SANITARY)
	WATER LINE
	LATERAL
	CLEAN OUT
	WATER VALVE
	FIRE HYDRANT

3

UTILITY PLAN

THE OFFICE OF
CITY ENGINEER
CITY OF CHICAGO

STEVENS
ENGINEERS
ARCHITECTS
PLANNERS

