
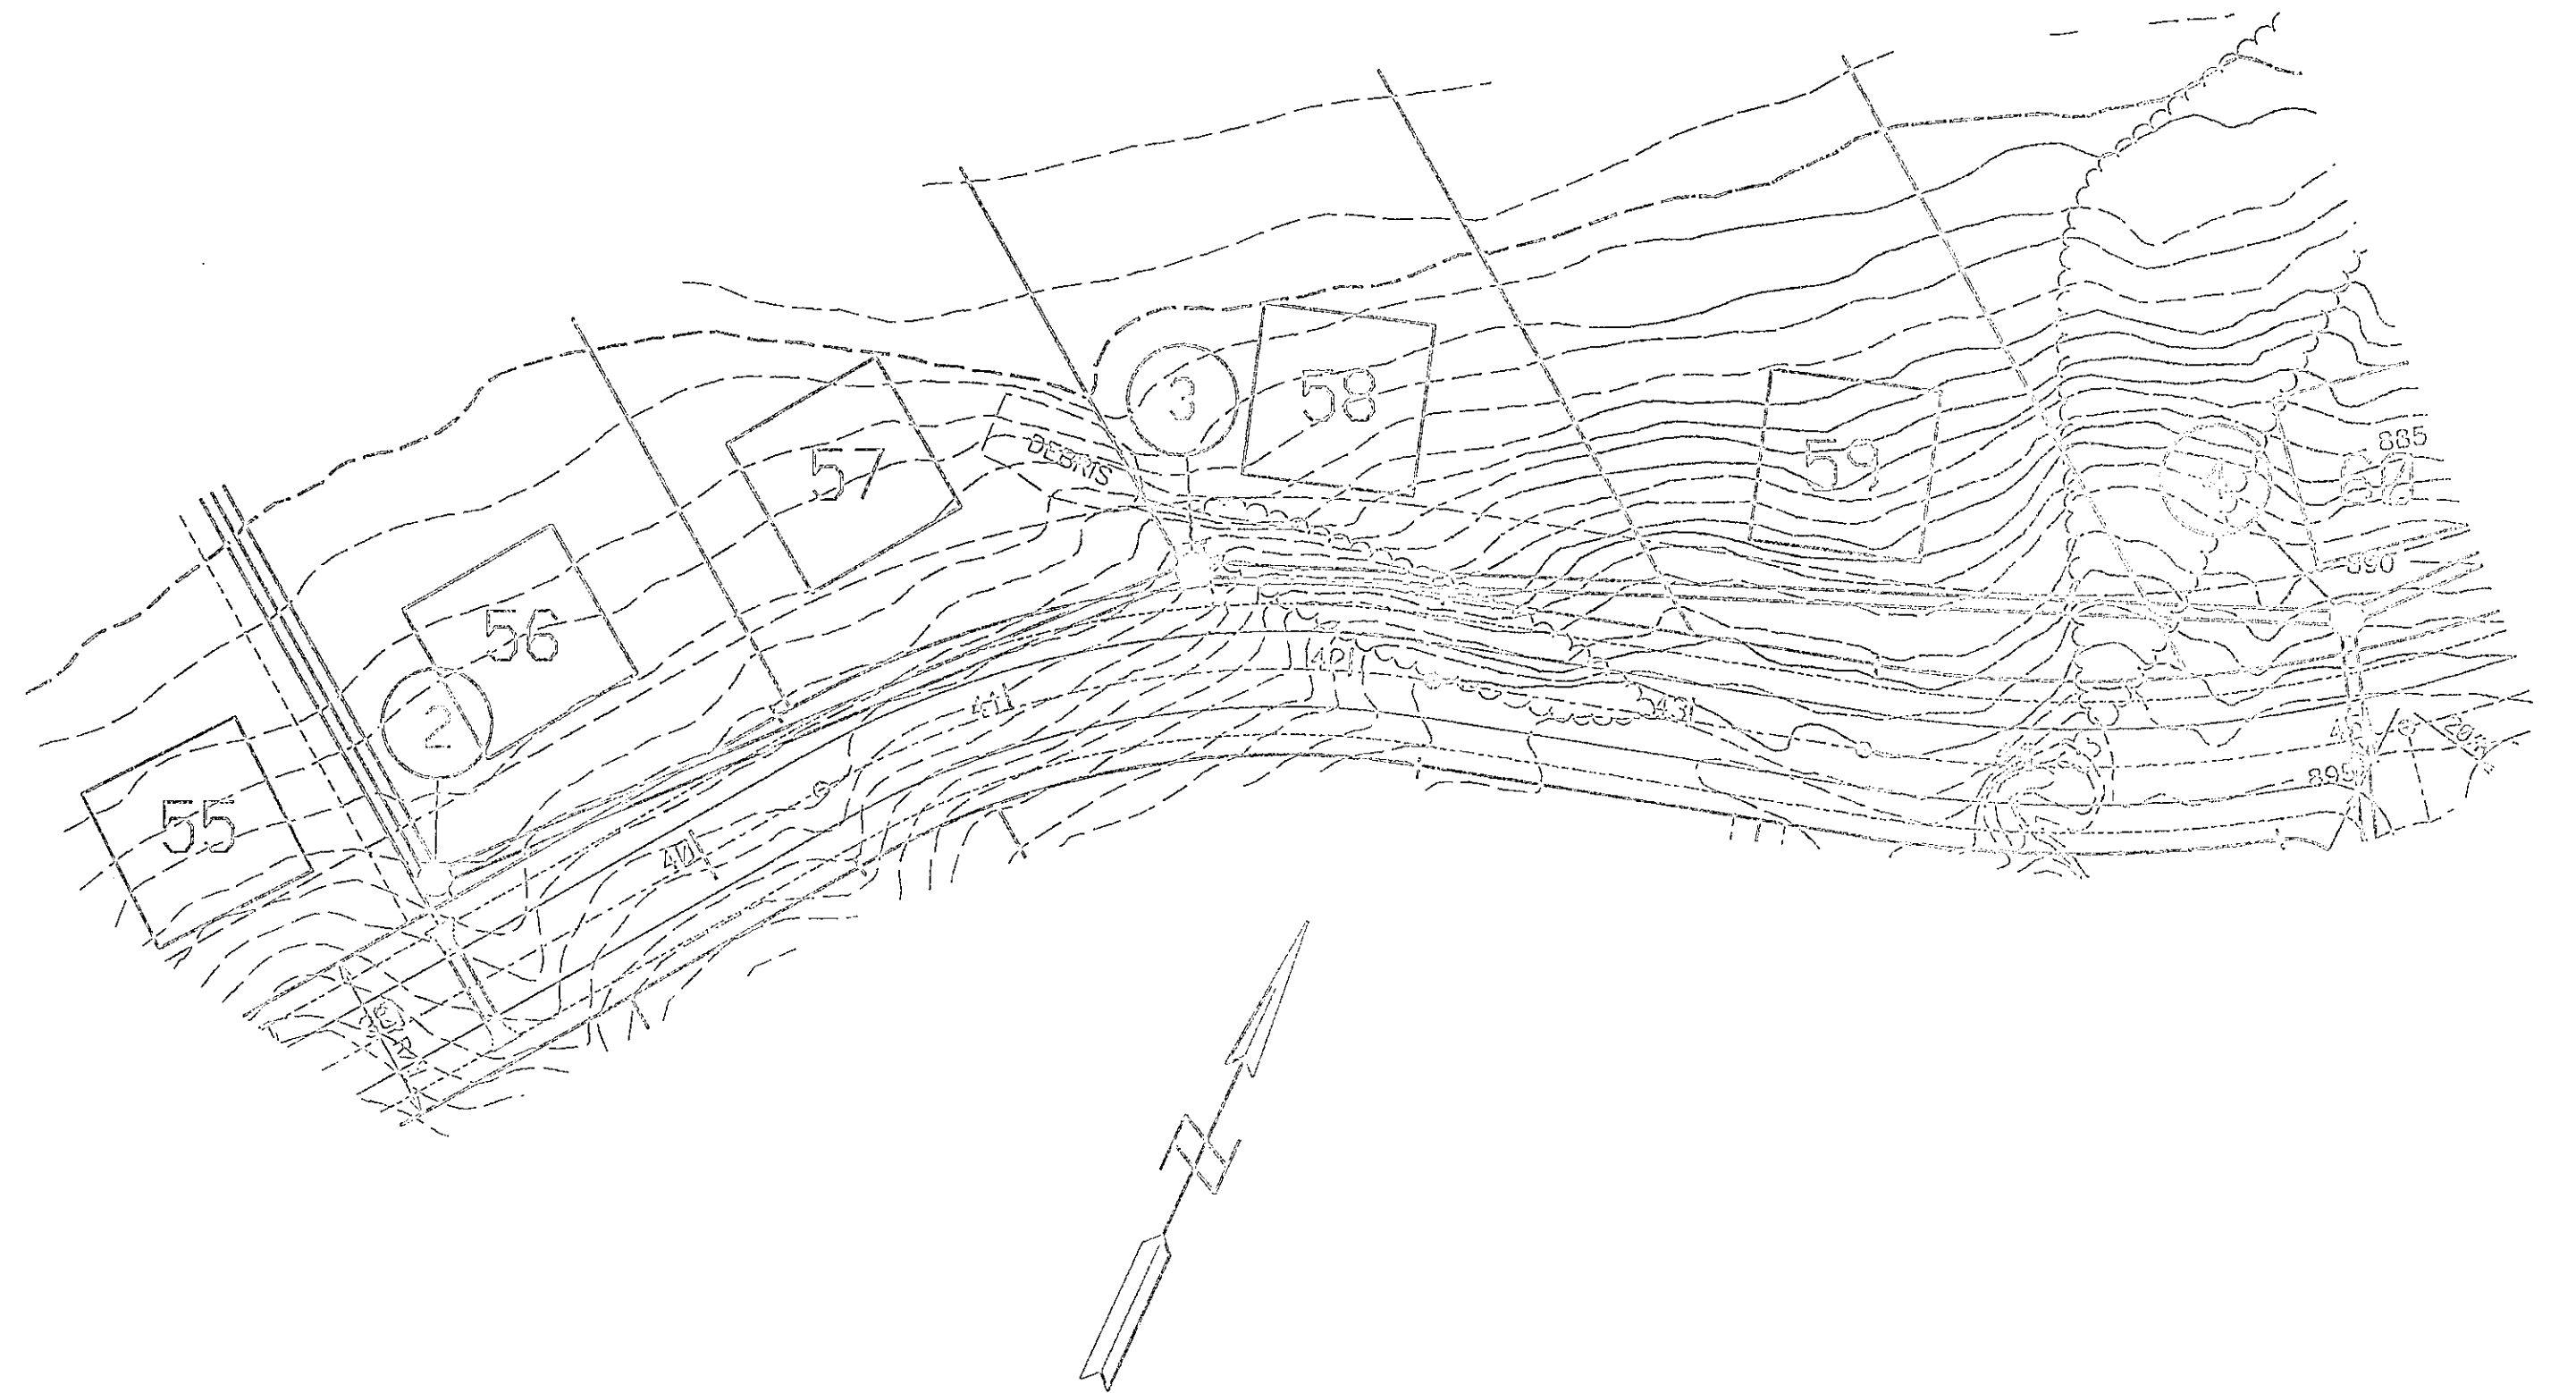
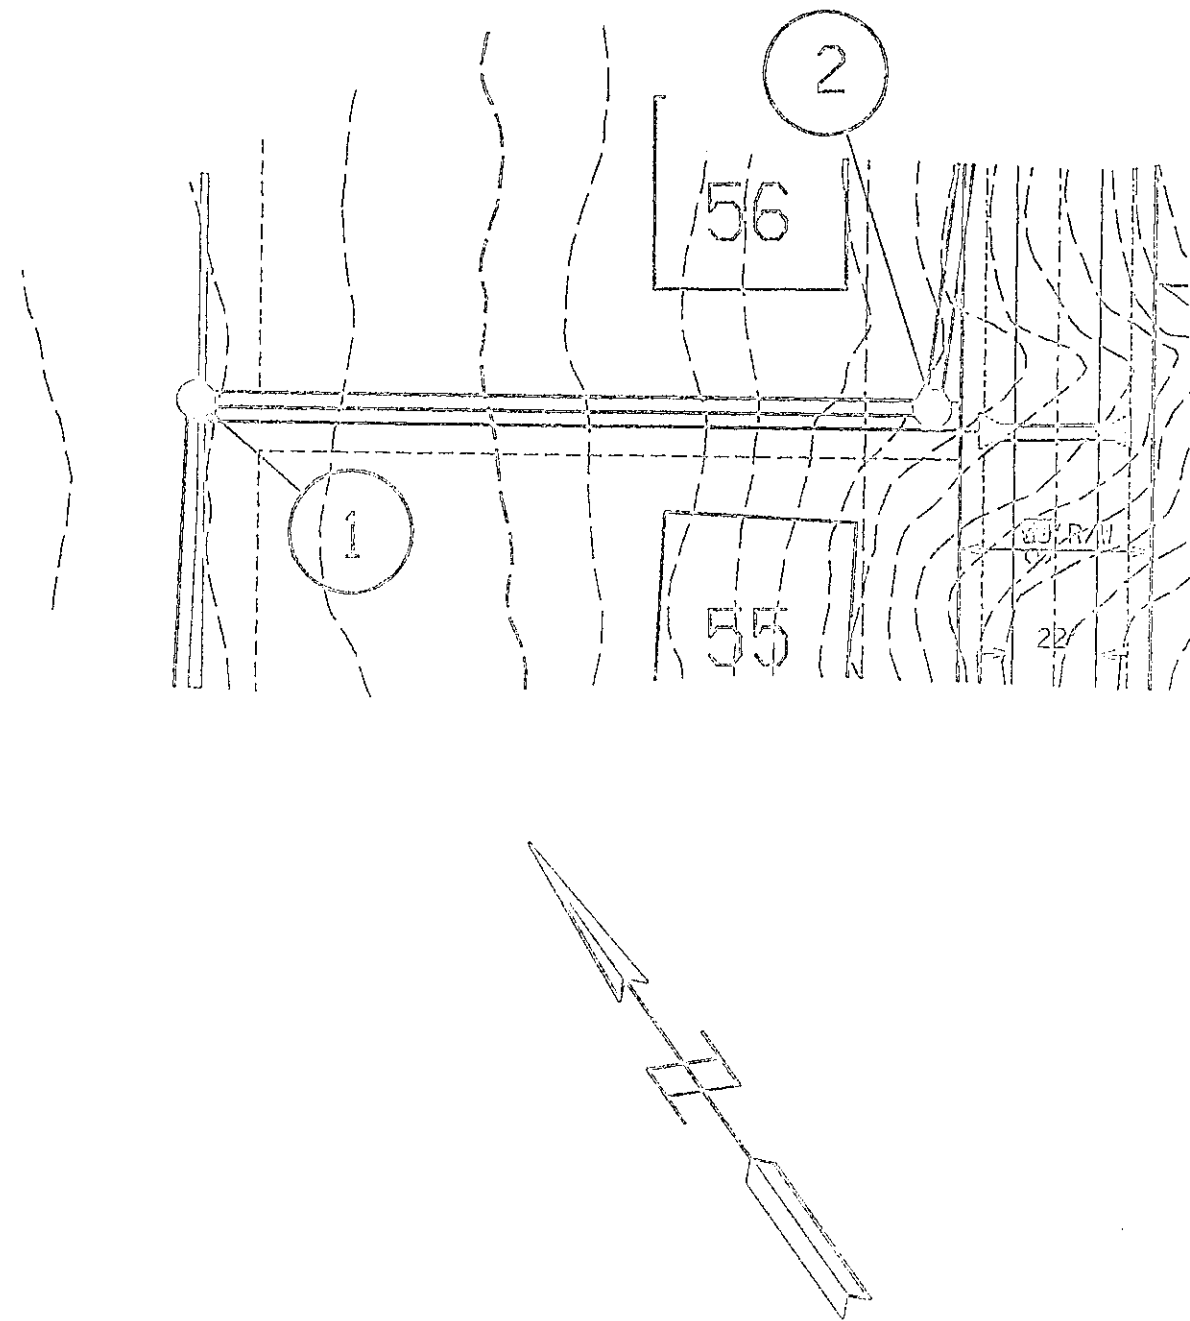


PLAN	REVISED	DATE
NO.	BY	
NOTE BOOK	REVISIONS	
NO.	BY	

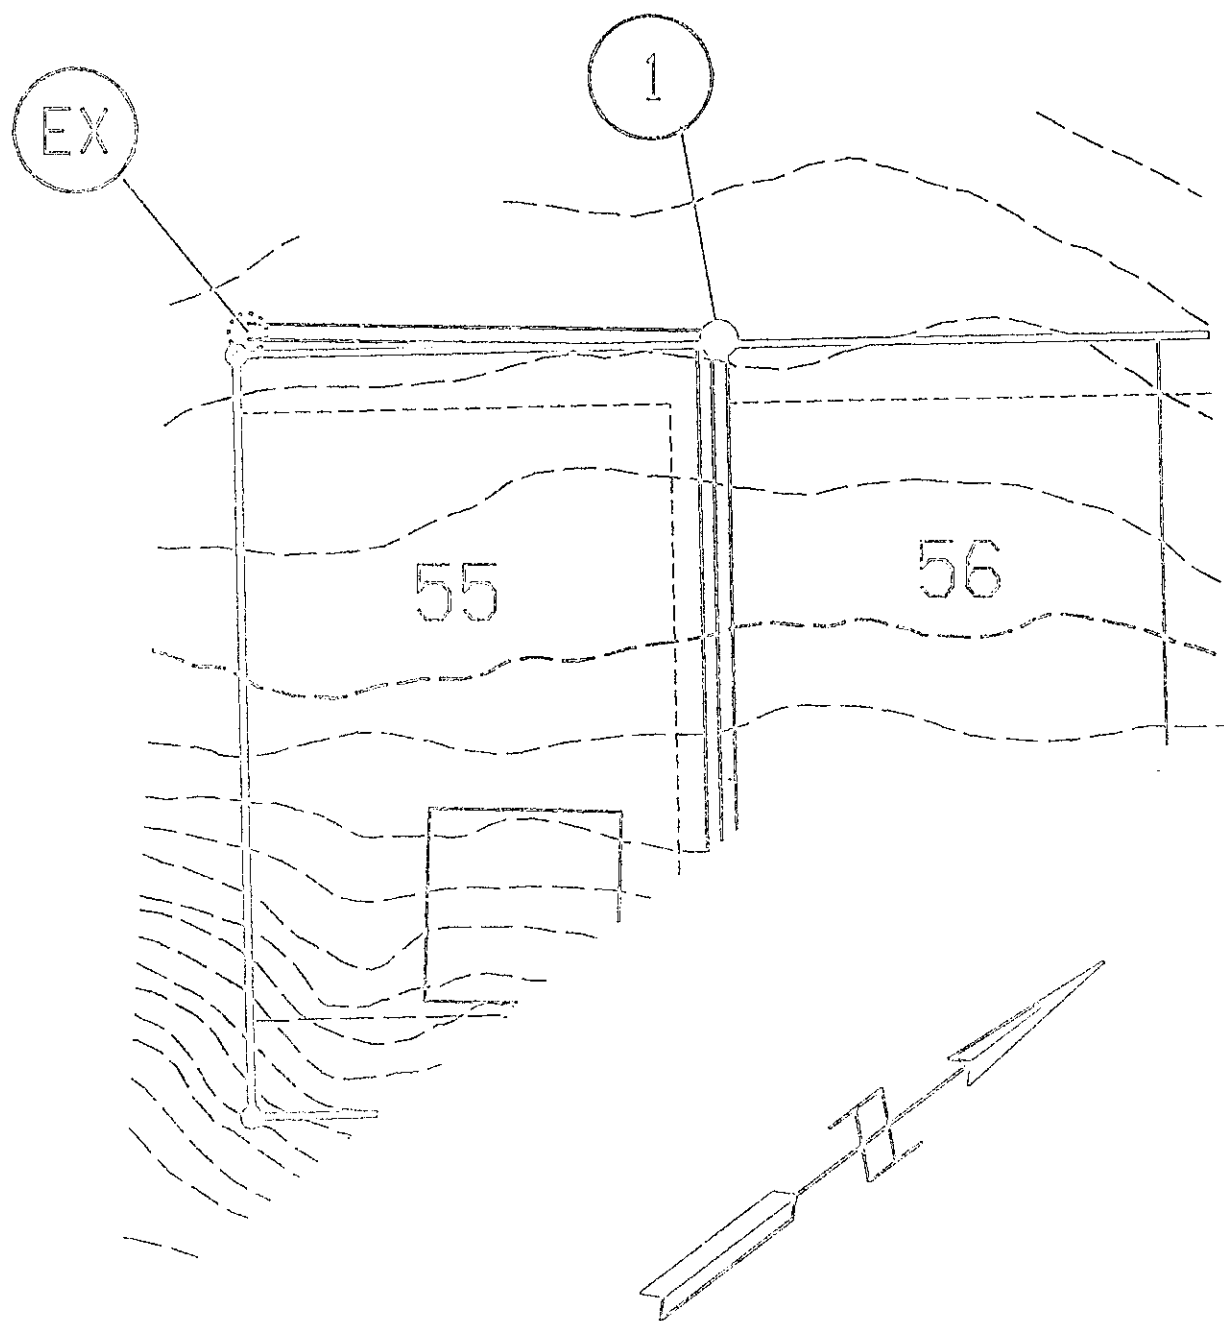


NOTES:
LENGTHS OF PIPES INDICATED ARE FROM
CENTER TO CENTER OF STRUCTURES AND
ARE NOT ACTUAL PIPE LENGTHS.

SHALL
BE
CONSIDERED
AS
PART OF
THE
WORK

DEITCH MARK DESCRIPTION

N-E CORNER OF CONCRETE WALK TO RONALD FELDPAUS
RESIDENCE LOCATED AT SOUTH SIDE OF HUNTSVILLE
ROAD APPROX. 0.9 MILE EAST OF INTERSECTION WITH S.R.
67, N-E CORNER OF WALK IS ALSO THE TOP STEP OF
STEPS TO ROAD LEVEL. ELEV. 876.98

PLAN	REVISED	DATE
NO.	BY	
NOTE BOOK	REVISIONS	
NO.	BY	

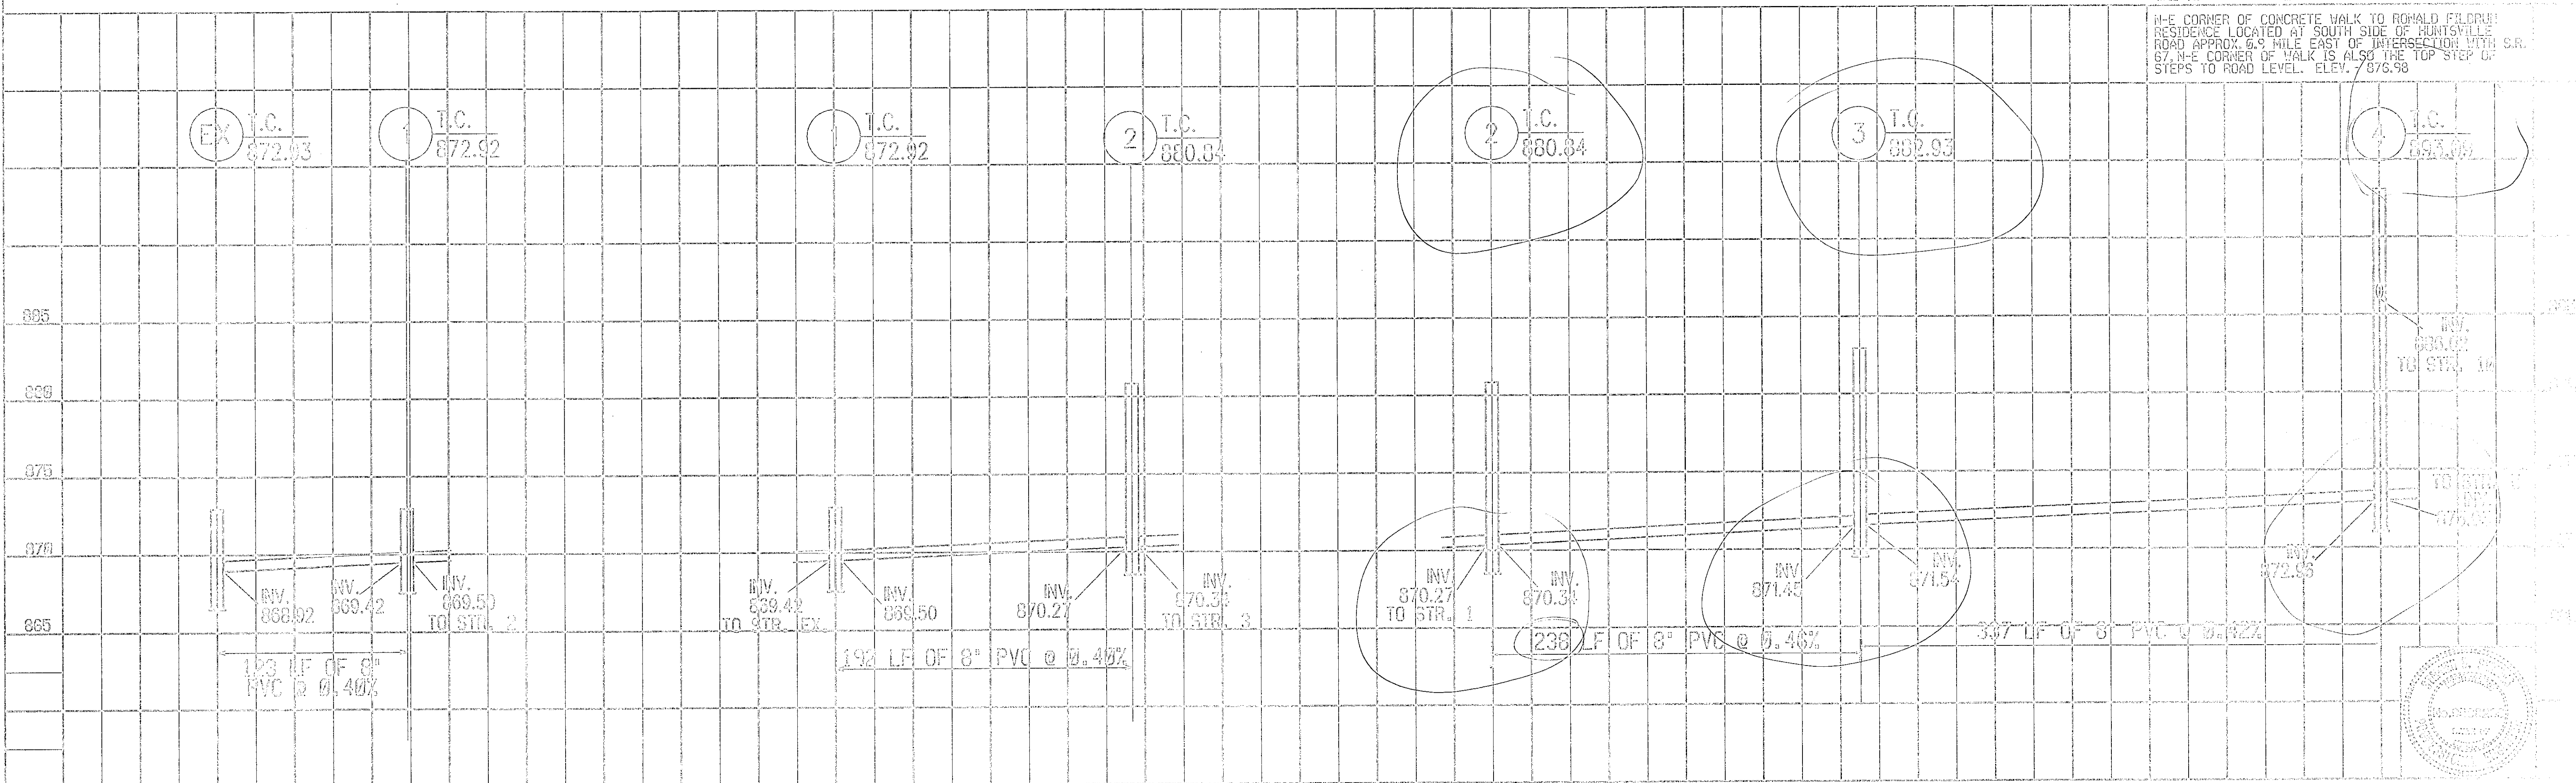

HICKORY HILLS EAST SECTION THREE SANITARY SEWER AS-BUILTS

PROJECT NO.	DATE	BY	DATE	BY	DATE
02005	10/10/05	10/10/05	10/10/05	10/10/05	10/10/05