
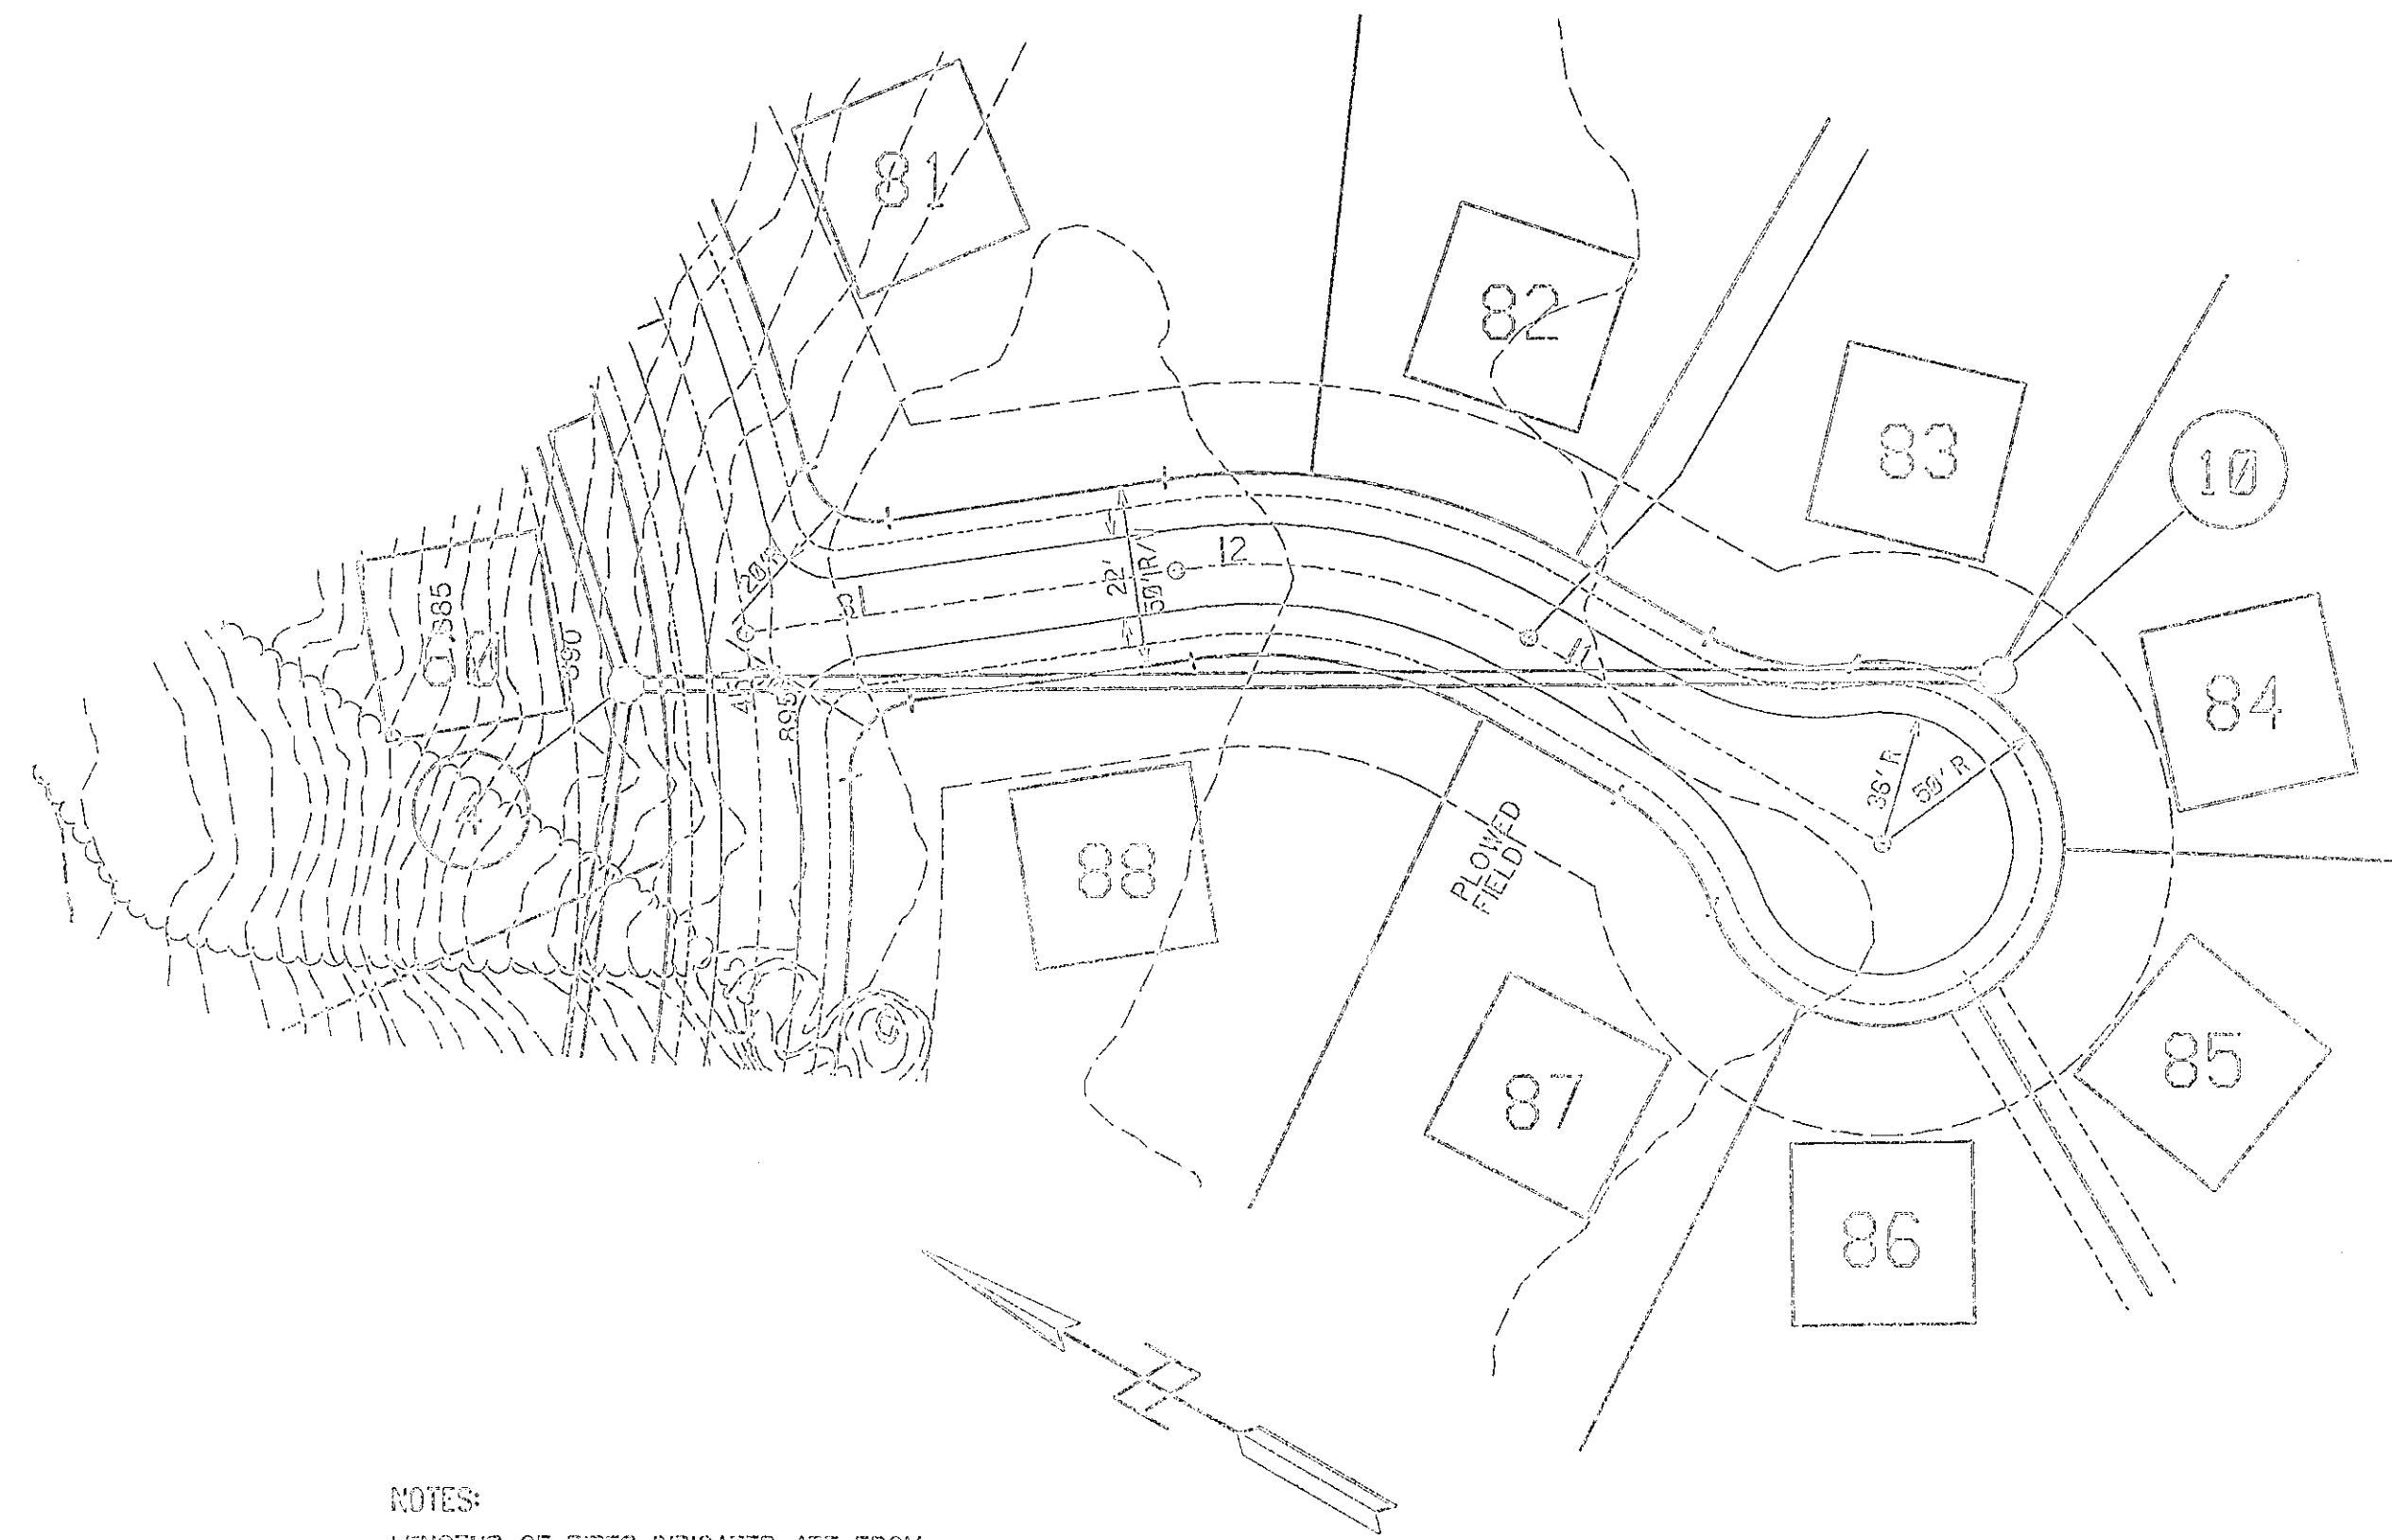


PLAN	DATE
SUNWATER	5/17
PLOTTED	
NOTE BOOK	15 OF 15 SHEETS
NO.	

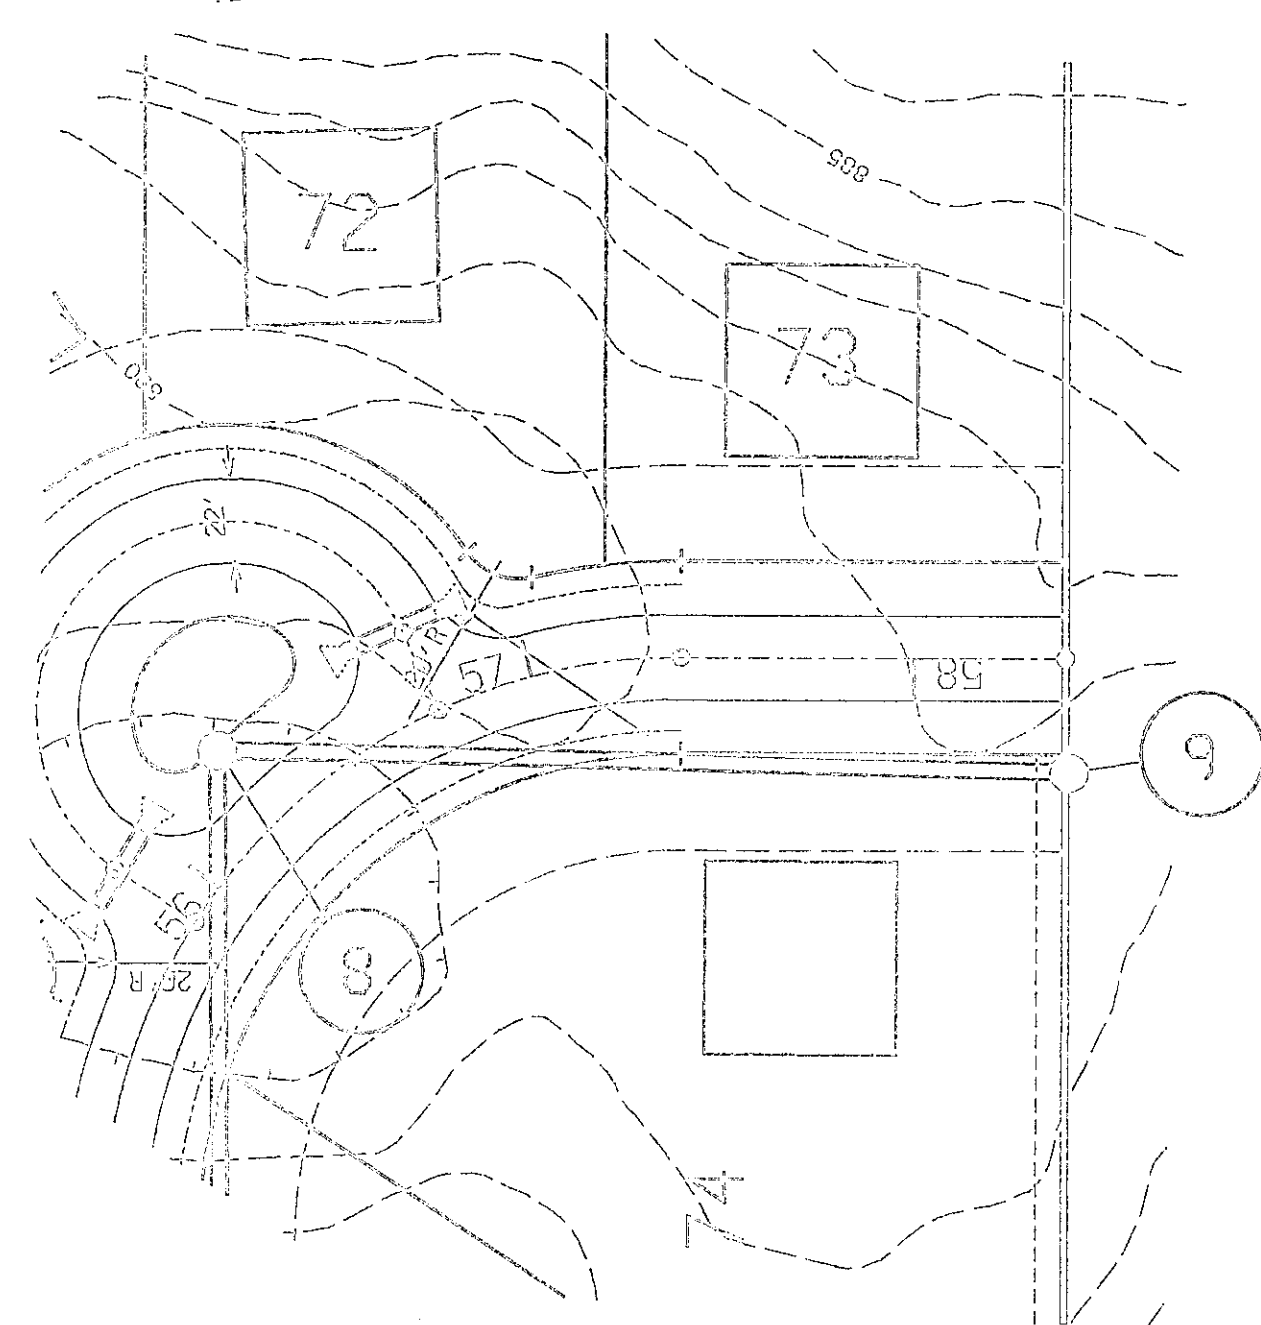


NOTES:
LENGTHS OF PIPES INDICATED ARE FROM
CENTER TO CENTER OF STRUCTURES AND
ARE NOT ACTUAL PIPE LENGTHS.

BENCH MARK DESCRIPTION

N-E CORNER OF CONCRETE WALK TO RONALD FILMOUR
RESIDENCE LOCATED AT SOUTH SIDE OF HUNTSVILLE
ROAD APPROX. 0.9 MILE EAST OF INTERSECTION WITH OLD
87 N-E CORNER OF WALK IS ALSO THE TOP STEP OF
STEPS TO ROAD LEVEL. ELEV. = 878.90

PLAN	DATE
SUNWATER	5/17
PLOTTED	
NOTE BOOK	15 OF 15 SHEETS
NO.	

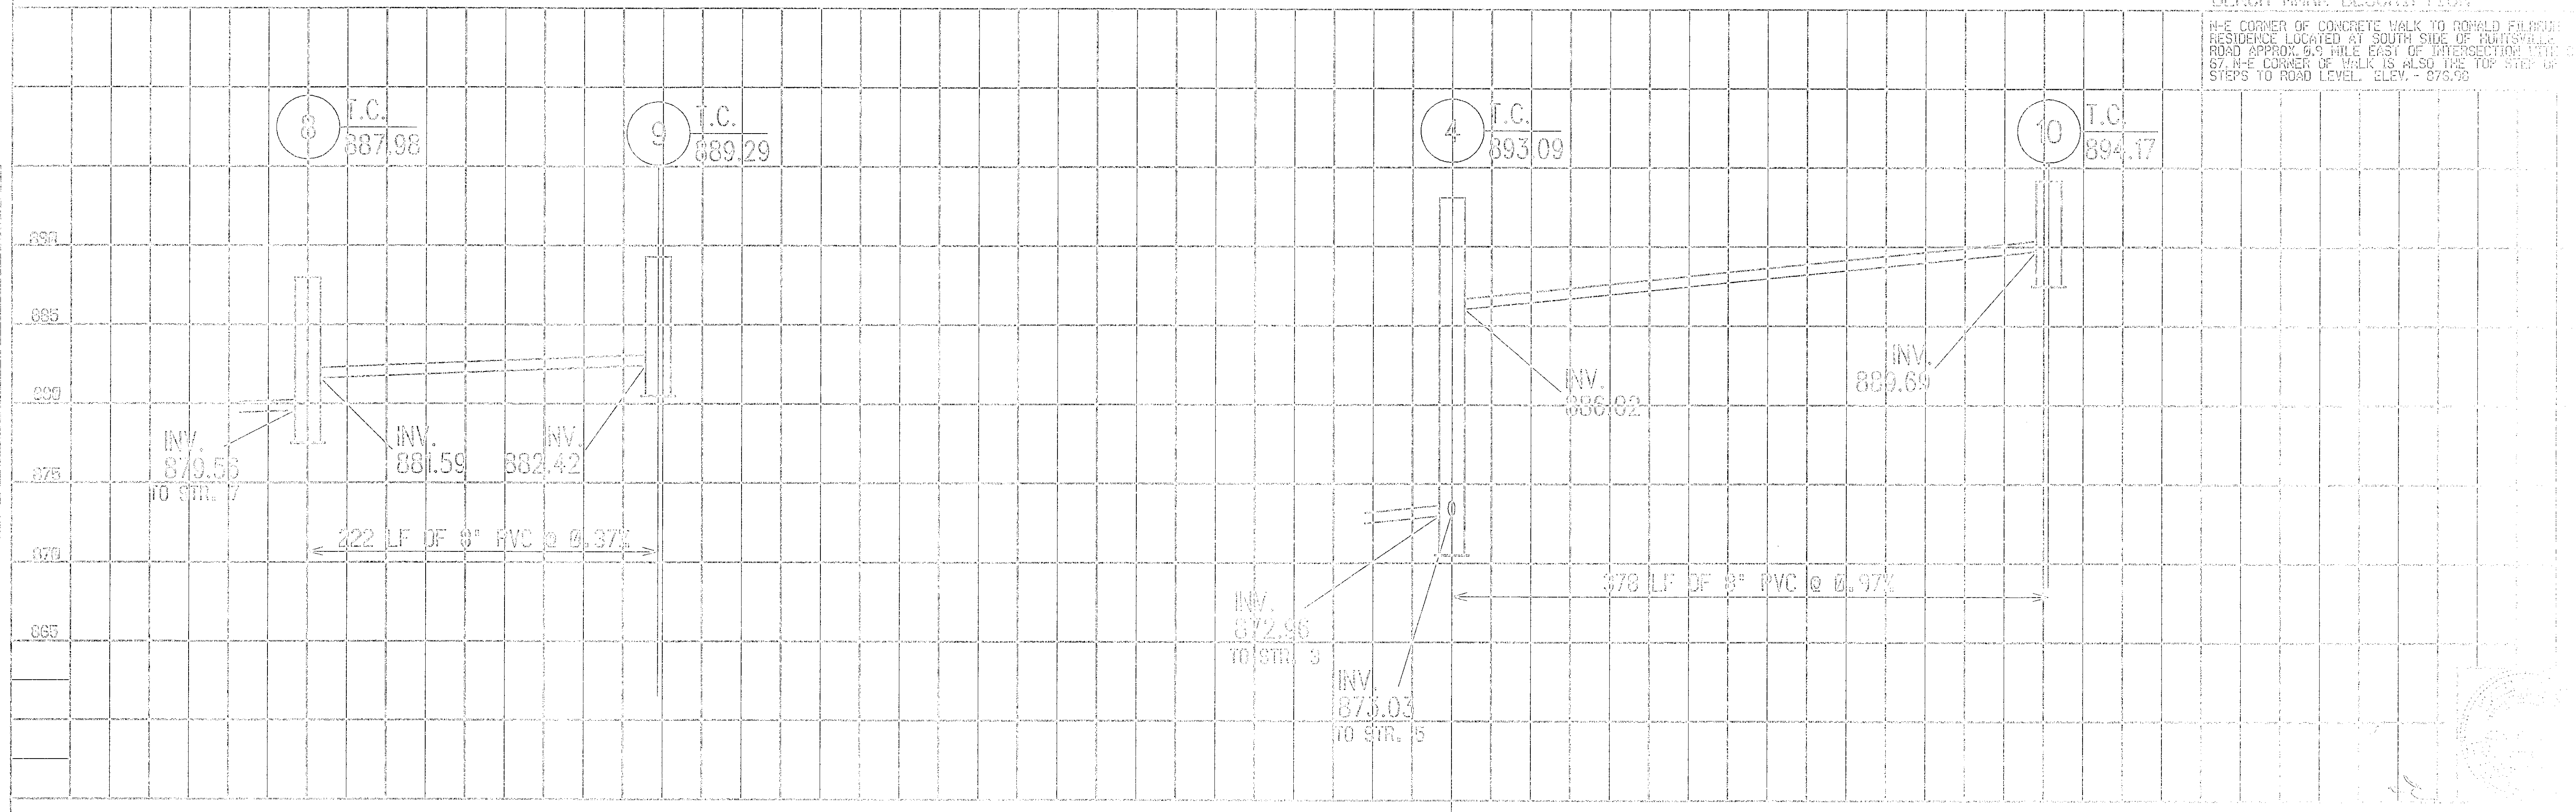

HICKORY HILLS EAST SECTION THREE SANITARY SEWER AS-BUILT