


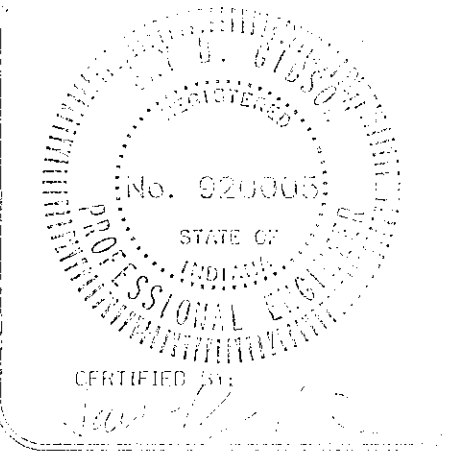

CDG CONSULTING L.L.C.
RESIDENTIAL COMMERCIAL
COMPLETE SITE DEVELOPMENT SERVICES
100 WEST OAK STREET SUITE 400 ZIONSVILLE, IN 46077
TELEPHONE 317-297-1122



FILE DATE
APRIL 6, 1995
AS-BUILTS 1/11/2000

DEVELOPMENT/
DRAINAGE
PLAN

SCALE: 1" = 100'
SHEET NO. 4

Hickory Hills
Section 4,
Madison County, Indiana
developed by:
Douglas W. Fanning

SHEET #
4
PROJECT NO.
9095

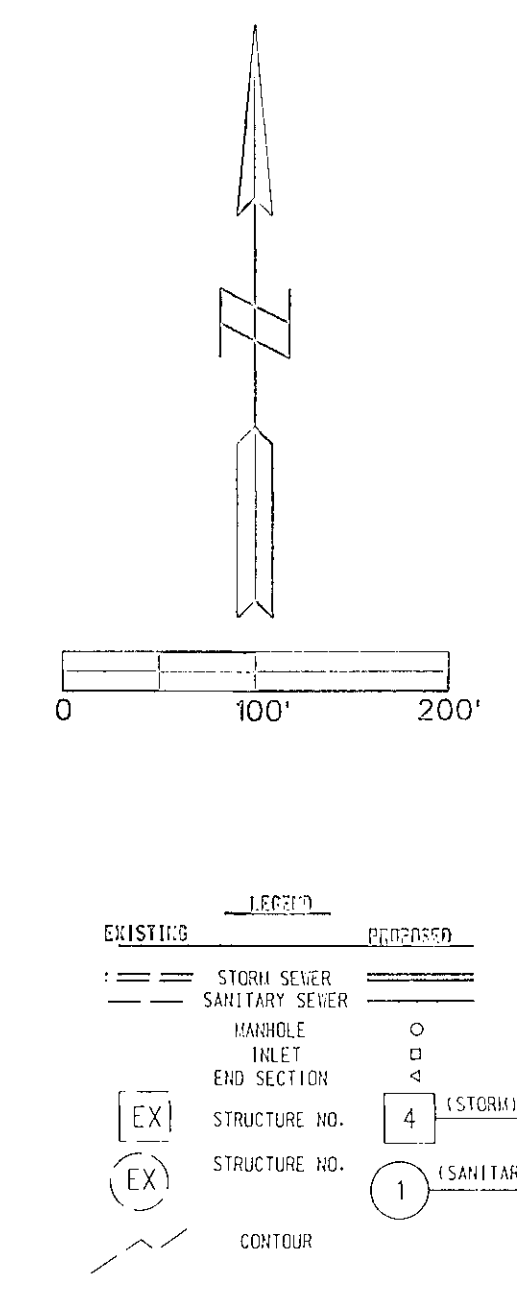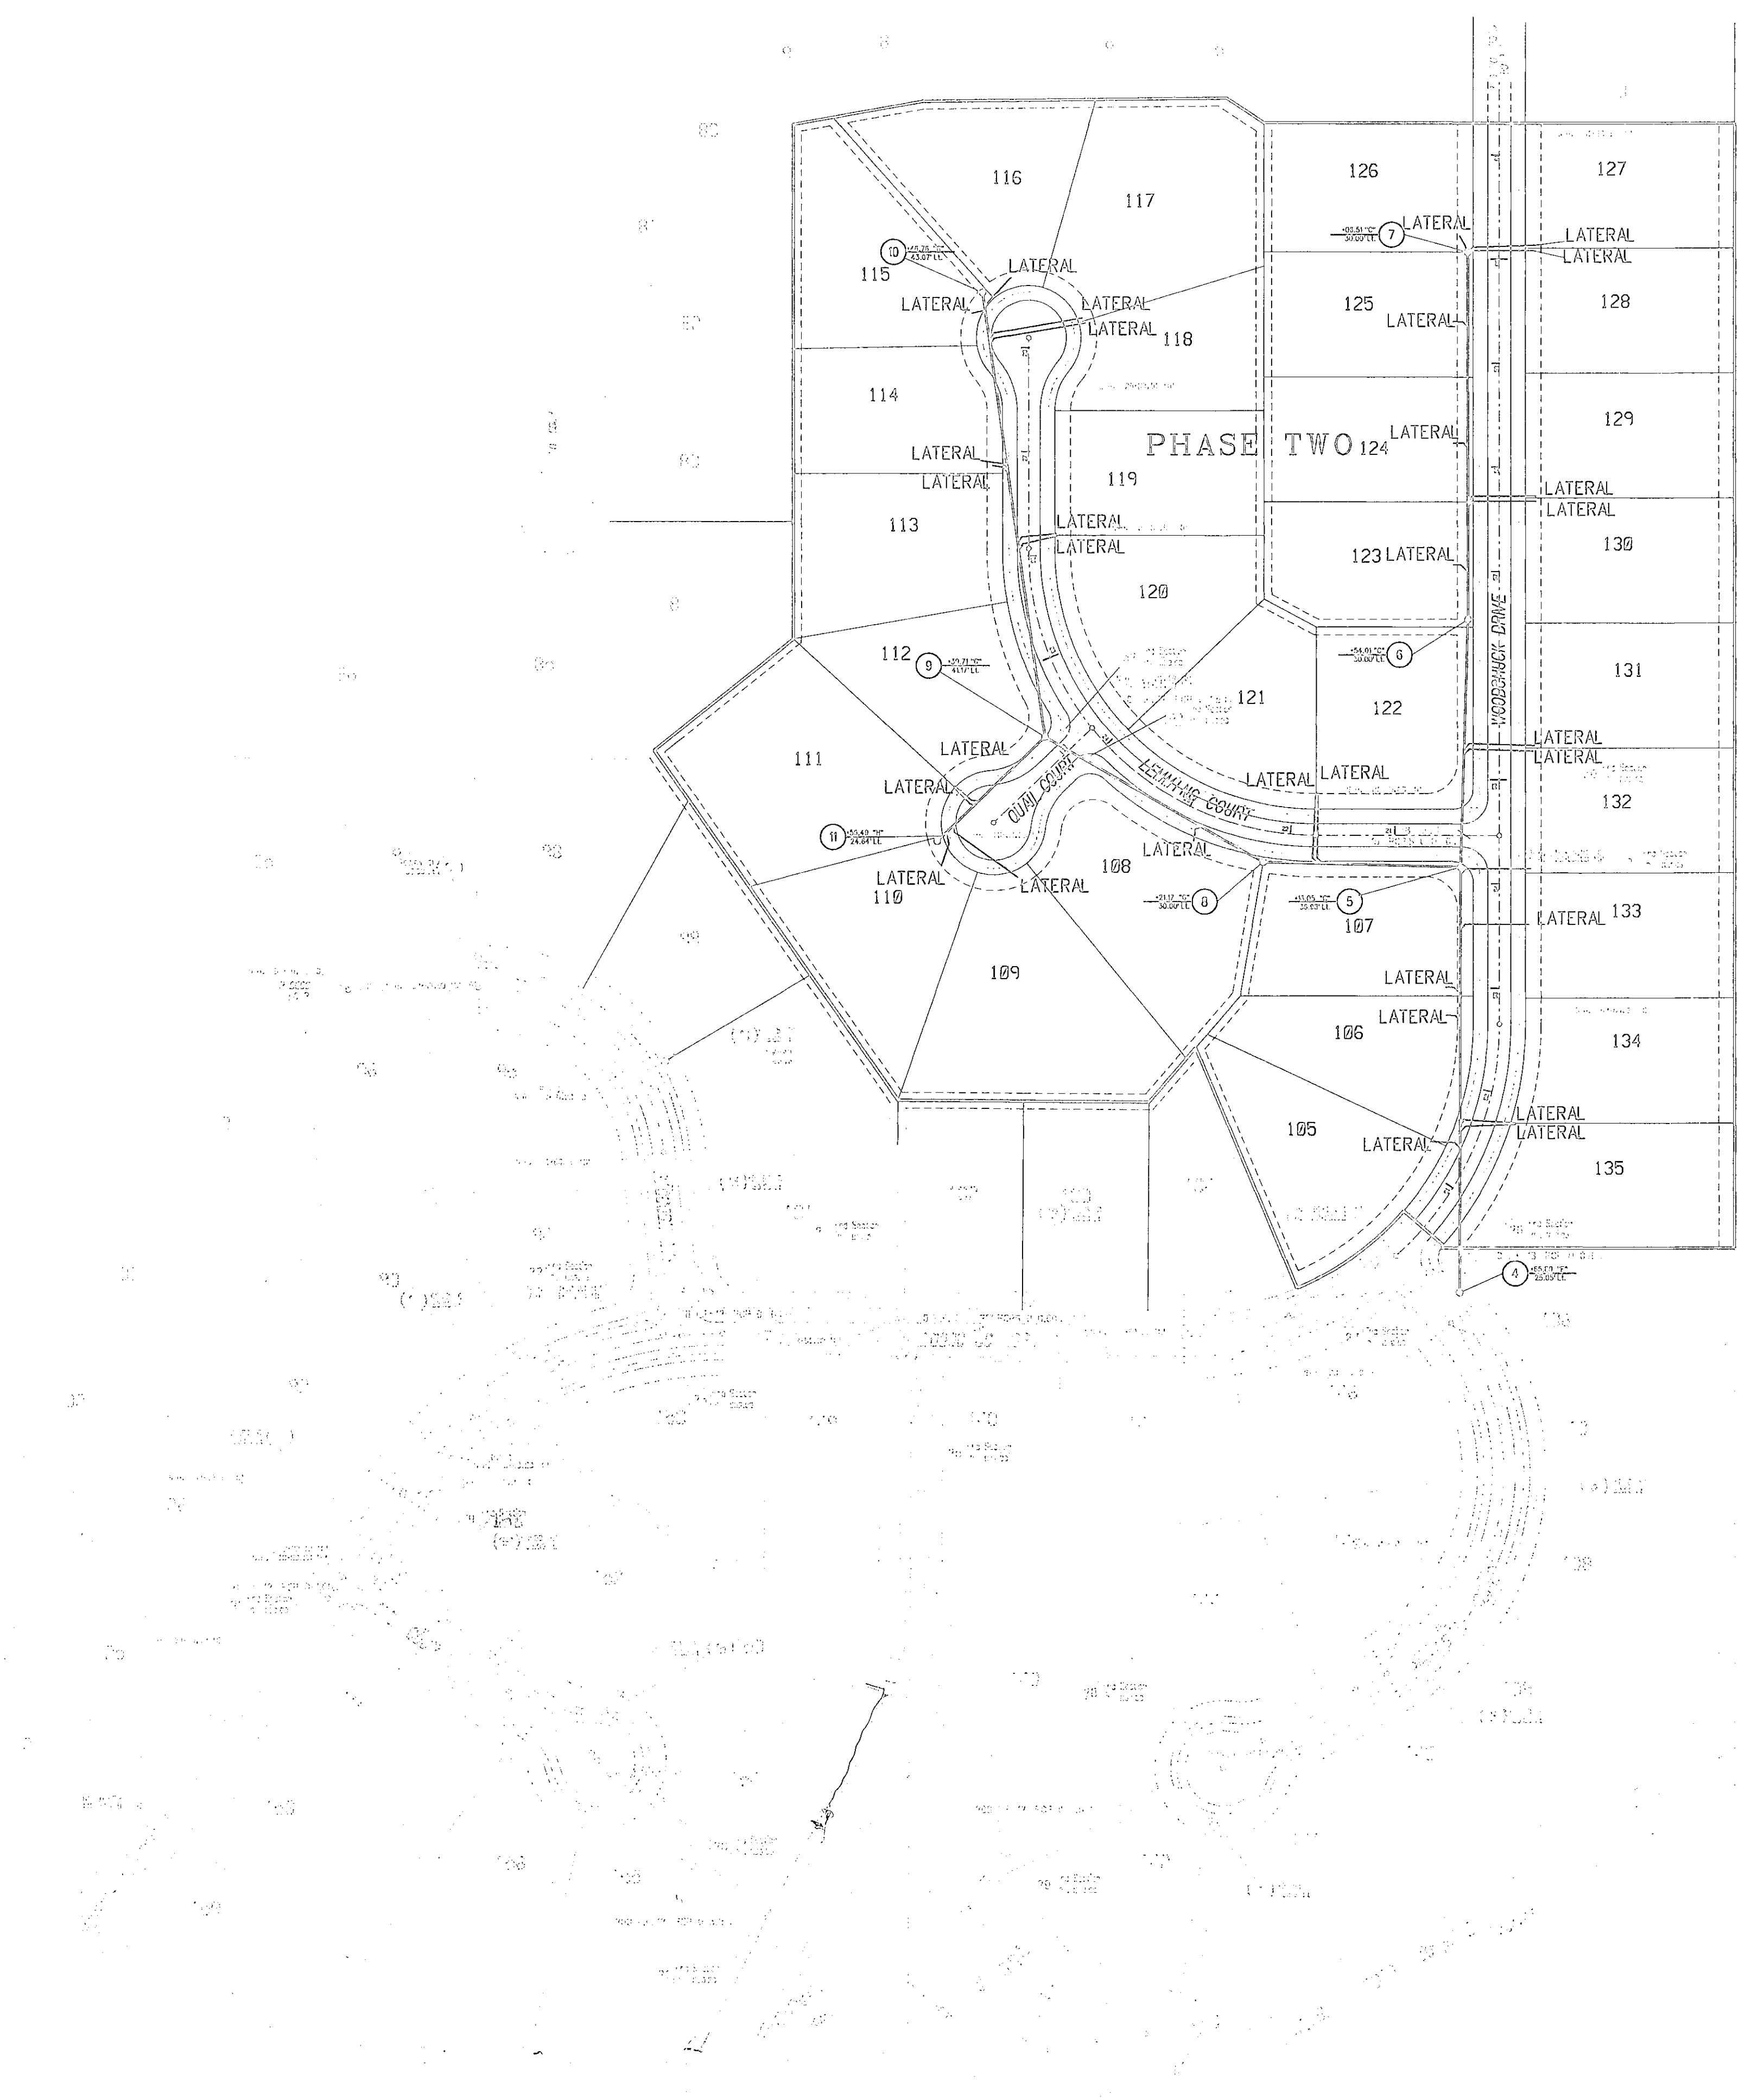

EXISTING	PROPOSED
STORM SEWER	STORM SEWER
SANITARY SEWER	SANITARY SEWER
MANHOLE	MANHOLE
INLET	INLET
END SECTION	END SECTION
STRUCTURE NO. 4	STRUCTURE NO. 4 (STORM)
STRUCTURE NO. 1	STRUCTURE NO. 1 (SANITARY)
CONTOUR	CONTOUR

AS-BUILTS
PHASE TWO

Jan B. Cole
1/13/2000

BENCHMARK DESCRIPTION:

RAILROAD SPIKE IN POWER POLE "RM25"
FROM PENDELTON FLOOD INSURANCE RATE MAP
ELEV. - 888.24

