


Existing manhole
T.C. - 880.63
INV. - 873.08

1 TAP
@ 1.5' X 61' RADI 2 COL. OF SAC
67' RADI 2 M.H. #1
DEPTH @ 8.5' @ EXISTING
OR 6' @ 2.5' BELOW M.H. #1 CAPTION

4 +65.80 "F"
25.05' LL

3 +59.40 "F"
30.00' LL

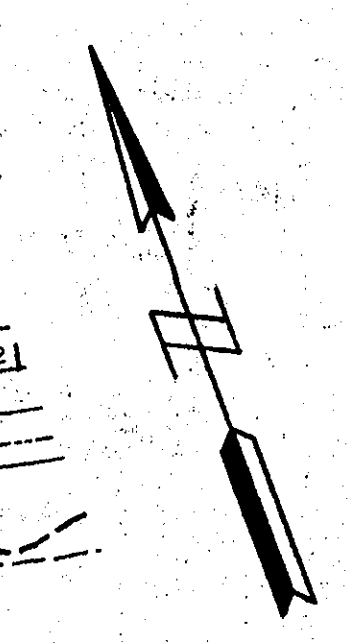

2 TAPS
@ 201.0 X 6.5
@ 204.5 X 6.5
CAPTION @ 45°

END
3/25/96
8' FT.

END
3/26/96
411.0'

END
3/27/96
145.0'

END
3/28/96
203.0'

END
3/29/96
0.0' SET BOXES

END
4/1/96
135' MARK

END
4/1/96
135' MARK

NOTES:


LENGTHS OF PIPES INDICATED ARE FROM
CENTER TO CENTER OF STRUCTURES AND
ARE NOT ACTUAL PIPE LENGTHS.

NOTES:

CONTRACTOR SHALL BE RESPONSIBLE FOR CONTACTING ALL PERMIT ISSUING AGENCIES
WITHIN THE TIME FRAME SPECIFIED BY THAT AGENCY PRIOR TO BEGINNING CONSTRUCTION



SCALE:
PLAN: 1" = 50'
PROFILE: 1" = 5'
HORIZONTAL: 1" = 50'

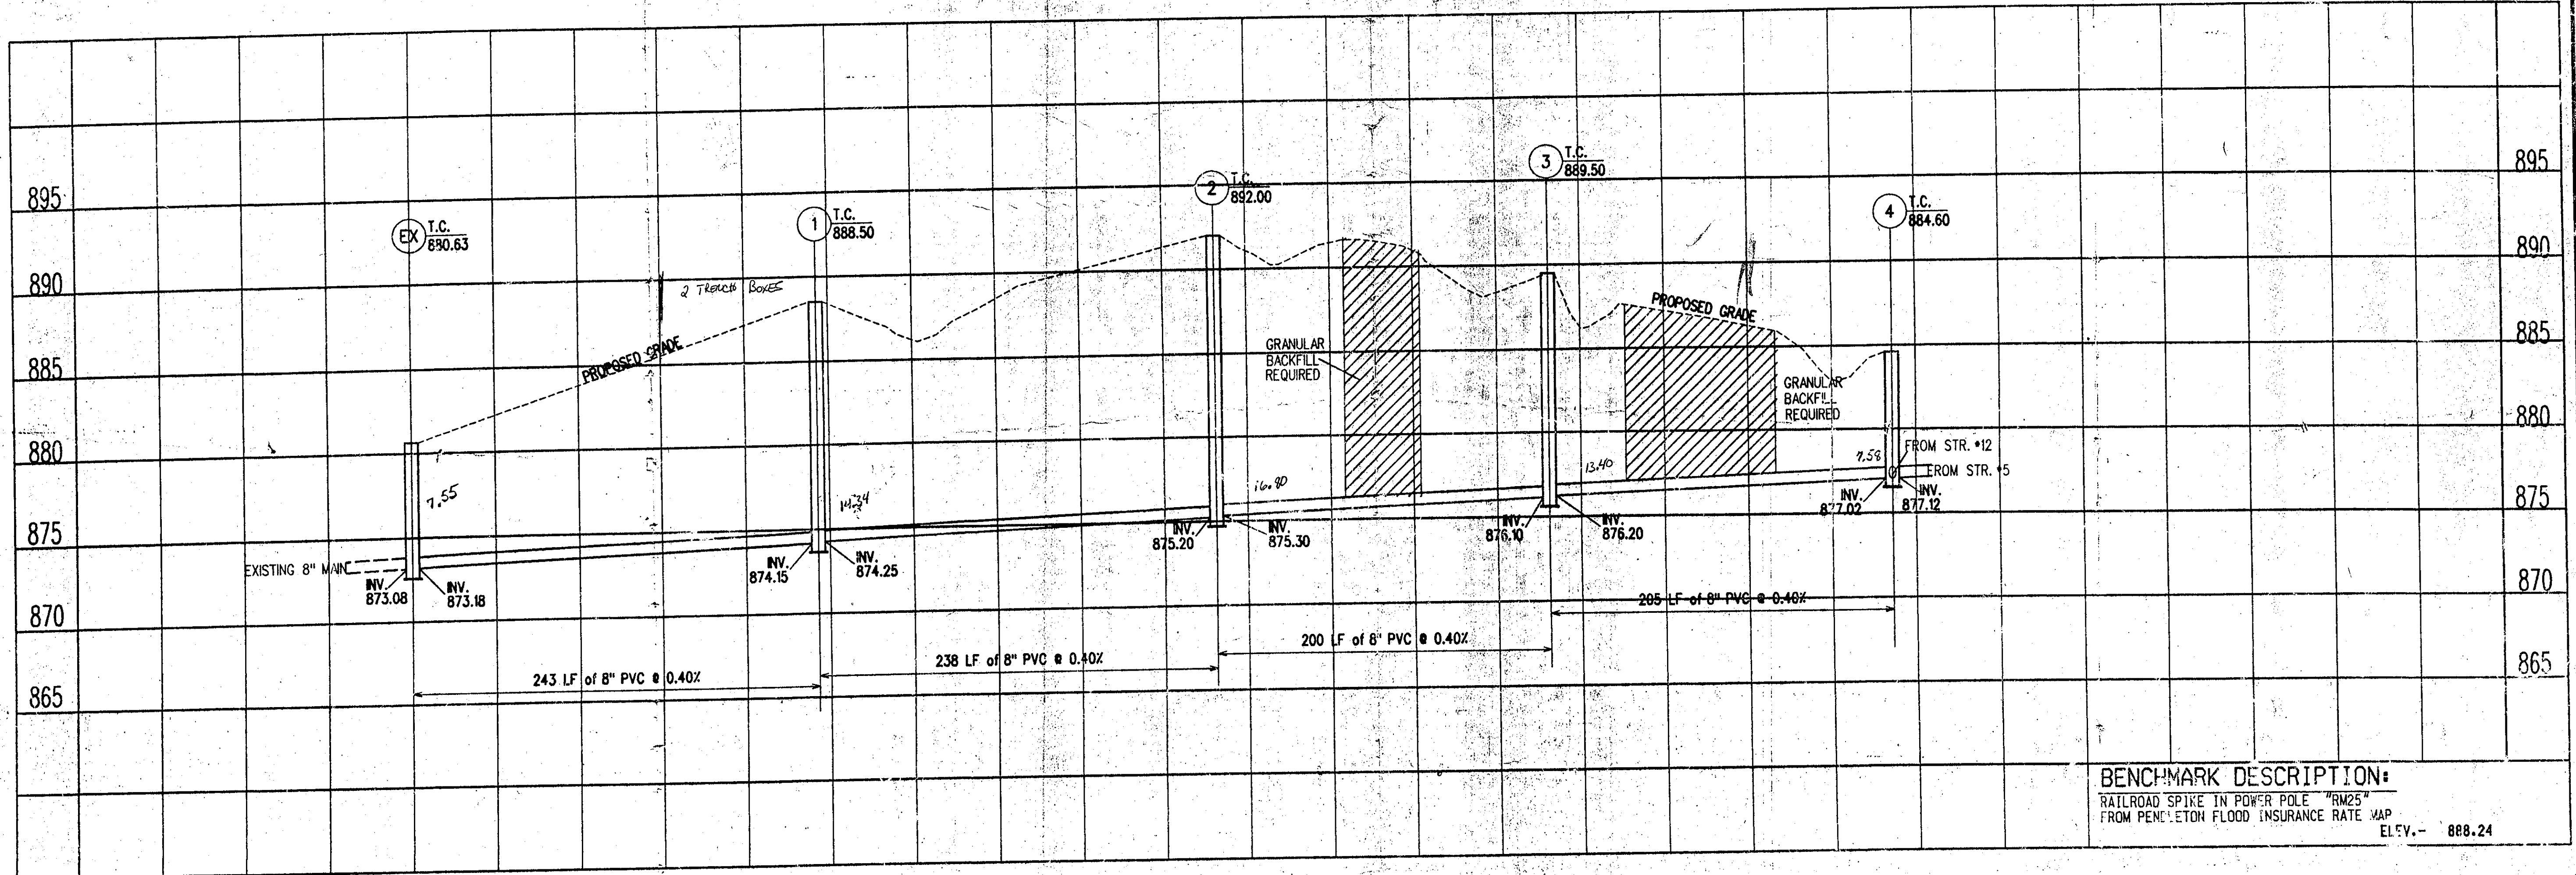

BENCHMARK DESCRIPTION:
RAILROAD SPIKE IN POWER POLE "RM25"
FROM PENCELTON FLOOD INSURANCE RATE MAP
ELEV. - 888.24



JB GIBSON
a division of J.B. GIBSON ENGINEERING & CONTRACTING, INC.
CONSULTING ENGINEERS - DEVELOPMENT - LAND SURVEYING
Laurens, Indiana 46052
121 1/2 North Lebanon Street
Telephone (317) 482-0255
FAX (317) 482-0297

FILE DATE
5-19-95

**SANITARY
SEWER
PROFILES**

SCALE: 1" = 50'

Project: **Hickory Hills**
Section 4
Madison County, Indiana
developed by: **Double H Farms**

SHEET #
10

PROJECT NO.
95S025