


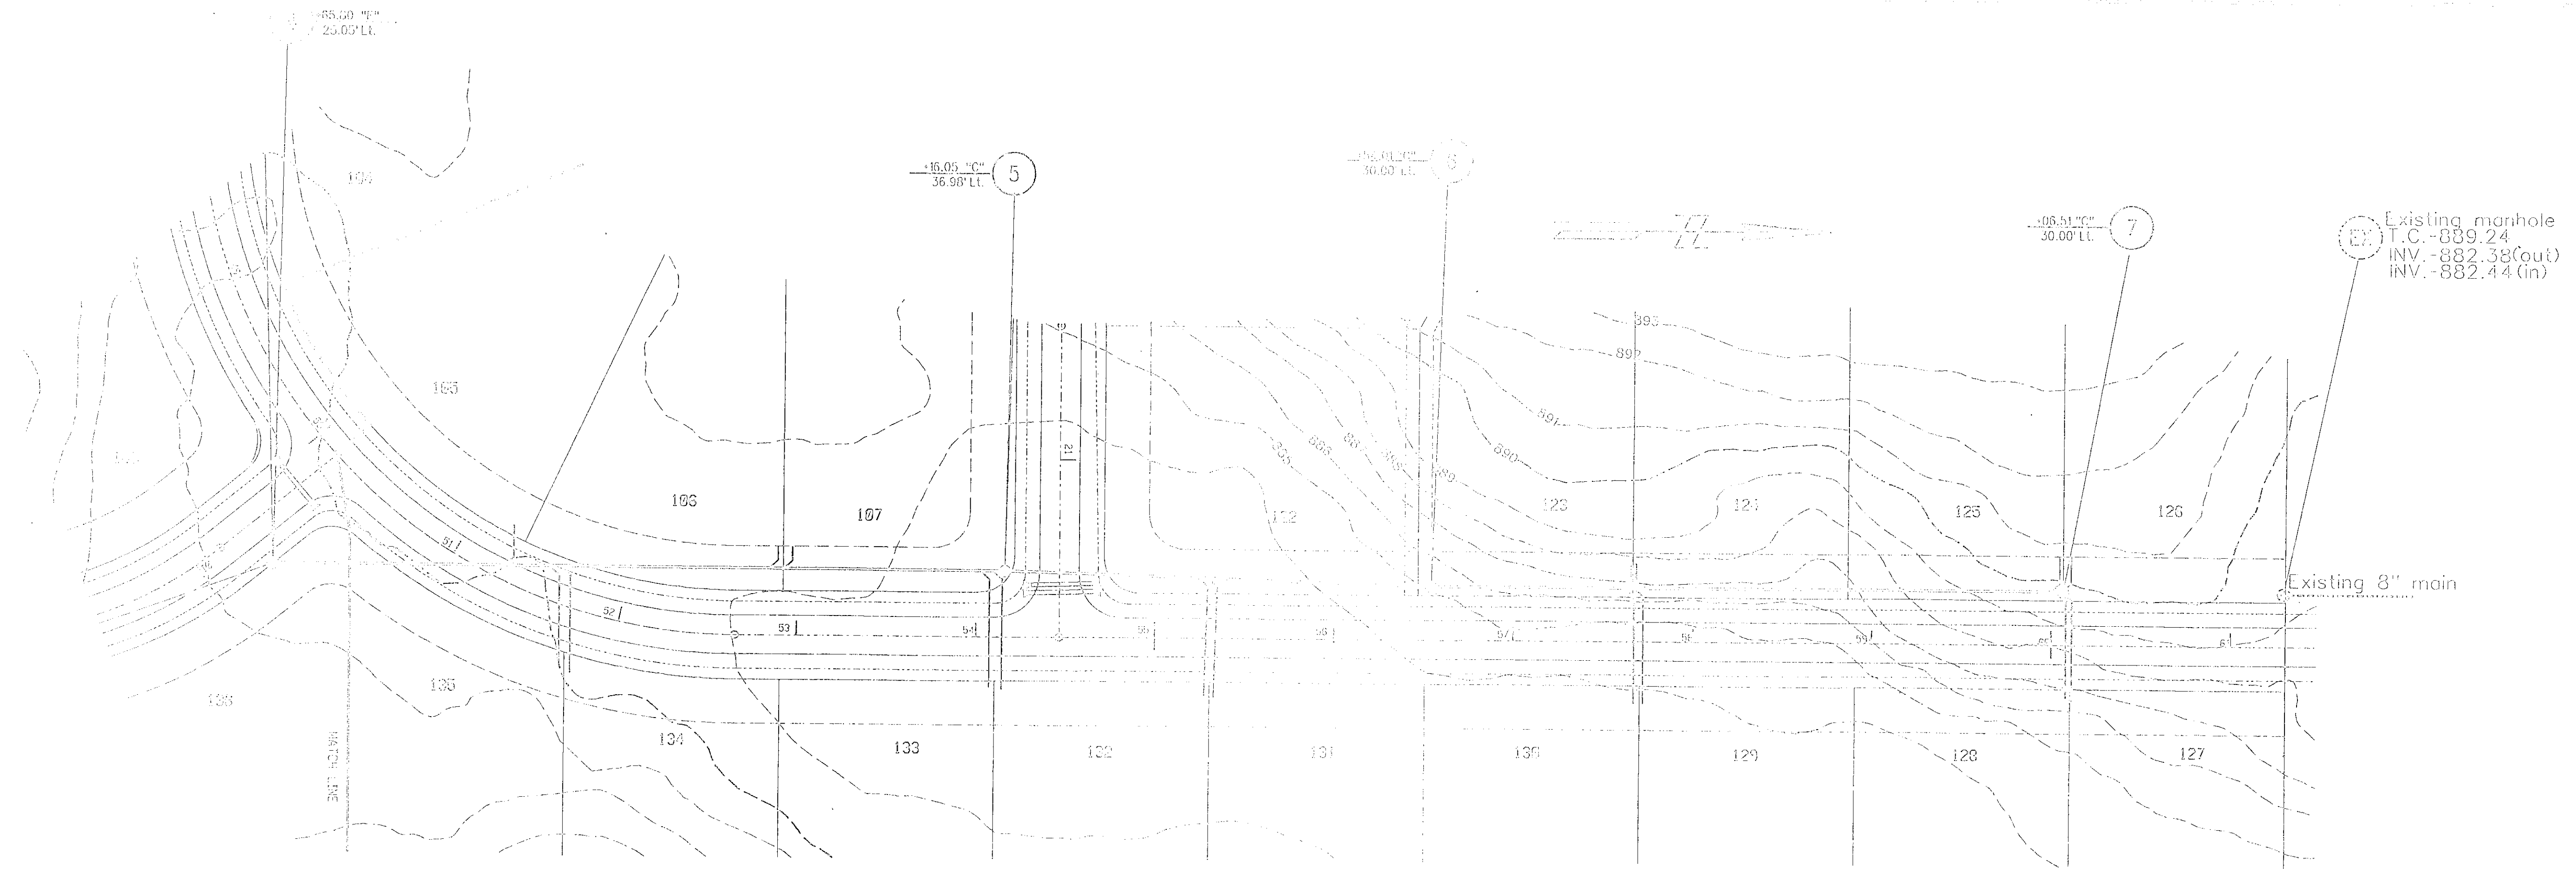



NOTES:
CONTRACTOR SHALL BE RESPONSIBLE FOR CONTACTING ALL PERMIT ISSUING AGENCIES
WHICH THE TIME FRAME SPECIFIED BY THAT AGENCY PRIOR TO BEGINNING CONSTRUCTION

NOTES:
LENGTHS OF PIPES INDICATED ARE FROM
CENTER TO CENTER OF STRUCTURES AND
ARE NOT ACTUAL PIPE LENGTHS.

GRANULAR
BACKFILL
REQUIRED

"DO NOT DIG BLIND"
1-800-522-5844
CALL BEFORE YOU DIG

SCALE:
PLAN 1" = 50'
PROFILE VERTICAL 1" = 5'
HORIZONTAL 1" = 50'

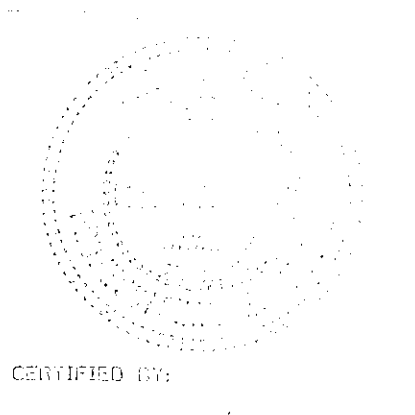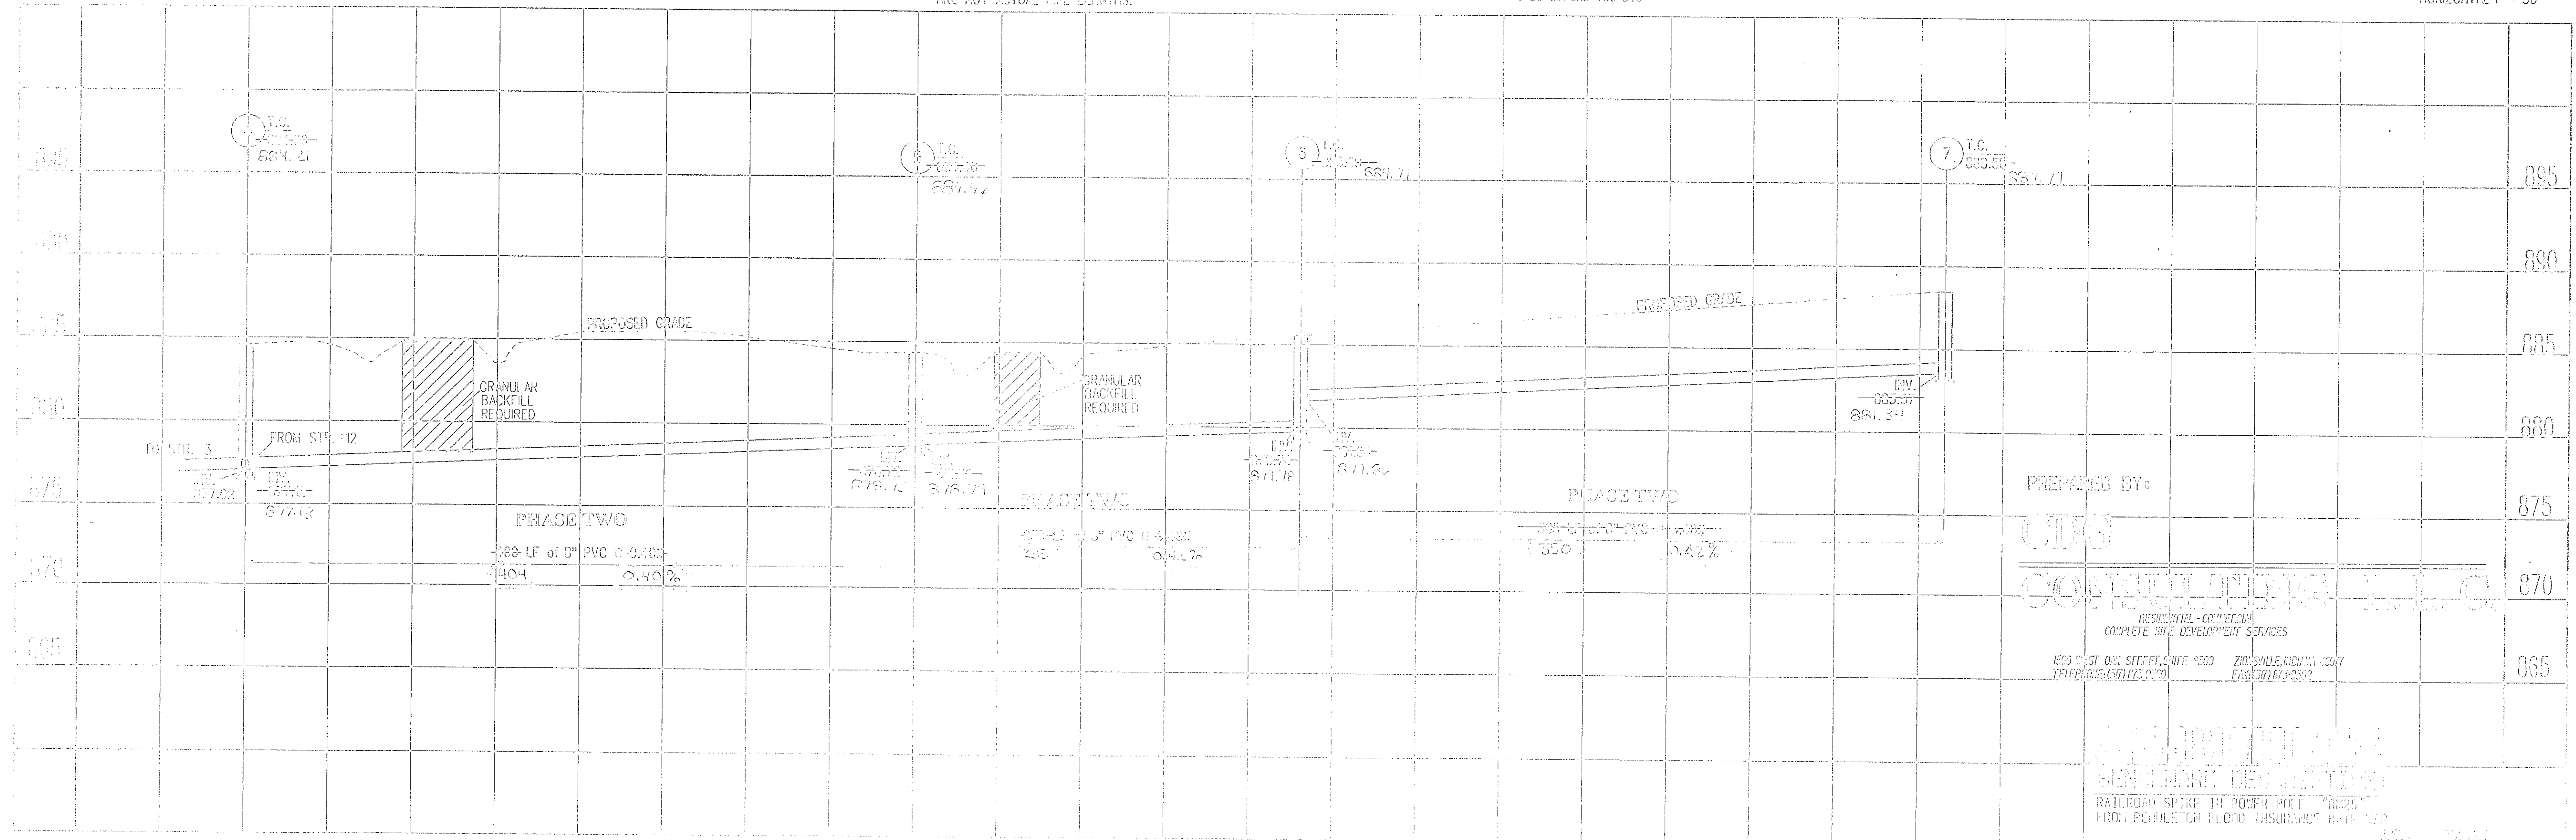

CDS CONSULTING, LLC
A DIVISION OF CDS ENGINEERING & CONSULTING, LLC
CONSULTING ENGINEERS - CIVIL/ENVIRONMENTAL
1000 N. LAKE STREET, SUITE 200
CHICAGO, ILLINOIS 60610
TEL: 312.555.1234
WWW.CDS-CONSULTING.COM

FILE DATE:
5-15-21
**SANITARY
SEWER
PROFILES**

PROJECT:
1000 N. LAKE STREET, SUITE 200
CHICAGO, ILLINOIS 60610
SHEET NO. 1 OF 1

SHEET NO. 1 OF 1

DATE: 5/15/21
DRAWN BY: J. SMITH
CHECKED BY: J. SMITH
APPROVED BY: J. SMITH

PRINT GRAPHICS FOR FAST COPIES 342-3121