


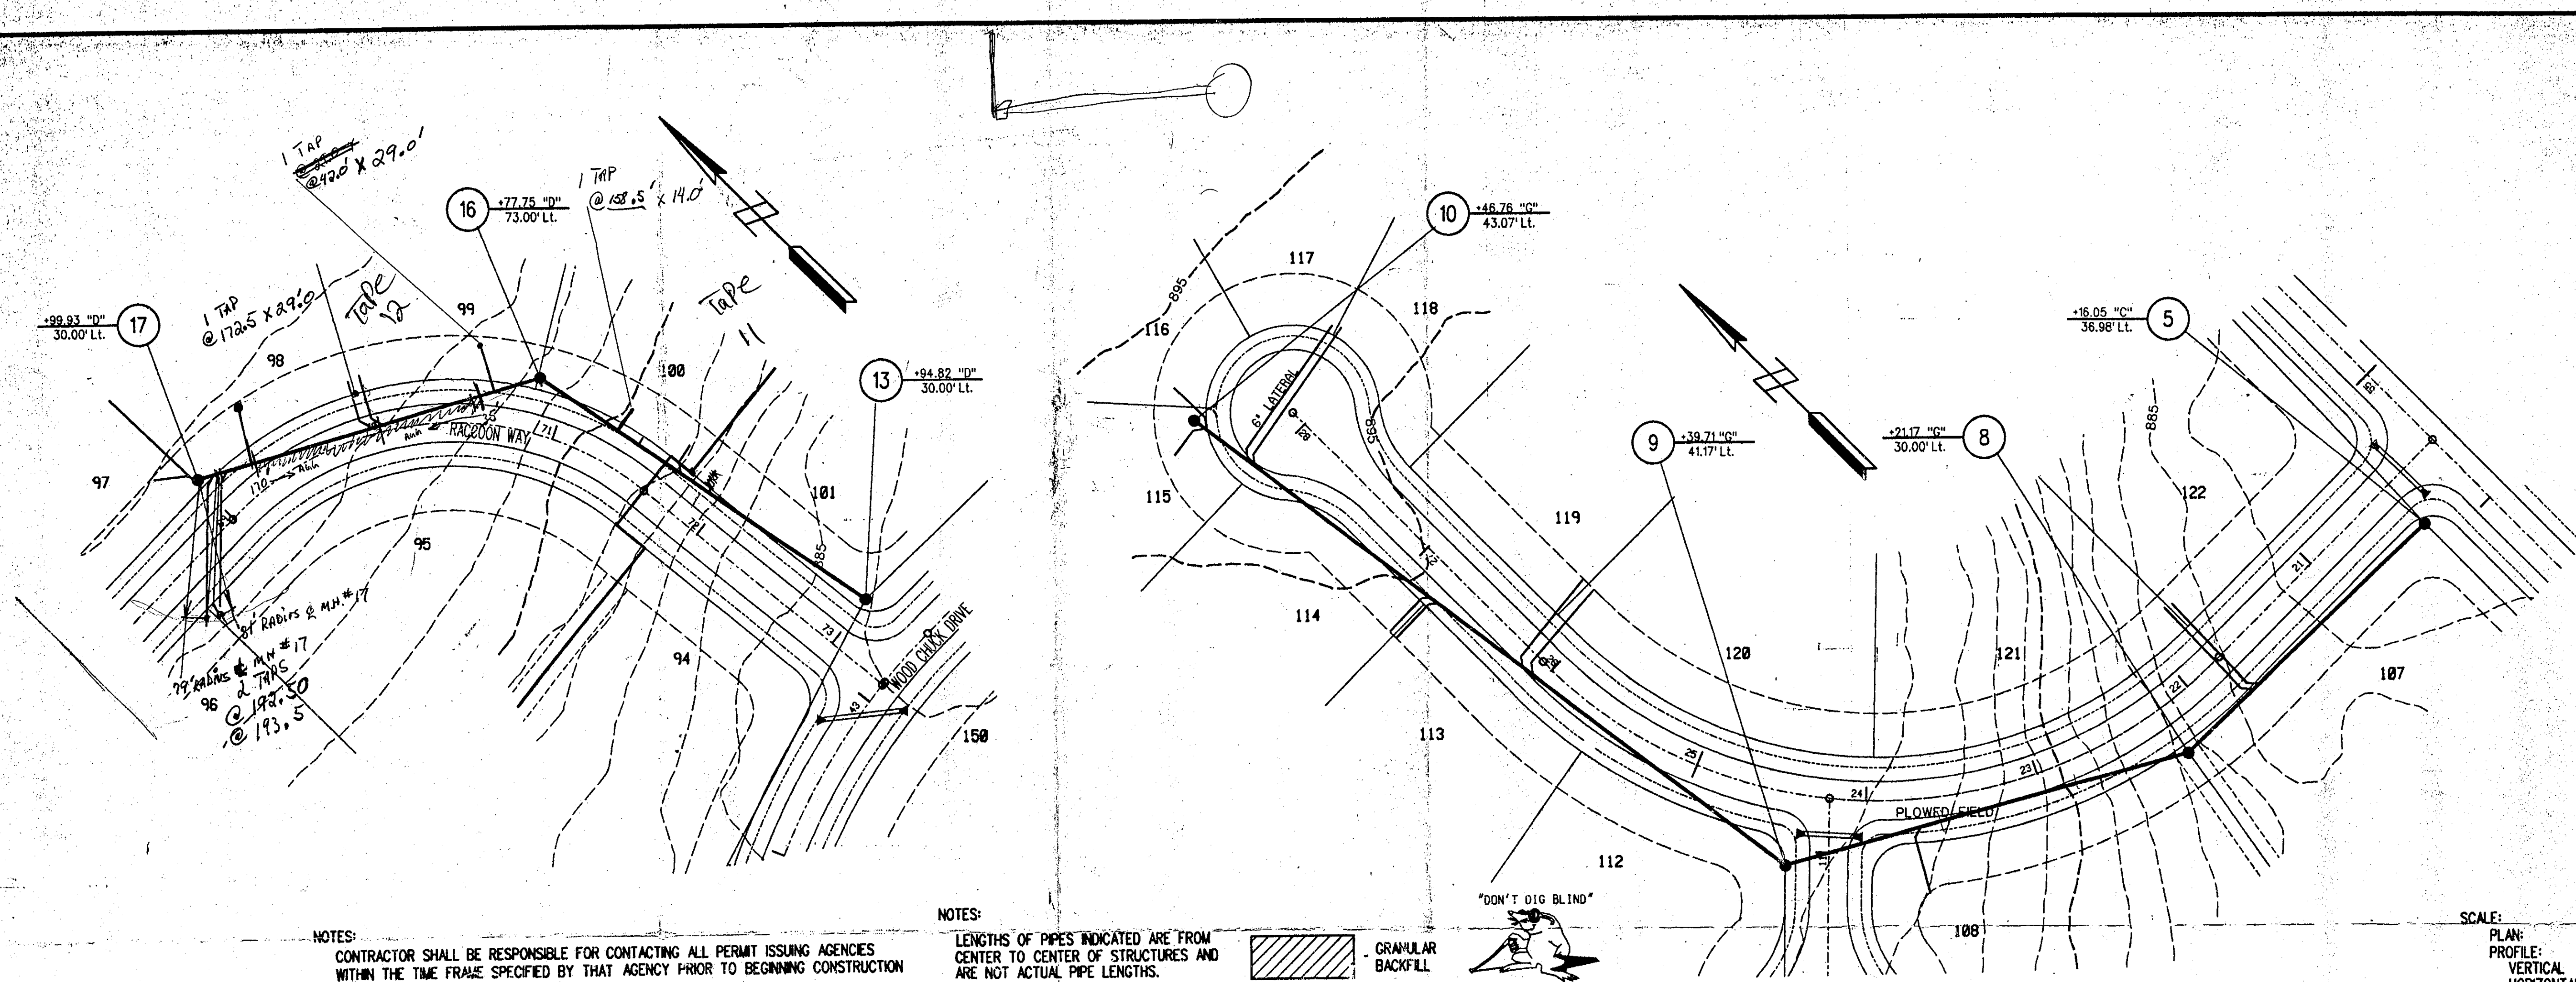


NOTES:
CONTRACTOR SHALL BE RESPONSIBLE FOR CONTACTING ALL PERMIT ISSUING AGENCIES
WITHIN THE TIME FRAME SPECIFIED BY THAT AGENCY PRIOR TO BEGINNING CONSTRUCTION

NOTES:
LENGTHS OF PIPES INDICATED ARE FROM
CENTER TO CENTER OF STRUCTURES AND
ARE NOT ACTUAL PIPE LENGTHS.

GRANULAR
BACKFILL

"DON'T DIG BLIND"
1-800-382-5544
CALL BEFORE YOU DIG


SCALE:
PLAN: 1" = 50'
PROFILE: 1" = 5'
HORIZONTAL 1" = 50'

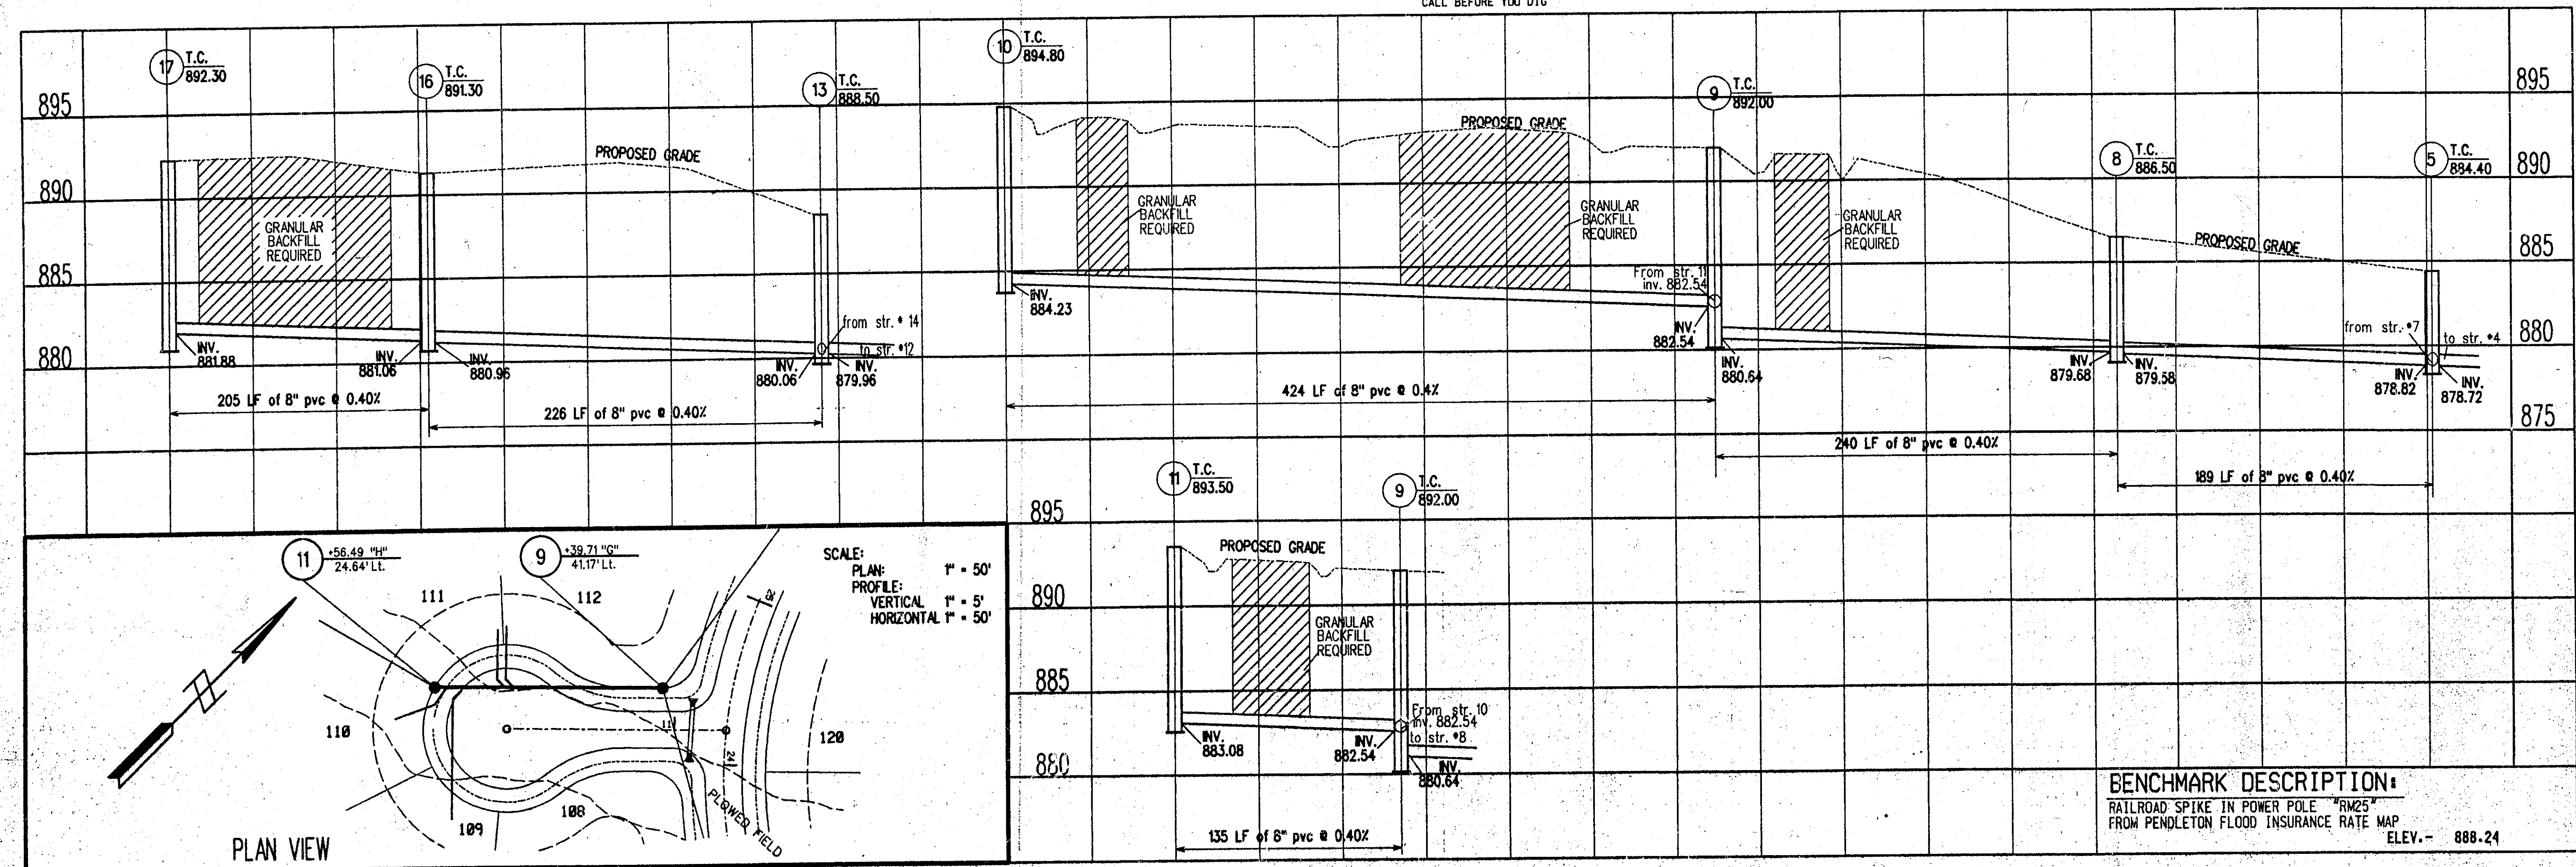

PLAN VIEW

SCALE:
PLAN: 1" = 50'
PROFILE: 1" = 5'
HORIZONTAL 1" = 50'

BENCHMARK DESCRIPTION:
RAILROAD SPIKE IN POWER POLE "RM25"
FROM PENDLETON FLOOD INSURANCE RATE MAP
ELEV. - 888.24

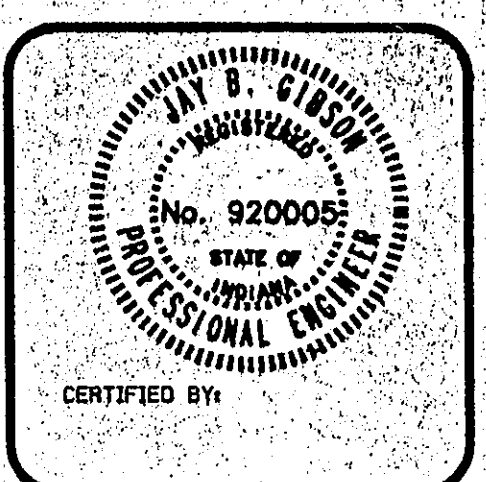

GIBSON
a division of M. B. BETTS ENGINEERING & CONTRACTING, INC.
CONSULTING ENGINEERS - LAND SURVEYING
Lebanon, Indiana 46032
112 1/2 North Lebanon Street
Telephone (317) 482-0235

FILE DATE
5-19-95
**SANITARY
SEWER
PROFILES**

Project:
**Hickory Hills
Section 4**
Madison County, Indiana

SHEET
1
PROJECT
95502