


Tim McCurdy 2/13/98

FALL CREEK REGIONAL WASTE DISTRICT MADISON COUNTY, INDIANA HUNTSVILLE SANITARY SEWER, LIFT STATION AND FORCEMAIN PROJECT FUNDED IN PART BY I.D.O.C. GRANT NO. CF 97-119 OCTOBER, 1997

SHEET INDEX


SHEET NO.	DESCRIPTION
1	Title Sheet
2	Base Map - West Half
3	Base Map - East Half
4	Forcemain Plan and Profile
5-11	Plan and Profile Sheets
12	Lift Station Detail Sheet
13	Standard Detail Sheet
14	Standard Detail Sheet

AREA MAP

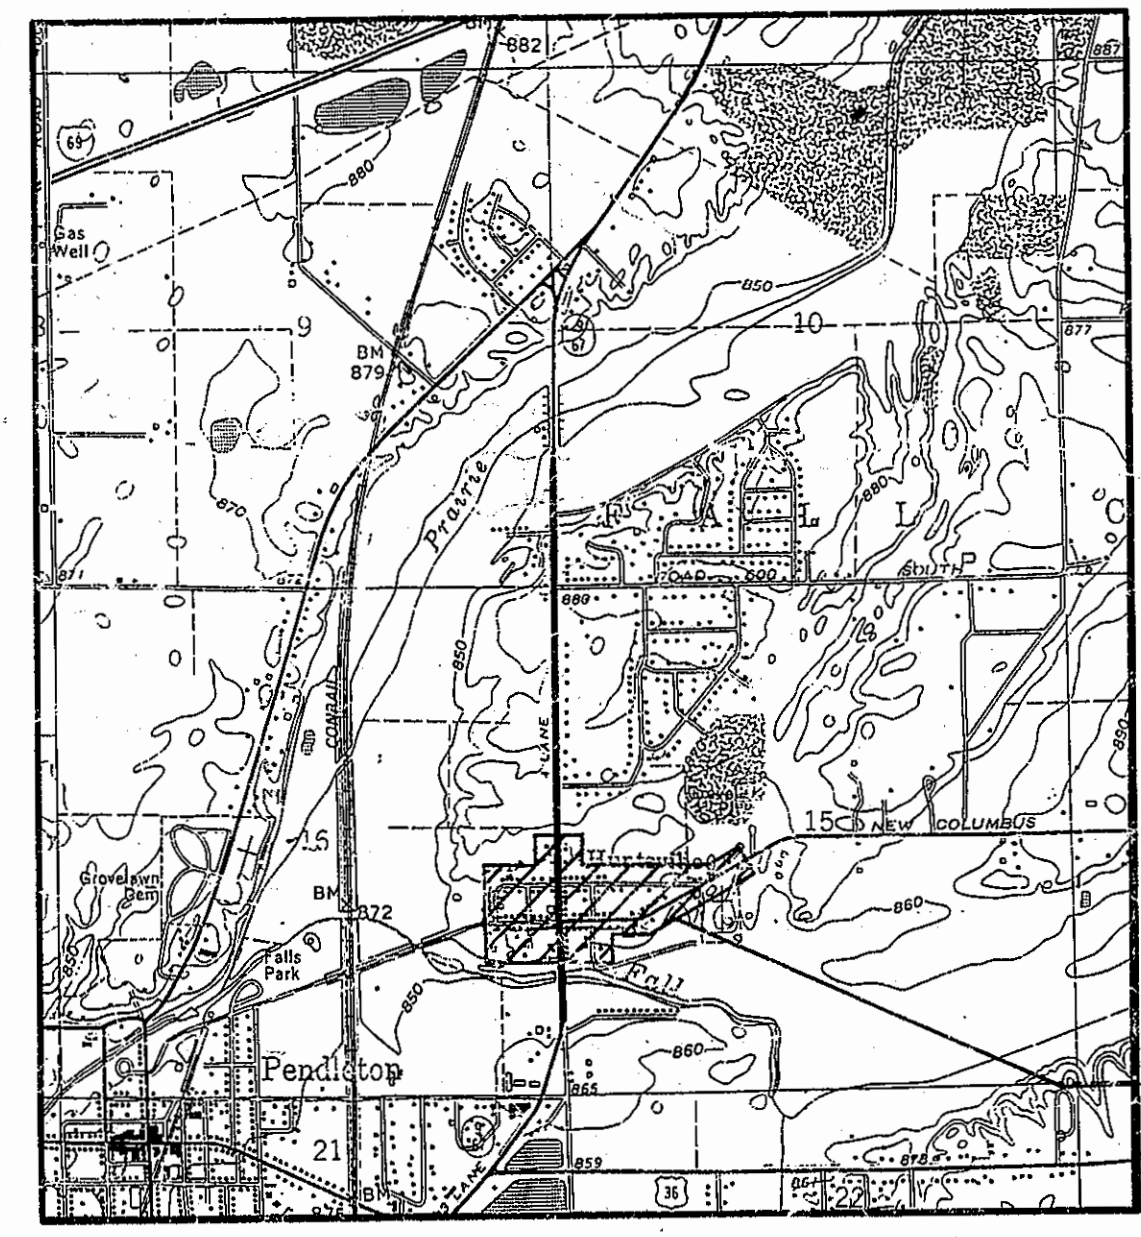

SCALE: 1" = 2,000'

LOCATION MAP

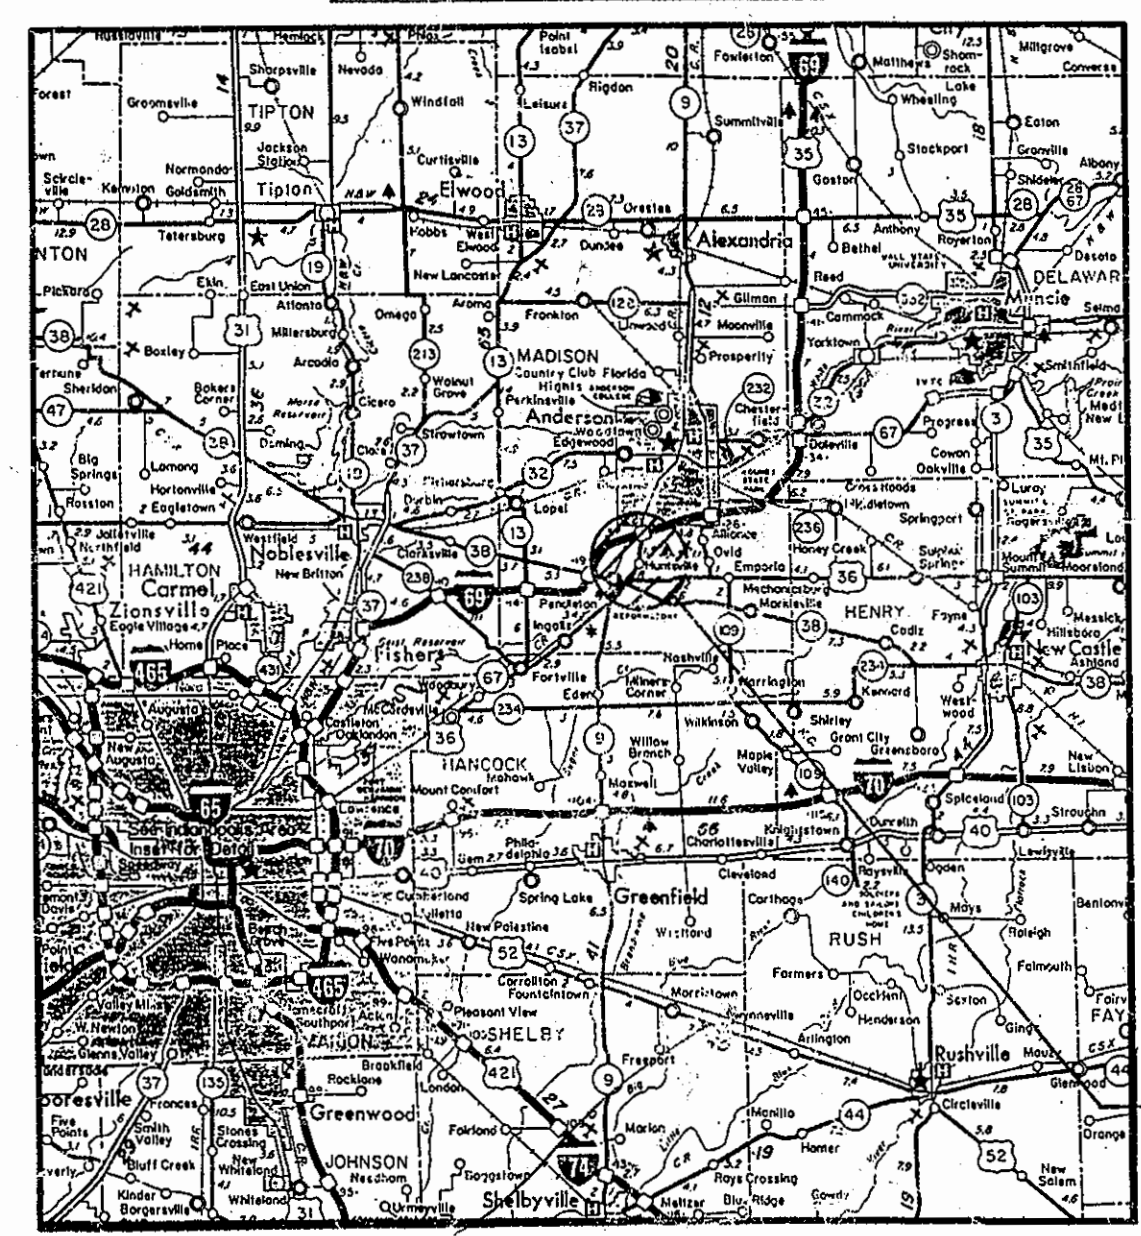

SCALE: 1" = 10 MILES

PROJECT AREA

PROJECT LOCATION

FALL CREEK REGIONAL WASTE DISTRICT BOARD

- Mr. William Clark -- President
- Mr. Morris McCurdy -- Member
- Mr. Doug McGee -- Member
- Mr. Mark Jablonski -- Member
- Mr. Agon Tolbert -- Member
- Mr. Marvin Kelly -- Member
- Mr. Jack Kasdorf -- Member
- Mr. Timothy Green -- Member
- Mr. John Ellingwood -- Member
- Mr. Joe Rowlett -- General Manager

MADISON COUNTY COMMISSIONERS

- Mr. Otis Cox
- Ms. Sandra Huntzinger
- Ms. Lucille Bailey

GRANT ADMINISTRATOR

Madison County Council
of Governments

PLANS PREPARED BY:

TRIAD ASSOCIATES INC.
INDIANAPOLIS, INDIANA

THESE PLANS CERTIFIED BY:

James W. Frazell, Professional Engineer

Thomas M. Schubert, Professional Engineer

