




BENCHMARK AND TEMPORARY BENCHMARK INFORMATION:

- INDOT BM MAD G-38 SOUTH END OF HEADWALL, CAP SET IN HIGHWAY 9 OVER FALL CREEK. ELEV. 862.27
- TBM #1 FLANGE BOLT UNDER 'Y' IN KENNEDY FIRE HYDRANT IN FRONT OF LACO SATELLITE CO. ELEV. 871.16
- TBM #2 SPIKE SET IN POWERPOLE No. 194-040 ON SOUTH SIDE OF NEW COLUMBUS ROAD AT BEND TO THE NORTHEAST. ELEV. 866.92
- TBM #3 RR SPIKE, UP 0.5', NORTH SIDE OF POWERPOLE No. 047-648 @ INTERSECTION OF HUNTSVILLE ROAD AND MARKET STREET. ELEV. 865.30
- TBM #4 NAIL SPIKE, UP 1', NORTH SIDE OF POWERPOLE No. 047-639 @ SOUTHWEST CORNER OF MAIN STREET AND CROSS STREET. ELEV. 868.77
- TBM #5 NAIL SPIKE, UP 1', SOUTH SIDE OF POWERPOLE NORTHWEST CORNER OF STATE ROAD No. 67 AND MAIN STREET. ELEV. 870.87
- TBM #6 'X' CUT IN TOP OF BRIDGE RAIL, NORTHEAST CORNER OF BRIDGE ON STATE ROAD No. 67 OVER FALL CREEK. ELEV. 862.90
- TBM #7 PK NAIL IN EAST SIDE OF POWERPOLE APP. 50' NORTH OF INTERSECTION OF WATER STREET AND COUNTY ROAD 300W WEST SIDE OF ROAD, 0.8' UP. ELEV. 863.94

NOTE:
ADDITIONAL RIGHT-OF-WAY OR EASEMENTS MAY
NEED TO BE ACQUIRED FOR INSTALLATION OF SEWER.

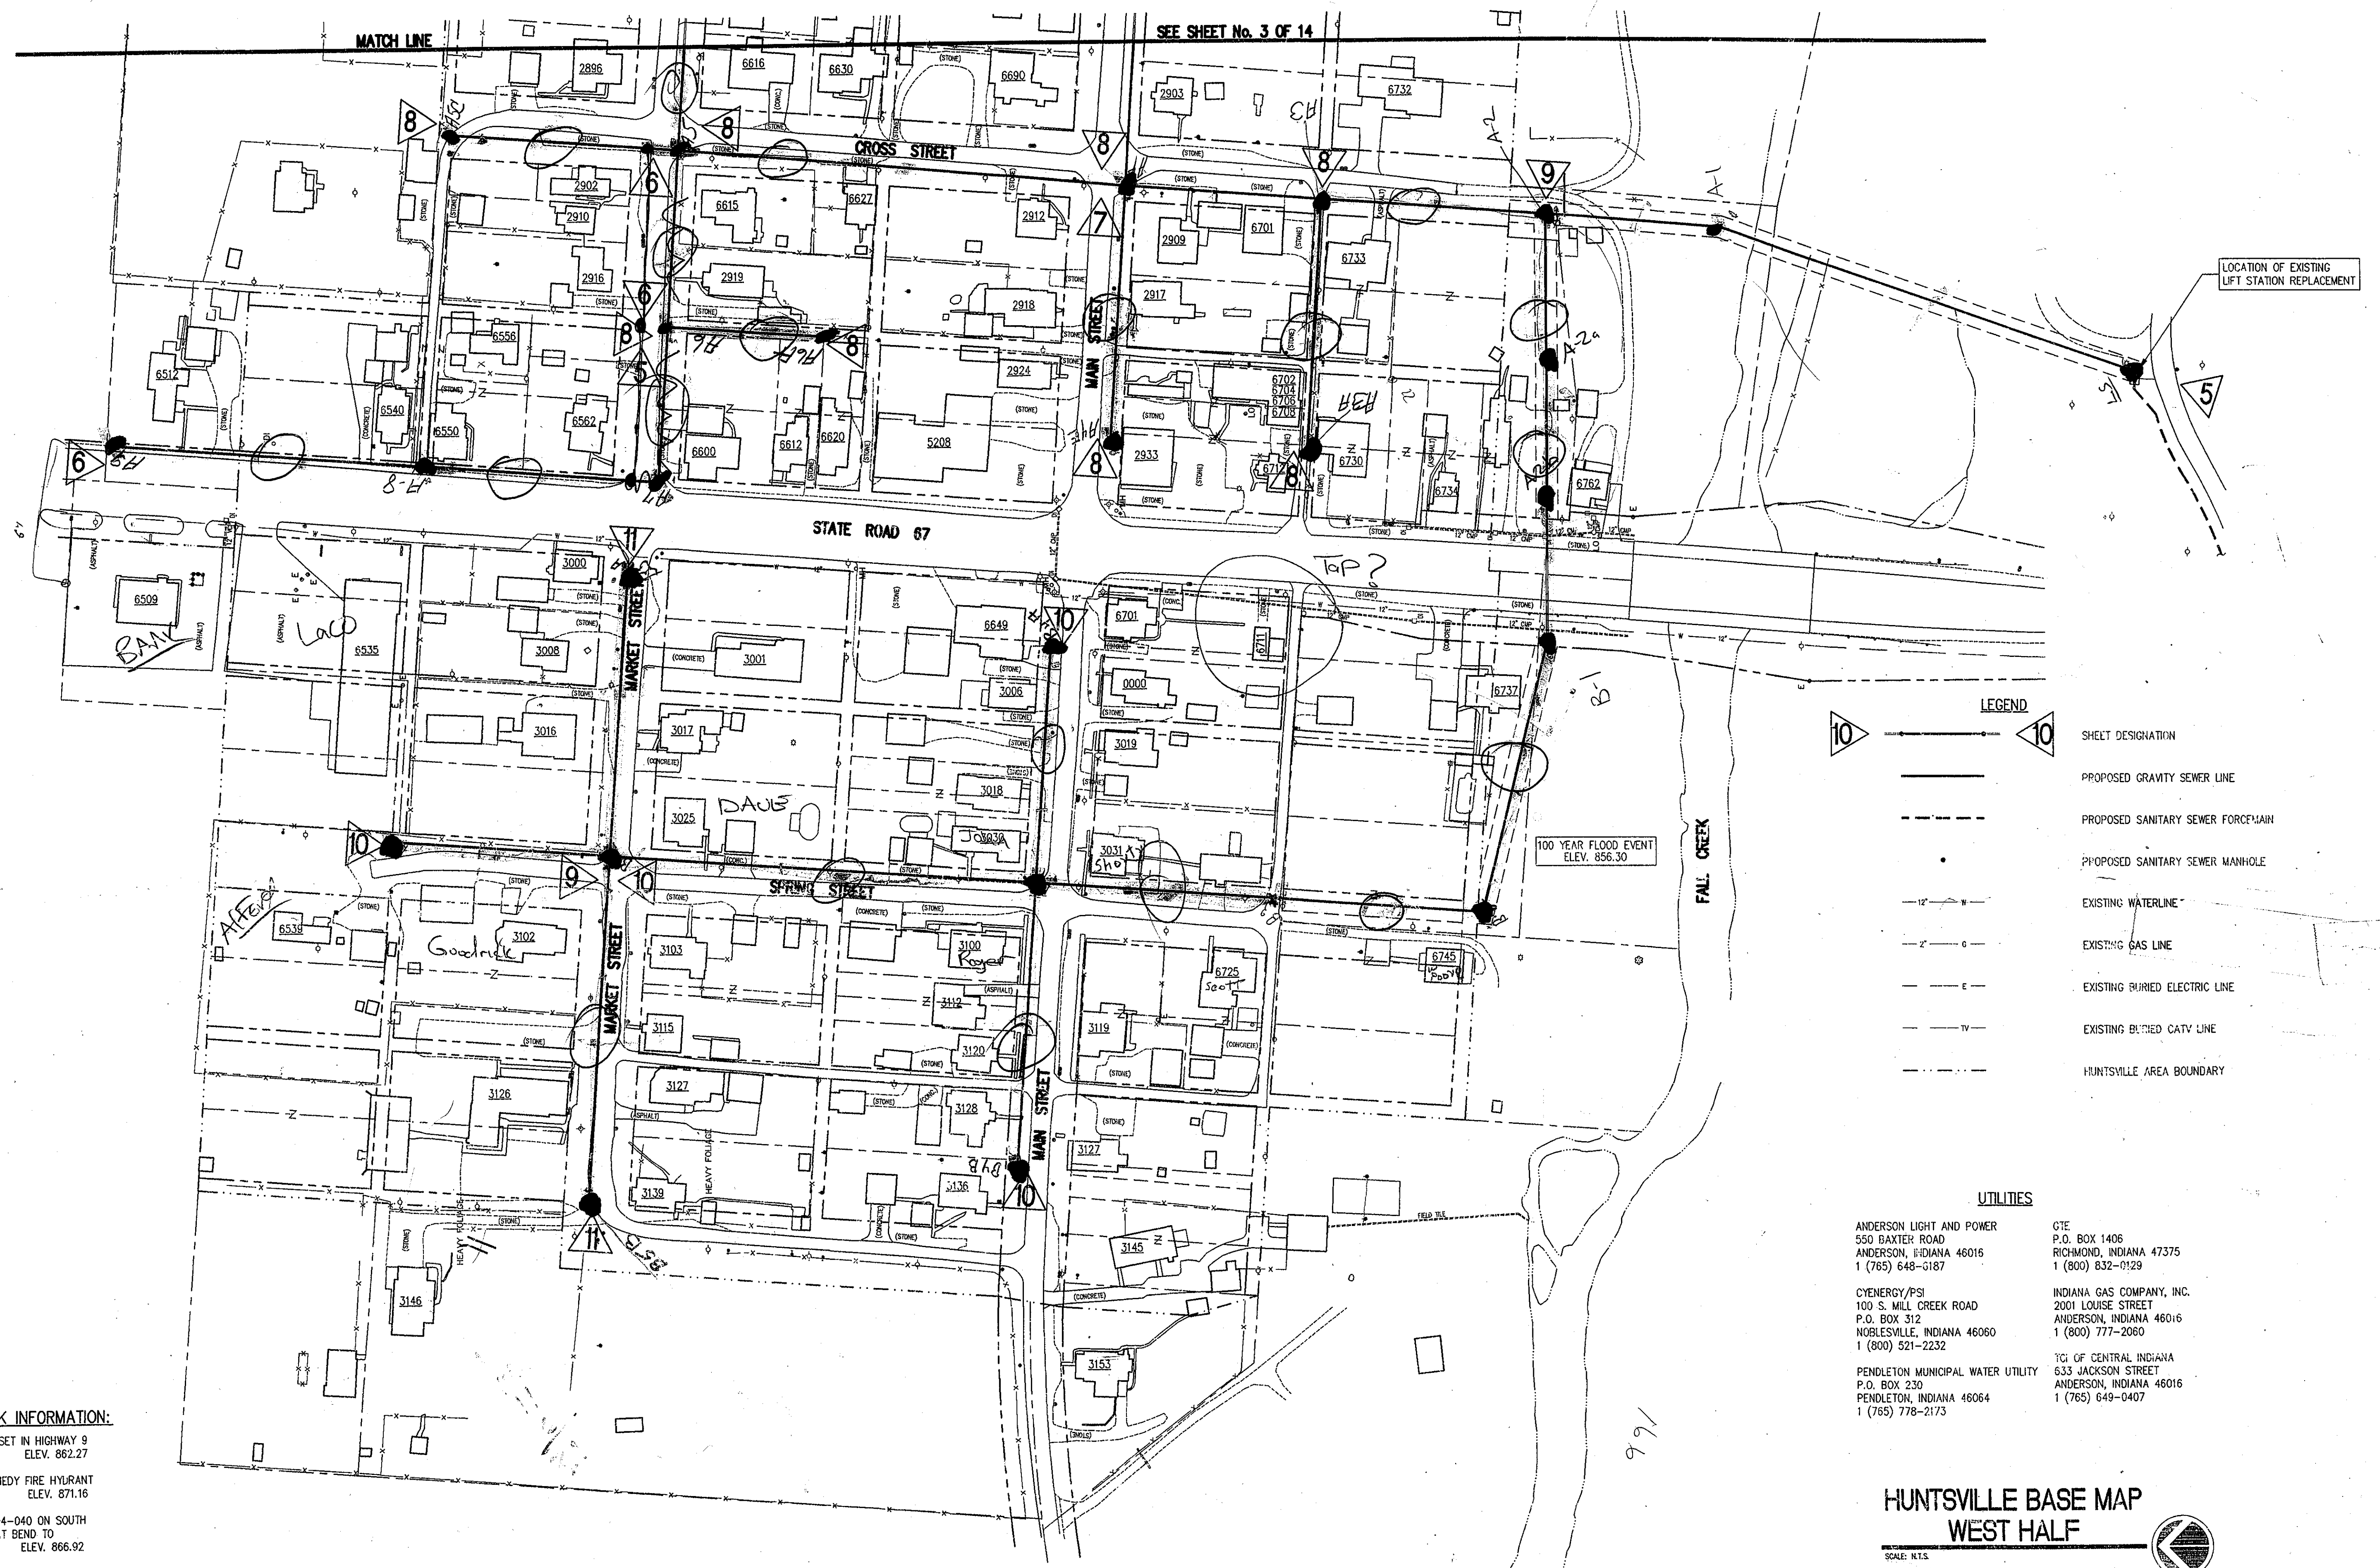

PER INDIANA STATE LAW 15-69-1991, IT IS
AGAINST THE LAW TO EXCAVATE WITHOUT
NOTIFYING THE UNDERGROUND LOCATION SERVICE
TWO (2) WORKING DAYS BEFORE COMMENCING WORK.

NOTE: CONTRACTOR TO VERIFY ALL UTILITY LOCATIONS
PRIOR TO THE START OF CONSTRUCTION

FILE NAME	HUNT2	PLOT SCALE	1"=75'	PLOT DATE	10/23
NO.	DATE	DESCRIPTION	BY		

TRIAD ASSOCIATES INC.
INDIANAPOLIS, INDIANA

APPROVED:
Thomas M. Schubert, P.E.

**SANITARY SEWER AND FORCEMAIN PROJECT
HUNTSVILLE, INDIANA**

BASE MAP - WEST HALF

DRAWN BY: DATE: OCTOBER '97 PROJECT No. SHEET No.
DAP SCALE: AS NOTED 97003L 2

DESIGNED BY: David Kleser, E.I.
CHECKED BY: James W. Frazell, P.E.