

BENCHMARK AND TEMPORARY BECHMARK INFORMATION:

INDOT BM MAD G-38 SOUTH END OF HEADWALL, CAP SET IN HIGHWAY 9 OVER FALL CREEK. ELEV. 862.27

TBM #1 FLANGE BOLT UNDER "Y" IN KENNEDY FIRE HYDRANT IN FRONT OF LACO SATELITE CO. ELEV. 871.16

TBM #2 SPIKE SET IN POWERPOLE No. 194-040 ON SOUTH SIDE OF NEW COLUMBUS ROAD AT BEND TO THE NORTHEAST. ELEV. 866.92

TBM #3 RR SPIKE, UP 0.5', NORTH SIDE OF POWERPOLE No. 047-648 @ INTERSECTION OF HUNTSVILLE ROAD AND MARKET STREET. ELEV. 865.30

TBM #4 NAIL SPIKE, UP 1', NORTH SIDE OF POWERPOLE No. 047-639 @ SOUTHWEST CORNER OF MAIN STREET AND CROSS STREET. ELEV. 868.77

TBM #5 NAIL SPIKE, UP 1', SOUTH SIDE OF POWERPOLE NORTHWEST CORNER OF STATE ROAD No. 67 AND MAIN STREET. ELEV. 870.87

TBM #6 "X" CUT IN TOP OF BRIDGE RAIL, NORTHEAST CORNER OF BRIDGE ON STATE ROAD No. 67 OVER FALL CREEK. ELEV. 862.90

TBM #7 PK NAIL IN EAST SIDE OF POWERPOLE APP. 50' NORTH OF INTERSECTION OF WATER STREET AND COUNTY ROAD 300W WEST SIDE OF ROAD, 0.8' UP. ELEV. 863.94

NOTE:
ADDITIONAL RIGHT-OF-WAY OR EASEMENTS MAY NEED TO BE ACQUIRED FOR INSTALLATION OF SEWER.

DON'T DIG BLIND CALL BEFORE YOU DIG
1-800-382-5544
1-800-428-5200

PER INDIANA STATE LAW IS-69-1991, IT IS AGAINST THE LAW TO EXCAVATE WITHOUT NOTIFYING THE UNDERGROUND LOCATION SERVICE TWO (2) WORKING DAYS BEFORE COMMENCING WORK.

NOTE: CONTRACTOR TO VERIFY ALL UTILITY LOCATIONS PRIOR TO THE START OF CONSTRUCTION

LEGEND

-  SHEET DESIGNATION
-  PROPOSED GRAVITY SEWER LINE
-  PROPOSED SANITARY SEWER FORCEMAIN
-  PROPOSED SANITARY SEWER MANHOLE
-  EXISTING WATERLINE
-  EXISTING GAS LINE
-  EXISTING BURIED ELECTRIC LINE
-  EXISTING BURIED CATV LINE
-  HUNTSVILLE AREA BOUNDARY

UTILITIES

ANDERSON LIGHT AND POWER
550 BAXTER ROAD
ANDERSON, INDIANA 46016
1 (765) 648-6187

CYENERGY/PSI
100 S. MILL CREEK ROAD
P.O. BOX 312
NOBLESVILLE, INDIANA 46060
1 (800) 521-2232

PENDLETON MUNICIPAL WATER CO.
P.O. BOX 230
PENDLETON, INDIANA 46064
1 (765) 778-2173

GTE
P.O. BOX 1406
RICHMOND, INDIANA 47375
1 (800) 632-0129

INDIANA GAS COMPANY, INC.
2001 LOUISE STREET
ANDERSON, INDIANA 46016
1 (800) 777-2060

TO OF CENTRAL INDIANA
633 JACKSON STREET
ANDERSON, INDIANA 46016
1 (765) 649-0407

HUNTSVILLE BASE MAP WEST HALF

SCALE: N.T.S.




SEE SHEET No. 2 OF 14

FILE NAME:	HUNT3	PLOT SCALE:	1"=75'	PLOT DATE:	10/23
NO.	DATE	DESCRIPTION	BY		

**TRIAD
ASSOCIATES
INC.**

INDIANAPOLIS, INDIANA

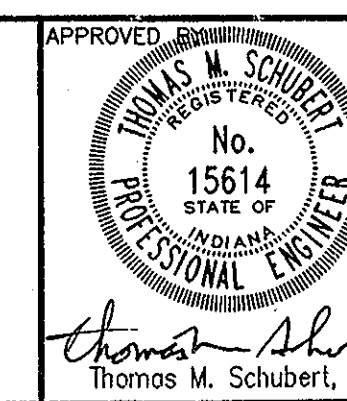

SANITARY SEWER AND FORCEMAIN PROJECT HUNTSVILLE, INDIANA			
BASE MAP - EAST HALF			
DRAWN BY:	DATE	PROJECT No.	SHEET No.
DAP	OCTOBER '97	97003L	3
DESIGNED BY:	SCALE	AS NOTED	14
David Kieser, E.I.			
CHECKED BY:			
James W. Frazell, P.E.			