



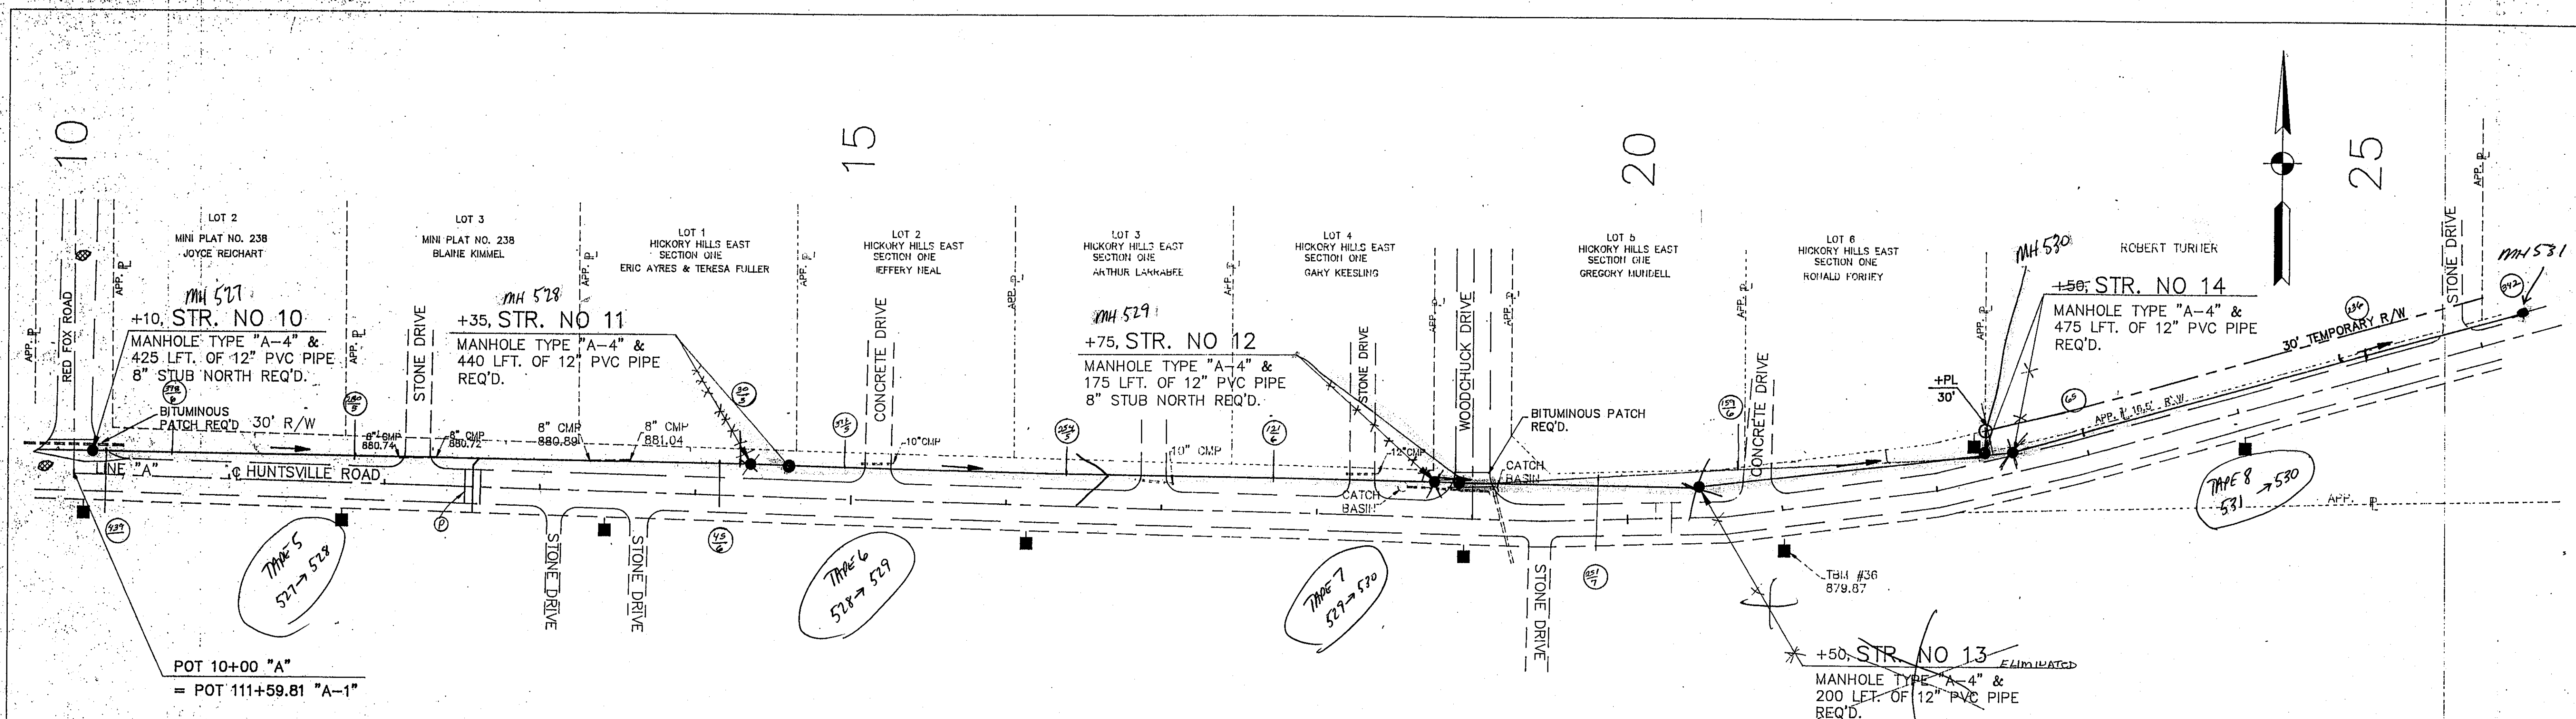

ALL R/W ON THIS SHEET DESCRIBER FROM LINE "A" EXCEPT AS SHOWN.

② Bituminous Patch

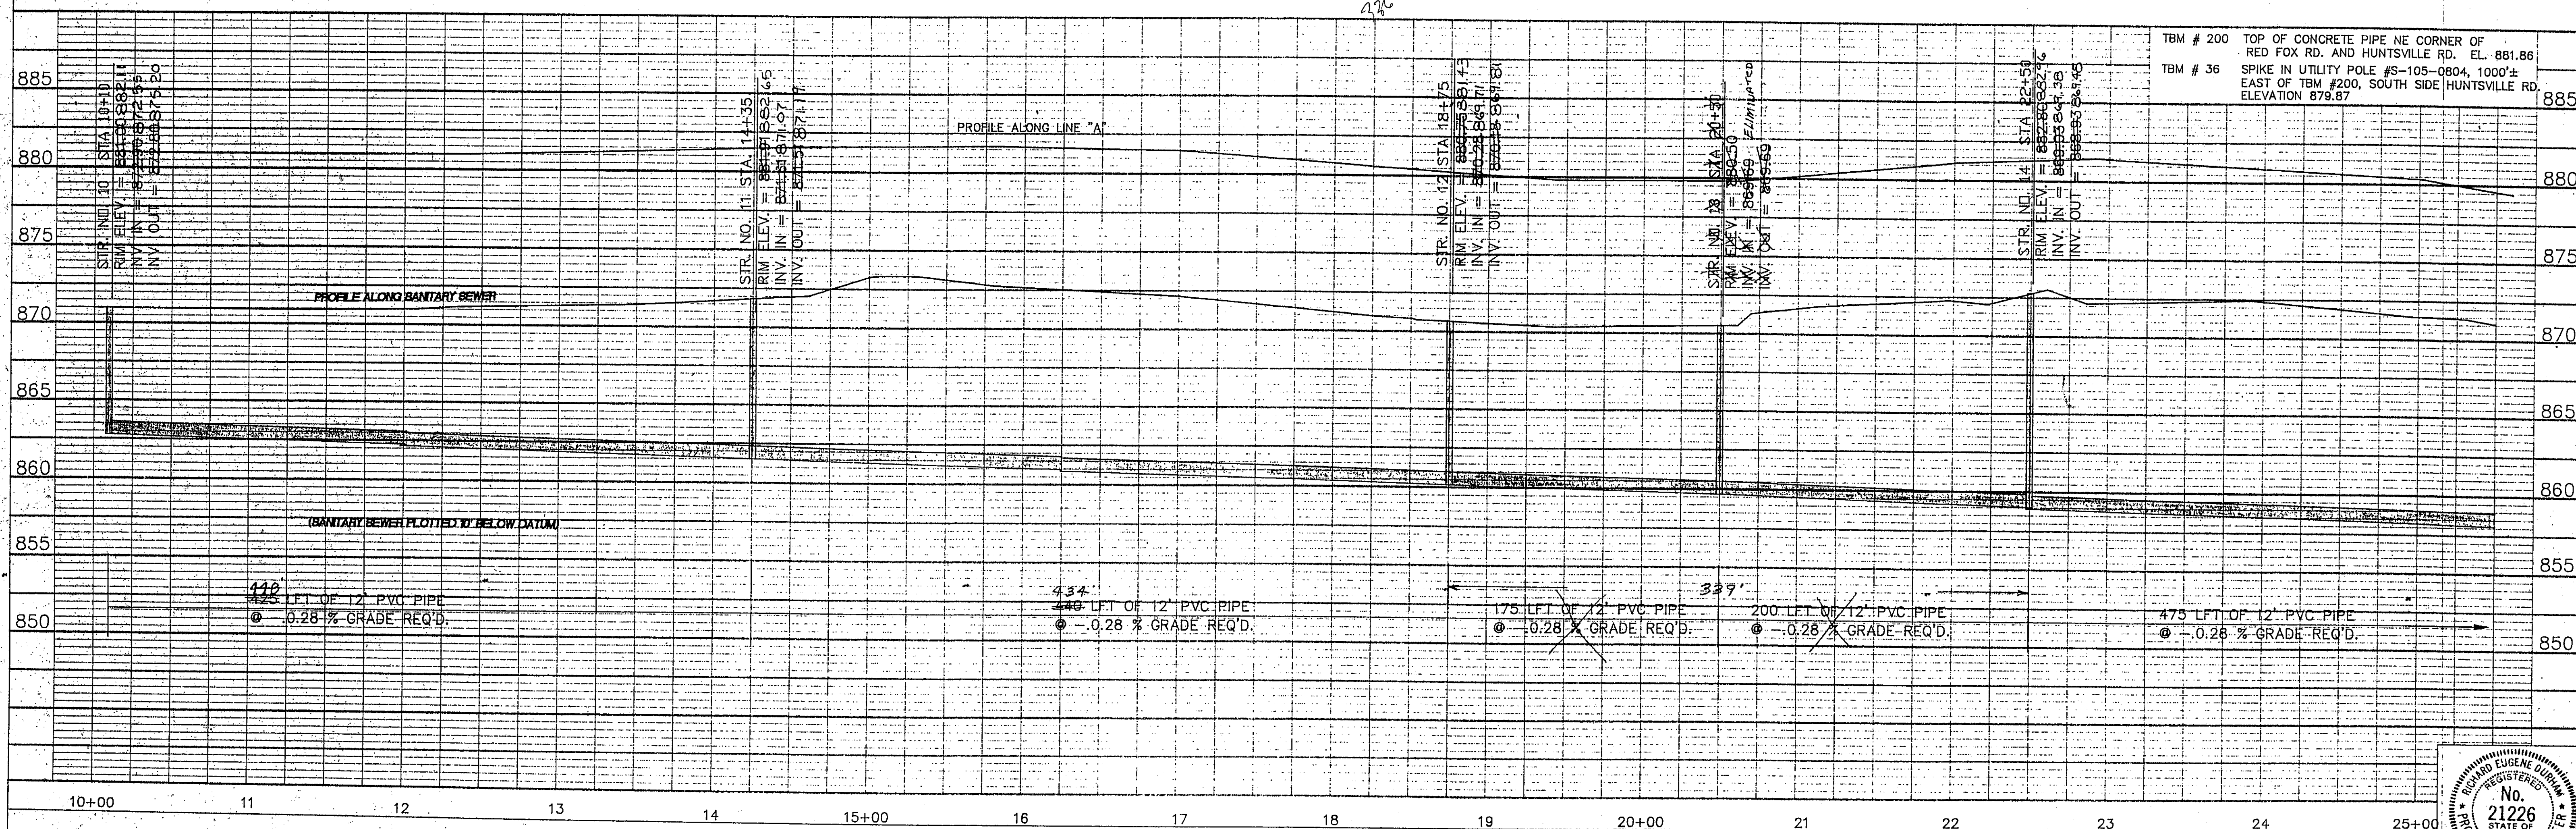

F.C.R.W.D. HUNTSVILLE ROAD SEWER

**DURHAM Engineering**  
12 W. 8th STREET ANDERSON, INDIANA

SCALE 1"=50' HOR.  
1"=5' VER.

SHEET NO. 4 of 9

