



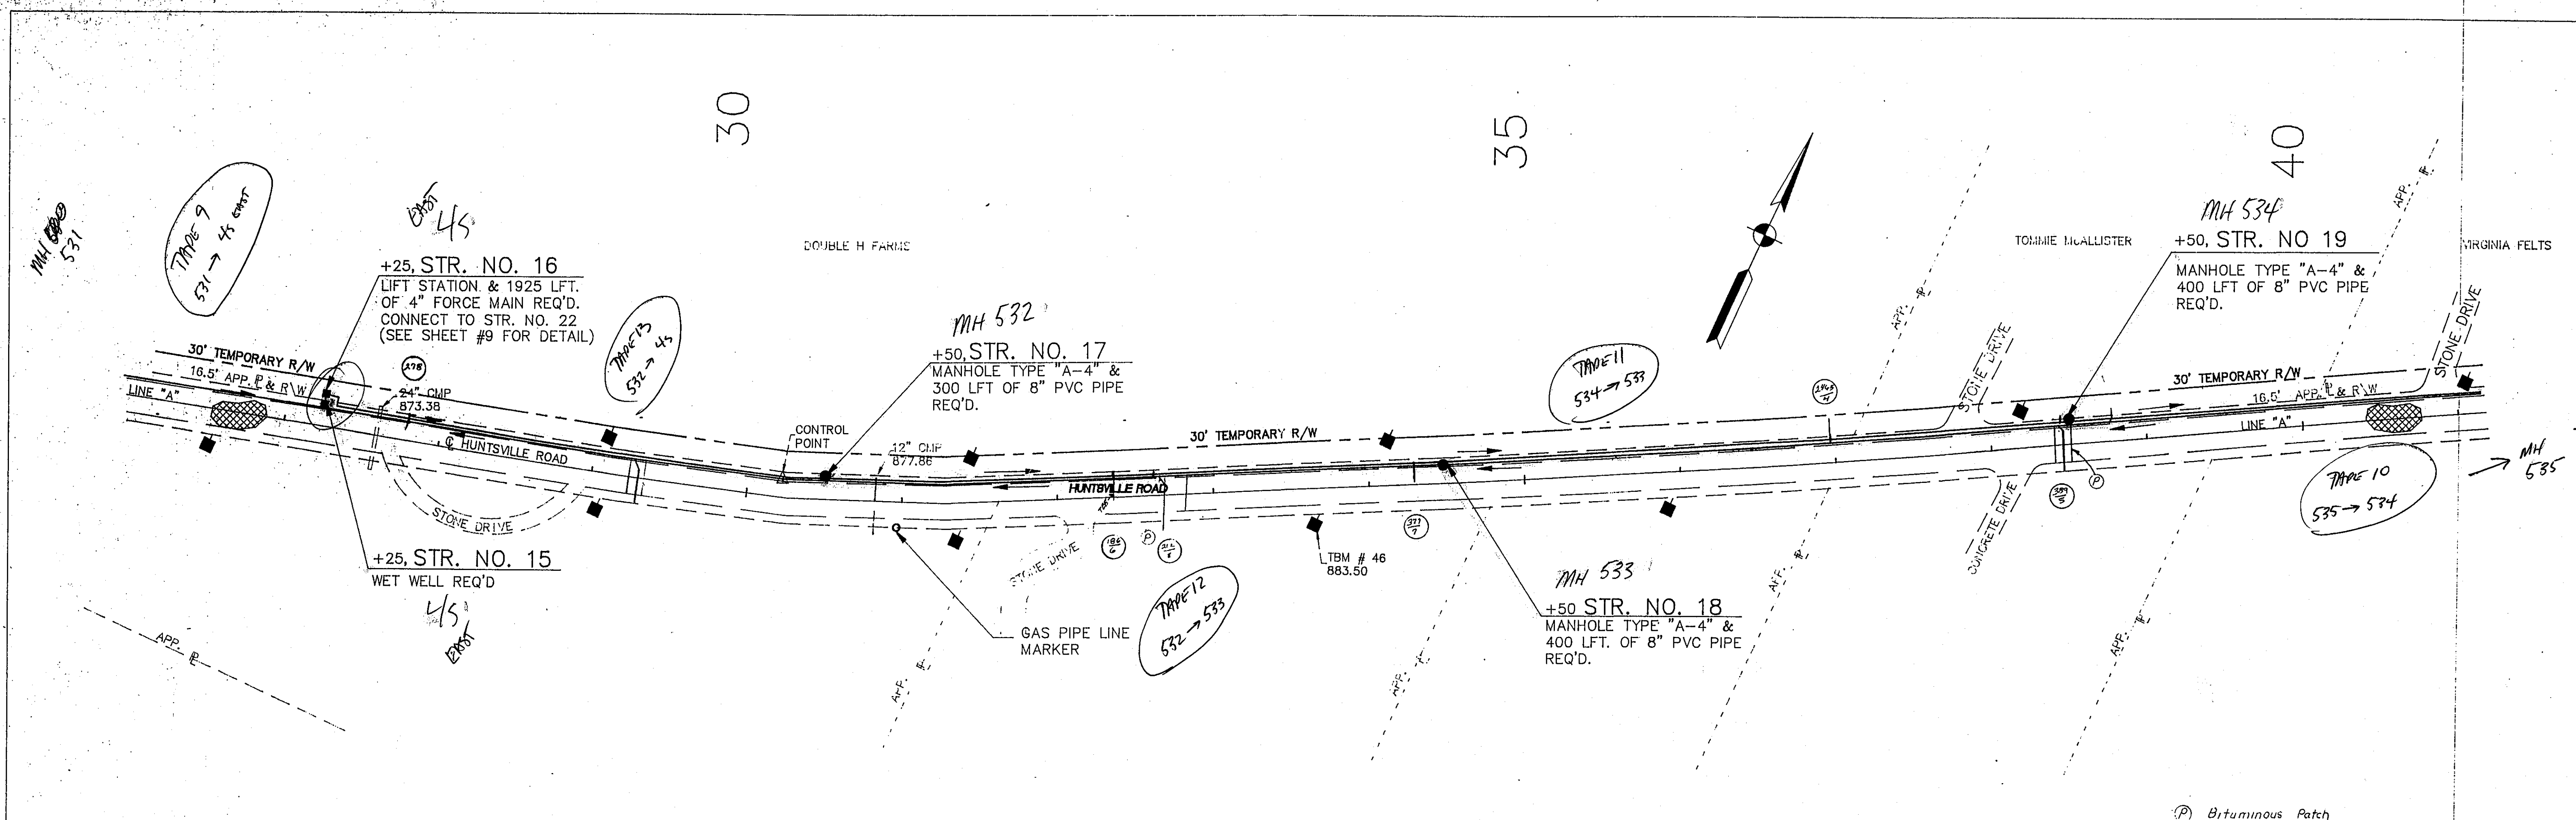

ALL R/W ON THIS SHEET DESCRIBED FROM LINE "A" EXCEPT AS SHOWN.

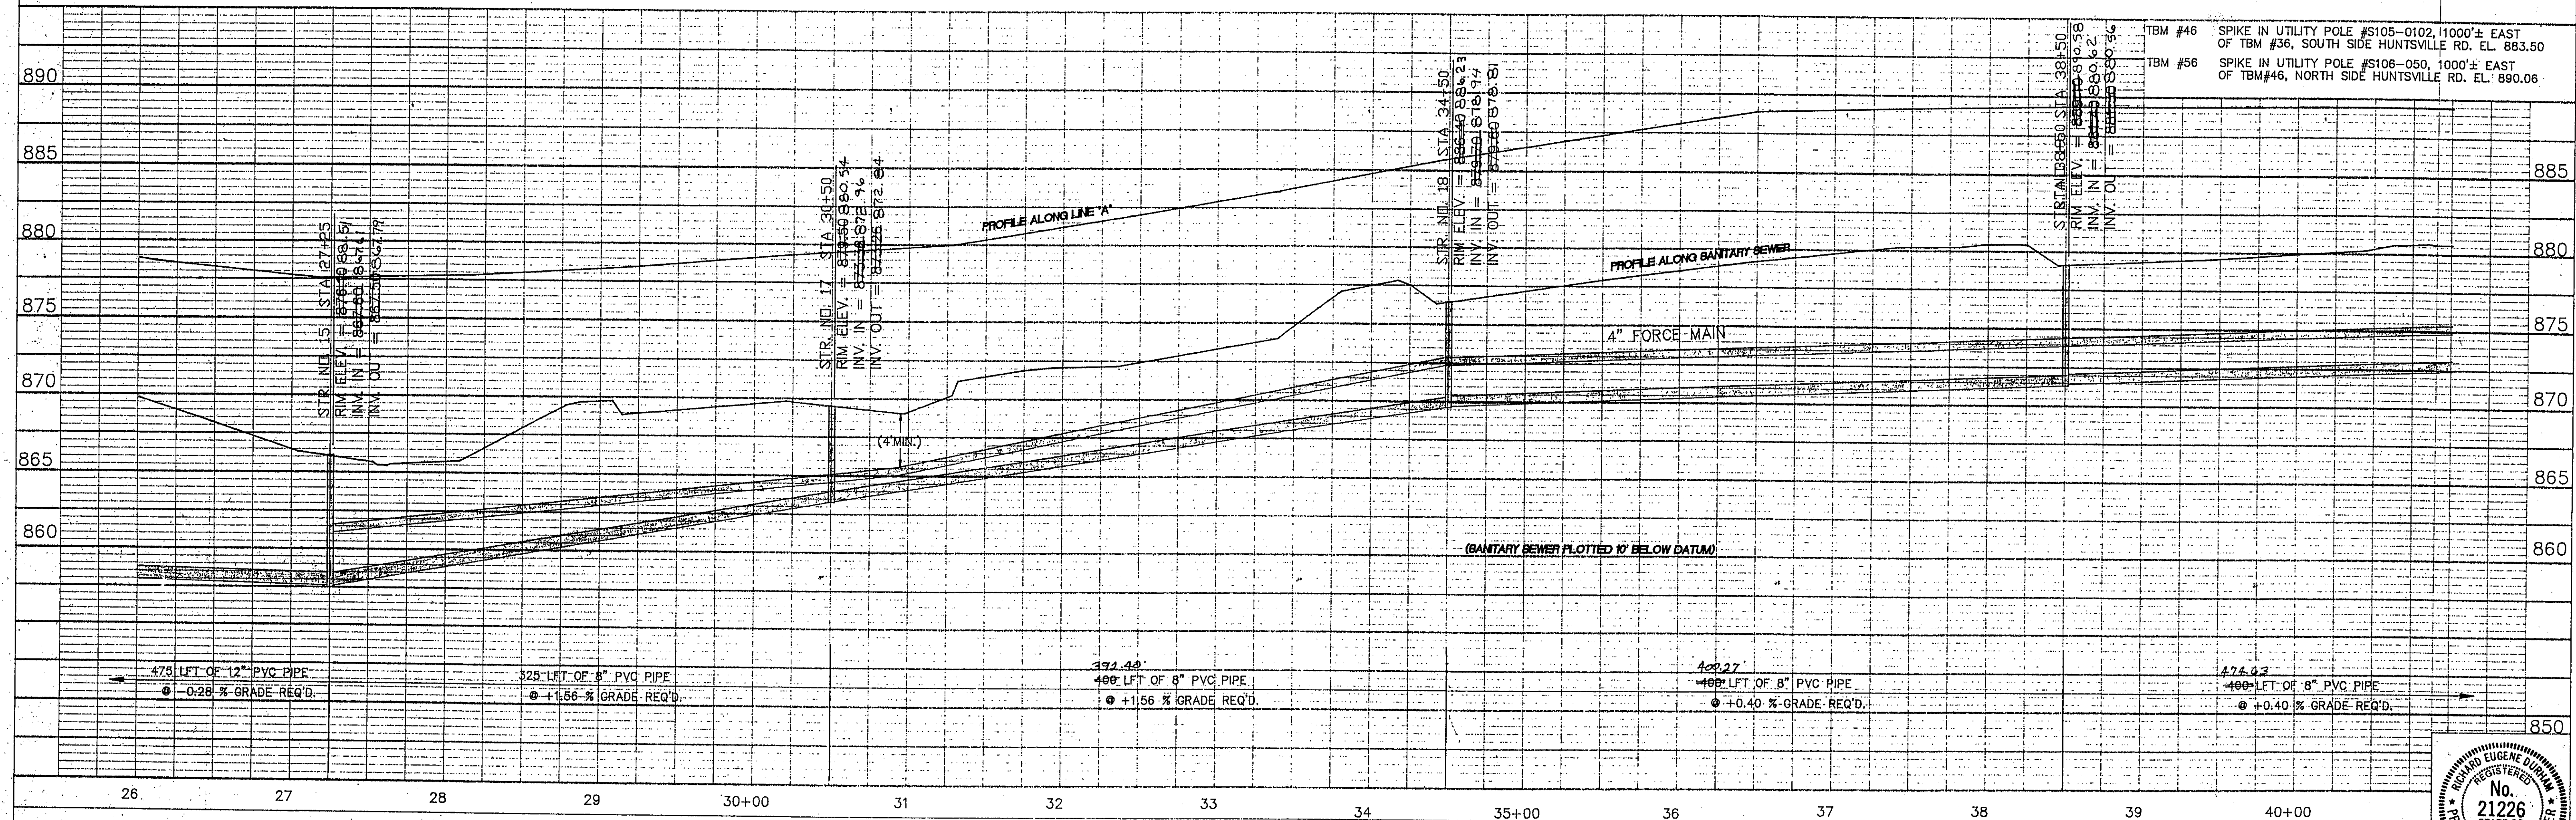

F.C.R.W.D. HUNTSVILLE ROAD SEWER

JOB NO. 9143
 DATE: 12/1/83

DURHAM Engineering
 12 W. 8th STREET ANDERSON, INDIANA

SCALE 1"=50' HOR.
 1"=5' VER.

