



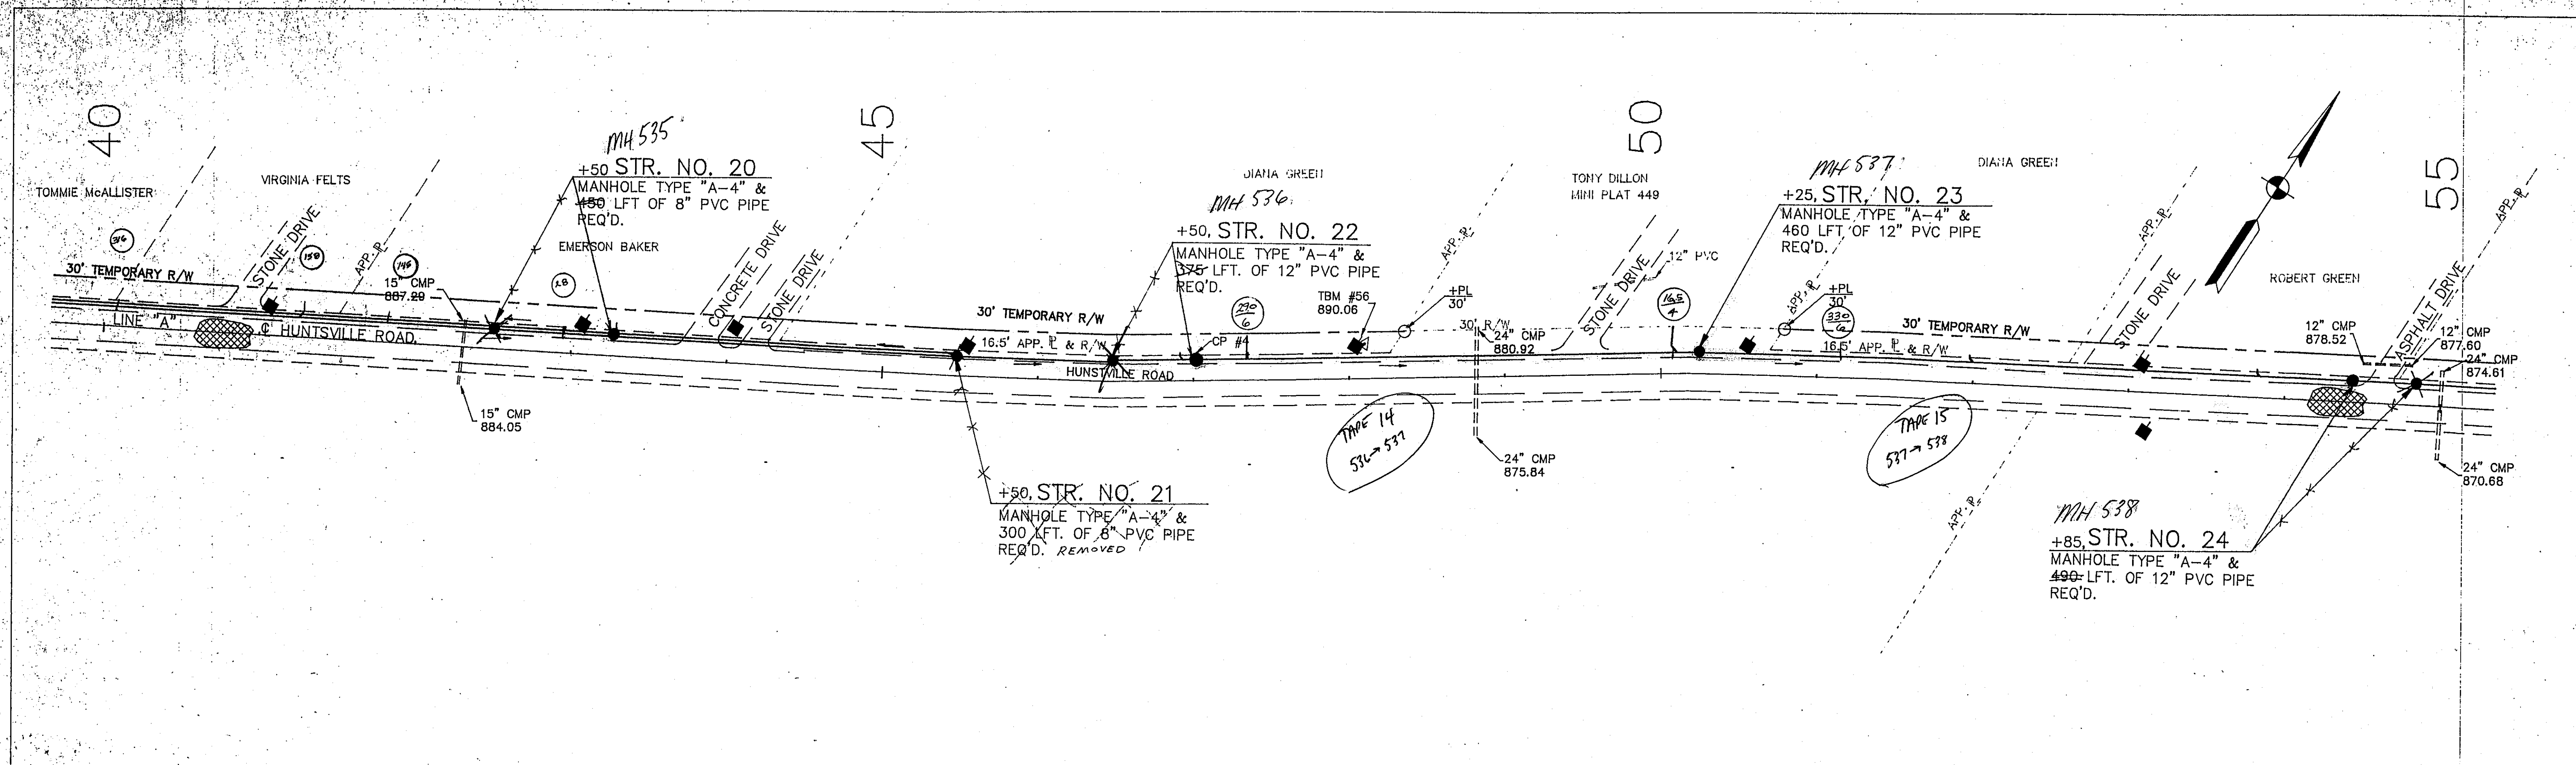

ALL R/W ON THIS SHEET DESCRIBED FROM LINE "A" EXCEPT AS SHOWN.

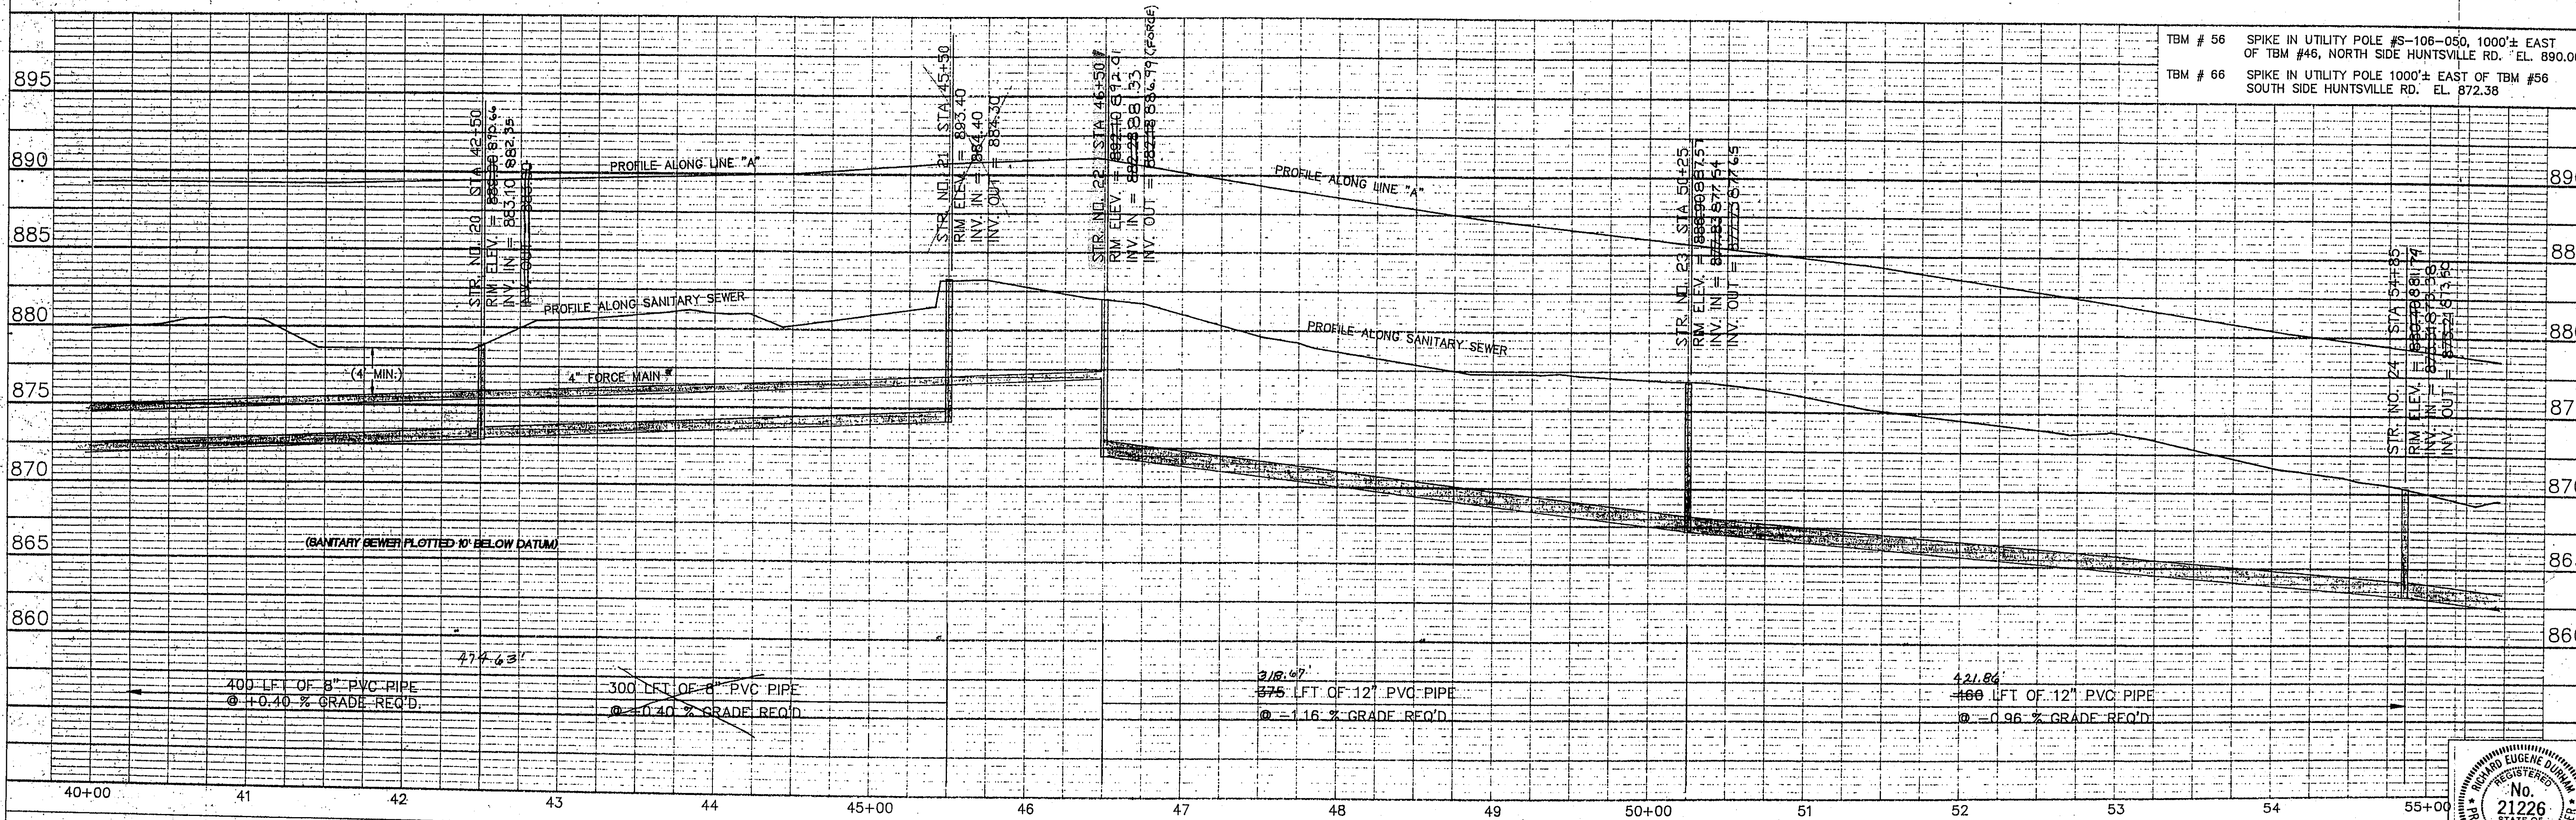

TBM # 56 SPIKE IN UTILITY POLE #S-106-050, 1000'± EAST OF TBM #46, NORTH SIDE HUNTSVILLE RD. EL. 890.06
 TBM # 66 SPIKE IN UTILITY POLE 1000'± EAST OF TBM #56 SOUTH SIDE HUNTSVILLE RD. EL. 872.38

F.C.R.W.D. HUNTSVILLE ROAD SEWER

DURHAM Engineering
 12 W. 8th STREET ANDERSON, INDIANA

SCALE 1"=50' HOR.
 1"=5' VER.
 SHEET NO. 6 of 9

