

MH 538

JAMES CROSBY

60

MH 539

+75, STR. NO. 25
MANHOLE TYPE "A-4" &
375 LFT OF 12" PVC PIPE
REQ'D.

TAPE 17
539 → 540

65

JOY WILLIAMS
MINI PLAT #205

MH 540

+50, STR. NO. 26
MANHOLE TYPE "A-4" &
393 LFT OF 12" PVC PIPE
REQ'D.

TAPE 18
540 → 541

BITUMINOUS PATCH
REQ'D.

MH 541

EXISTING SANITARY SEWER LINE
25' APP. F & R/W


+43, STR. NO. 27
MANHOLE TYPE "A-4"
REQ'D. (SEE SHEET 8)

STR. NO. 28
EXISTING MANHOLE
12" EXISTING SEWER

TAPE 16
538 → 539

MH 234

ALL R/W ON THIS SHEET DESCRIBED FROM LINE "A" EXCEPT AS SHOWN.

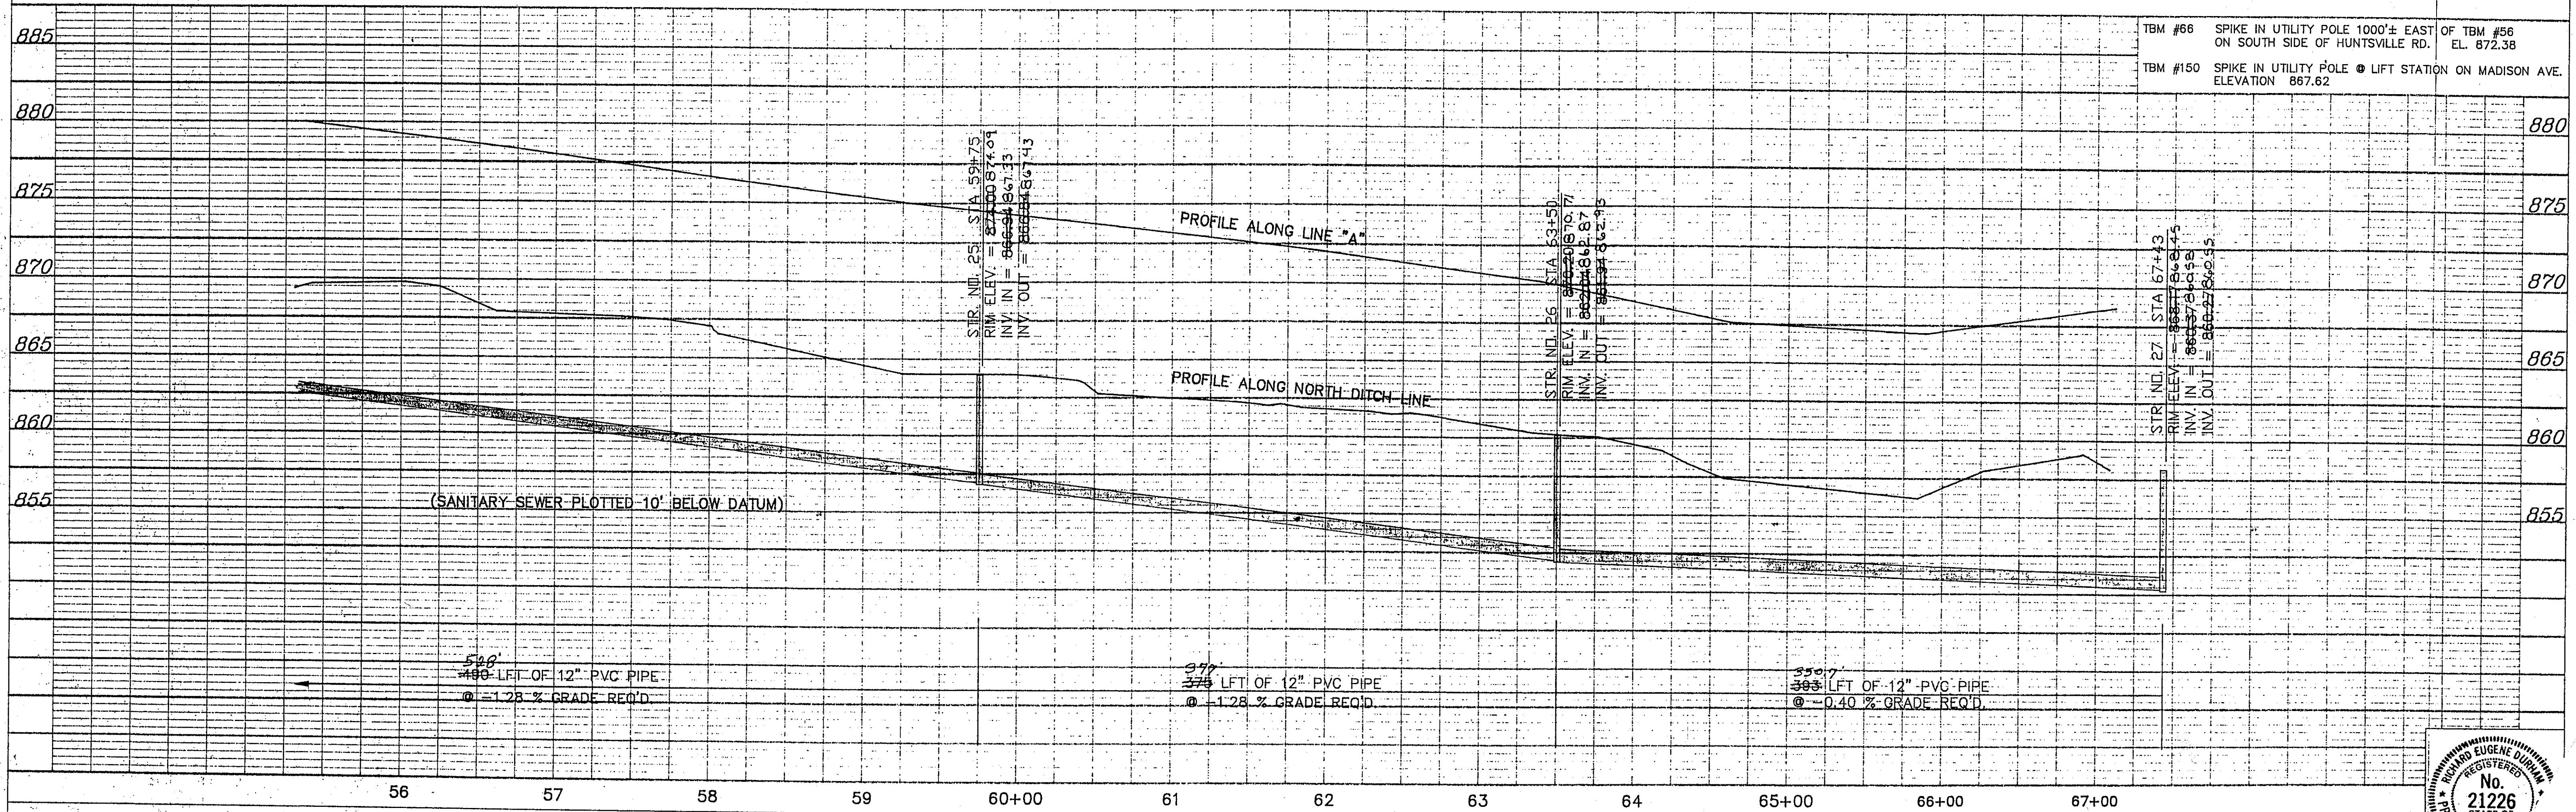

F.C.R.W.D. HUNTSVILLE ROAD SEWER

DURHAM Engineering
12 W. 8th STREET ANDERSON, INDIANA

SCALE VER. 1"=5'
HOR. 1"=50'
SHEET NO. 7 of 9

