



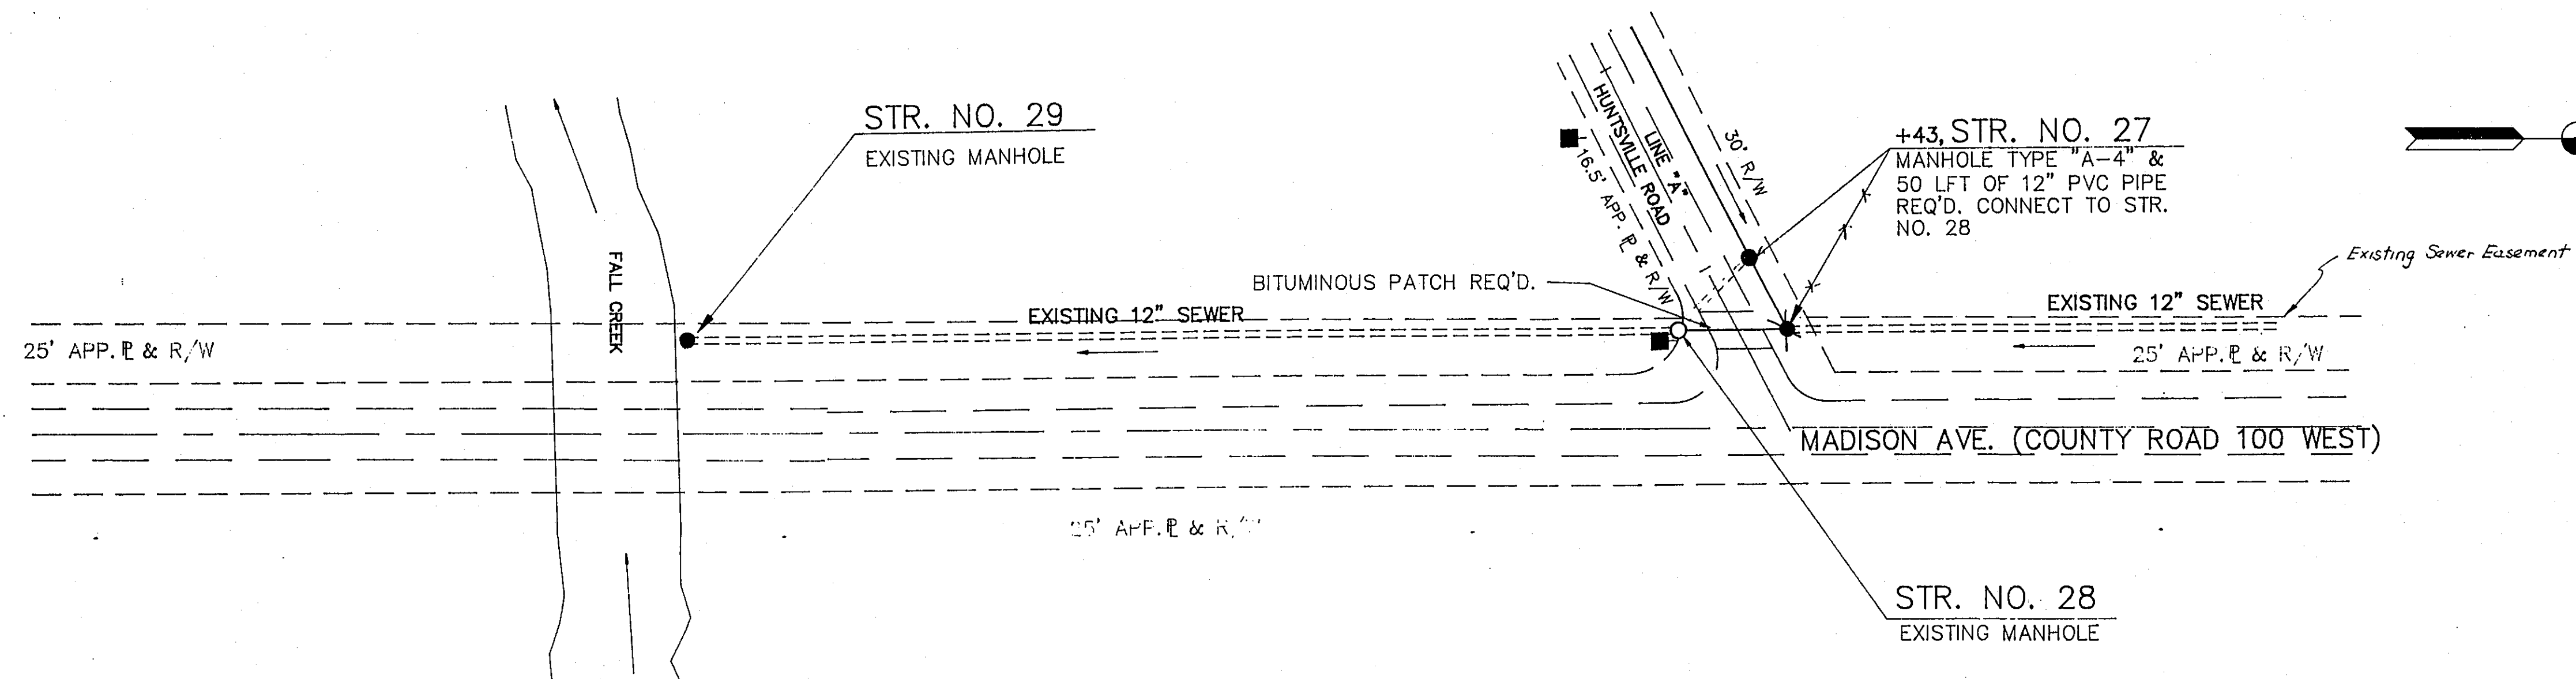

ALL R/W ON THIS SHEET DESCRIBED FROM LINE "A" EXCEPT AS SHOWN.

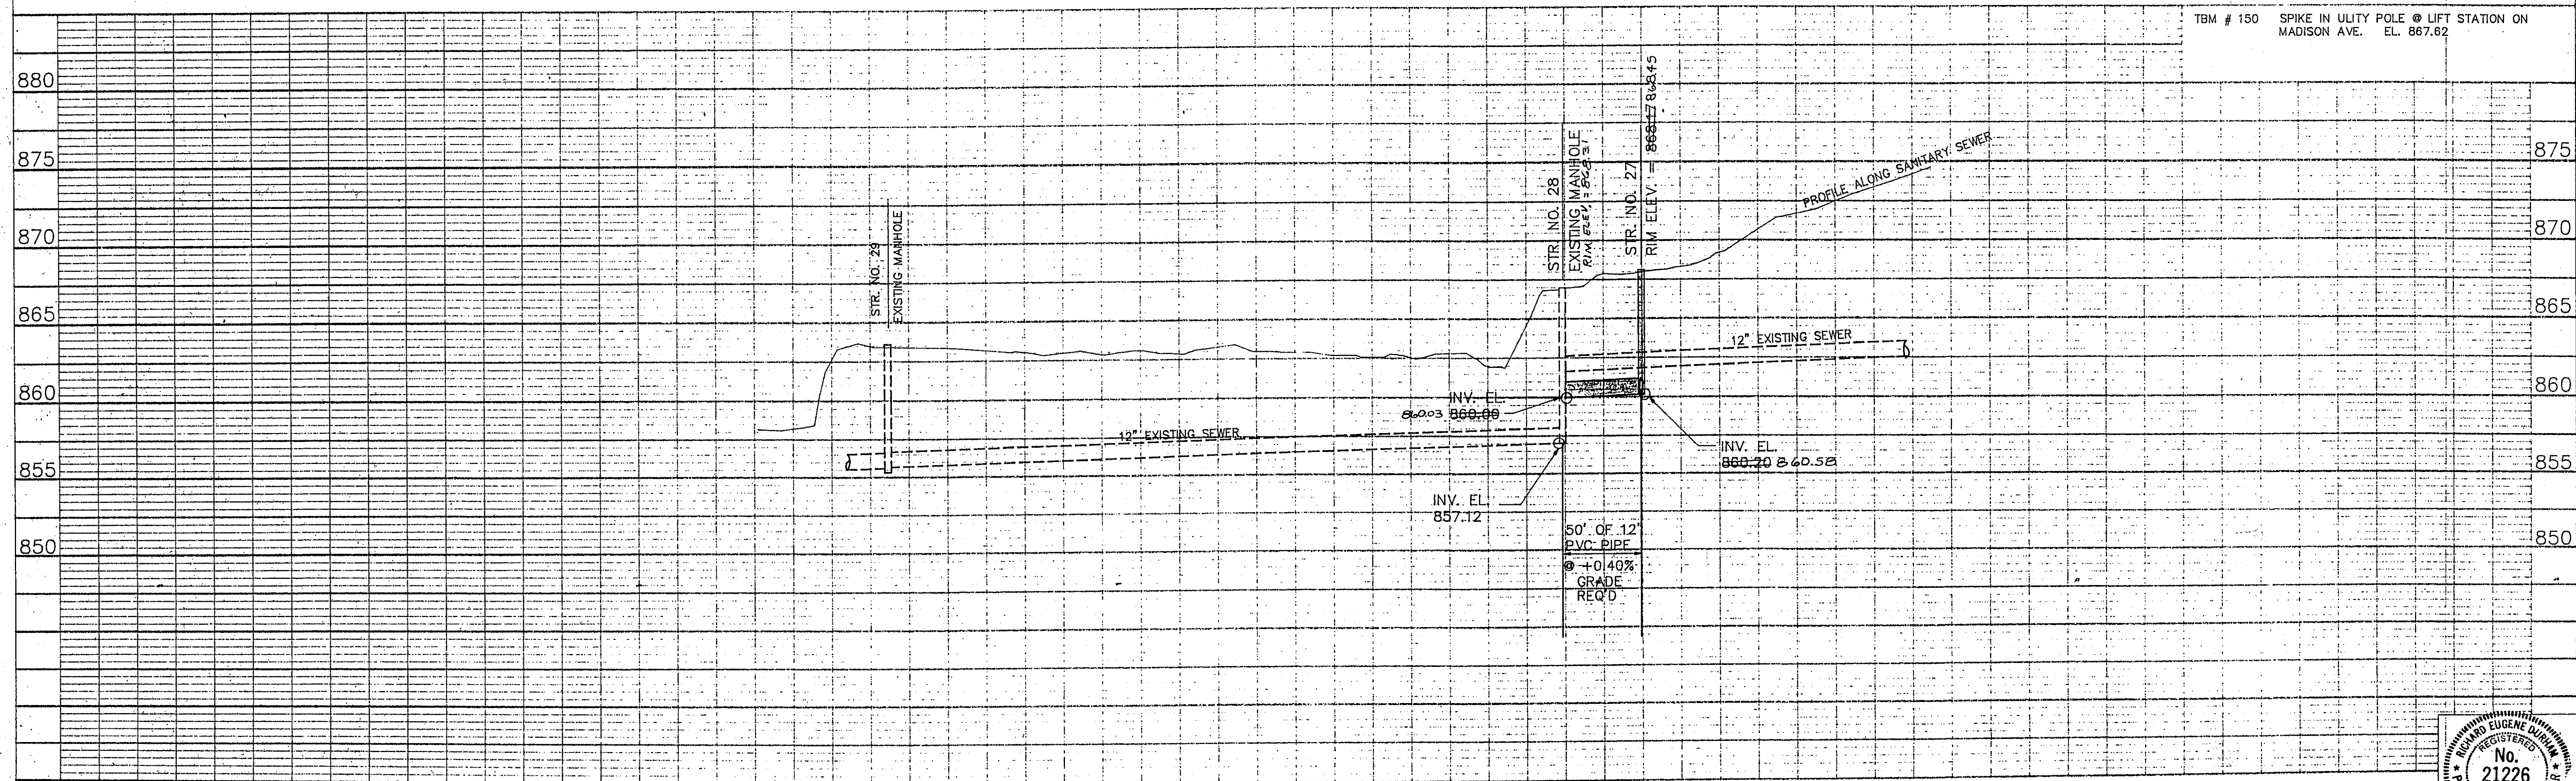

F.C.R.W.D. HUNTSVILLE ROAD SEWER

DURHAM Engineering
12 W. 8th STREET ANDERSON, INDIANA
(317)644-3833

SCALE: HOR. 1" = 50'
VER. 1" = 5'

SHEET NO. 8 of 9

