
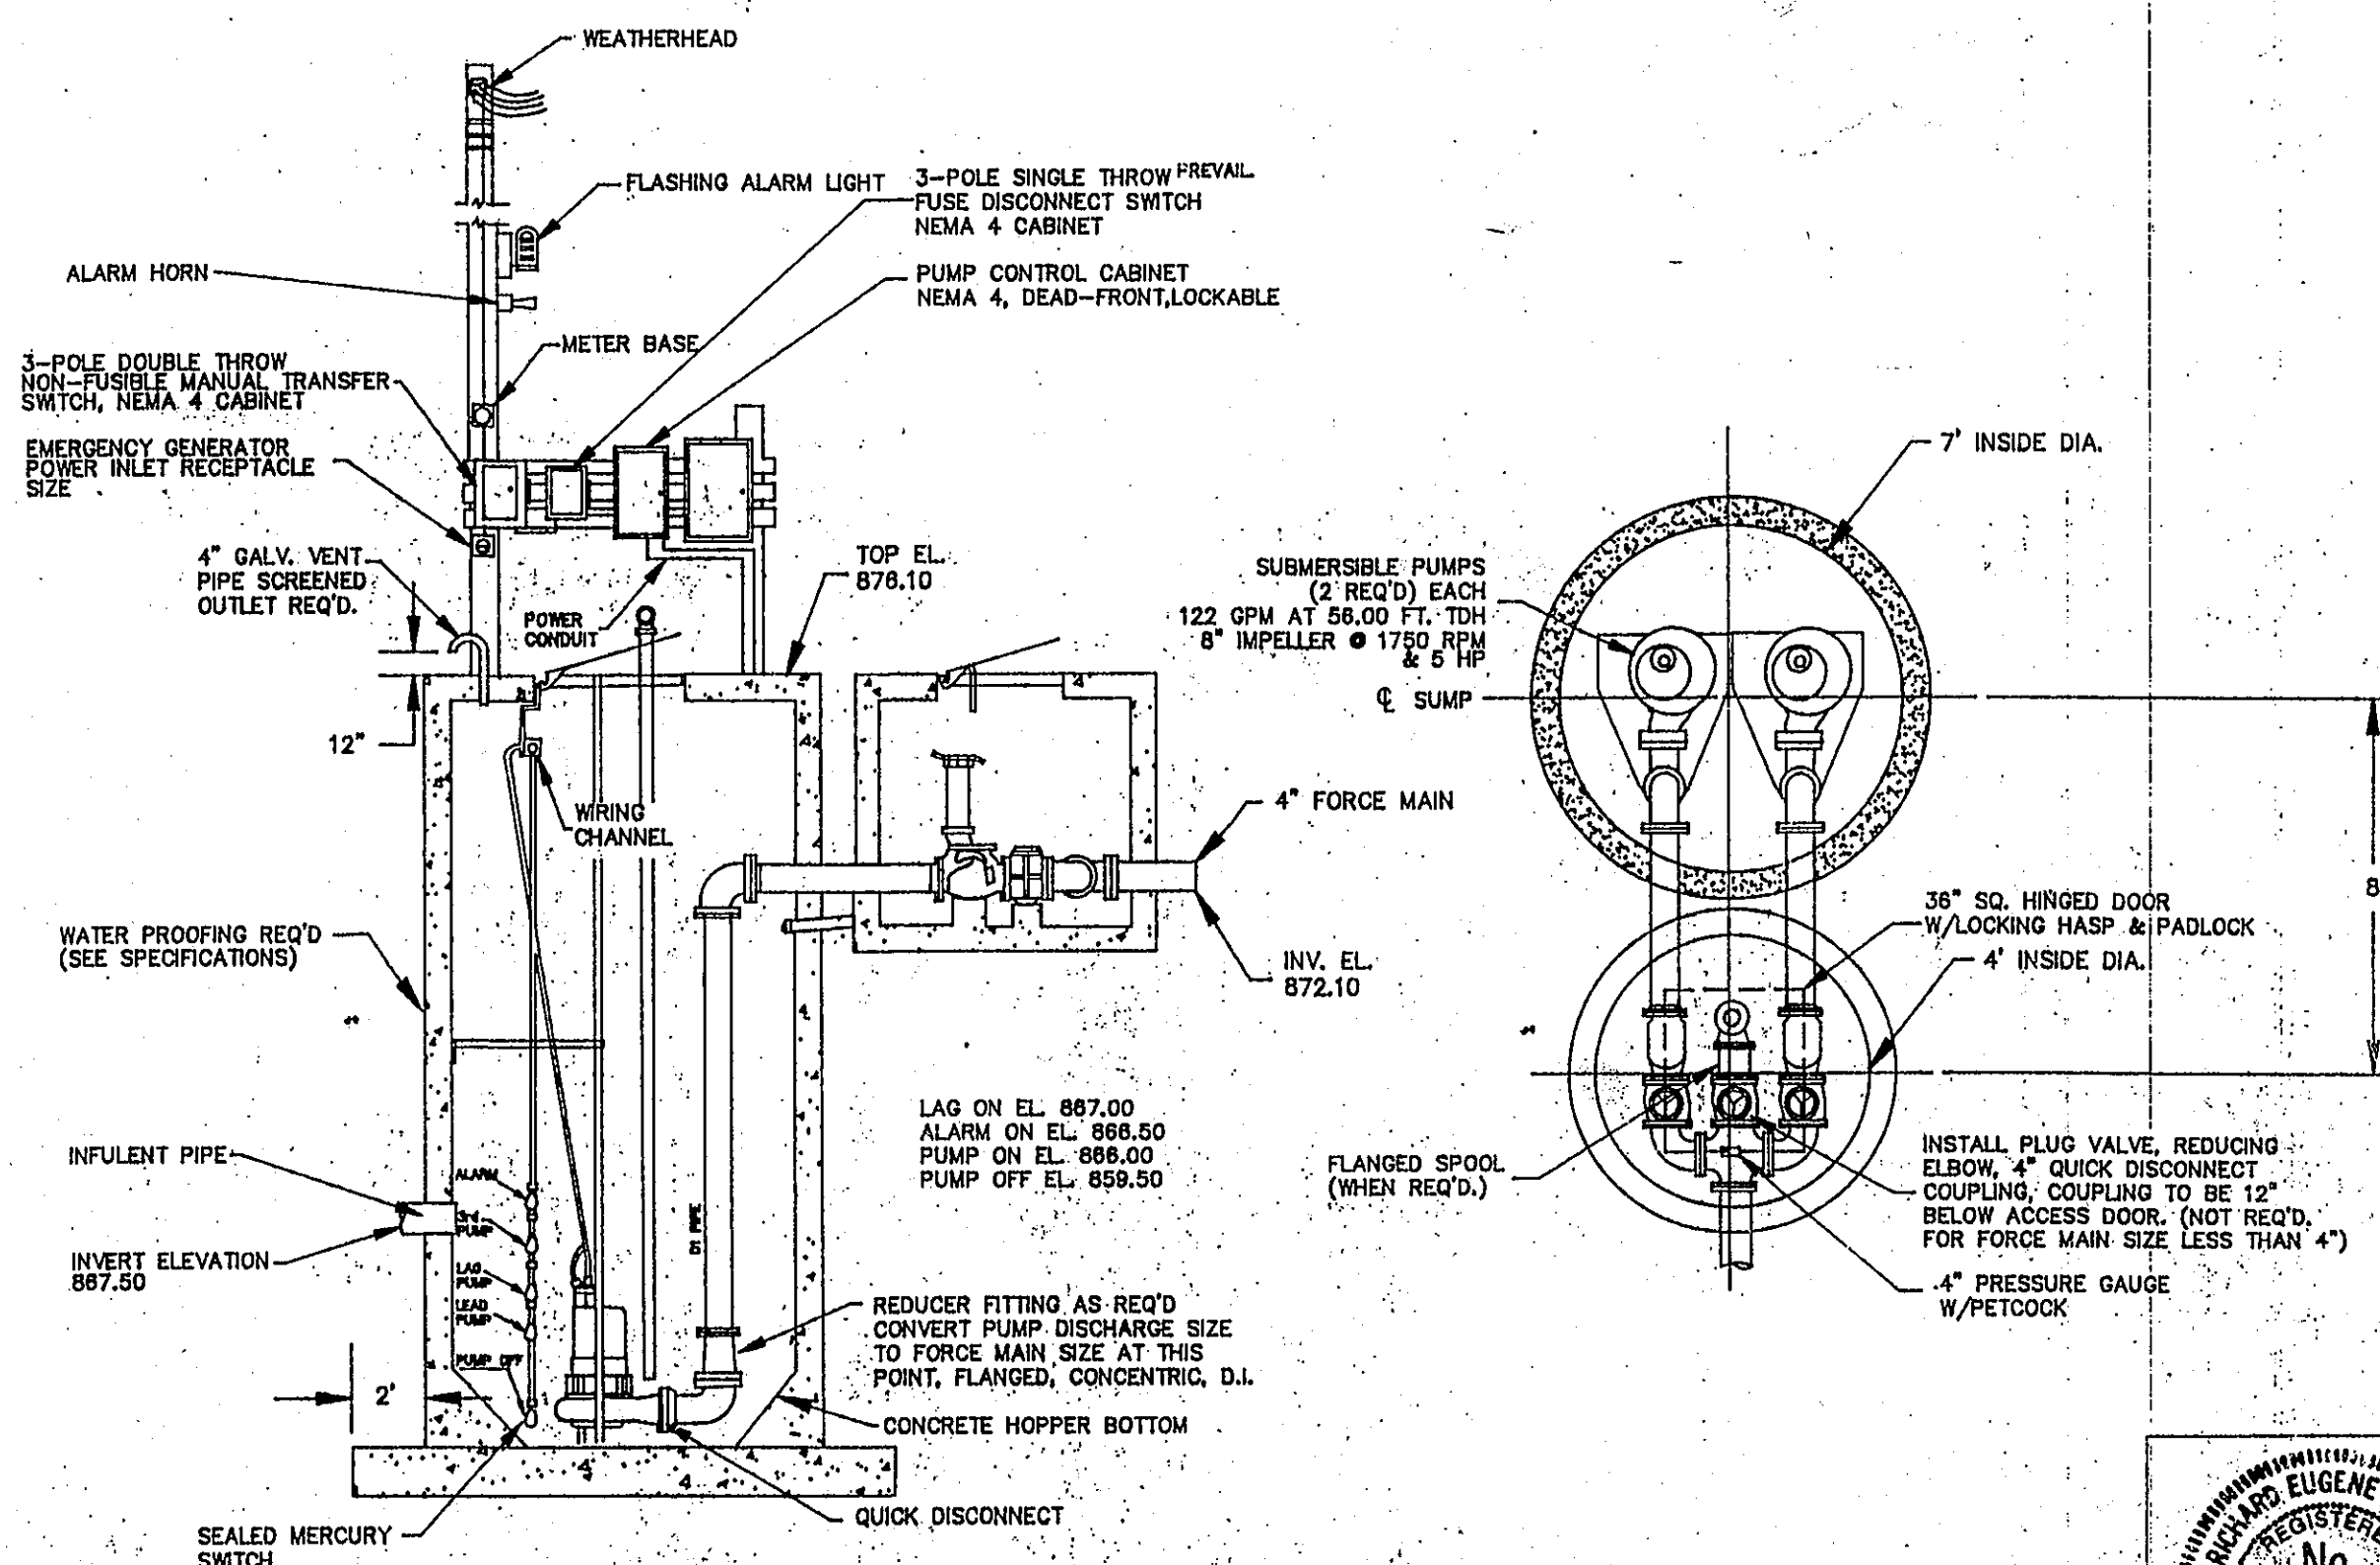
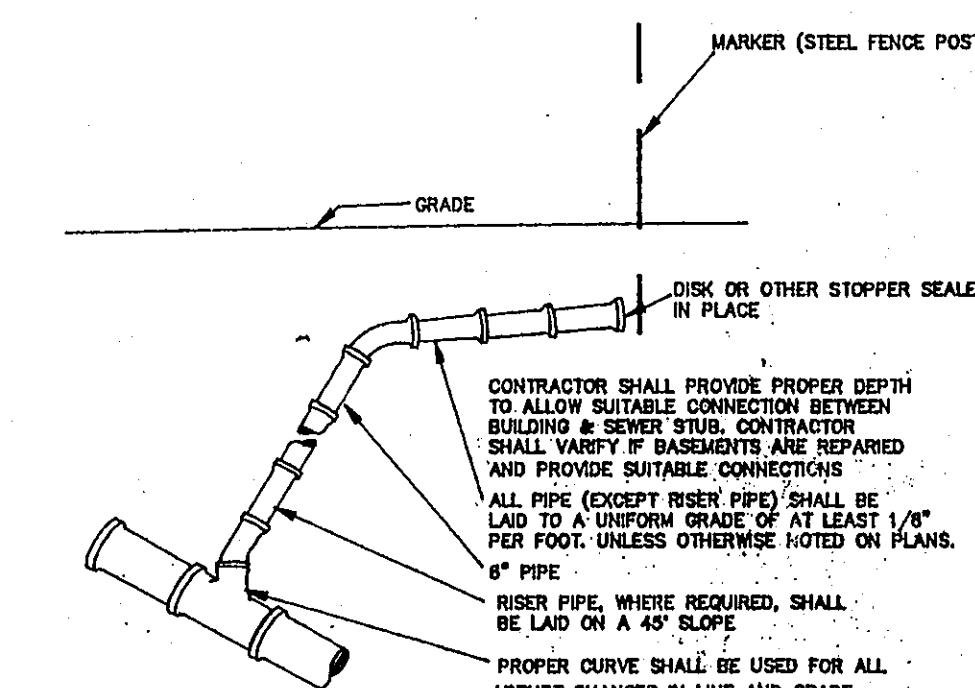
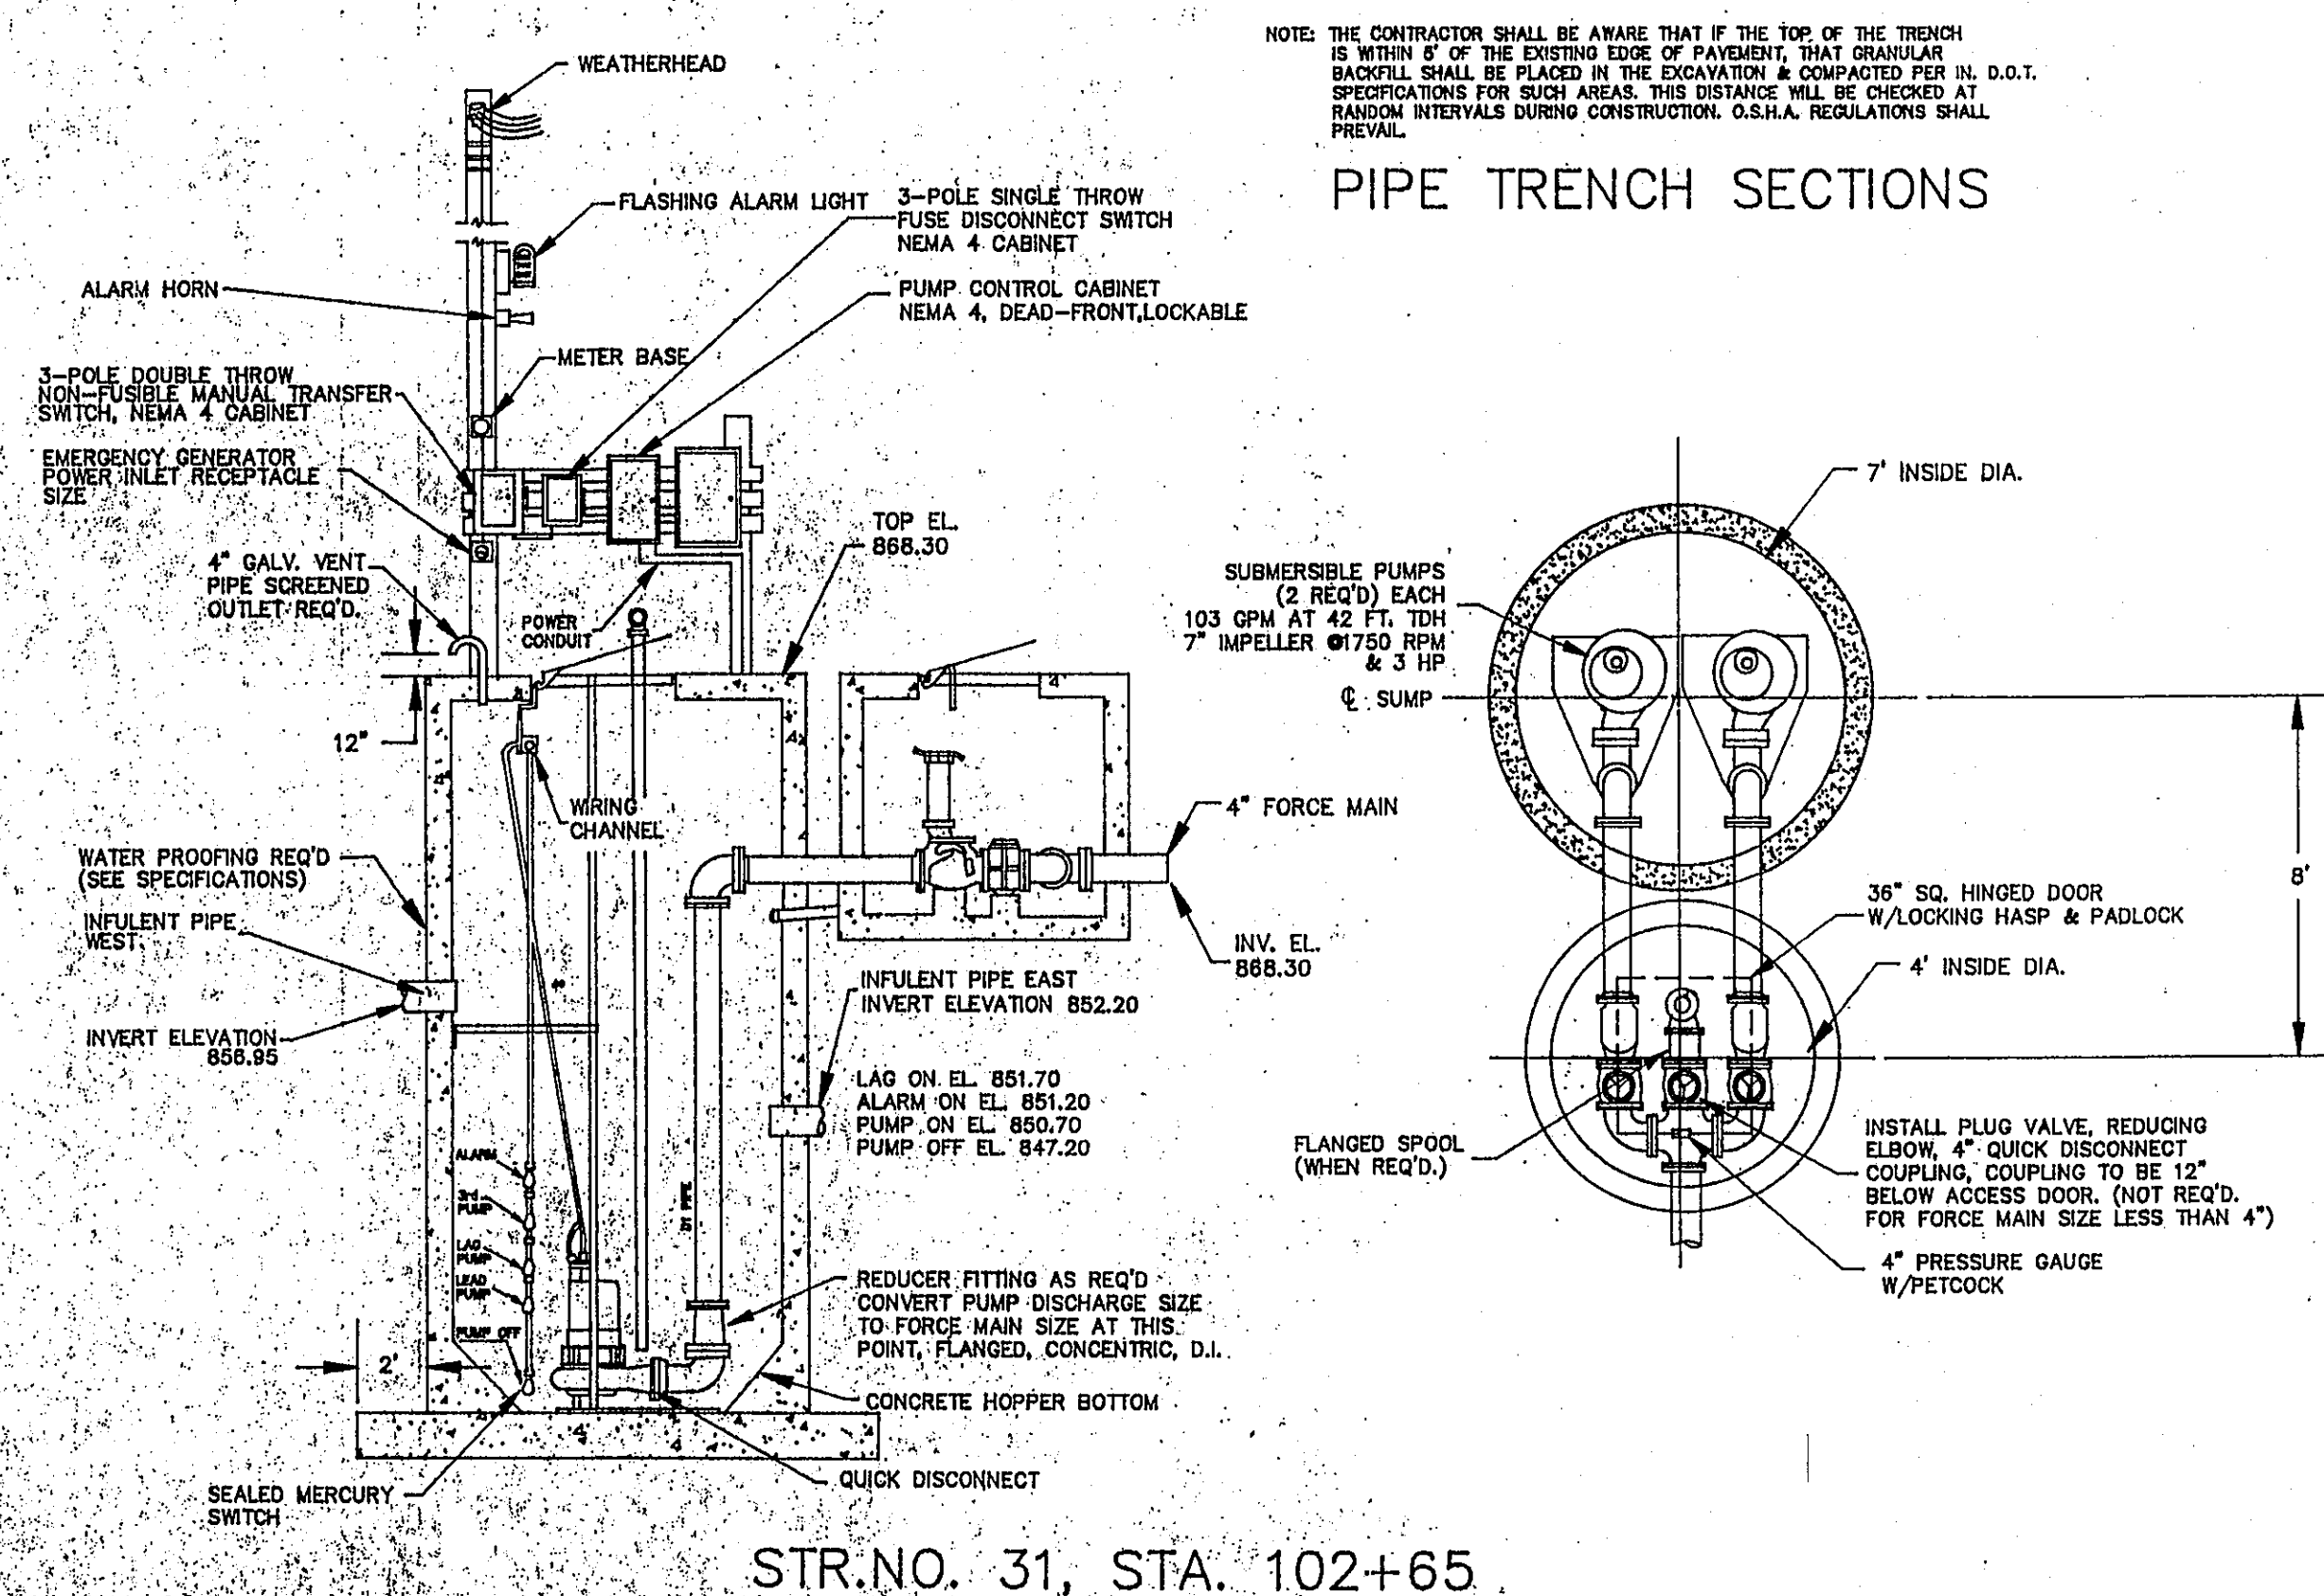
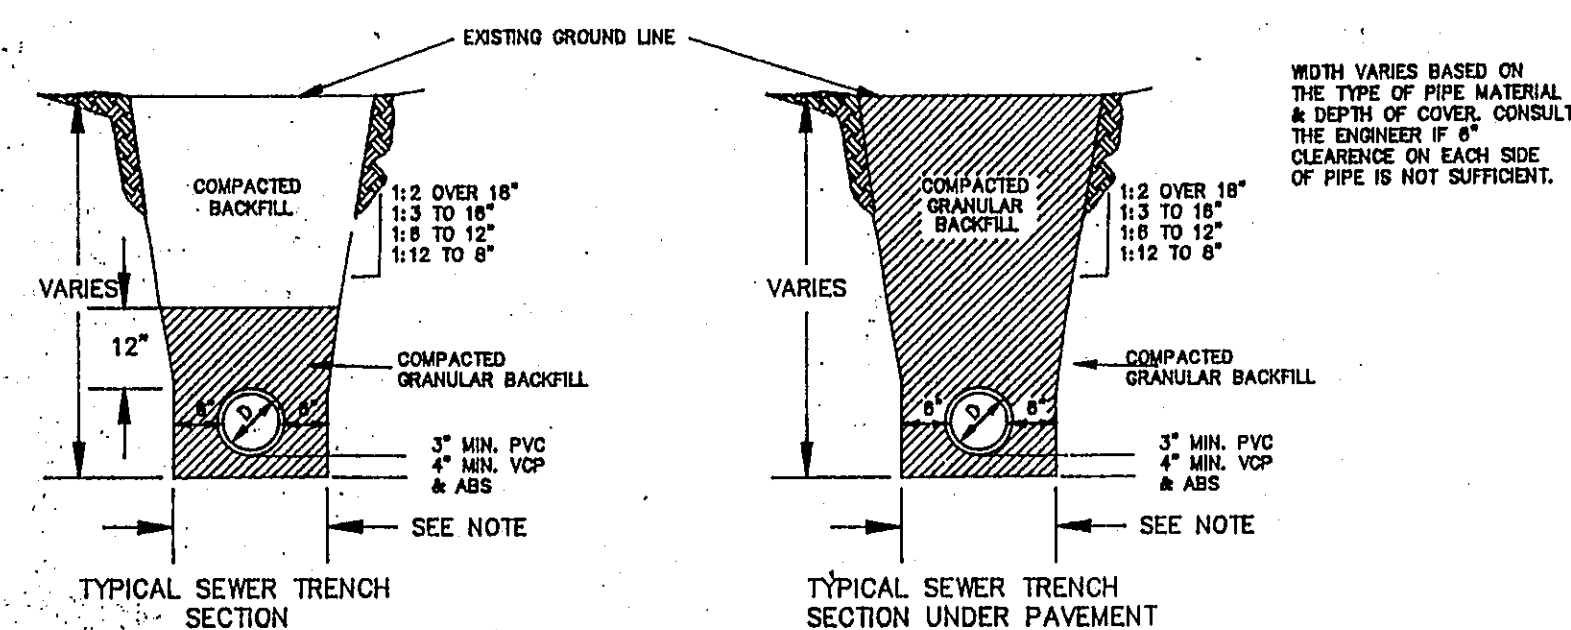
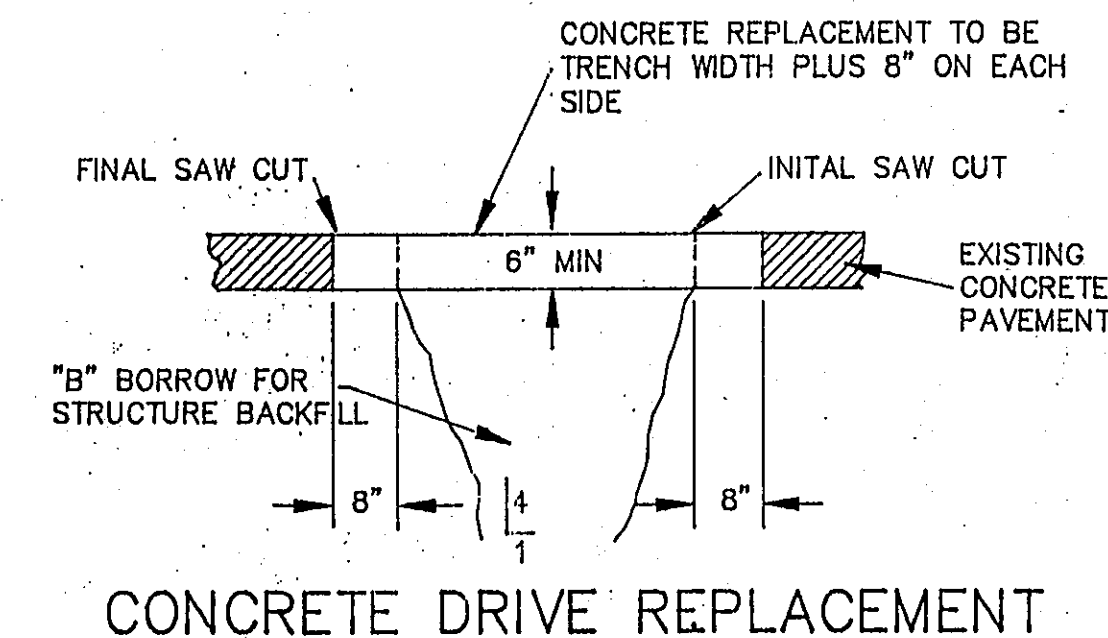
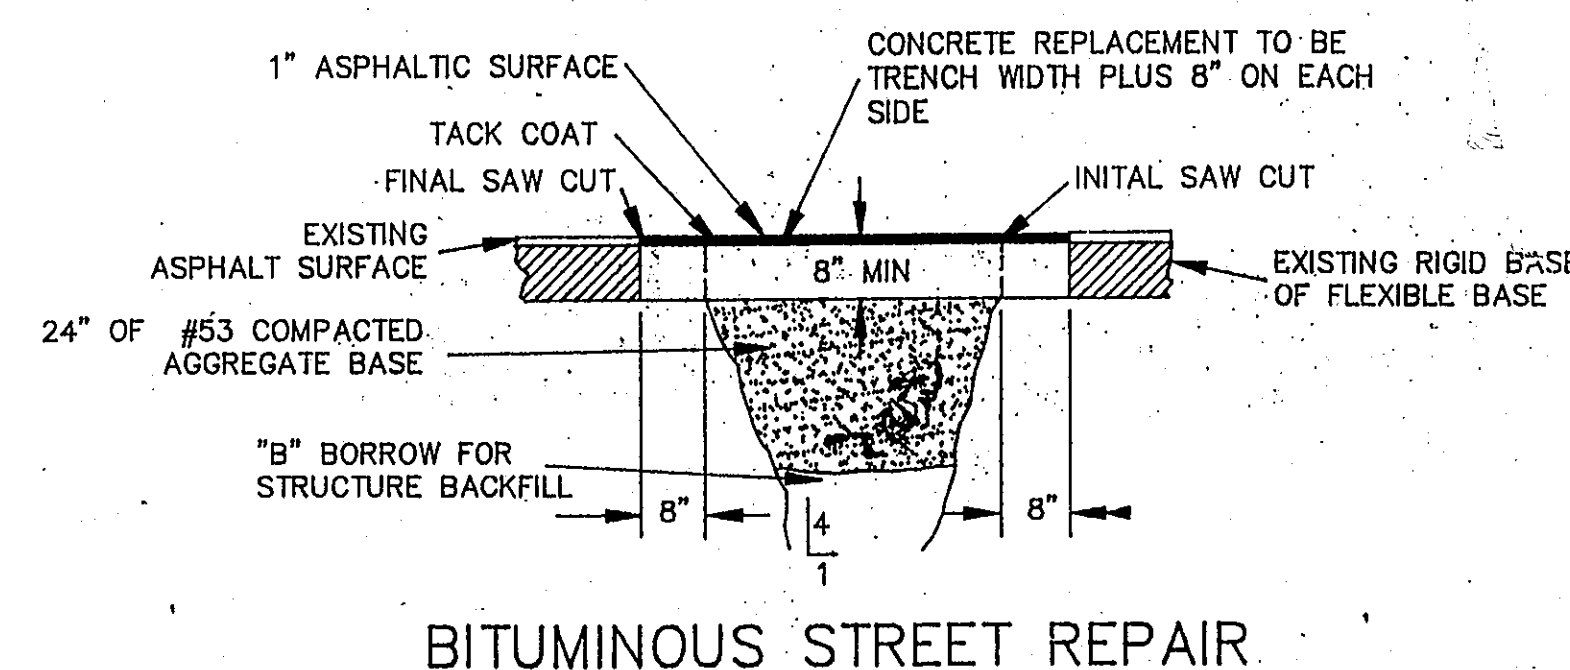
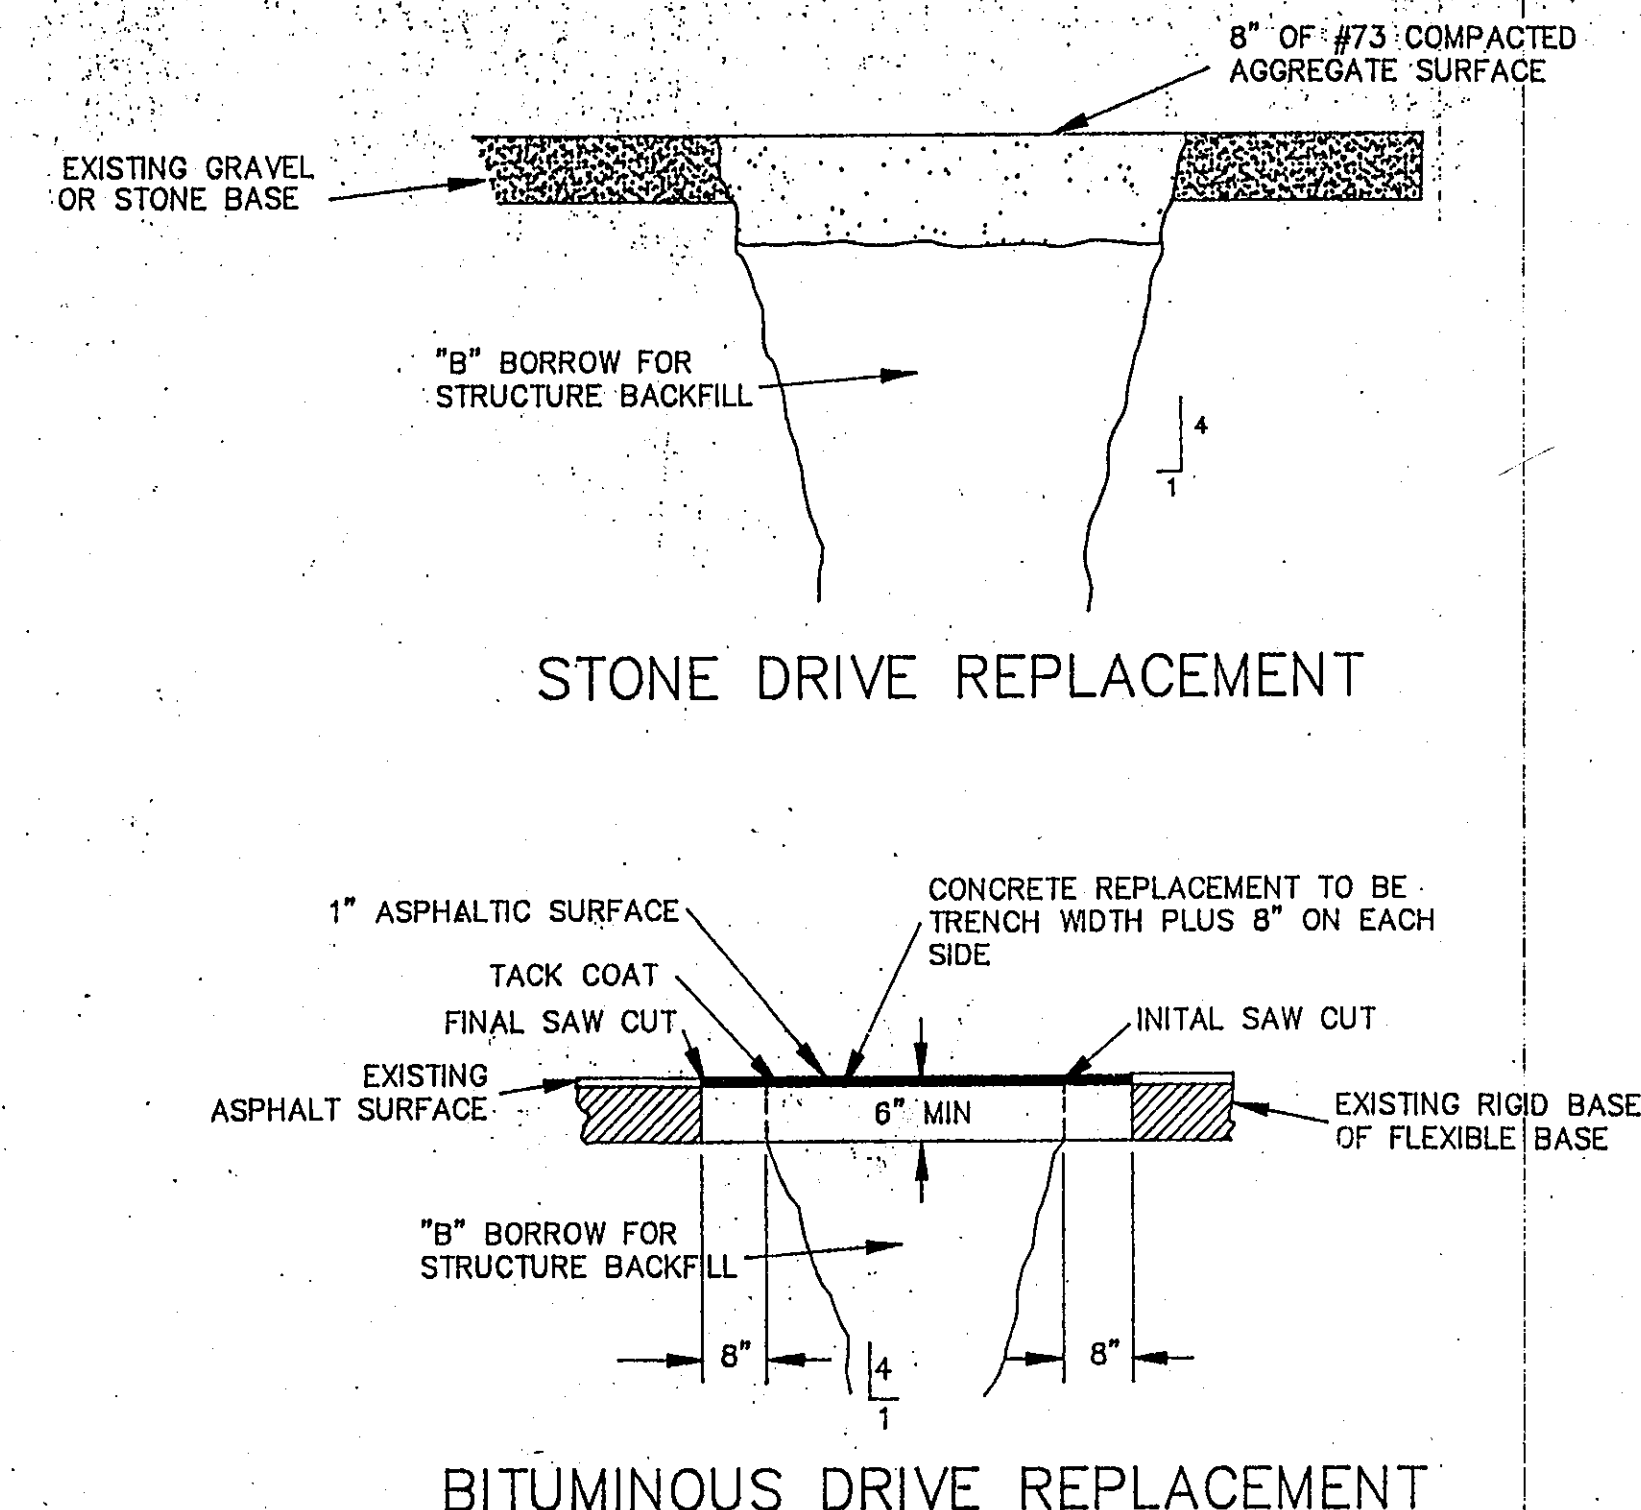
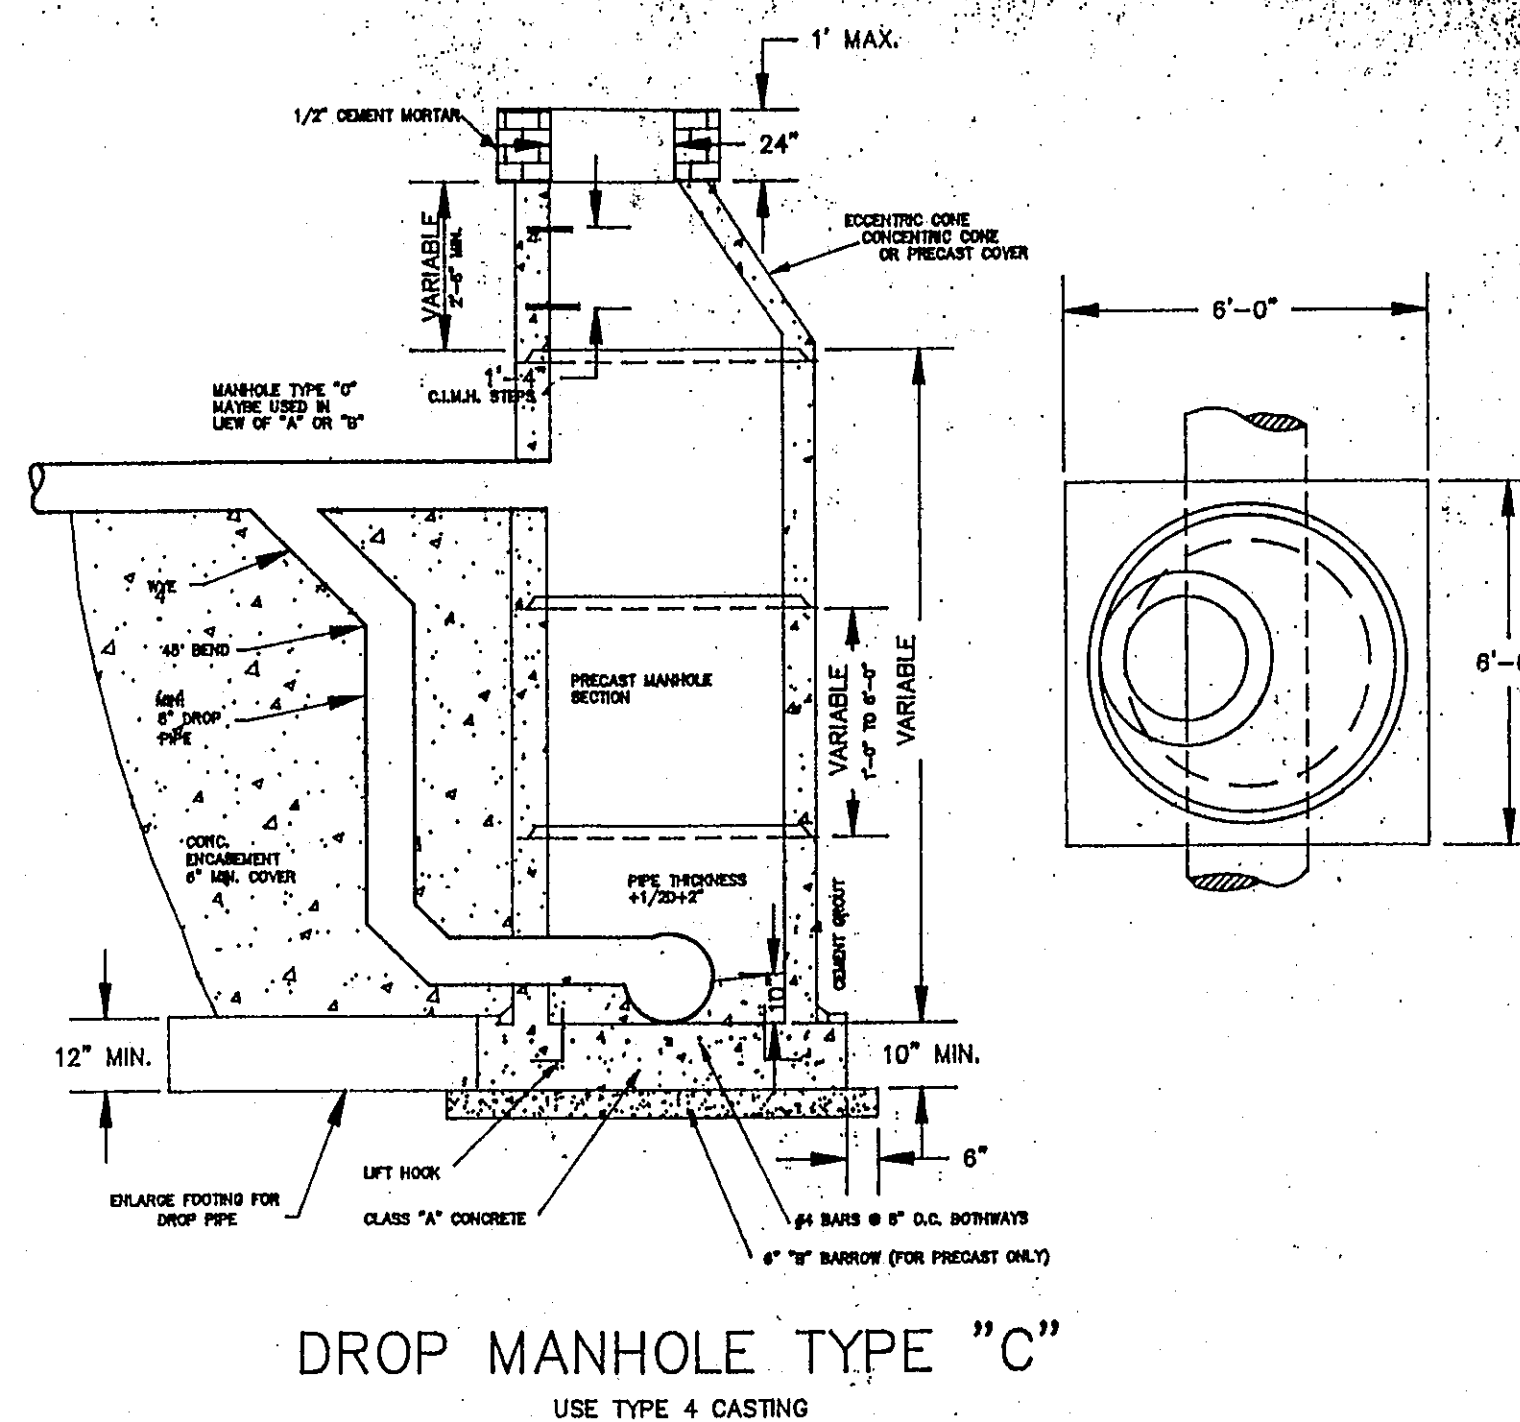


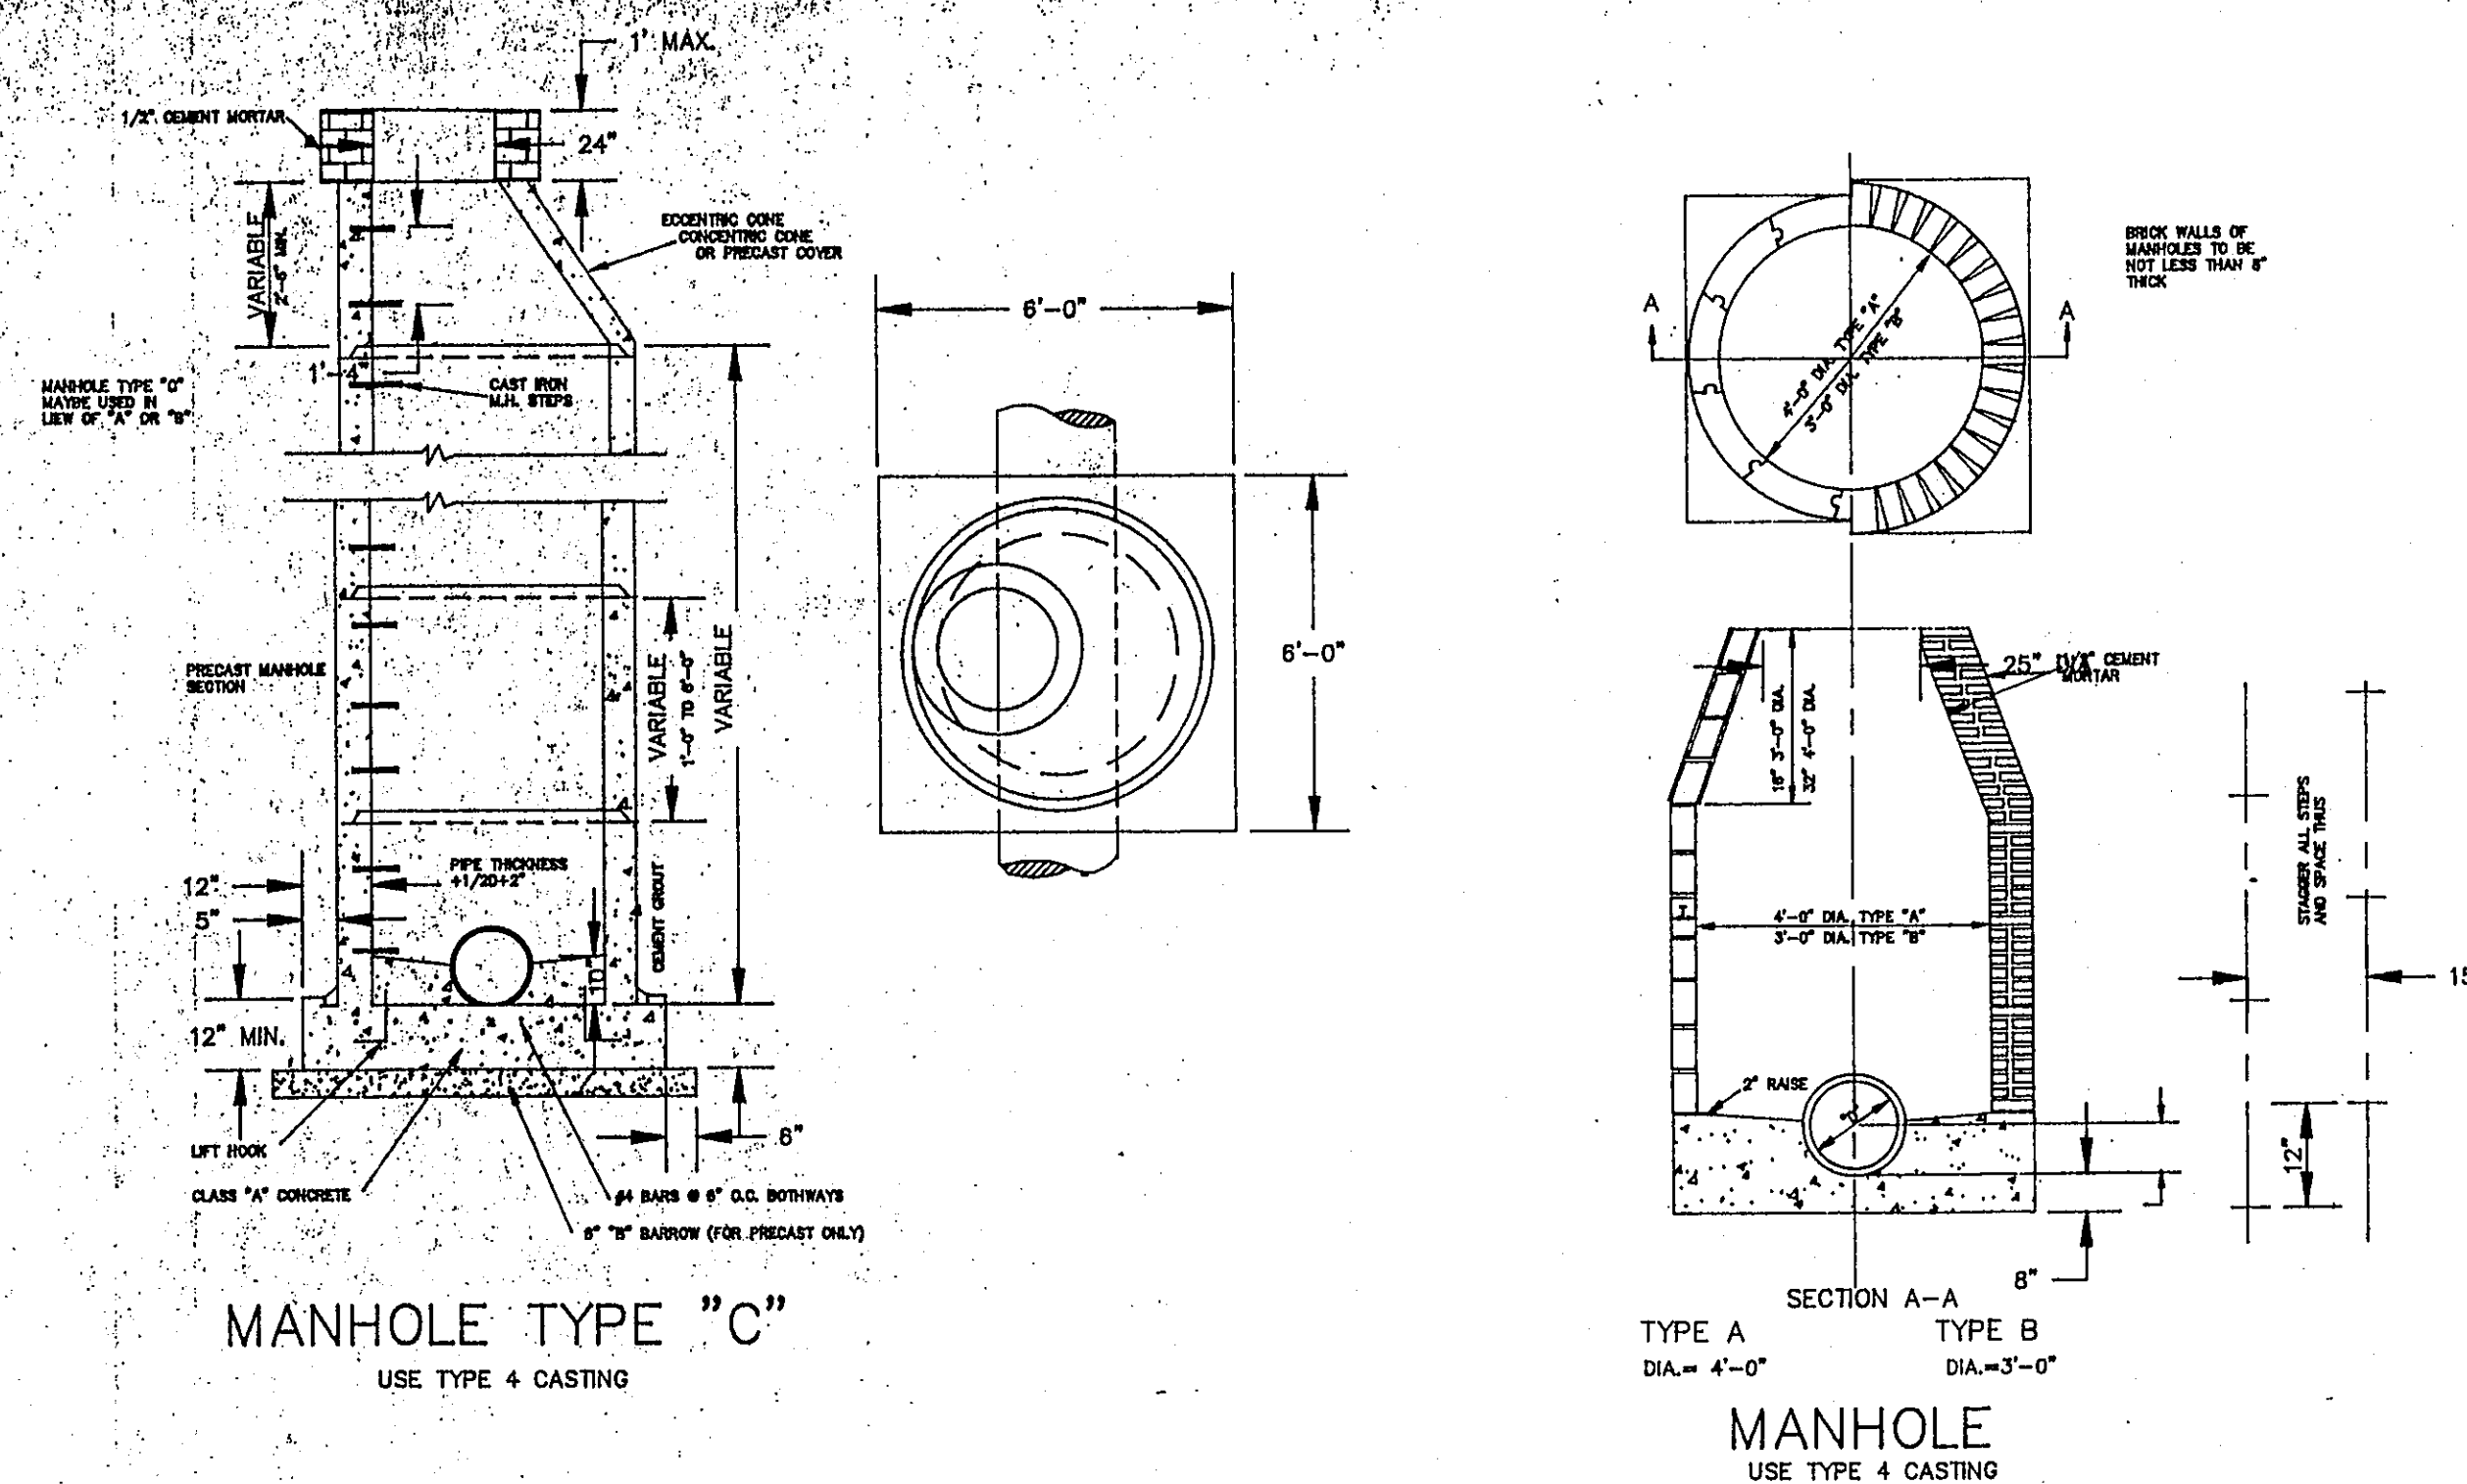

STR.NO. 31, STA. 102+65

# F.C.R.W.D. HUNTSVILLE ROAD SEWER DETAILS

STR.NO. 16, STA. 27+25

**DURHAM Engineering**  
12 W. 8th STREET ANDERSON, INDIANA  
(317) 644-3833

SCALE: N.T.S.

SHEET NO. 9 of 1

