


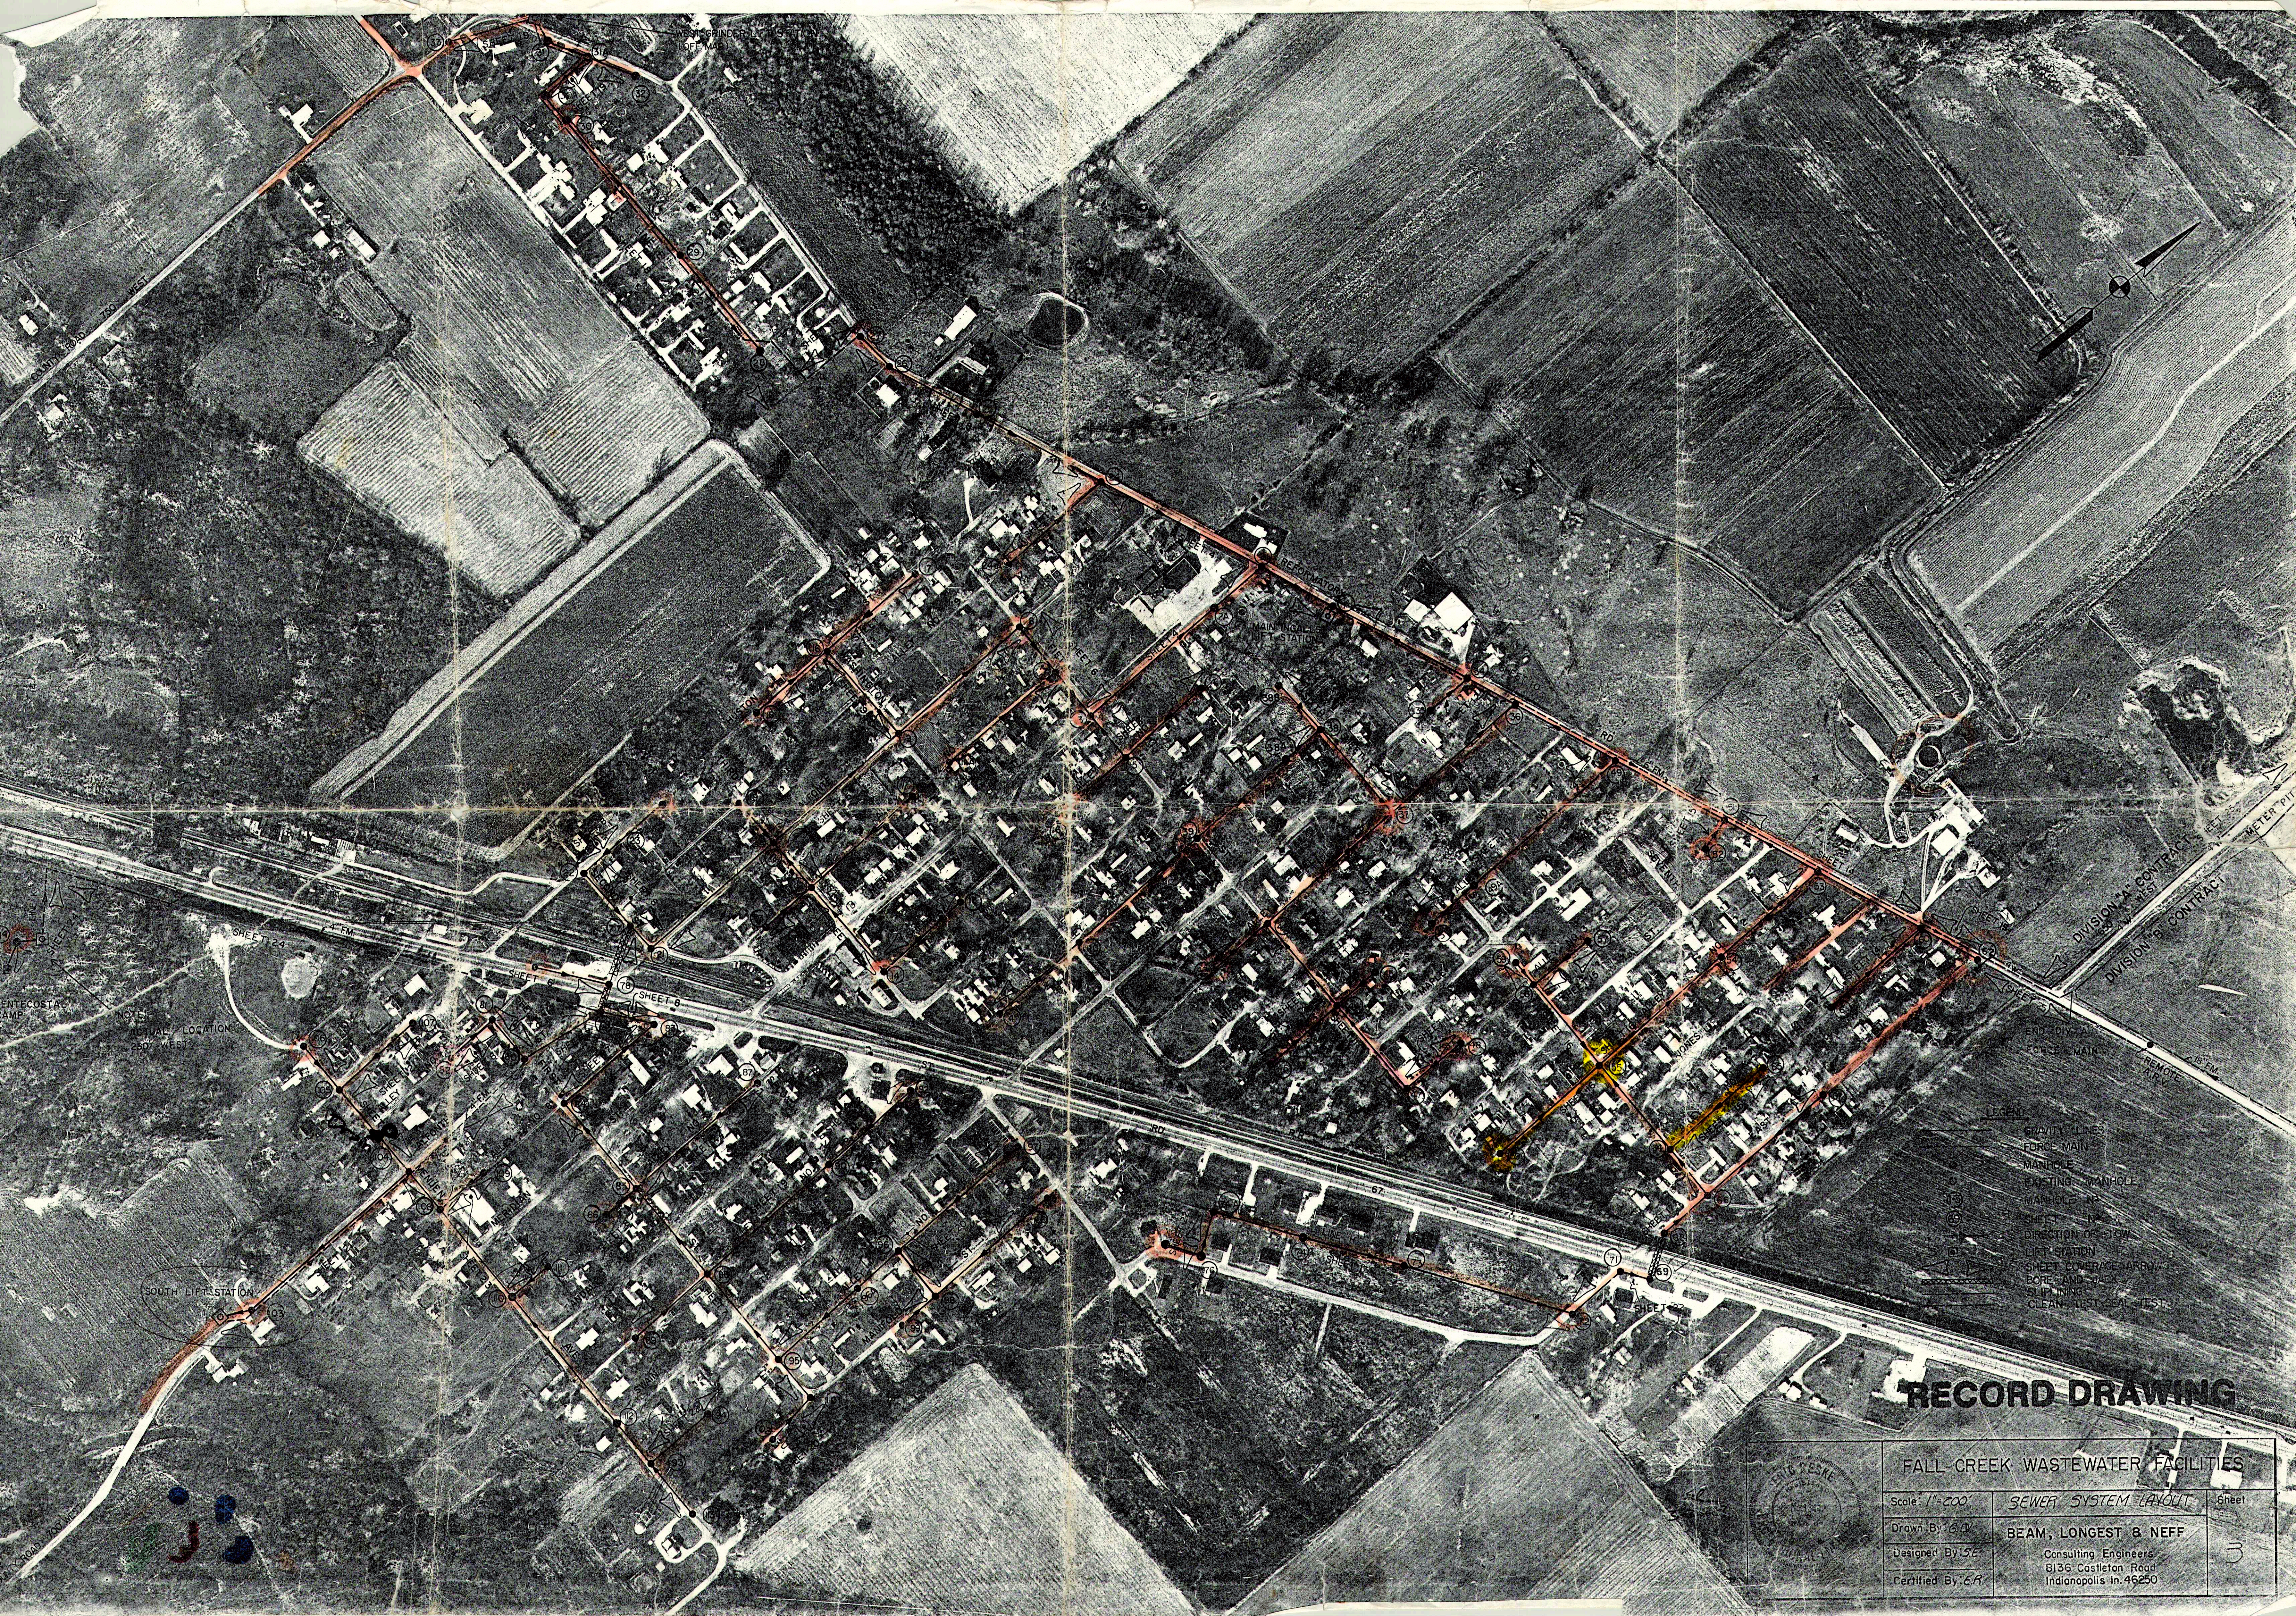

RECORD DRAWING

FALL CREEK WASTEWATER FACILITIES

Scale: 1"=200'	SEWER SYSTEM LAYOUT	Sheet
Drawn By: B.D.	BEAM, LONGEST & NEFF	3
Designed By: S.E.	Consulting Engineers	
Certified By: C.R.	8136 Castleton Road	
	Indianapolis, In. 46250	