


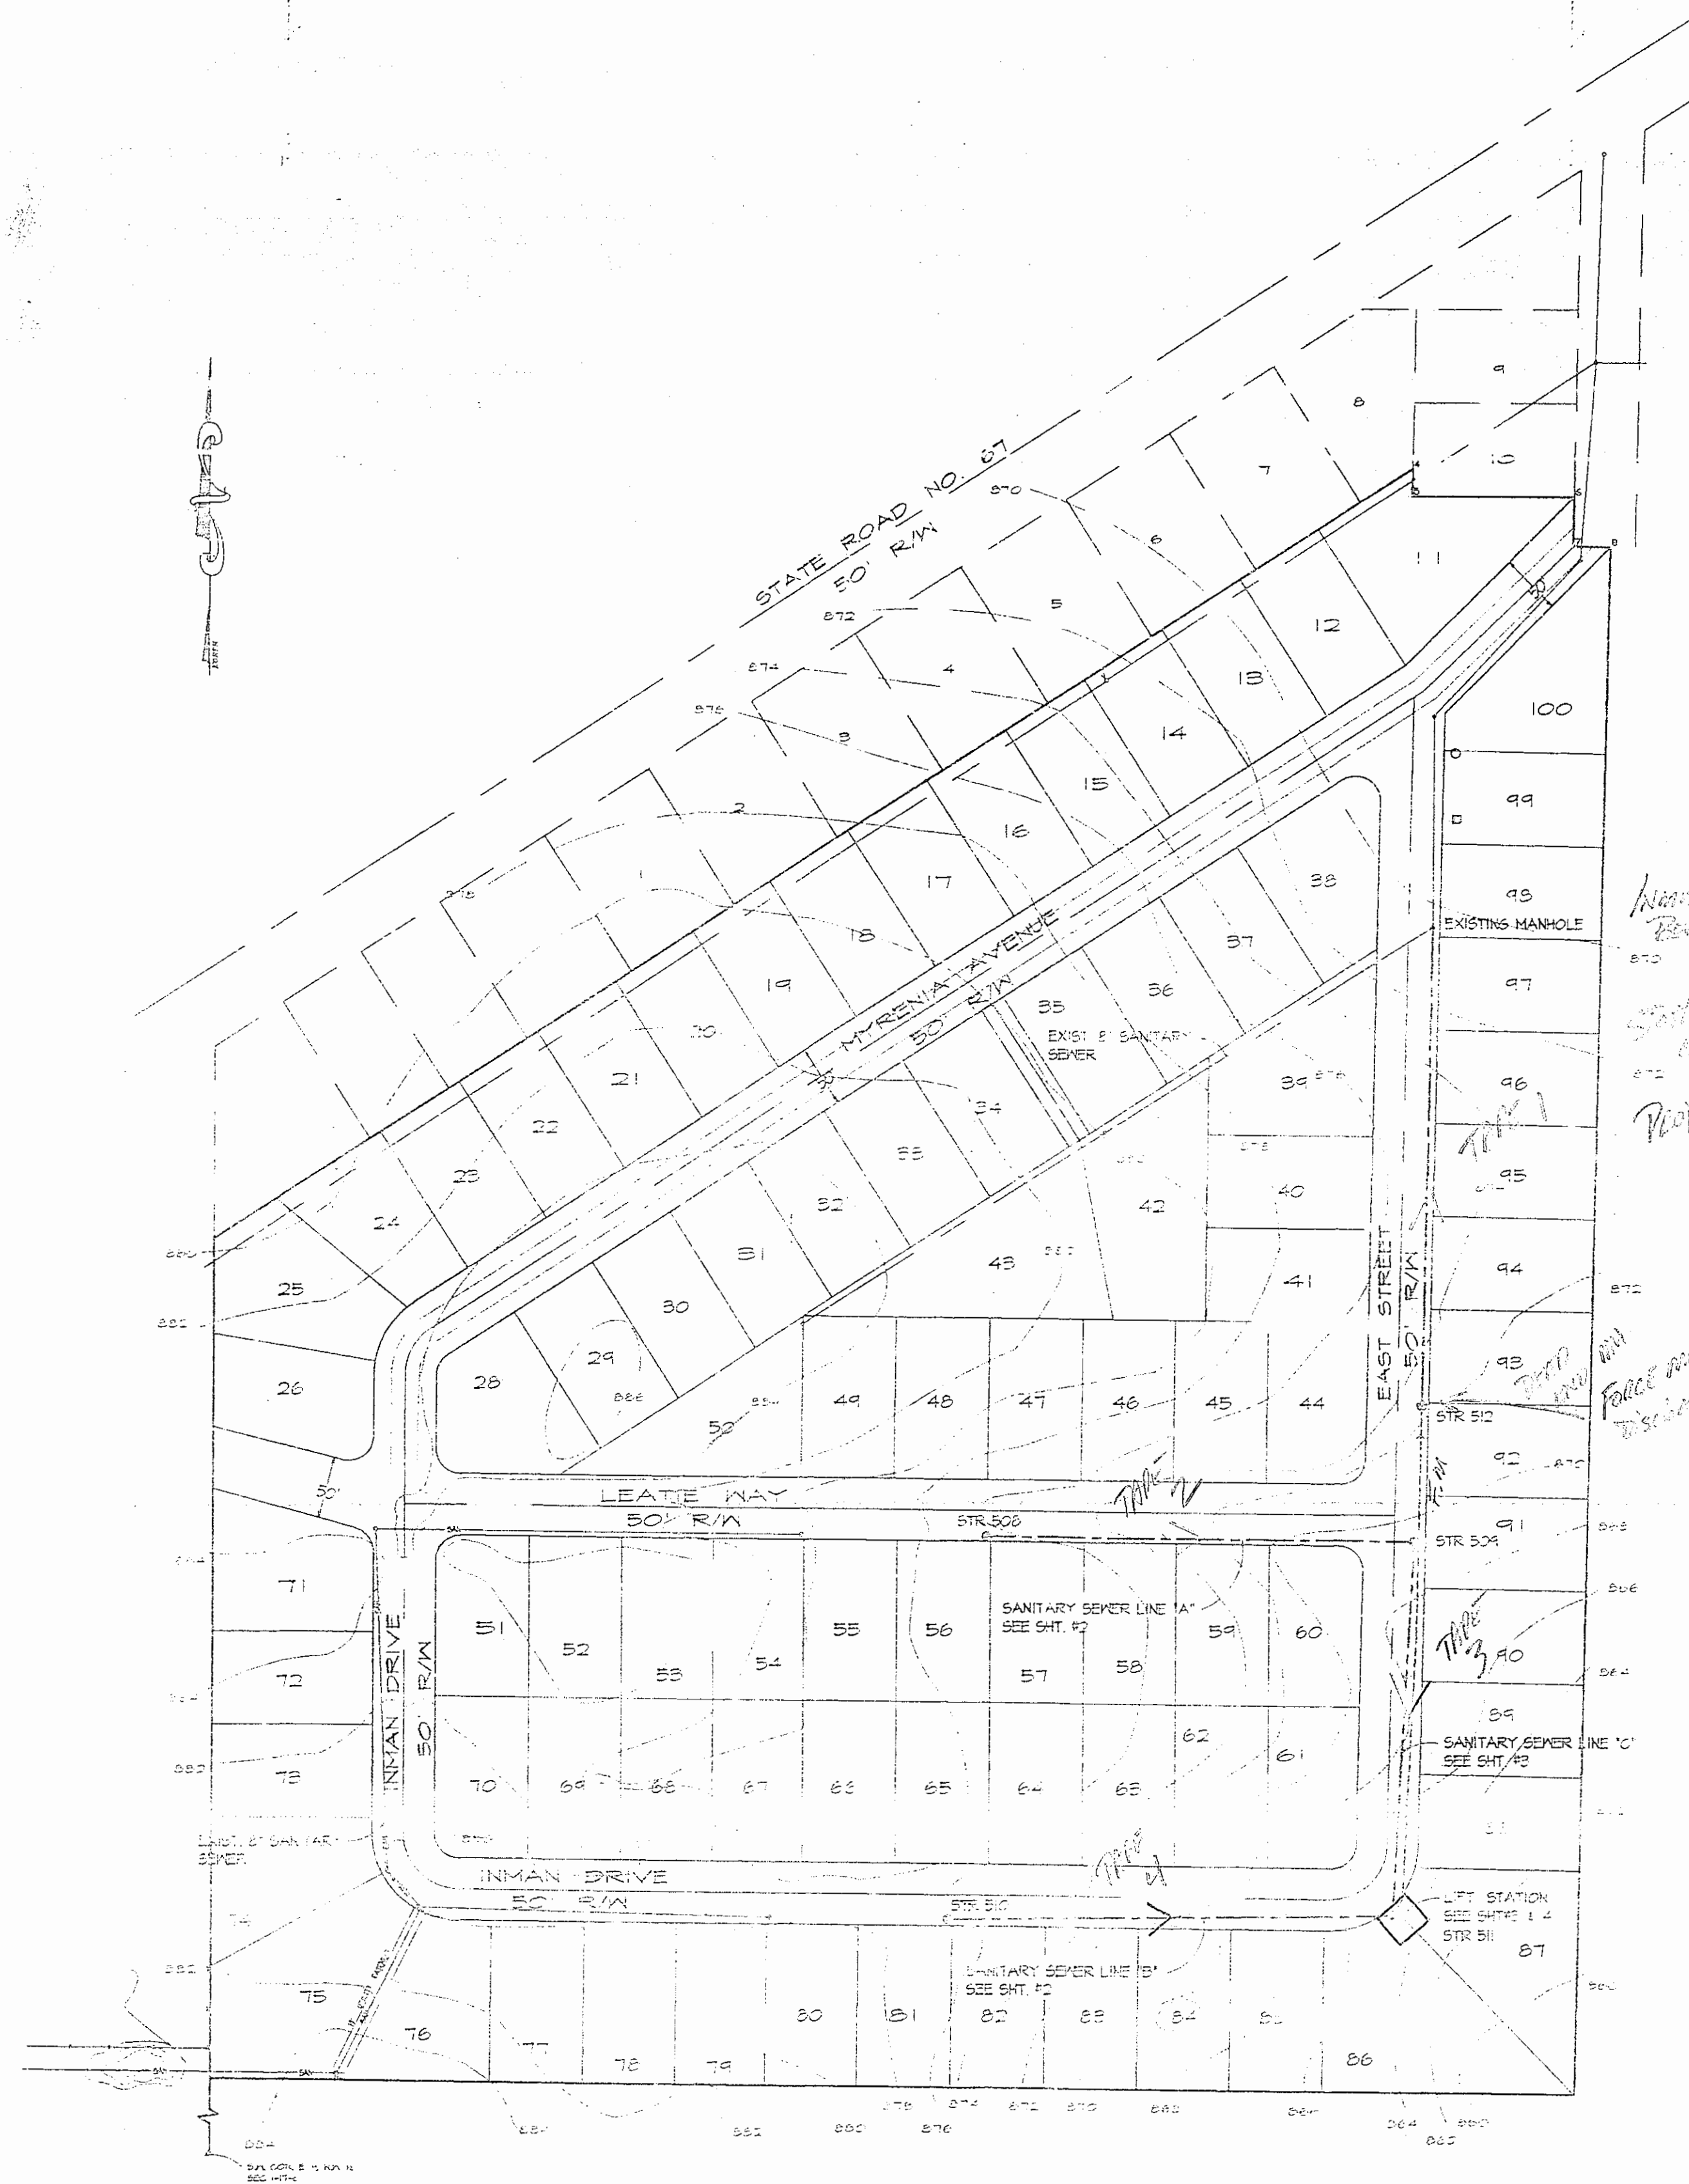

KEY MAP

1" = 100'

SEWER * FORCE MAIN * LIFT STATION MYRENIA INMAN ADDITION INGALLS, INDIANA

ENGINEER & SURVEYOR:

BRADLEY A. RAYL P.E., P.L.S.
SURVEYING & ENGINEERING
1926 E. 53rd STREET SUITE 4
ANDERSON, INDIANA 46013
Phone: (317) 643-5614

DEVELOPER:

JEFF HOSSLER
SOUTHGATE HOMES
5702 PENDLETON AVE.
ANDERSON, INDIANA 46013
Phone: (317) 641-7018


AS BUILTS

INMAN

LOTS TO BE SERVICED BY THIS PLAN INCLUDE:

39-41, 44-48, 56-65, 81-97
(3) (5) (10) (17)

35 LOTS TOTAL

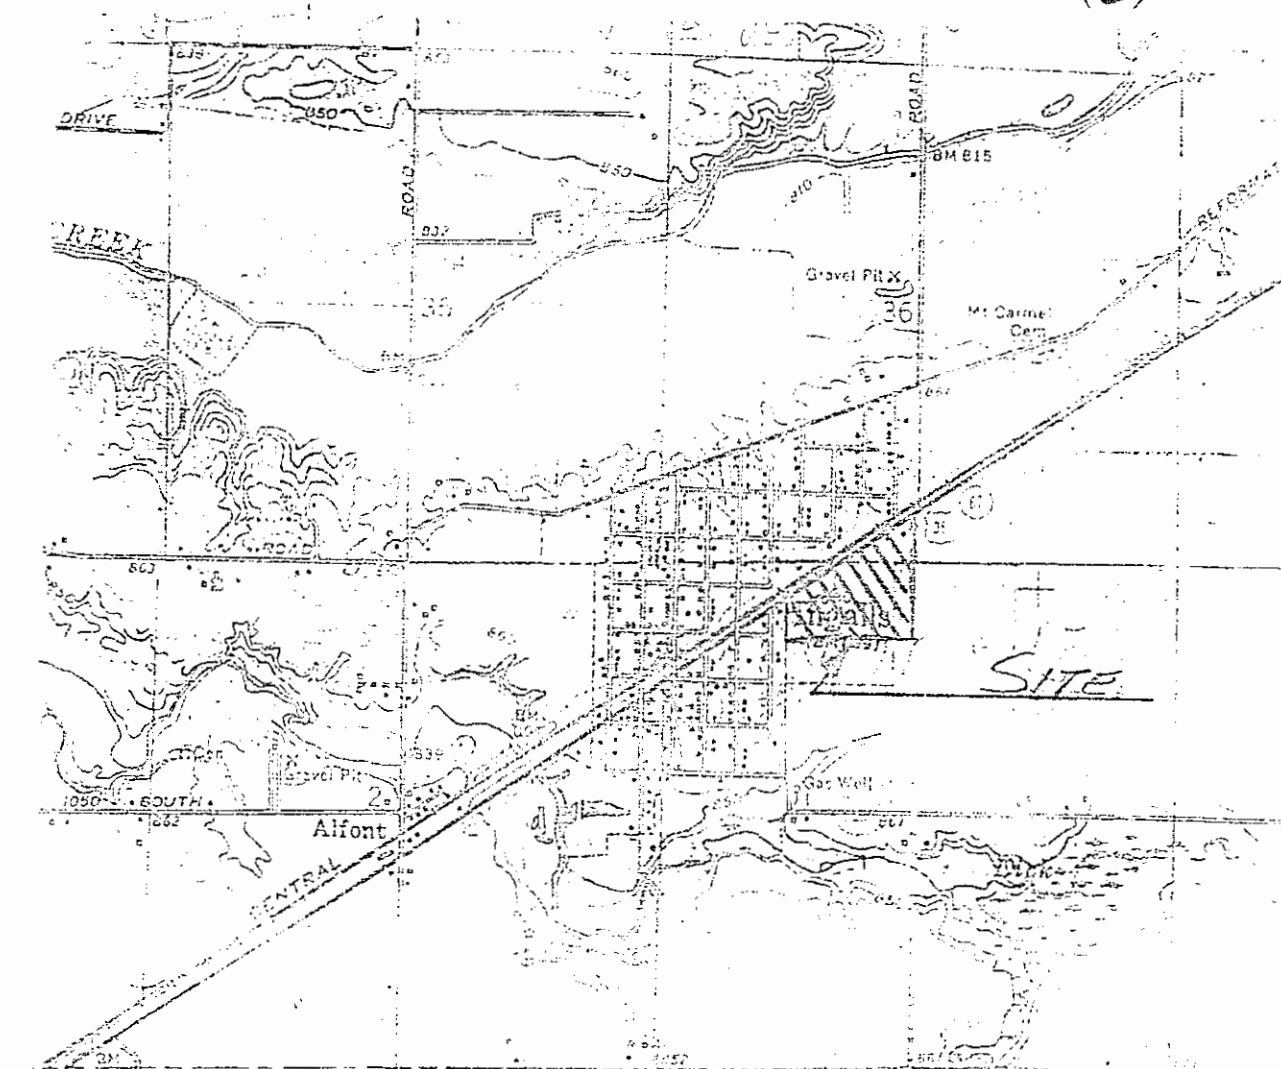

AREA MAP

NO SCALE


SHEET NO. DESCRIPTION

1.	TITLE SHEET
2.	SANITARY SEWER PLANS
3.	SANITARY SEWER PLANS
4.	LIFT STATION SITE PLAN
5.	LIFT STATION DETAILS NOTES

PLANS PREPARED BY:

Bradley A. Rayl

DATE: 6-26-96

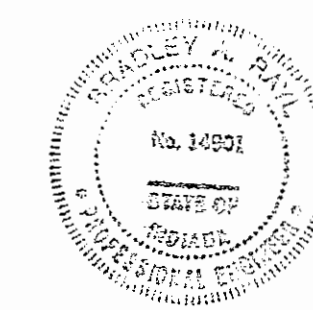

SHEET 1 OF 5

PRINTED NOV 04 1996