

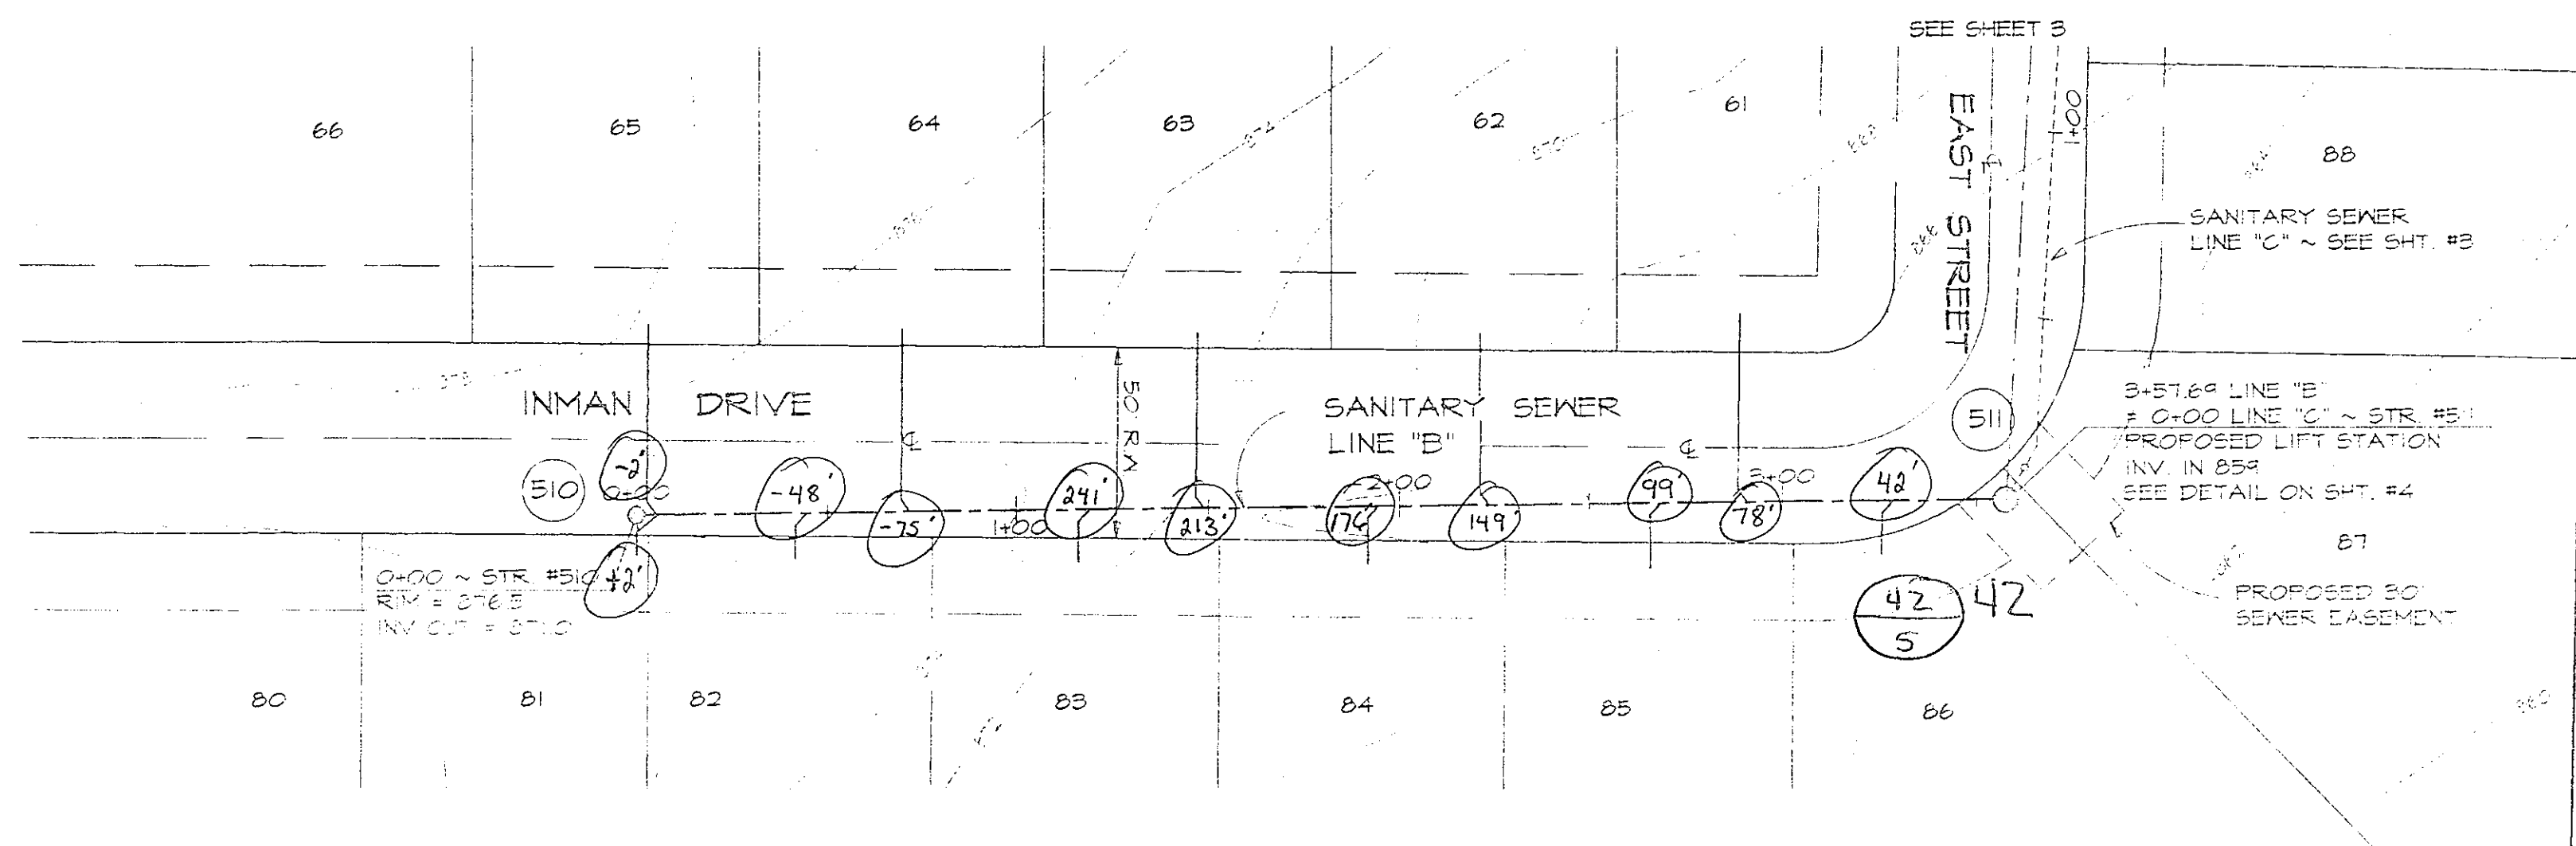
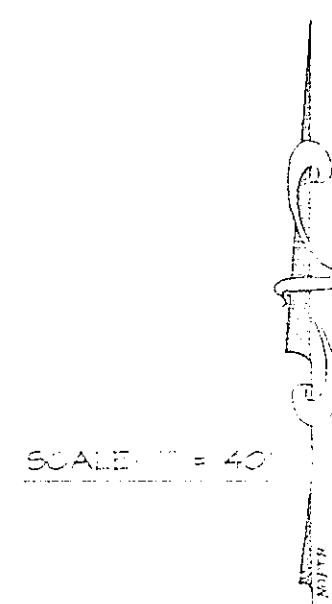
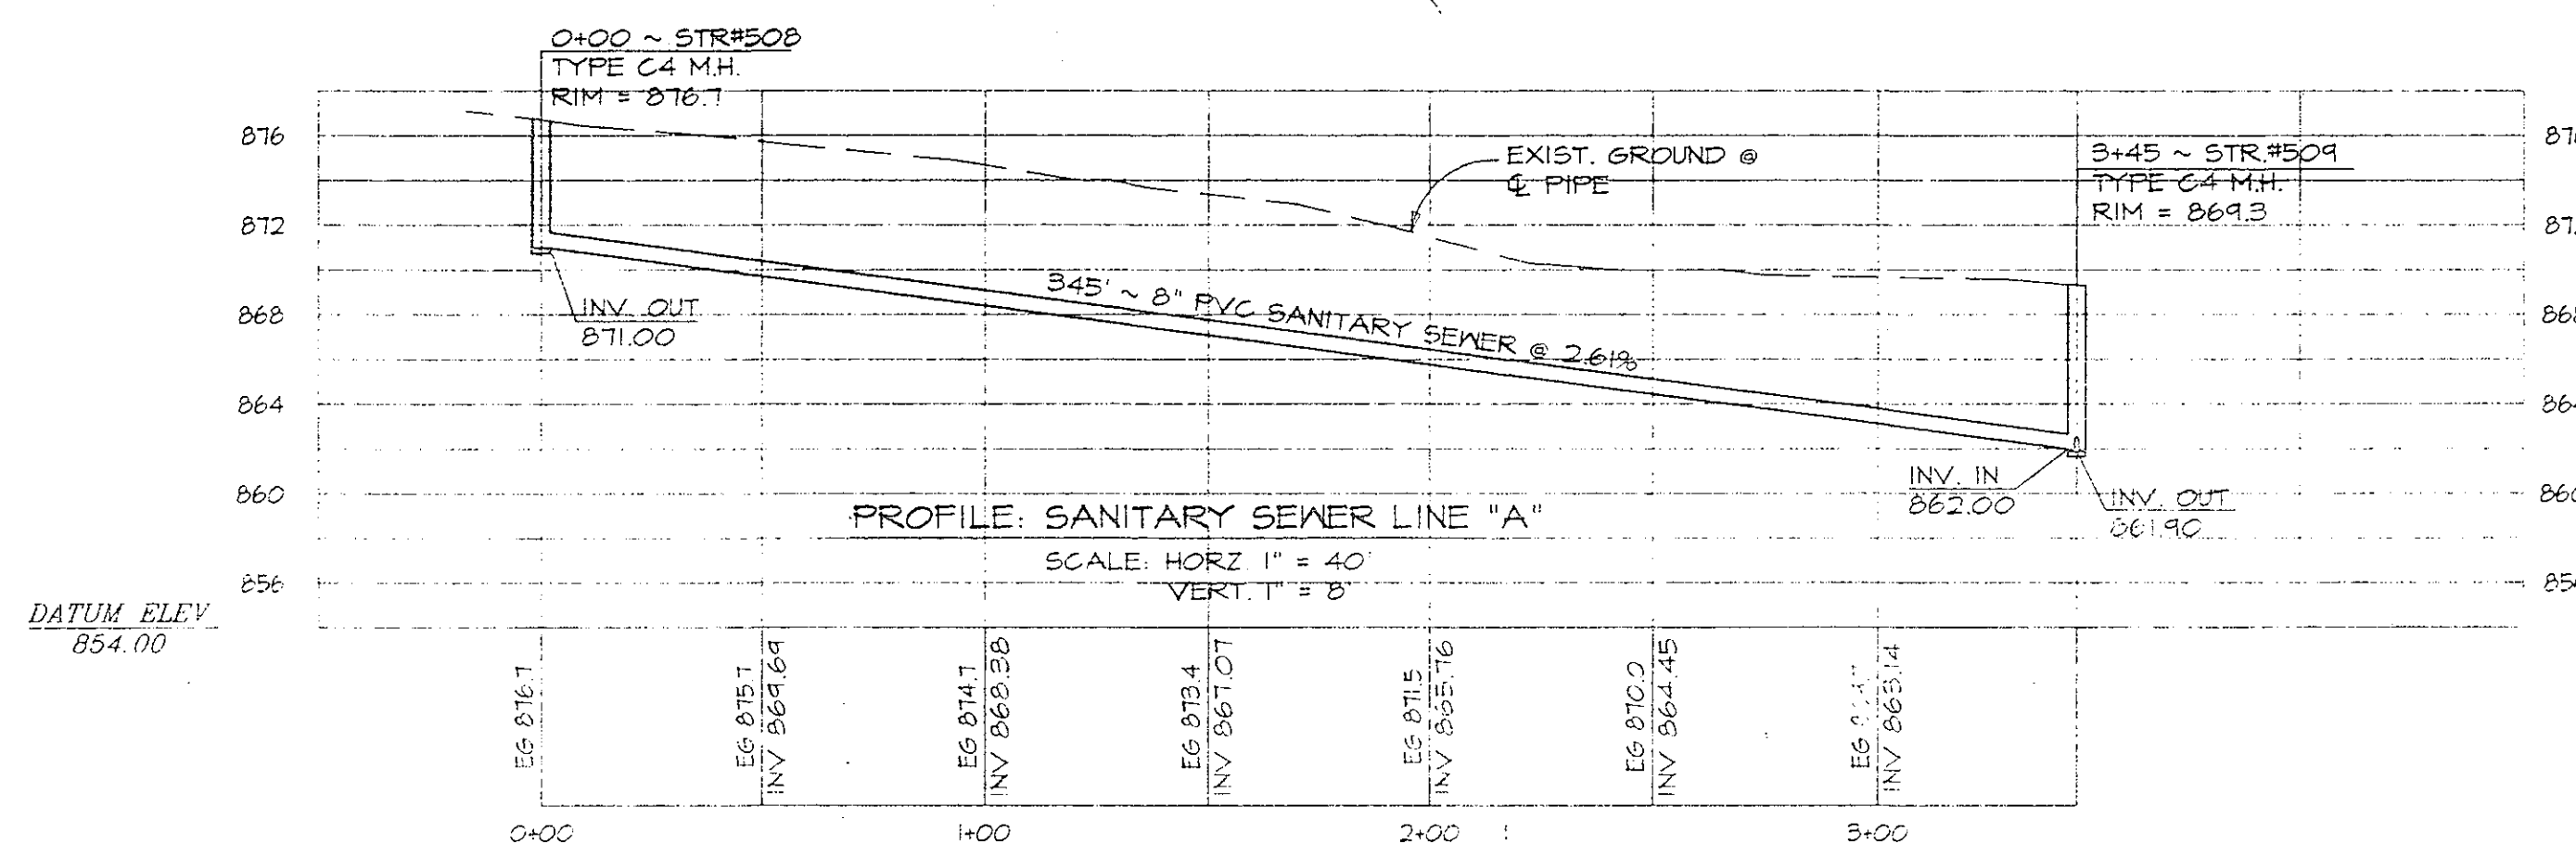
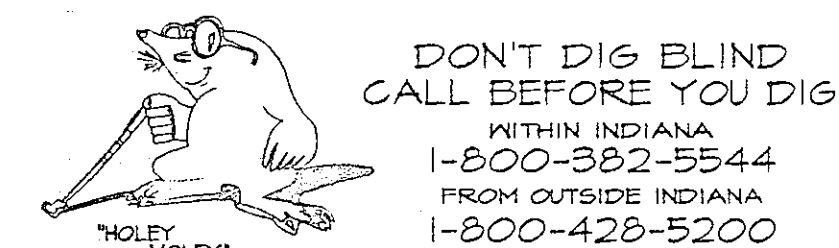
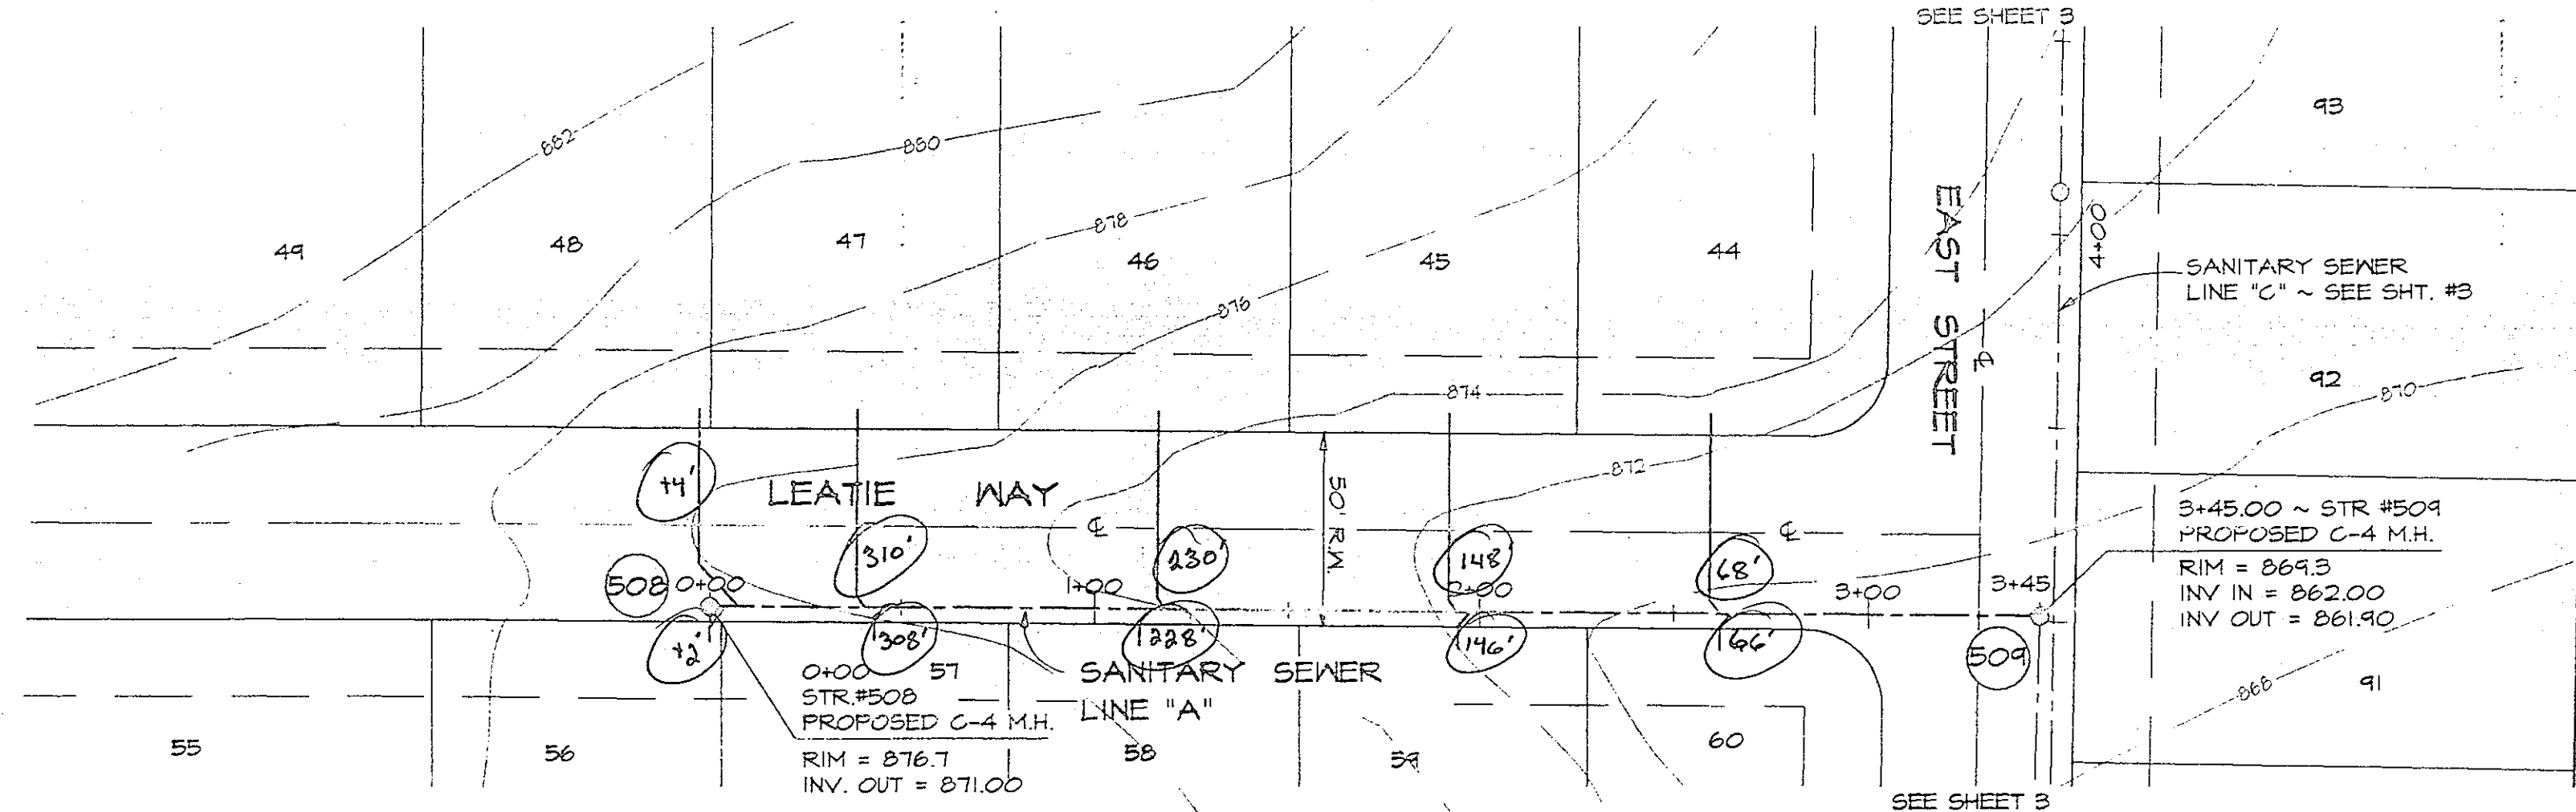


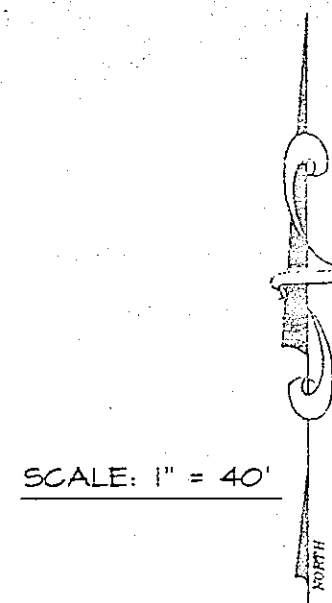

NOTE: SANITARY LATERALS SERVICES TO BE 6"Ø

LEGEND	
EXIST. GROUND	---
TYPE C-4 MAN HOLE	C
8" PVC SANITARY SEWER MAIN	---
1/2" PVC FORCE MAIN SEWER	---
STRUCTURE NO.	504
EXIST. GROUND ELEV.	EG 868.0
INV. ELEV	INV 862.75

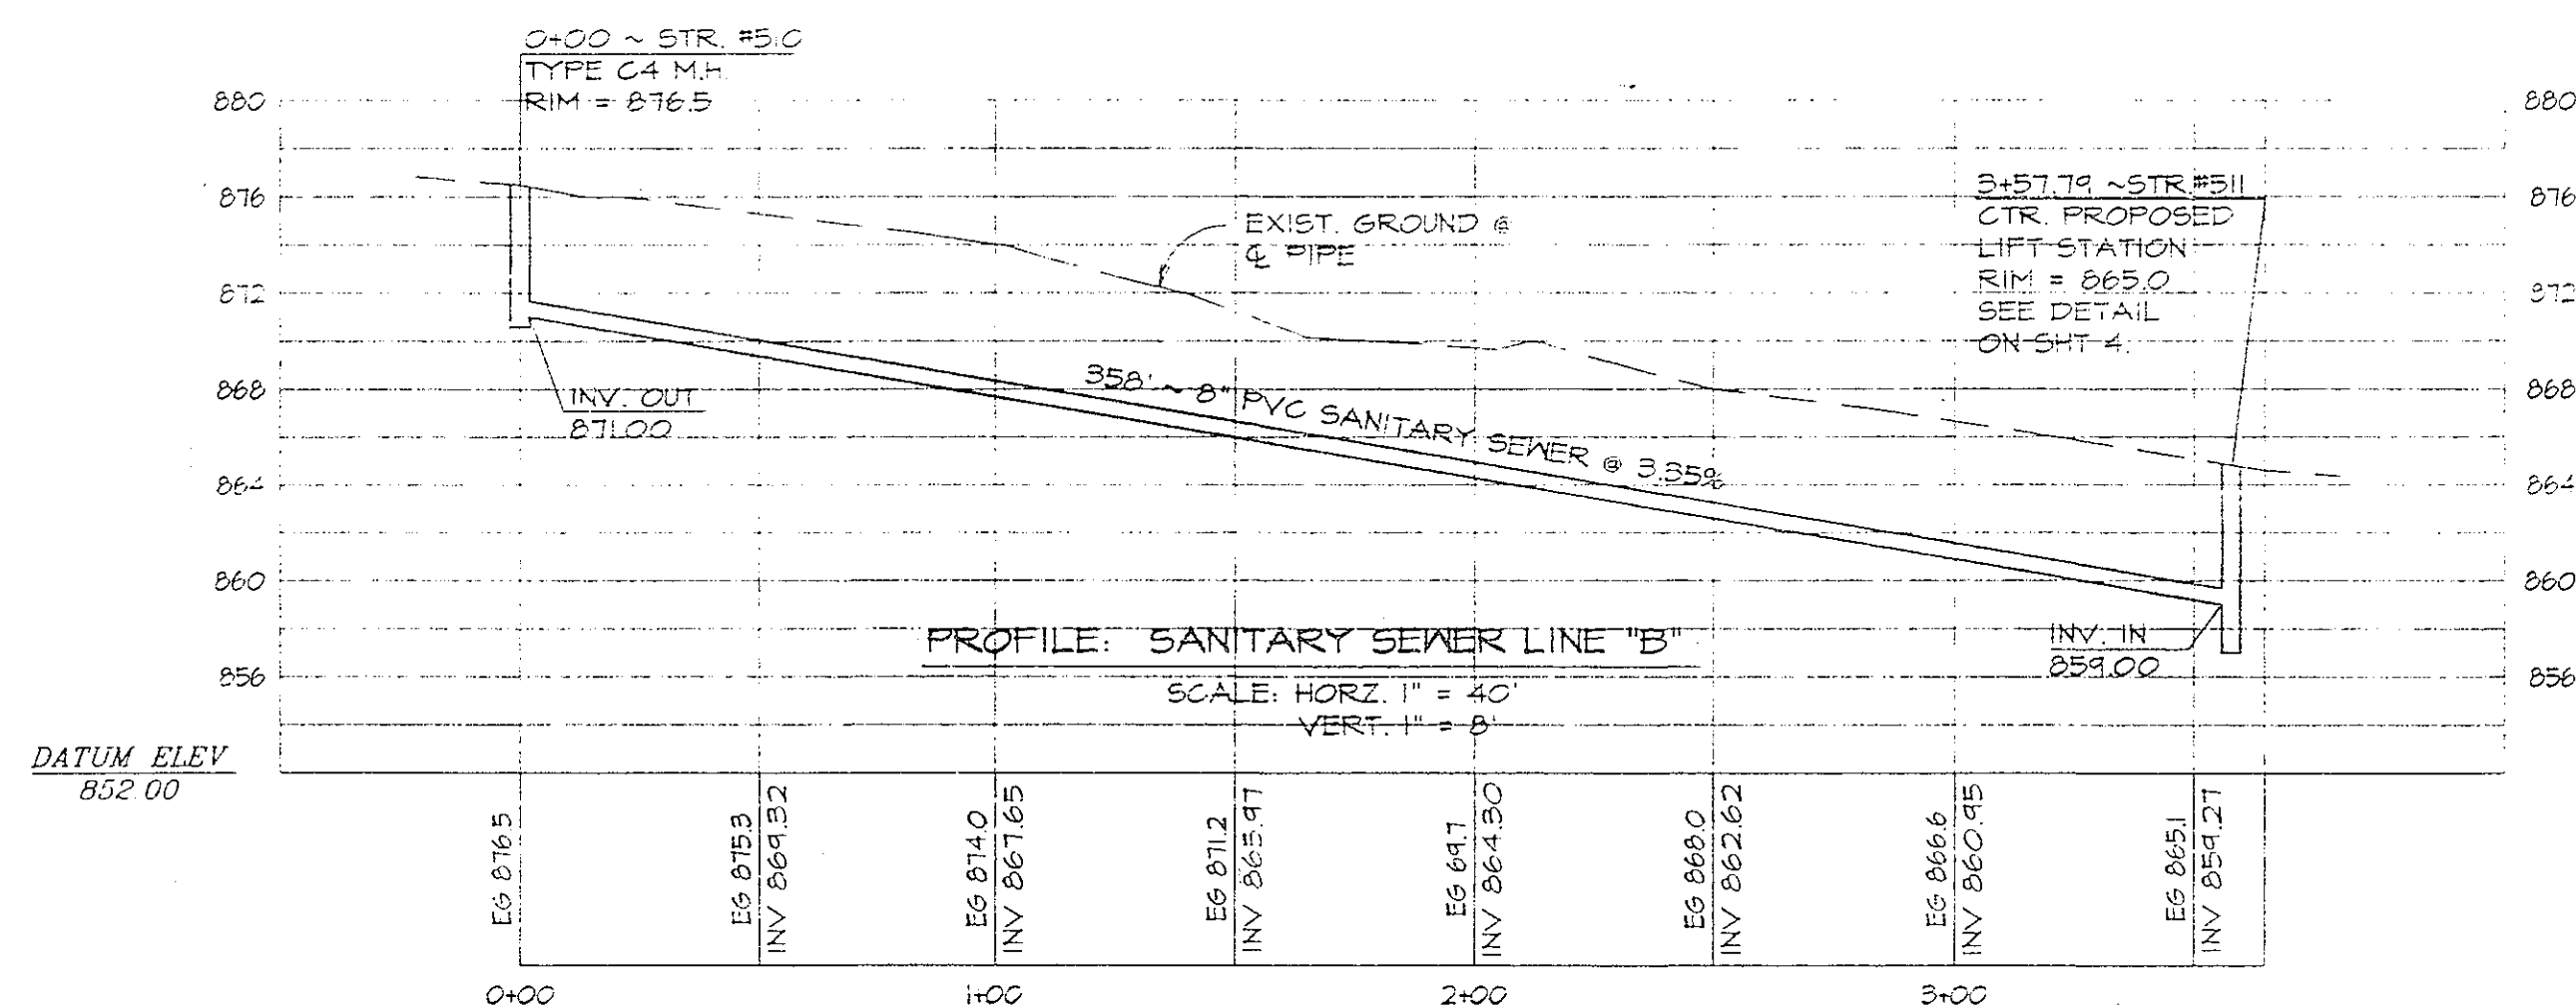

FILE: C:\MYRENA\SEWER\SH2.DWG

RAYL
SURVEYING
&
ENGINEERING

1926 E. 58RD ST. SUITE 4
ANDERSON, INDIANA 46013
(317) 643-5614


SEWER PLAN

REVISIONS: 0-14-96 CHANGED LOCATION OF LIFTSTATION / CHANGED STATIONING
0-13-96 CHANGED E.M. TO 1/2"Ø (R.P.)

MYRENA INMAN ADDITION
INGALLS, INDIANA

DATE: JUNE 25, 1996

DRAWN BY: DAVID LBAUGH

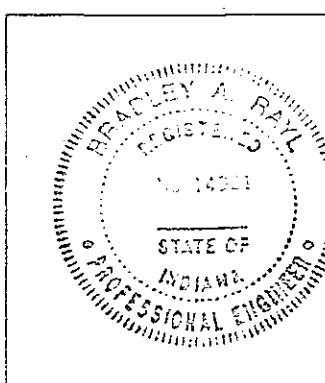

DATE: 6-26-96

SHEET
2 OF 3