


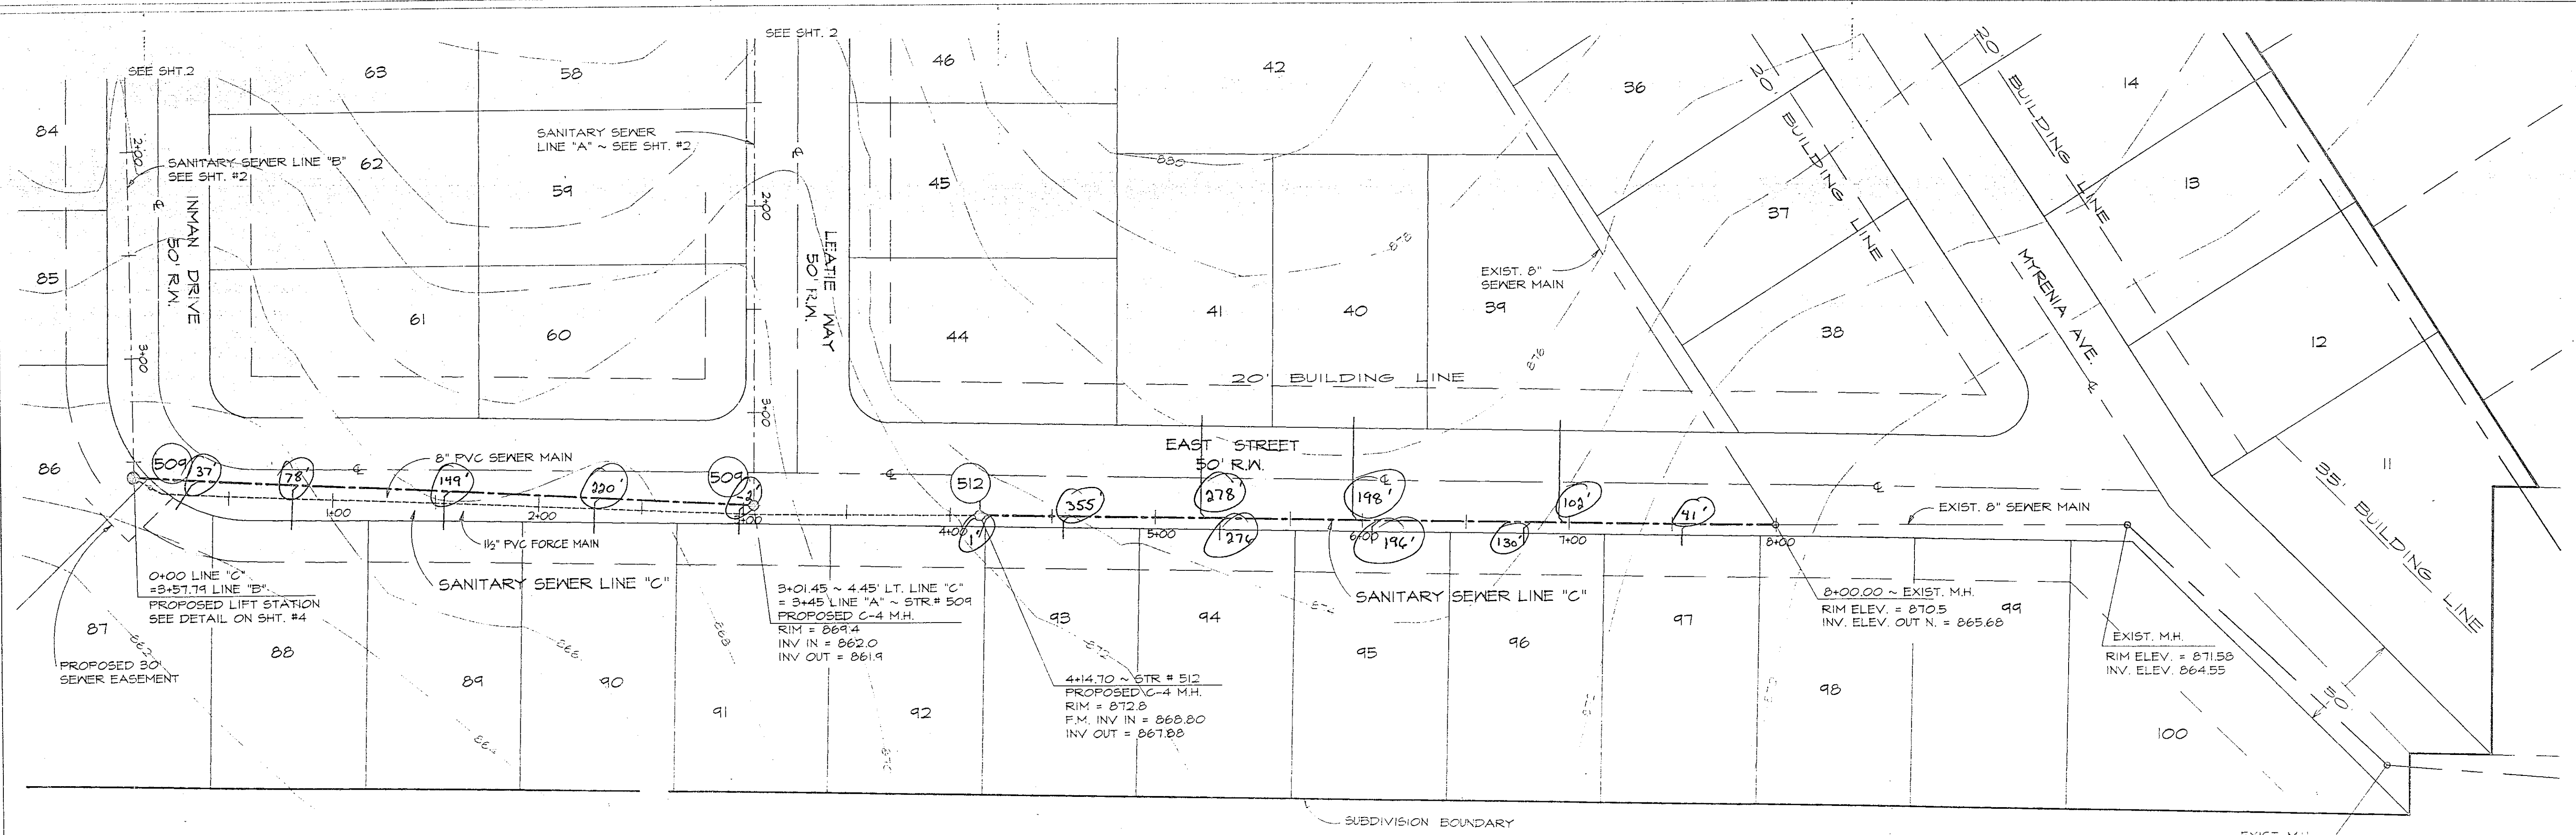

LEGEND

EXIST. GROUND

TYPE C-4 MAN HOLE

8" PVC SANITARY SEWER MAIN

1/2" PVC FORCE MAIN SEWER

STRUCTURE NO.

EXIST. GROUND ELEV.

INV. ELEV.

504


ES 868.0

INV 862.75

NOTE: SANITARY LATERALS TO BE 6"Ø

DON'T DIG BLIND
CALL BEFORE YOU DIG
WITHIN INDIANA
1-800-382-5544
FROM OUTSIDE INDIANA
1-800-428-5200

SCALE 1" = 40'

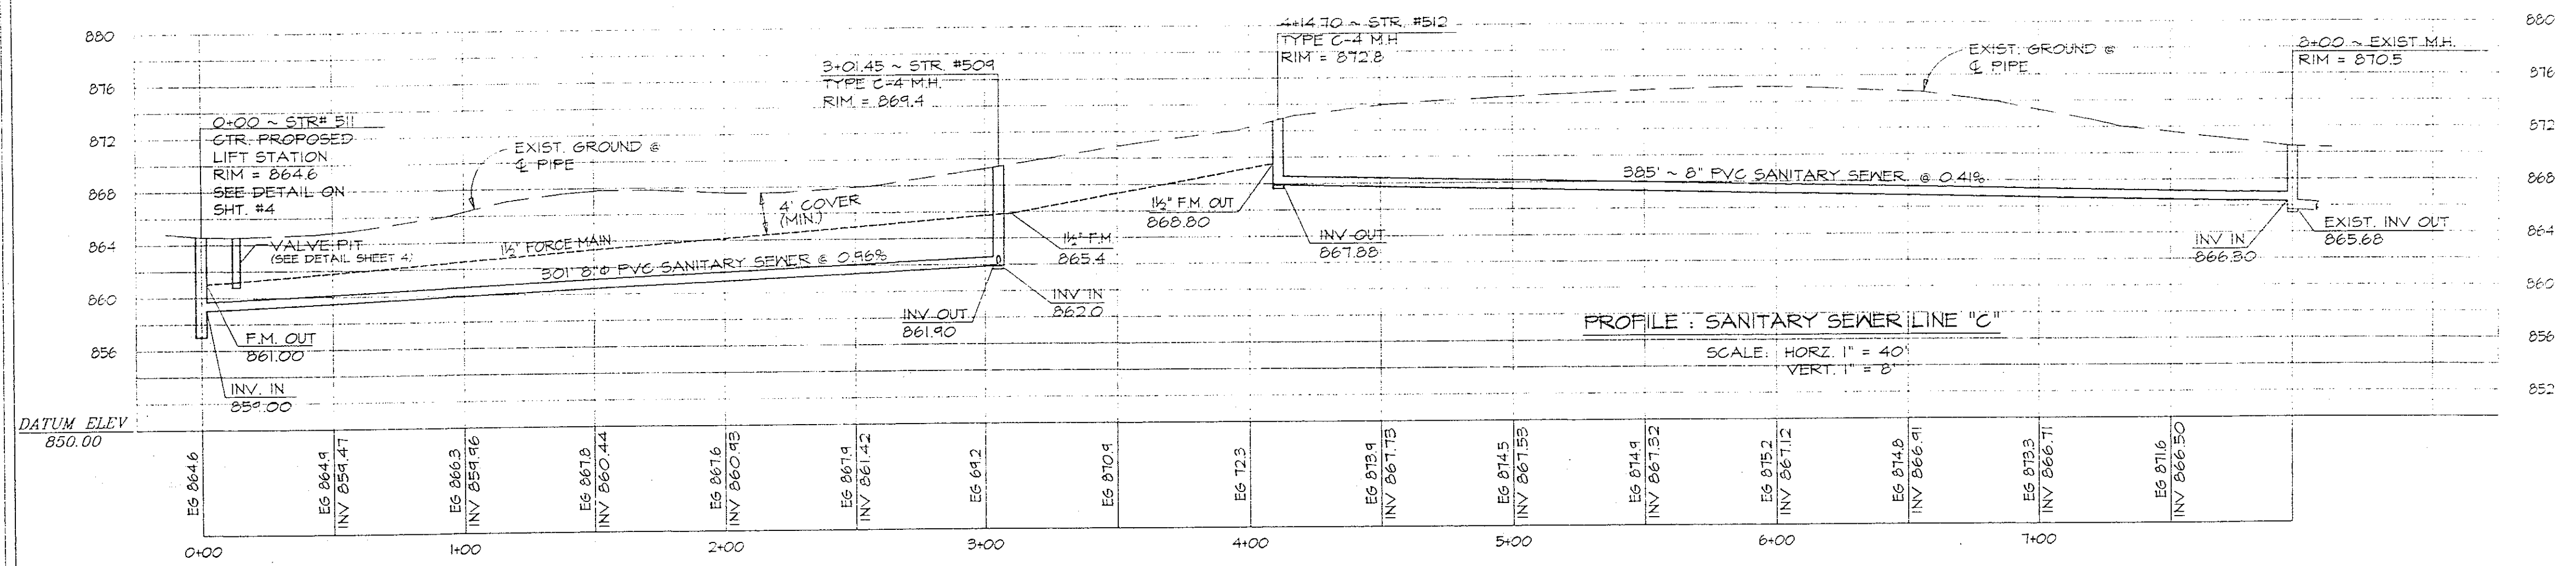

RAYL SURVEYING & ENGINEERING
1426 E. 53RD ST. SUITE 4
ANDERSON, INDIANA 46013
(317) 649-5614

SEWER PLAN

REVISIONS: 8-14-96 CHANGED STATIONING ALONG FORCE MAIN / CHANGED STR. #5 / CHANGED FORCE MAIN Ø (R.D.F.)
9-15-96 CHANGED FORCE MAIN Ø (R.D.F.)

**MYRENIA INMAN ADDITION
INGALLS, INDIANA**

DATE: JUNE 25, 1996
DRAWN BY: DAVID L. ELLIS

BY: *David L. Ellis*
DATE: 6-26-96

SHEET
3 OF 5

FILE: C:\MYRENIA\SEWER\SHS.DWG

PRINTED NOV 04 1996