



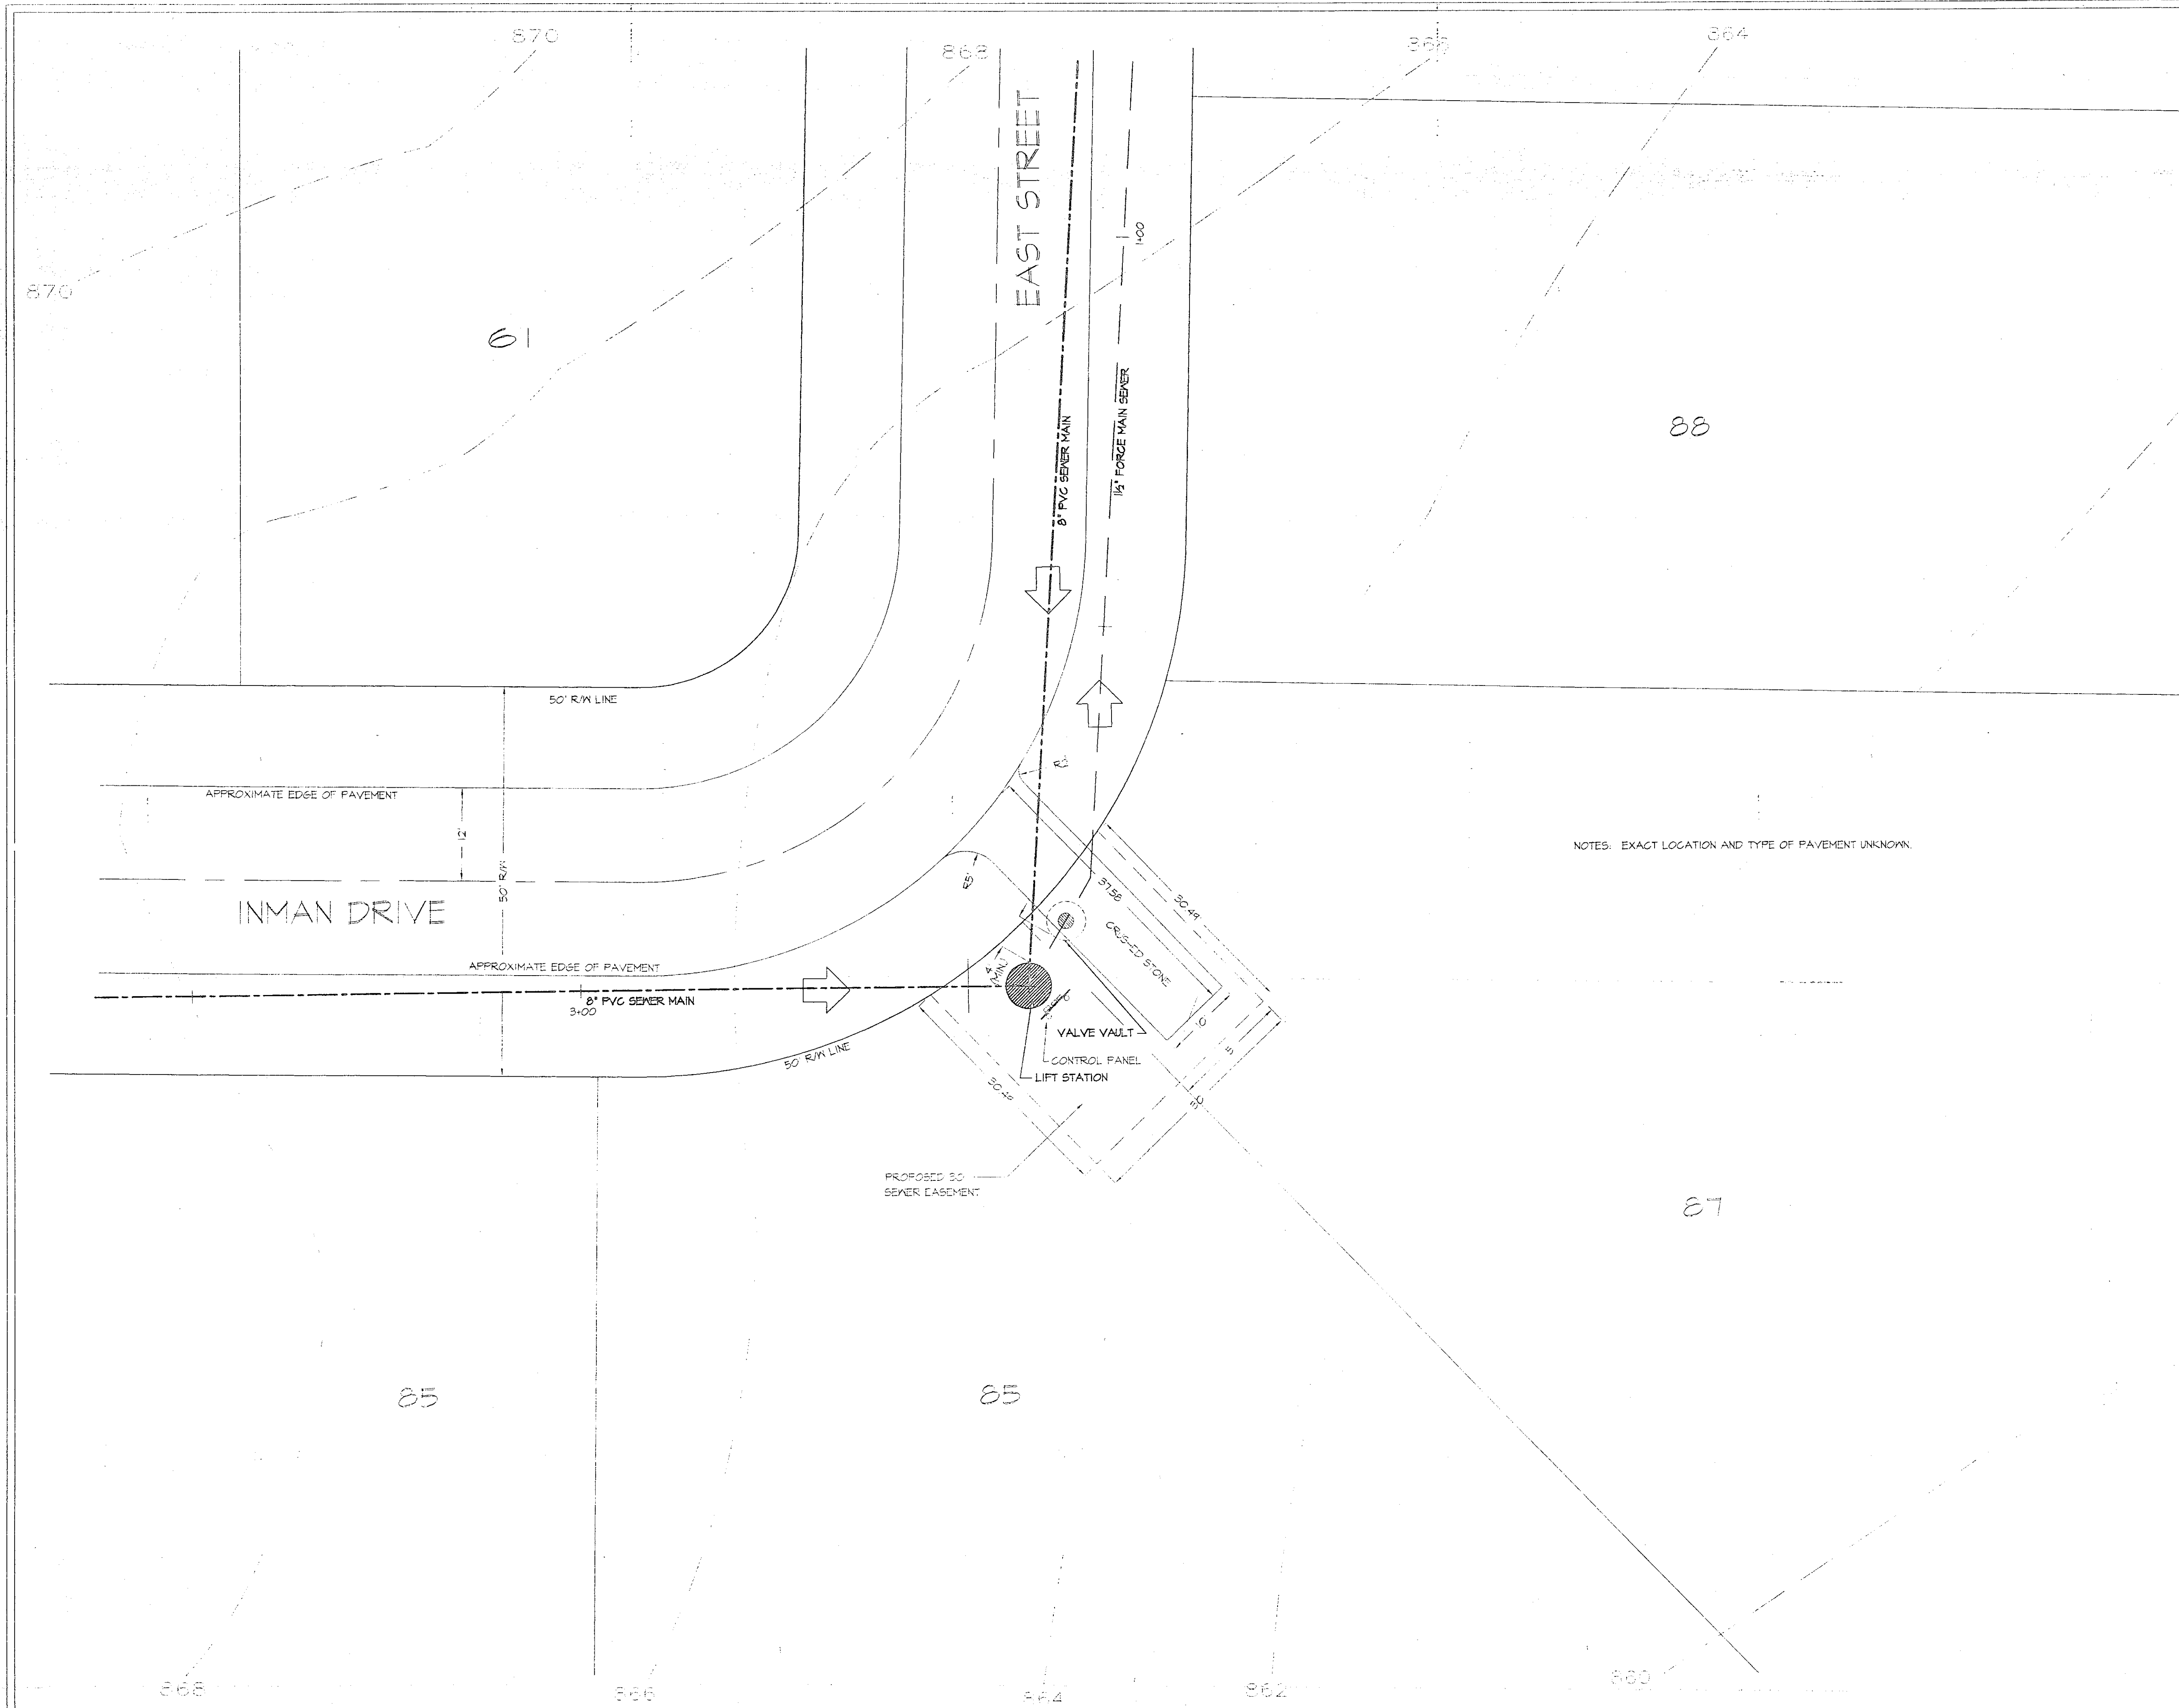

NOTES: EXACT LOCATION AND TYPE OF PAVEMENT UNKNOWN.

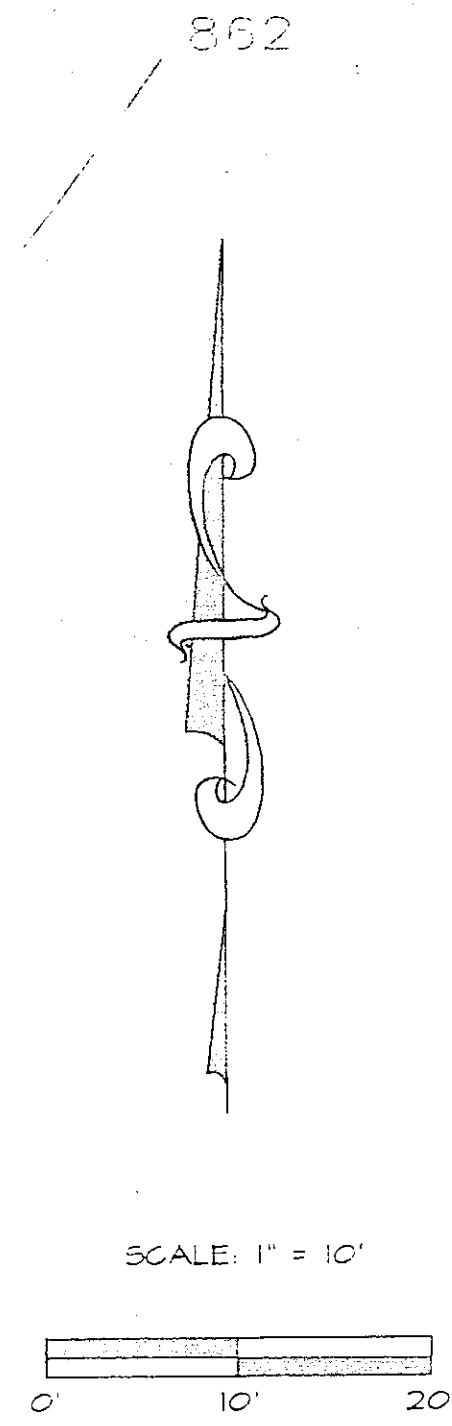

|                                            |                                                                                               |  |
|--------------------------------------------|-----------------------------------------------------------------------------------------------|--|
|                                            | RAY SURVEYING & ENGINEERING<br>1026 E. 33RD ST. SUITE 4<br>MARIETTA, GA 30067<br>404.477.1900 |  |
|                                            | LIFT STATION<br>SITE PLAN                                                                     |  |
| MYRENIA INMAN ADDITION<br>INGALLS, INDIANA |                                                                                               |  |
| DRAWN BY: RON D. FIELD<br>DATE: 6-26-96    |                                                                                               |  |
| SHEET<br>4 OF 5                            |                                                                                               |  |

FILE: C:\MYRENIA\SEWER\LIFTSTAD.DWG