


FINAL CONSTRUCTION PLANS
PENDLETON HEALTHPLEX AS-BUILT
PENDLETON, INDIANA



VICINITY MAP
NO SCALE

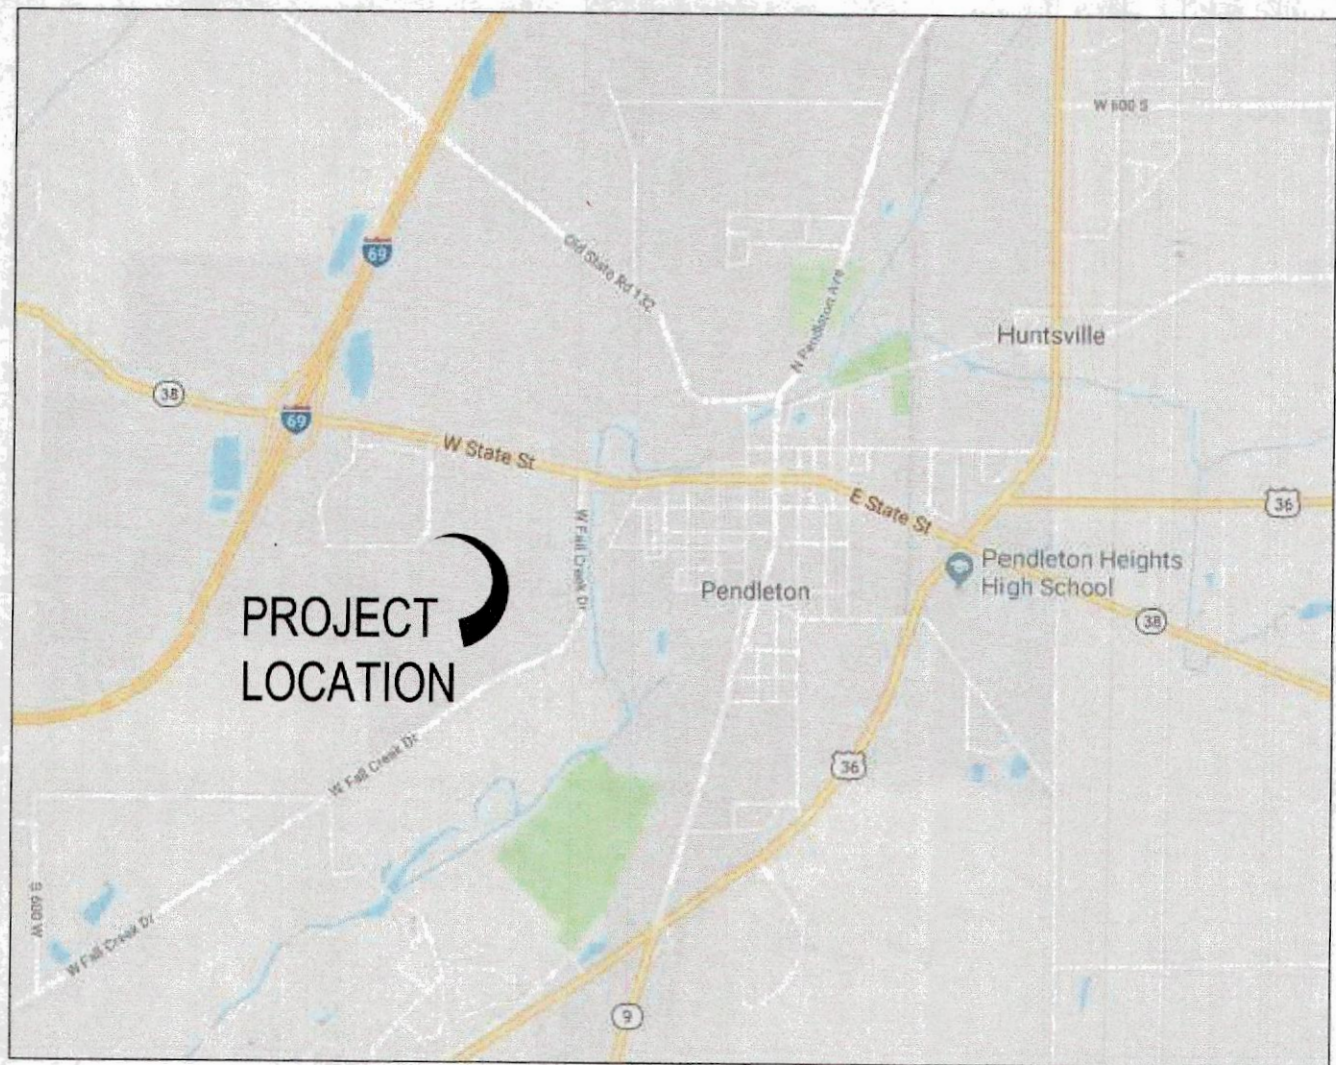

LOCATION MAP
NO SCALE

Table with 2 columns: SHEET # and SUBJECT. Lists various construction plan sheets including Title Sheet, Topographical Survey, Development Plan, Overall Site Dimension Plan, etc.


Professional engineer's title block containing: CROSSROAD ENGINEERS, PC logo; TITLE SHEET; PENDLETON HEALTHPLEX; JOB No. 1030059; DATE: SEPTEMBER 10, 2018; SHEET 100.

DEVELOPER
KLIPSCH-CARD ATHLETIC FACILITIES, LLC
200 E. 186TH STREET, STE A
WESTFIELD, IN 46074
PHONE: (317) 763-1503
CONTACT: ANDY CARD
EMAIL: acard@pacersac.com

OWNER
TOWN OF PENDLETON REDEVELOPMENT COMMISSION
119 W. STATE STREET
PENDLETON, IN 46064
PHONE: (765) 778-7776
CONTACT: TIM McCLINTICK
EMAIL: timcclintick@town.pendleton.in.us

ENGINEER
CROSSROAD ENGINEERS, PC
3417 SHERMAN DRIVE
BEECH GROVE, IN 46107
PHONE: (317) 780-1555
CONTACT: GREGORY J. ILKO
EMAIL: gilko@crossroadengineers.com

CONTRACTOR
LAUTH GROUP, INC.
111 CONGRESSIONAL BLVD., STE 300
CARMEL, IN 46032
PHONE: (317) 964-9507
CONTACT: MATT CHILDRESS
EMAIL: mchildress@lauth.net

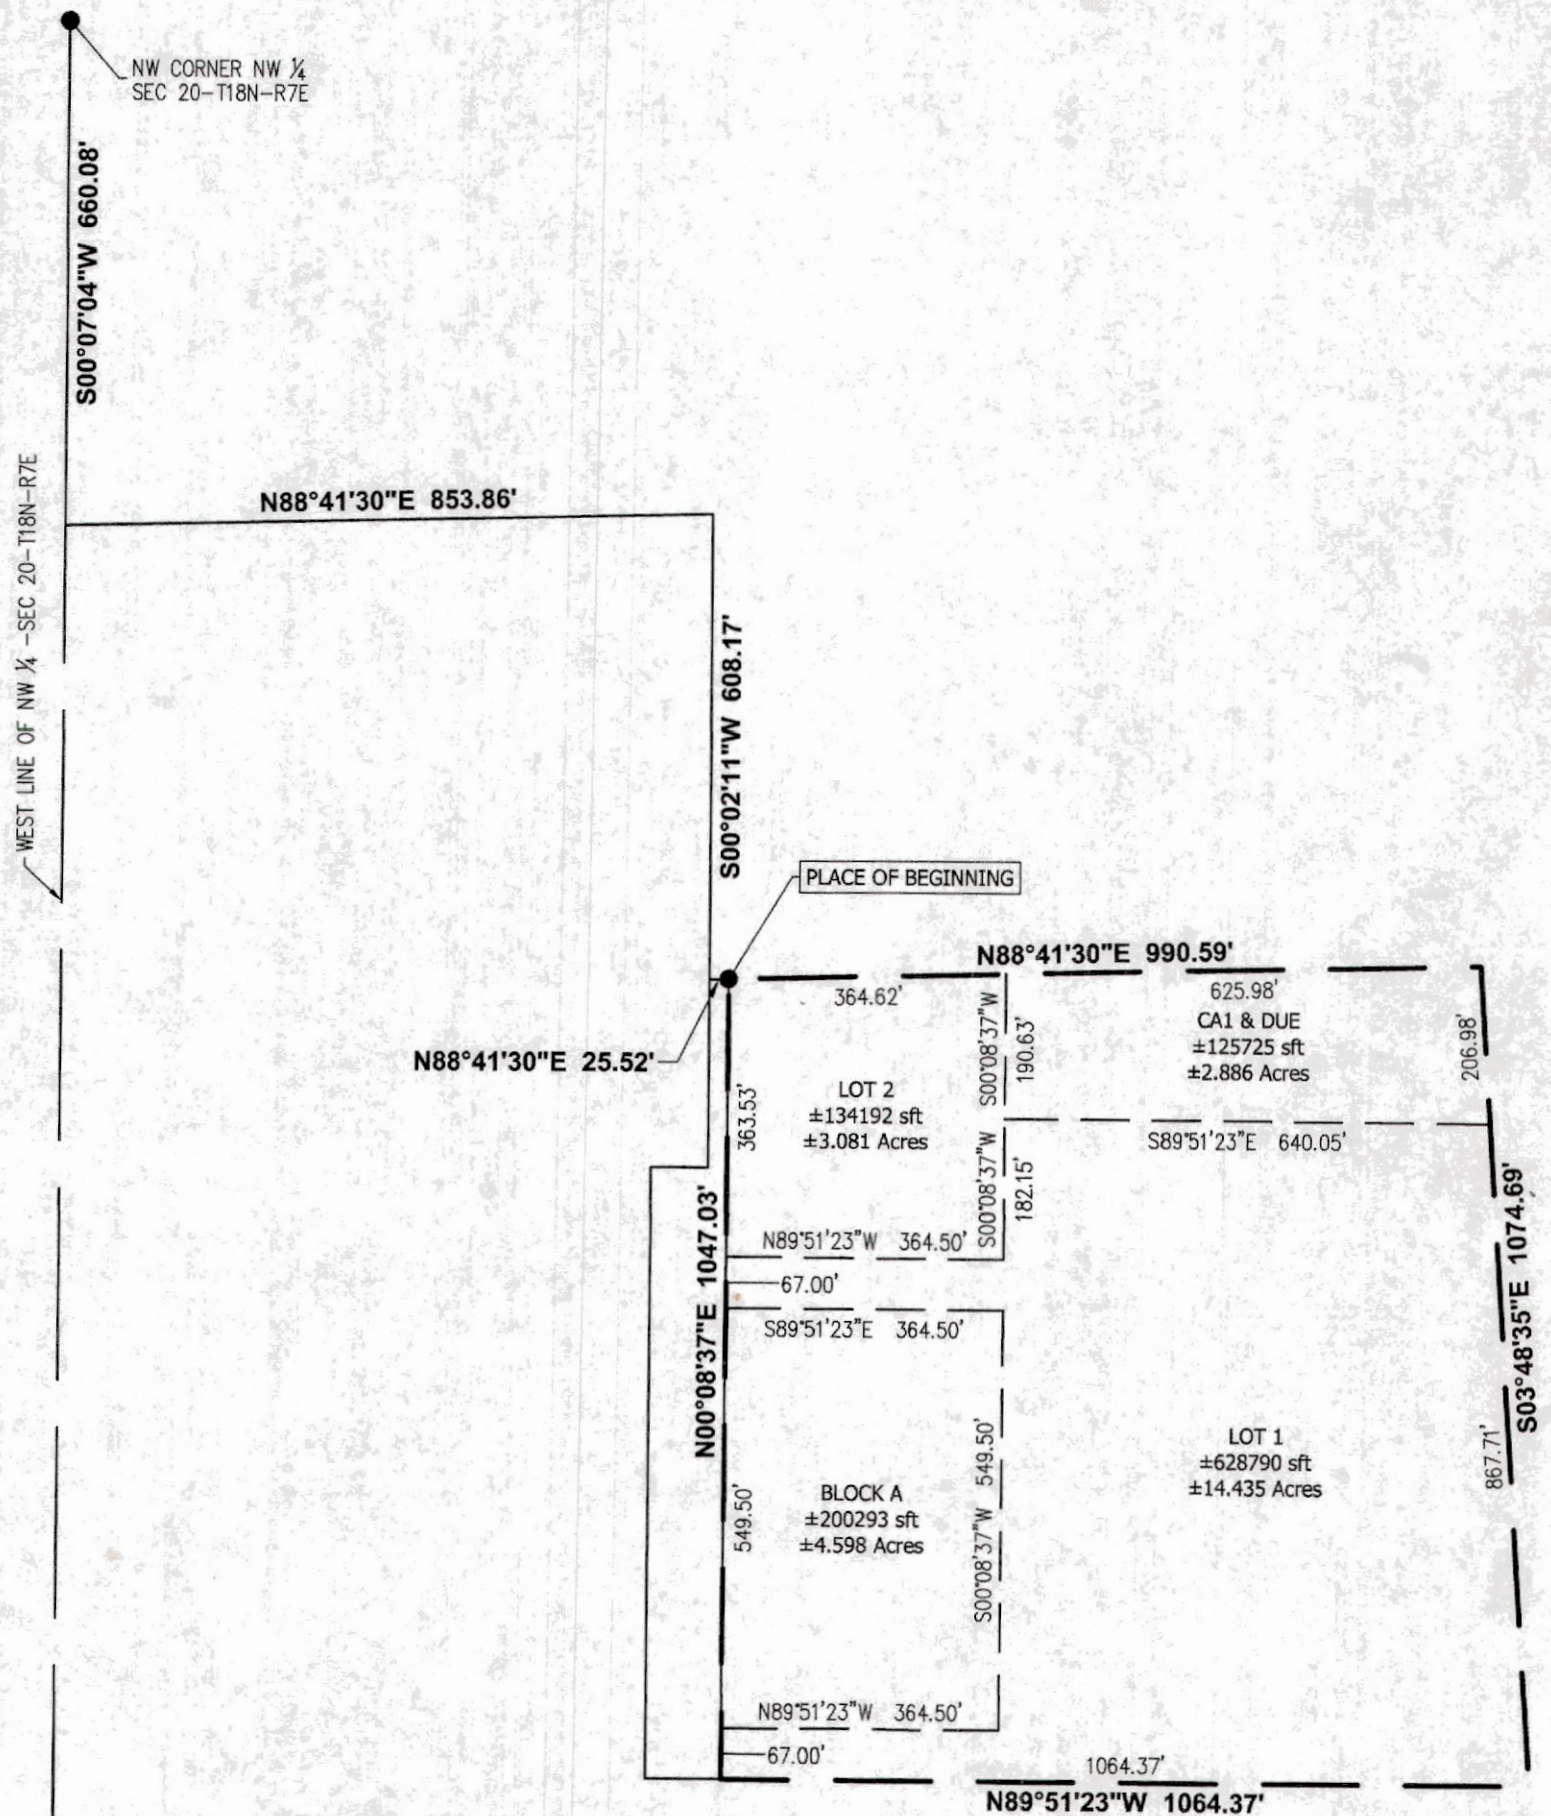

DIRECTORY PATH : R:\Active\Laith\Pendleton Wellness Center Design\CAD\Plans
DATE USER : 10/2/2019 1:27 PM : D:\cyl