
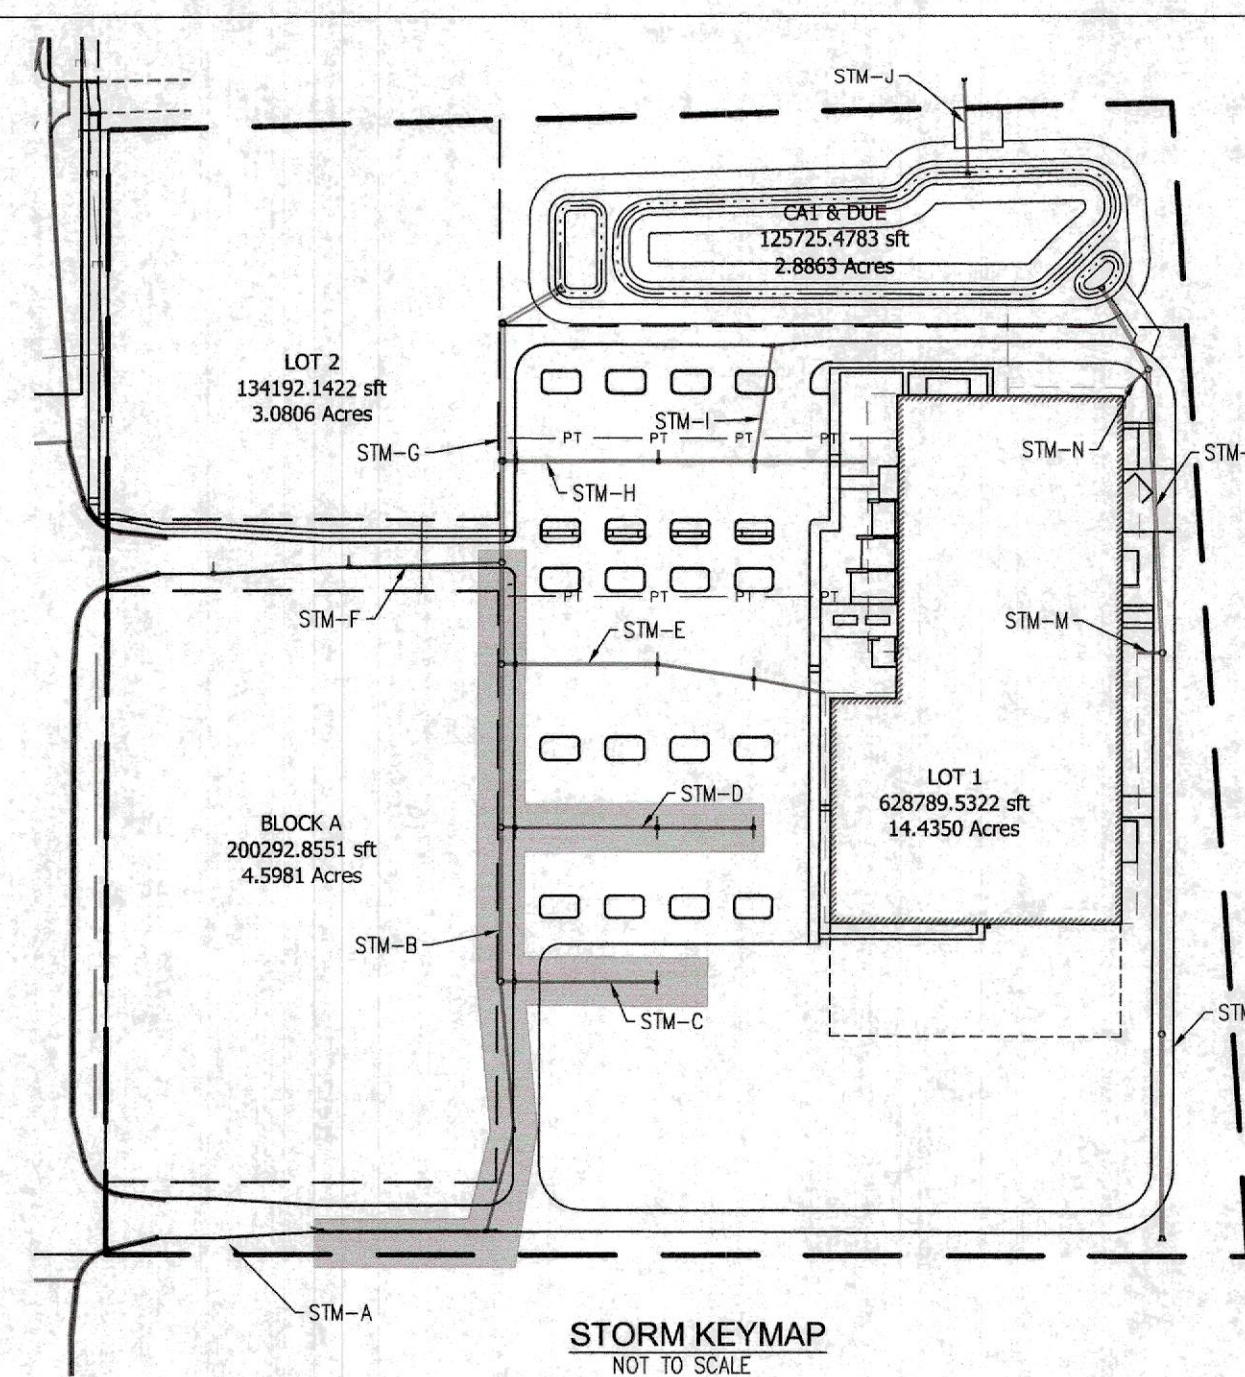
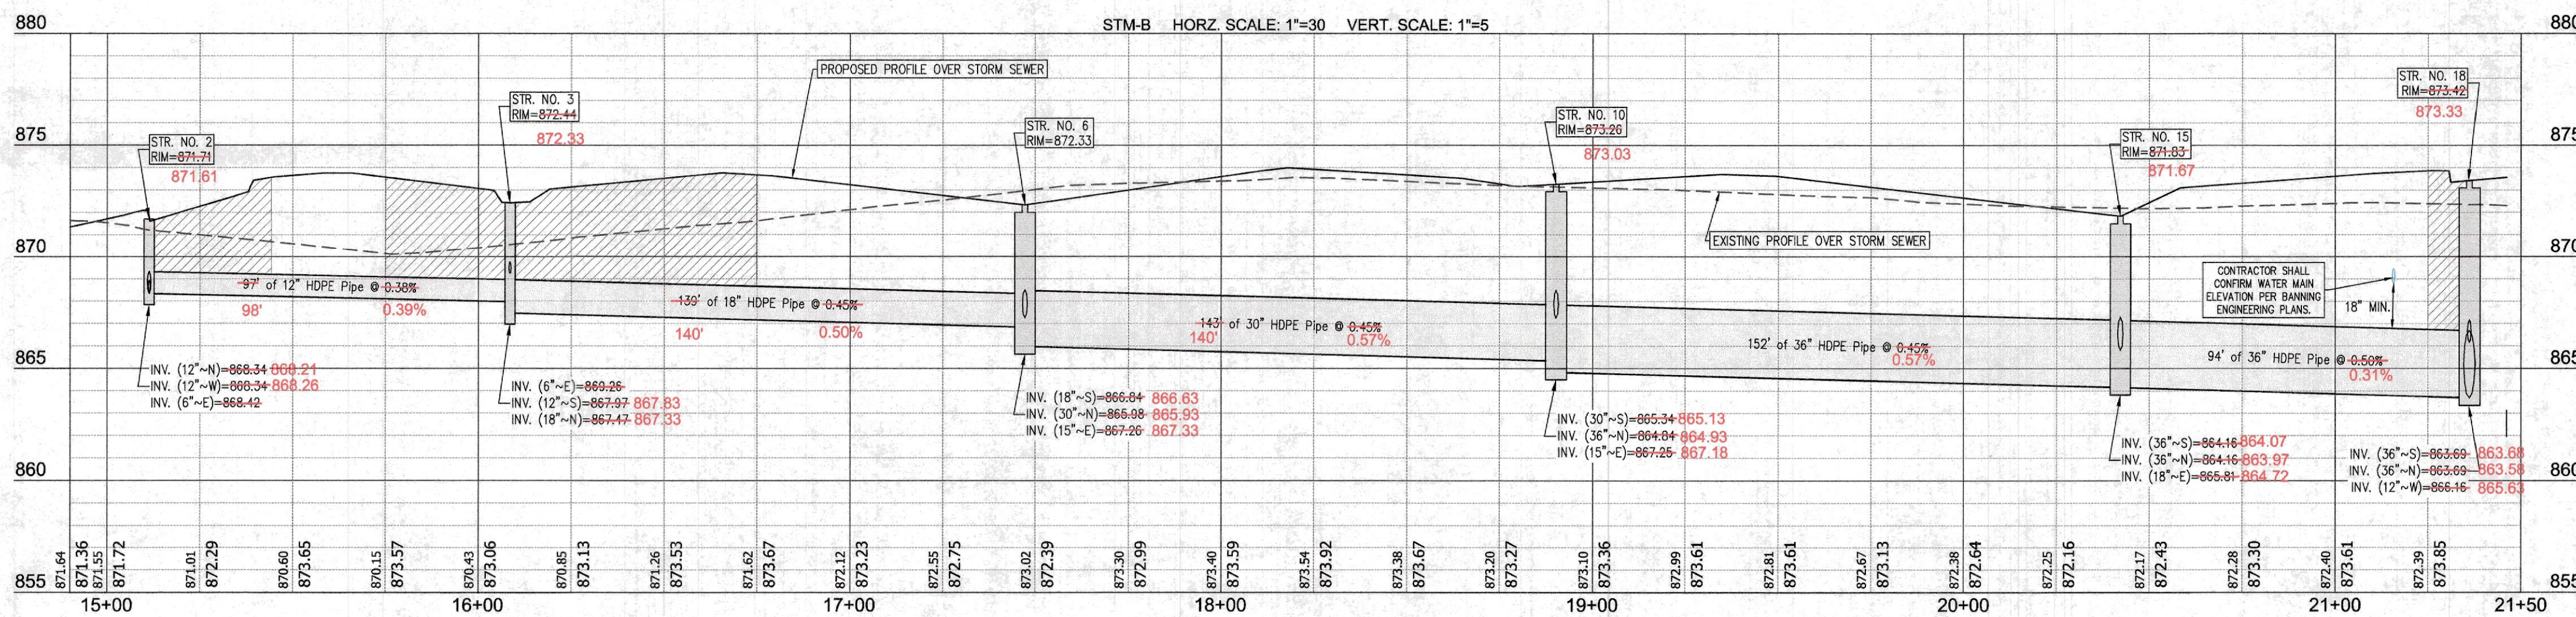
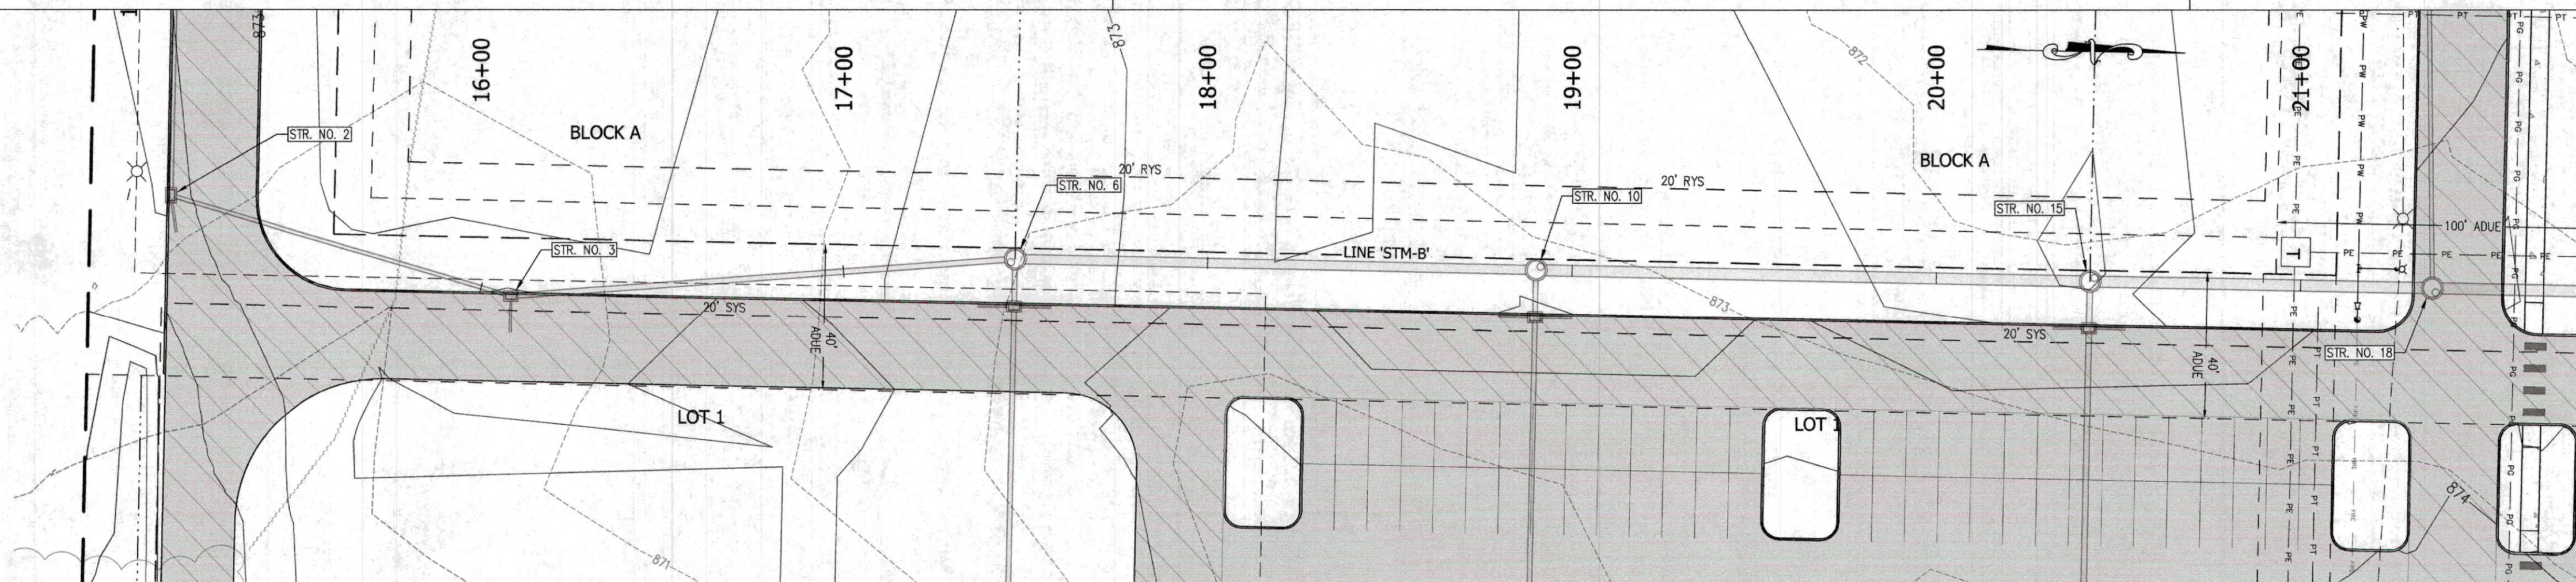
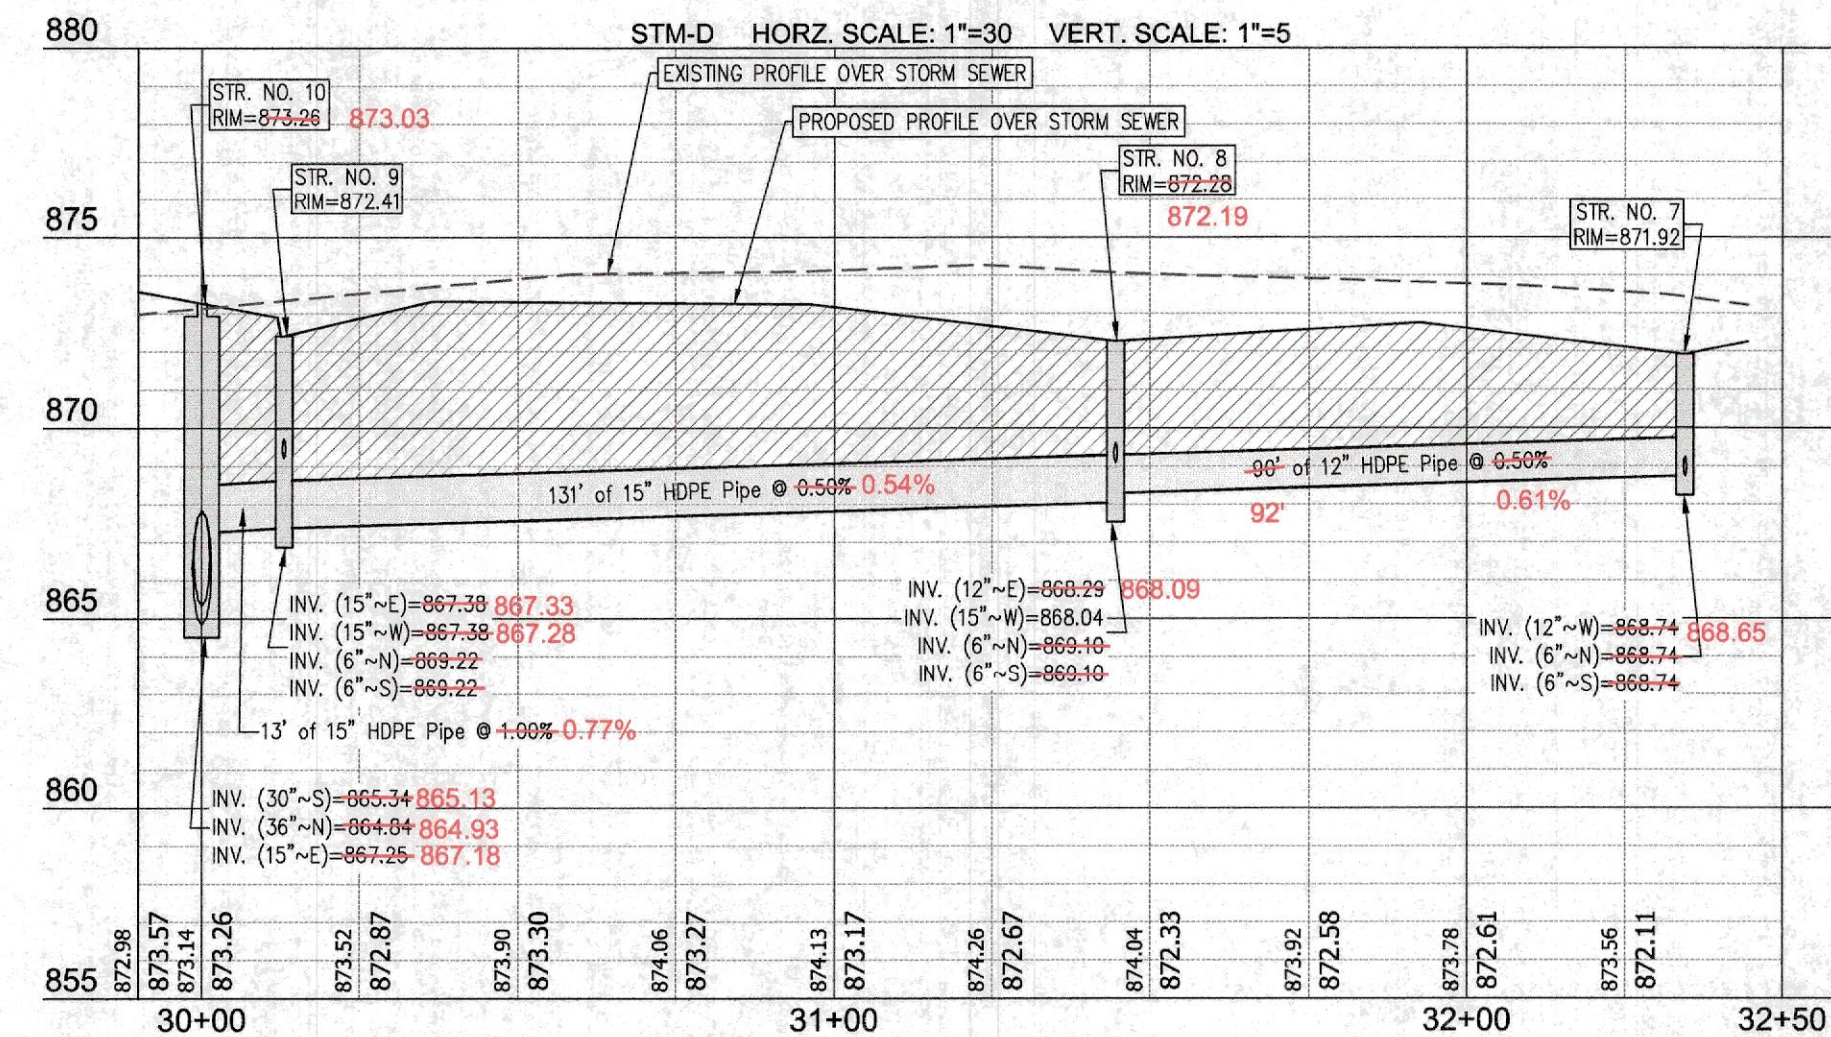
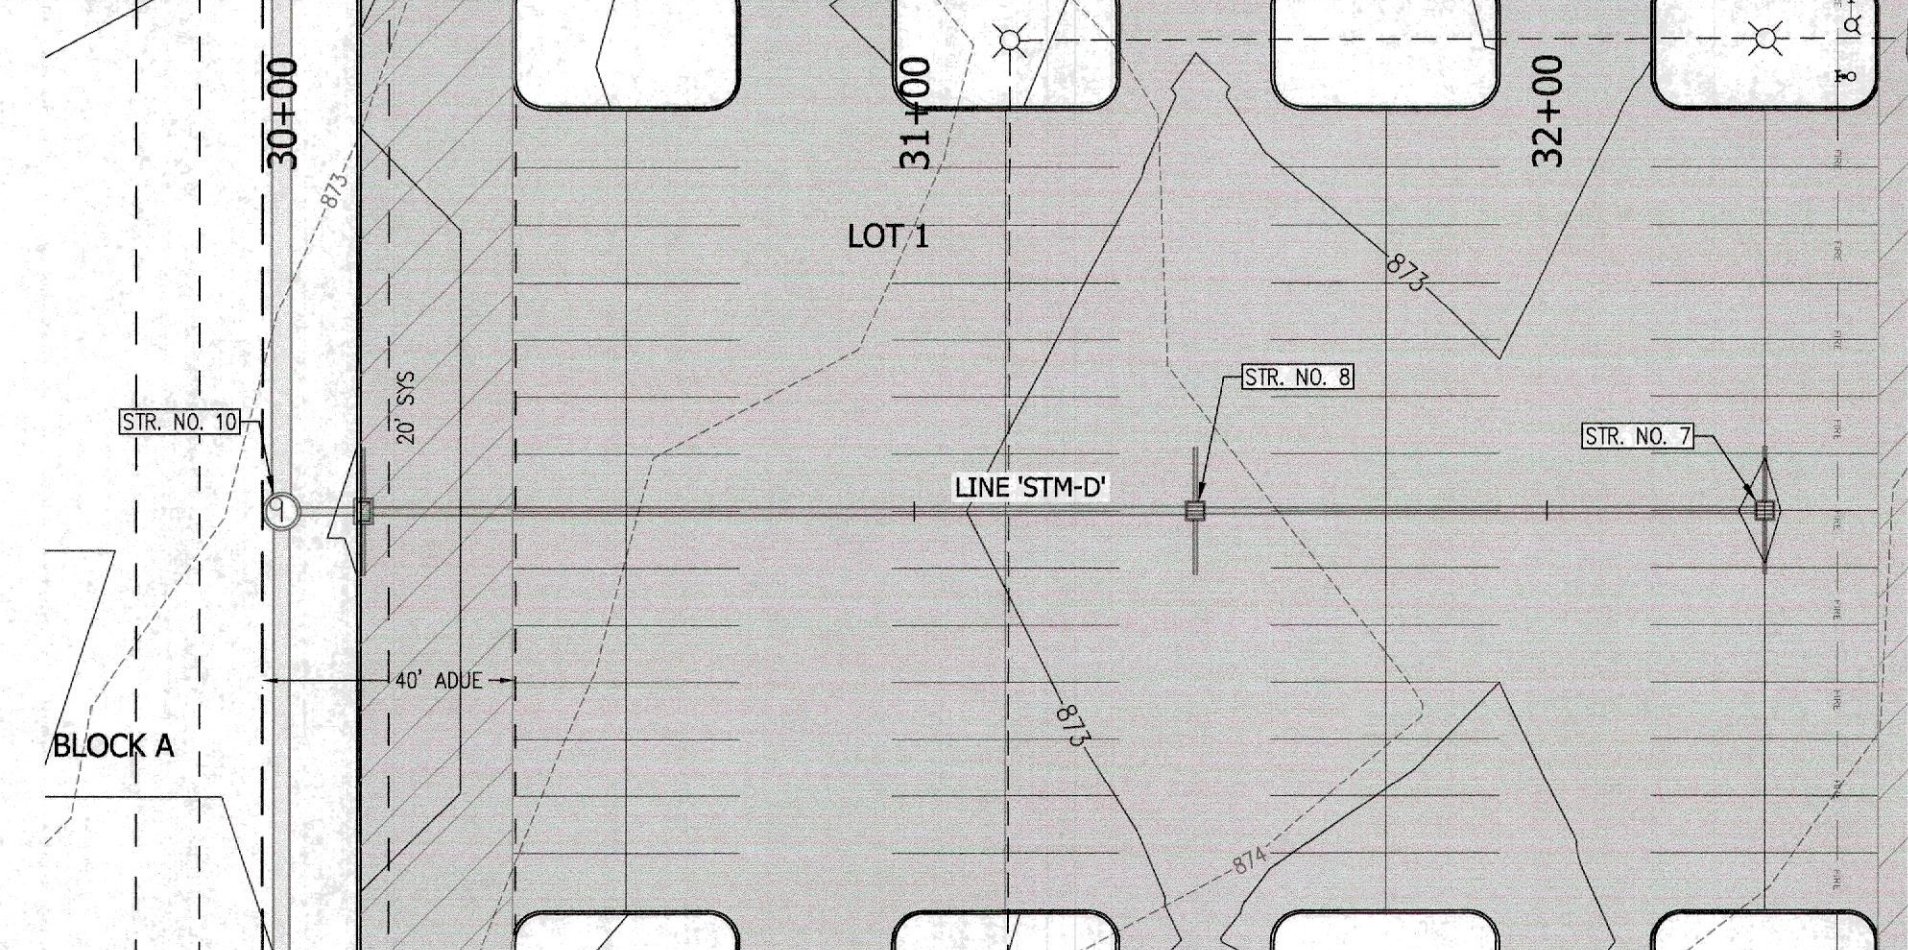
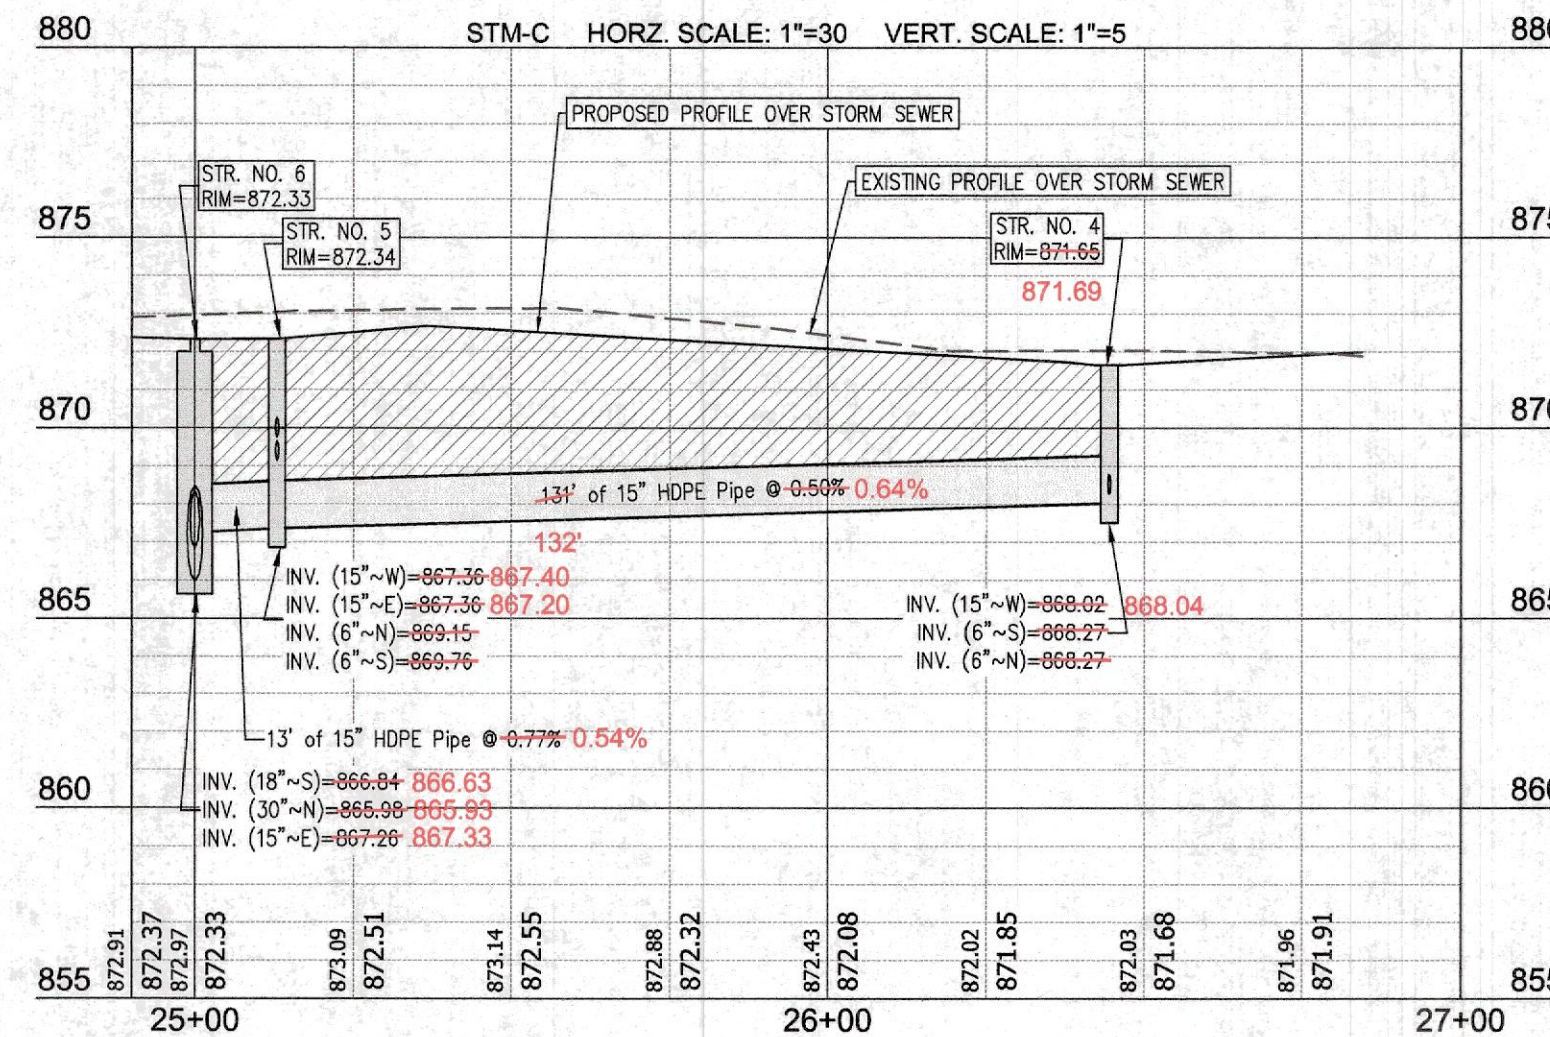
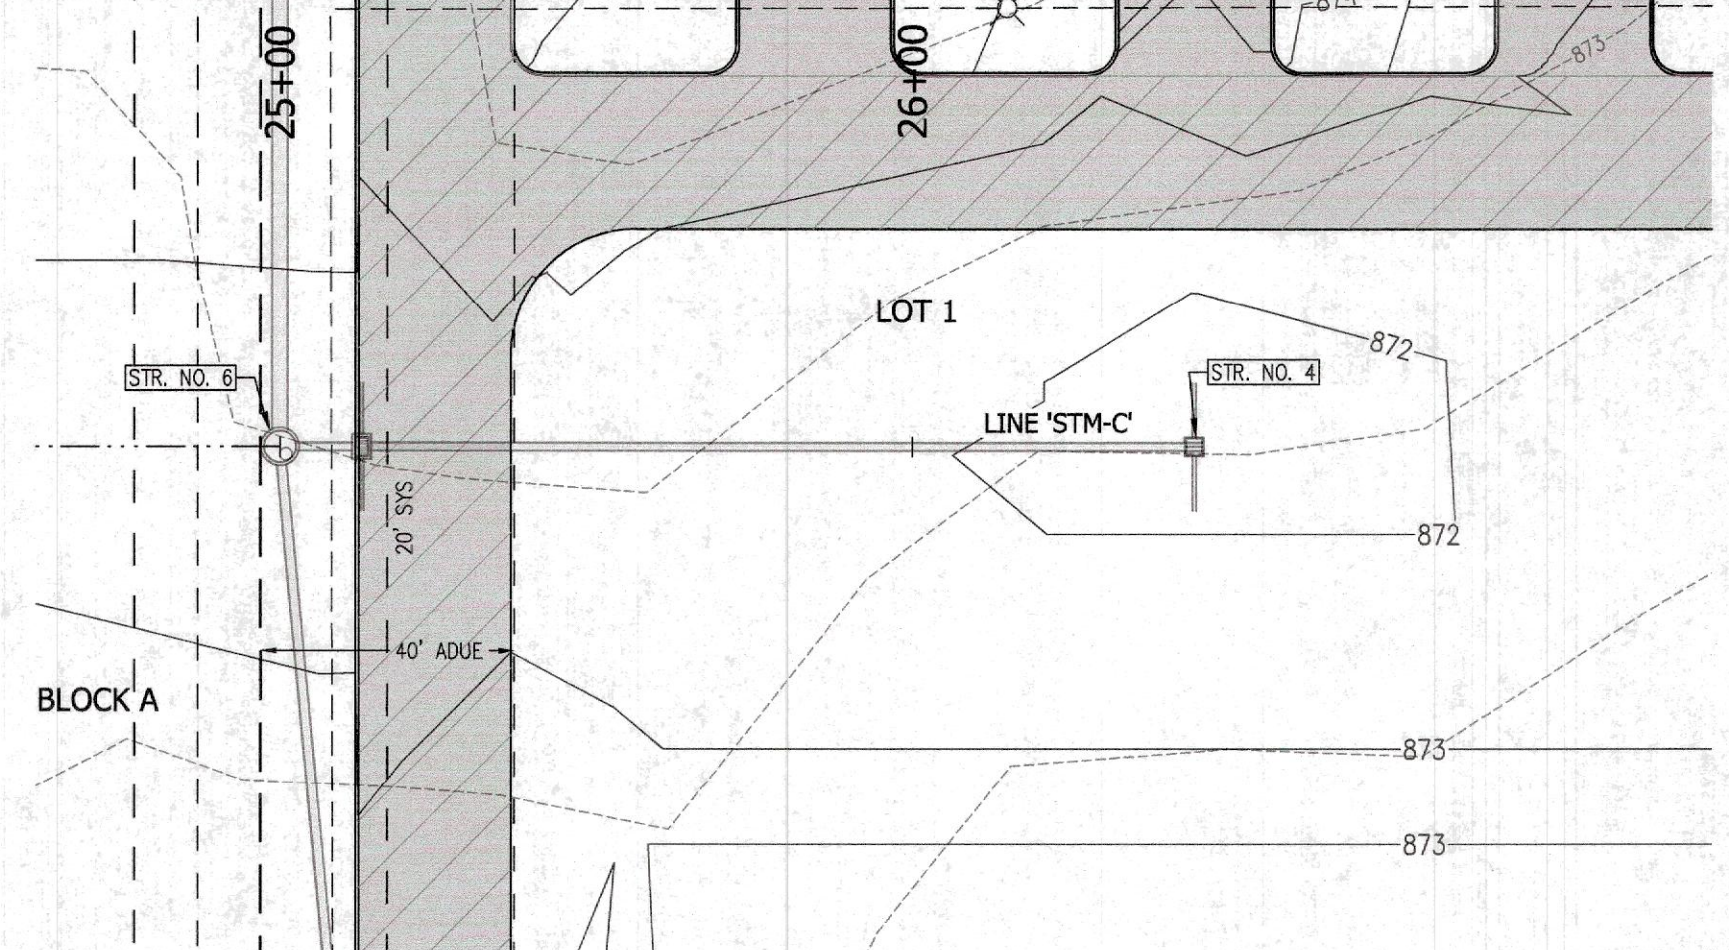
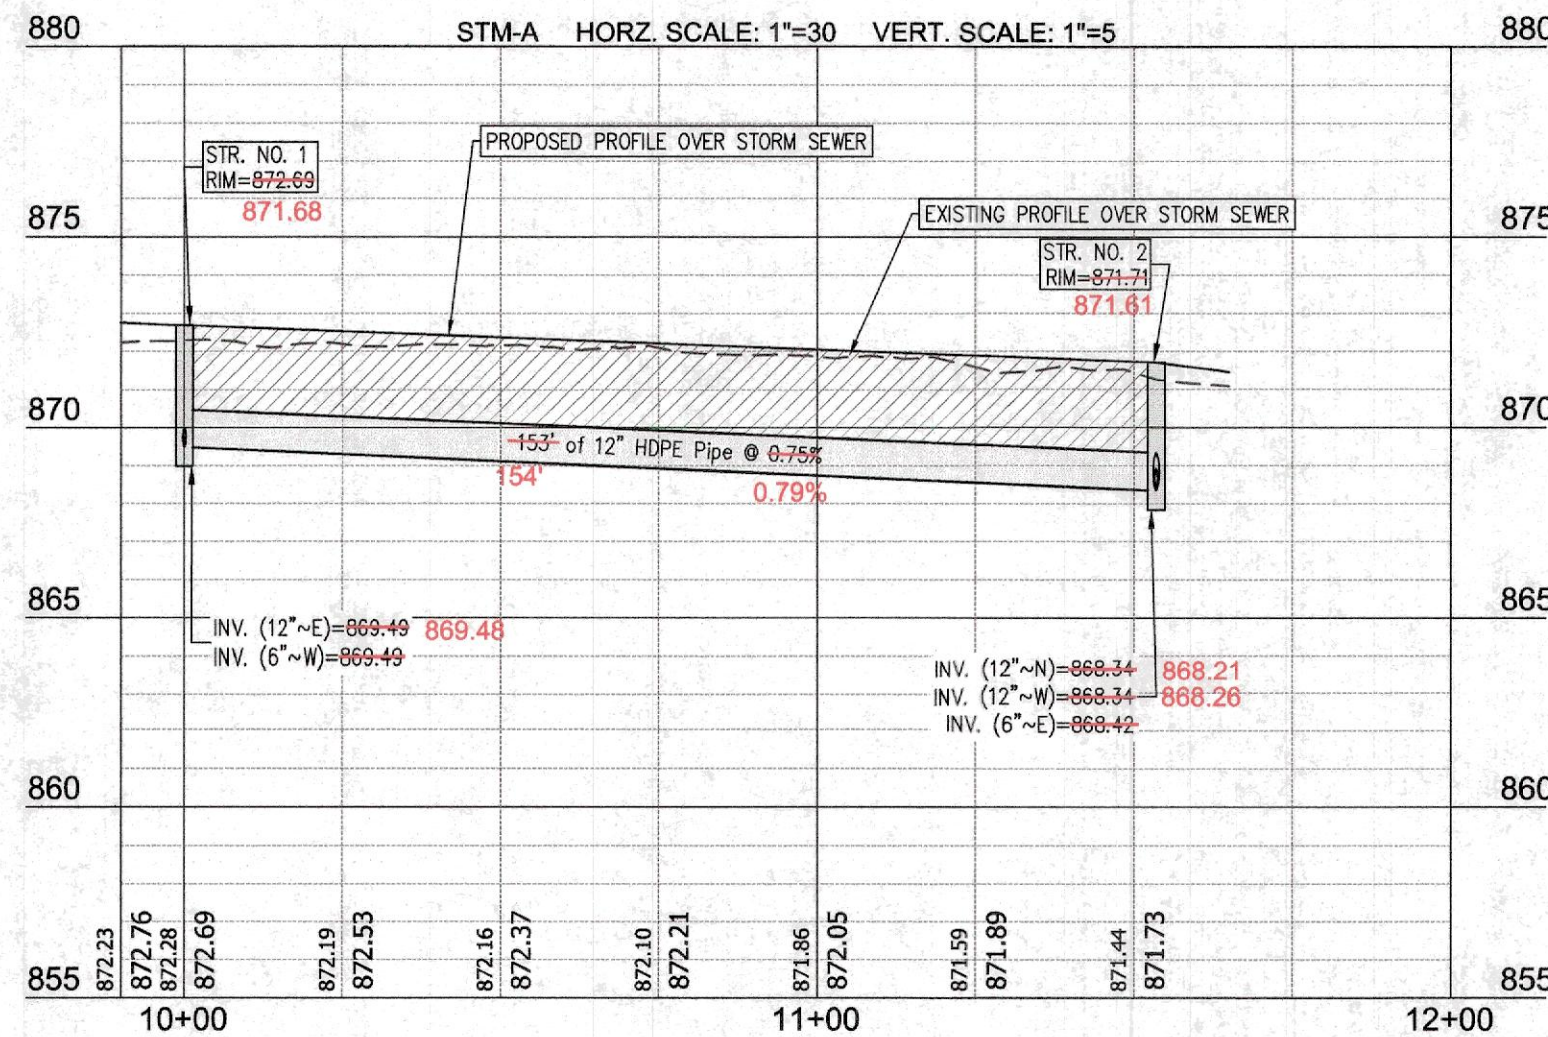


NOTE:
NO EARTHWORK
DISTURBING ACTIVITY
MAY COMMENCE UNTIL
A STORM WATER
MANAGEMENT PERMIT
IS OBTAINED.

EXISTING UTILITY SIZE AND MATERIAL INFORMATION SHOWN ON THESE PLANS
ARE PER THE BEST GRAPHICAL AND VISIBLE INFORMATION AVAILABLE.
CONFLICTS MAY EXIST AND IT SHALL BE THE CONTRACTOR'S RESPONSIBILITY
TO FIELD VERIFY ALL SIZING AND MATERIAL INFORMATION PROVIDED. IF
ACTUAL CONDITIONS DIFFER FROM THAT INFORMATION SHOWN ON THE
PLANS, THE CONTRACTOR SHALL, PRIOR TO THE INSTALLATION OF ANY
PROPOSED INFRASTRUCTURE, NOTIFY THE DESIGN ENGINEER IMMEDIATELY.

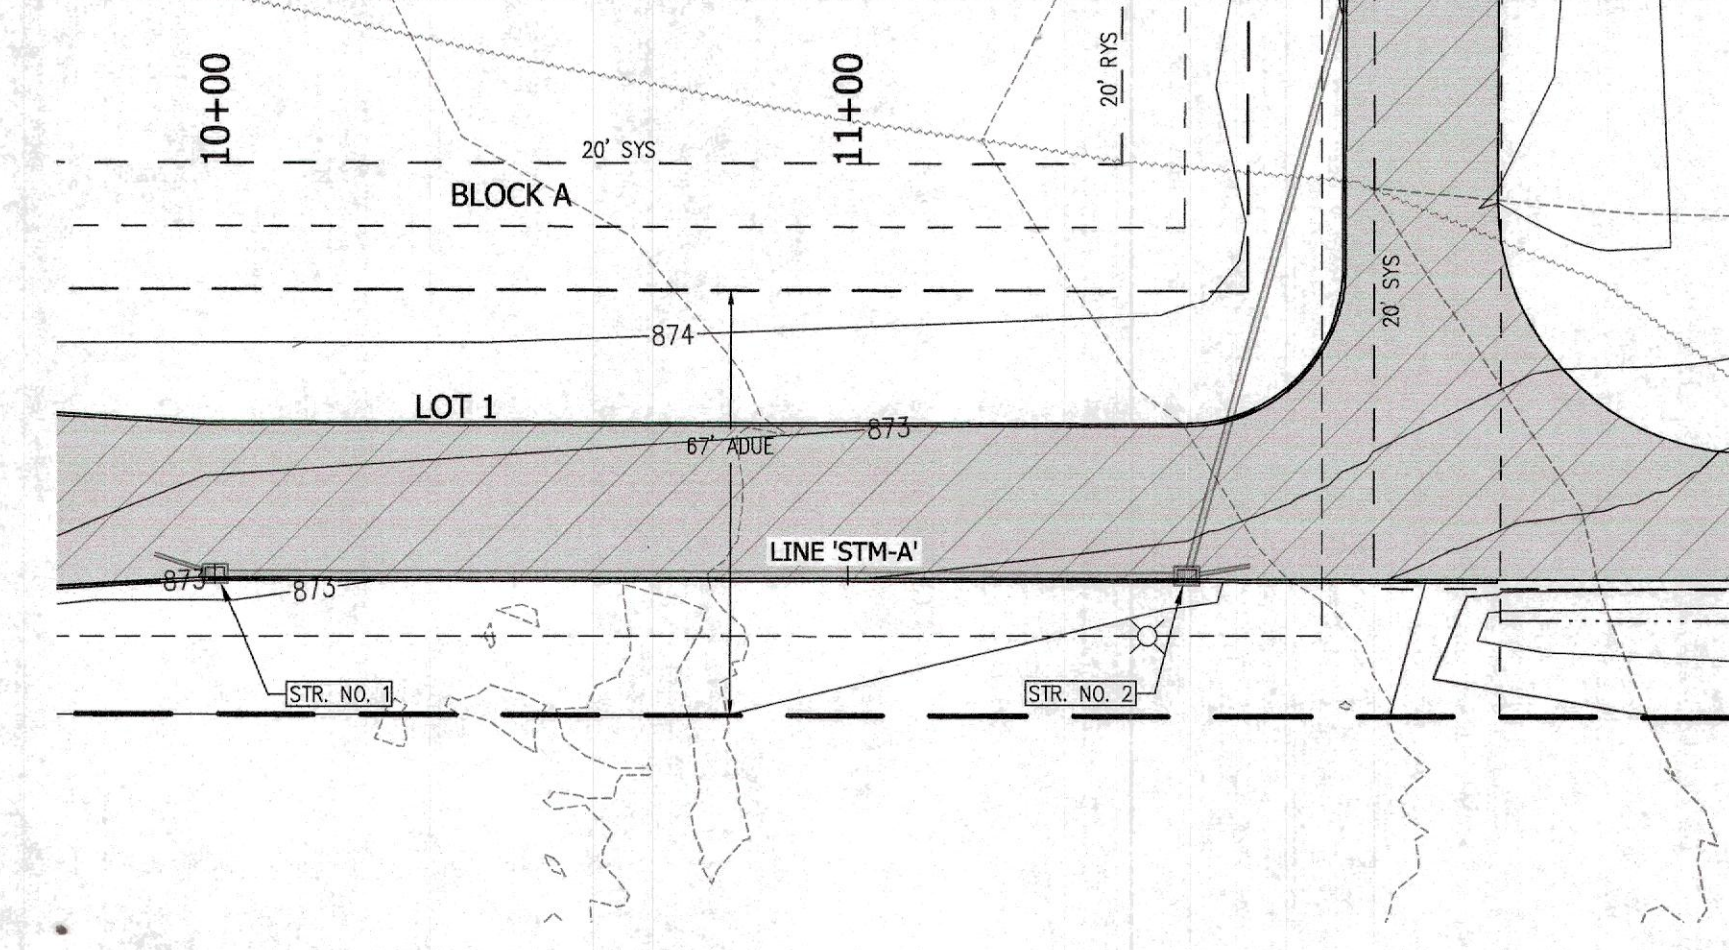

STORM PLAN AND PROFILE

PENDLETON HEALTHPLEX

JOB NO.	DRAWN	CHECKED	IN	DATE	DESIGNED	DMS	CJ	SHEET
1200008				SEPTEMBER 10, 2018				700



NO.	DATE	REVISIONS
1	09/20/18	REVISIONS PER INTERNAL AND OWNER REVIEWS
2	10/01/18	REVISIONS TO SANITARY SEWER PER F.C.R.M.D. COMMENTS
3	10/01/18	REVISIONS PER TOWN OF PENDLETON AND MAUSON CO. DRAINAGE BOARD (BANNING ENG.) REVIEWS
4	11/20/18	ADDED SANITARY LATERAL STUDS FOR FUTURE CONNECTIONS AT LOT #2 AND BLOCK A
5	12/01/18	RAISED ENTIRE PROJECT (TOPOGRAPHIC SURVEY AND PROPOSED IMPROVEMENTS) 0.38' FOR VERTICAL DATUM CORRECTION
7	02/12/19	REVISED TO INCLUDE KOP-N-SEAL FLEXIBLE BOOT CONNECTION TO SANITARY MAIN STR. # SS-1 & ASPHALT PATH. SECTION PER TOWN REQUIREMENTS
8	06/05/19	REVISIONS PER CLIENT & TOWN OF PENDLETON COORDINATION