

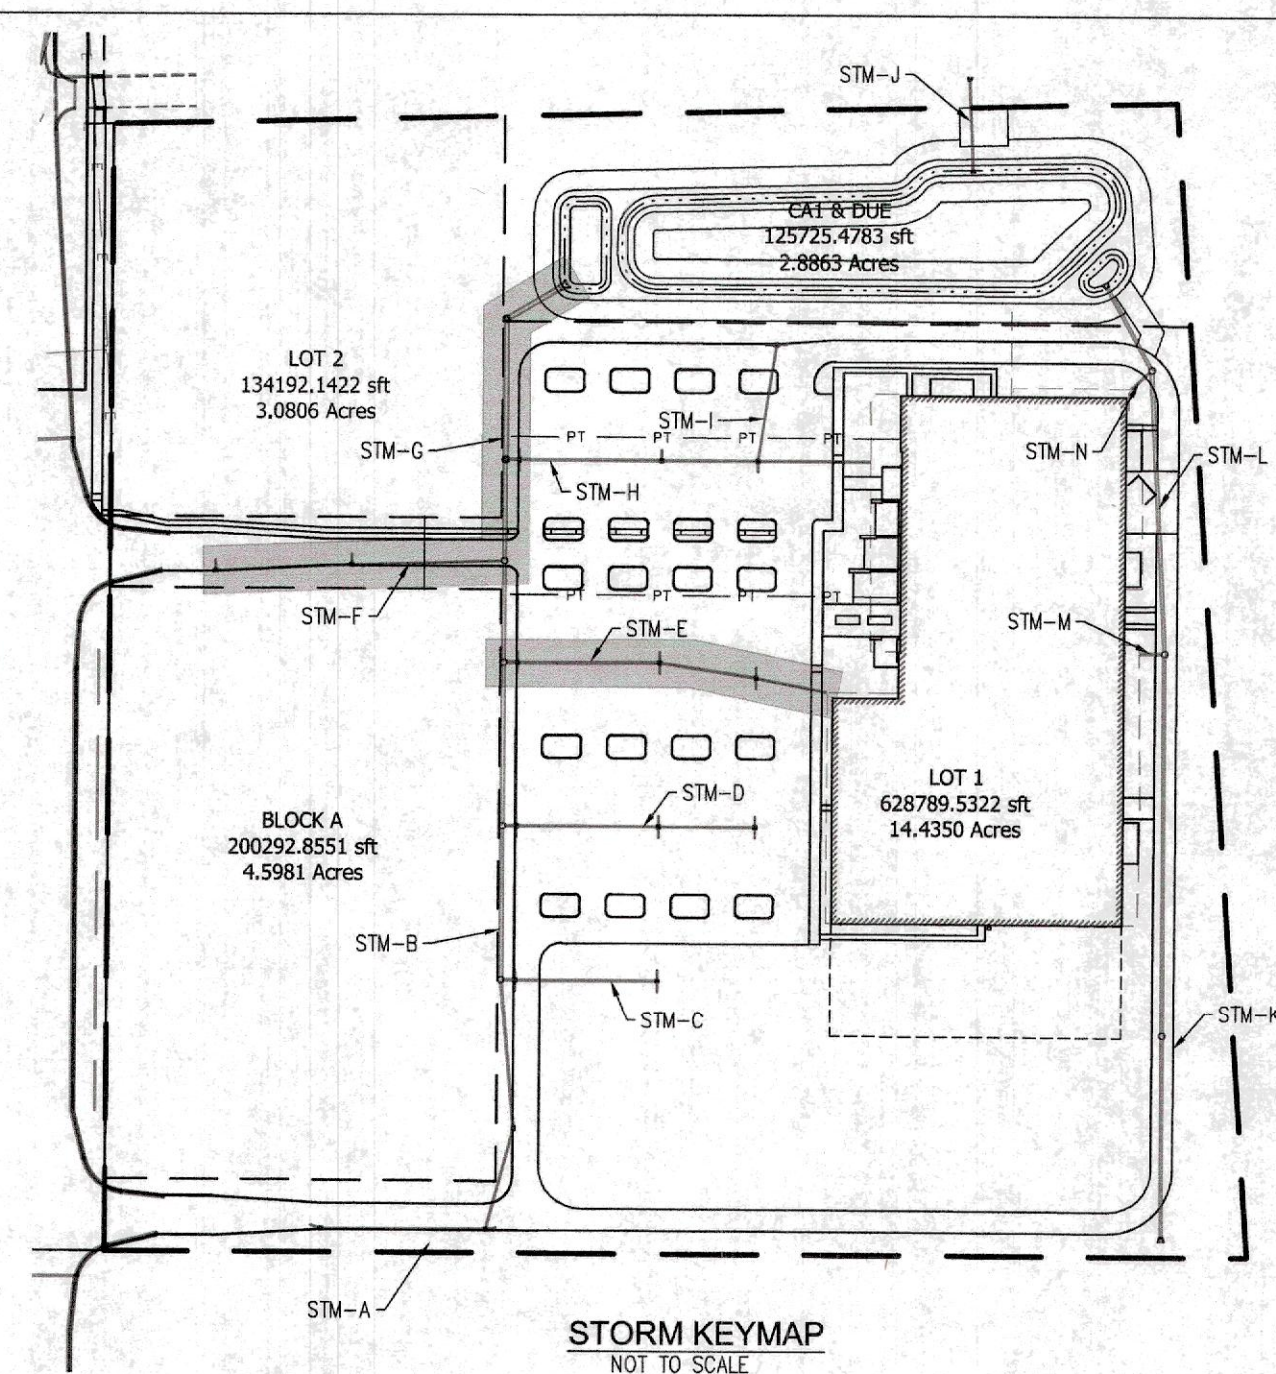
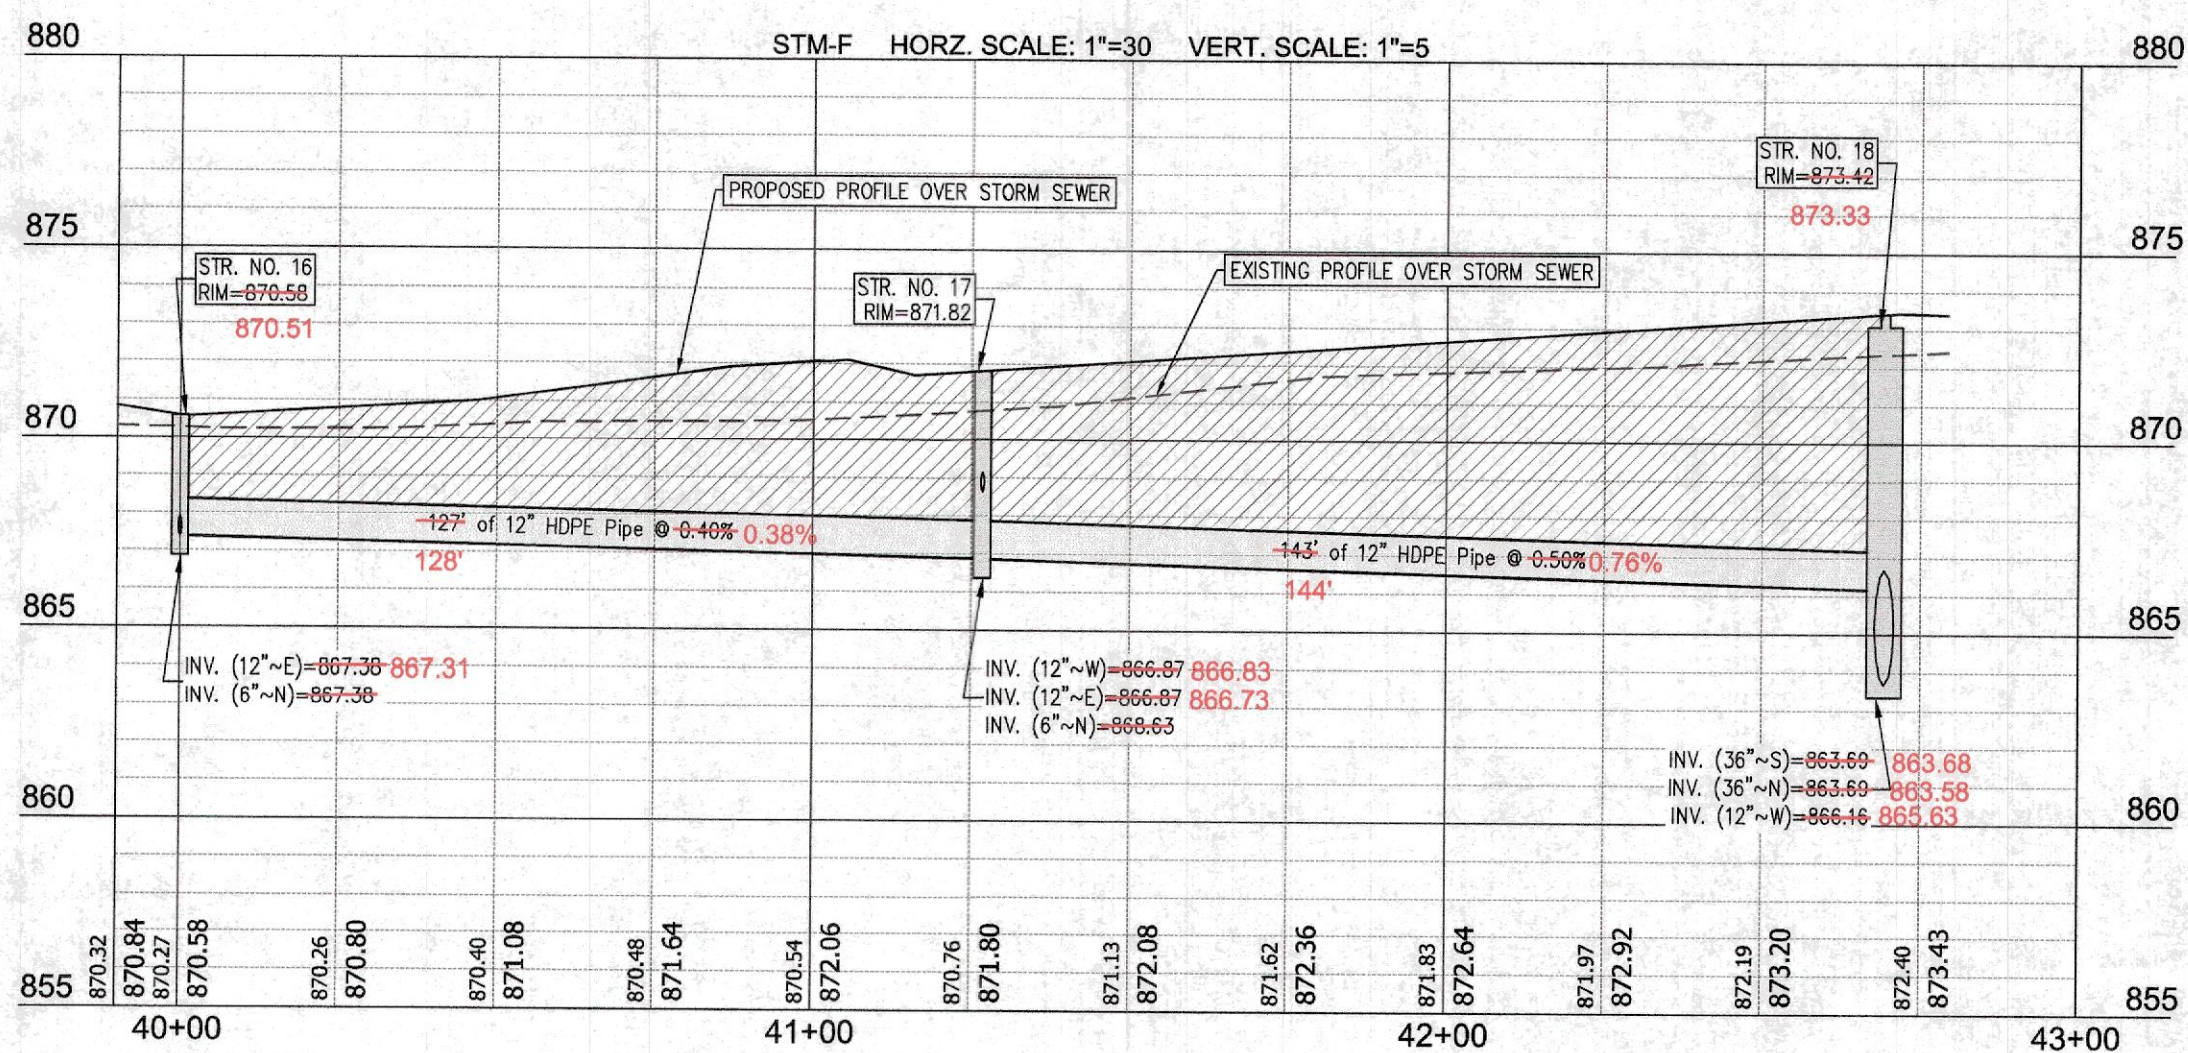


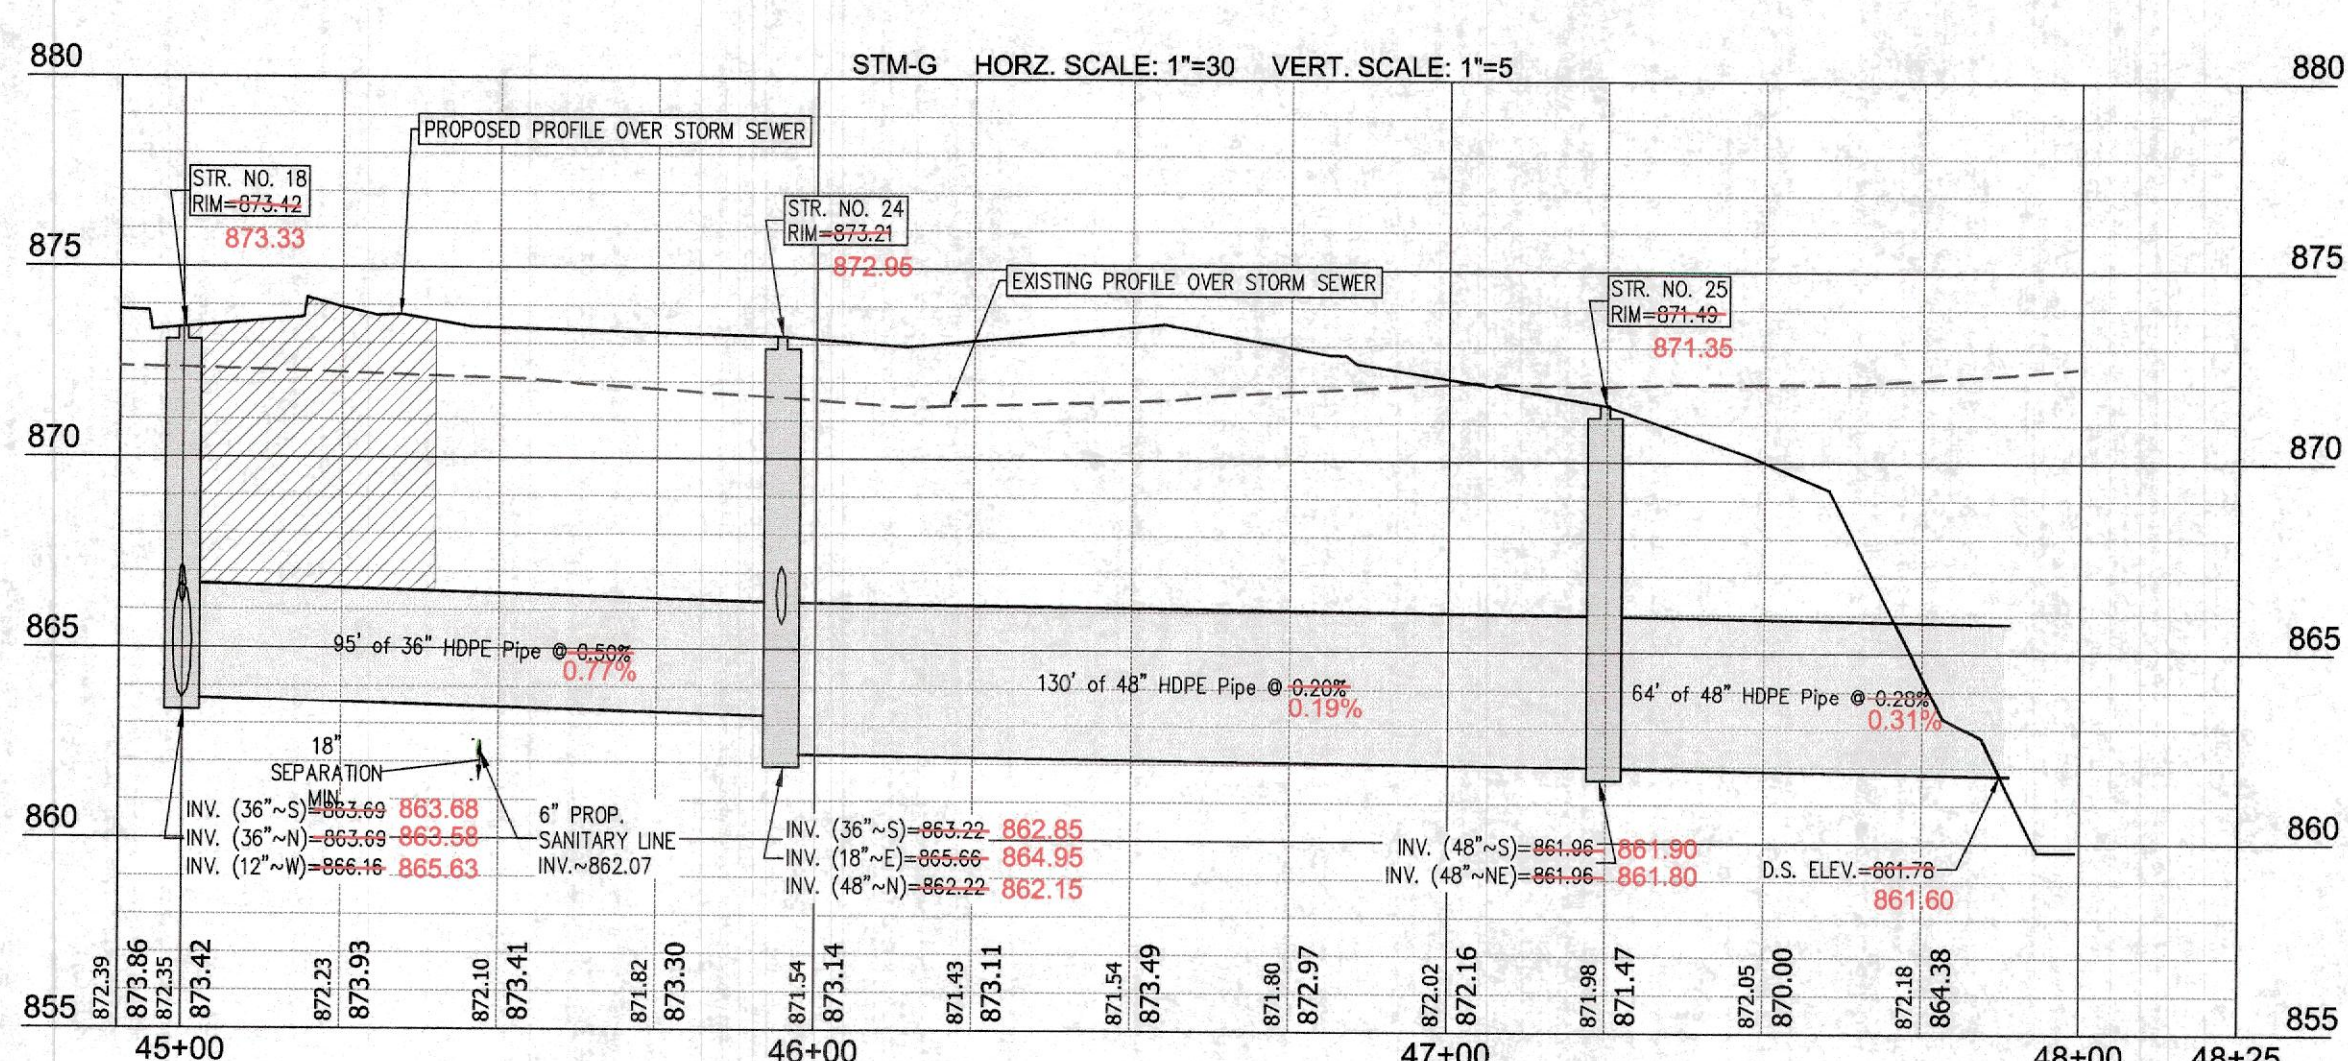


EXISTING UTILITY SIZE AND MATERIAL INFORMATION SHOWN ON THESE PLANS ARE PER THE BEST GRAPHICAL AND VISIBLE INFORMATION AVAILABLE. CONFLICTS MAY EXIST AND IT SHALL BE THE CONTRACTOR'S RESPONSIBILITY TO FIELD VERIFY ALL SIZING AND MATERIAL INFORMATION PROVIDED. IF ACTUAL CONDITIONS DIFFER FROM THAT INFORMATION SHOWN ON THE PLANS, THE CONTRACTOR SHALL, PRIOR TO THE INSTALLATION OF ANY PROPOSED INFRASTRUCTURE, NOTIFY THE DESIGN ENGINEER IMMEDIATELY.

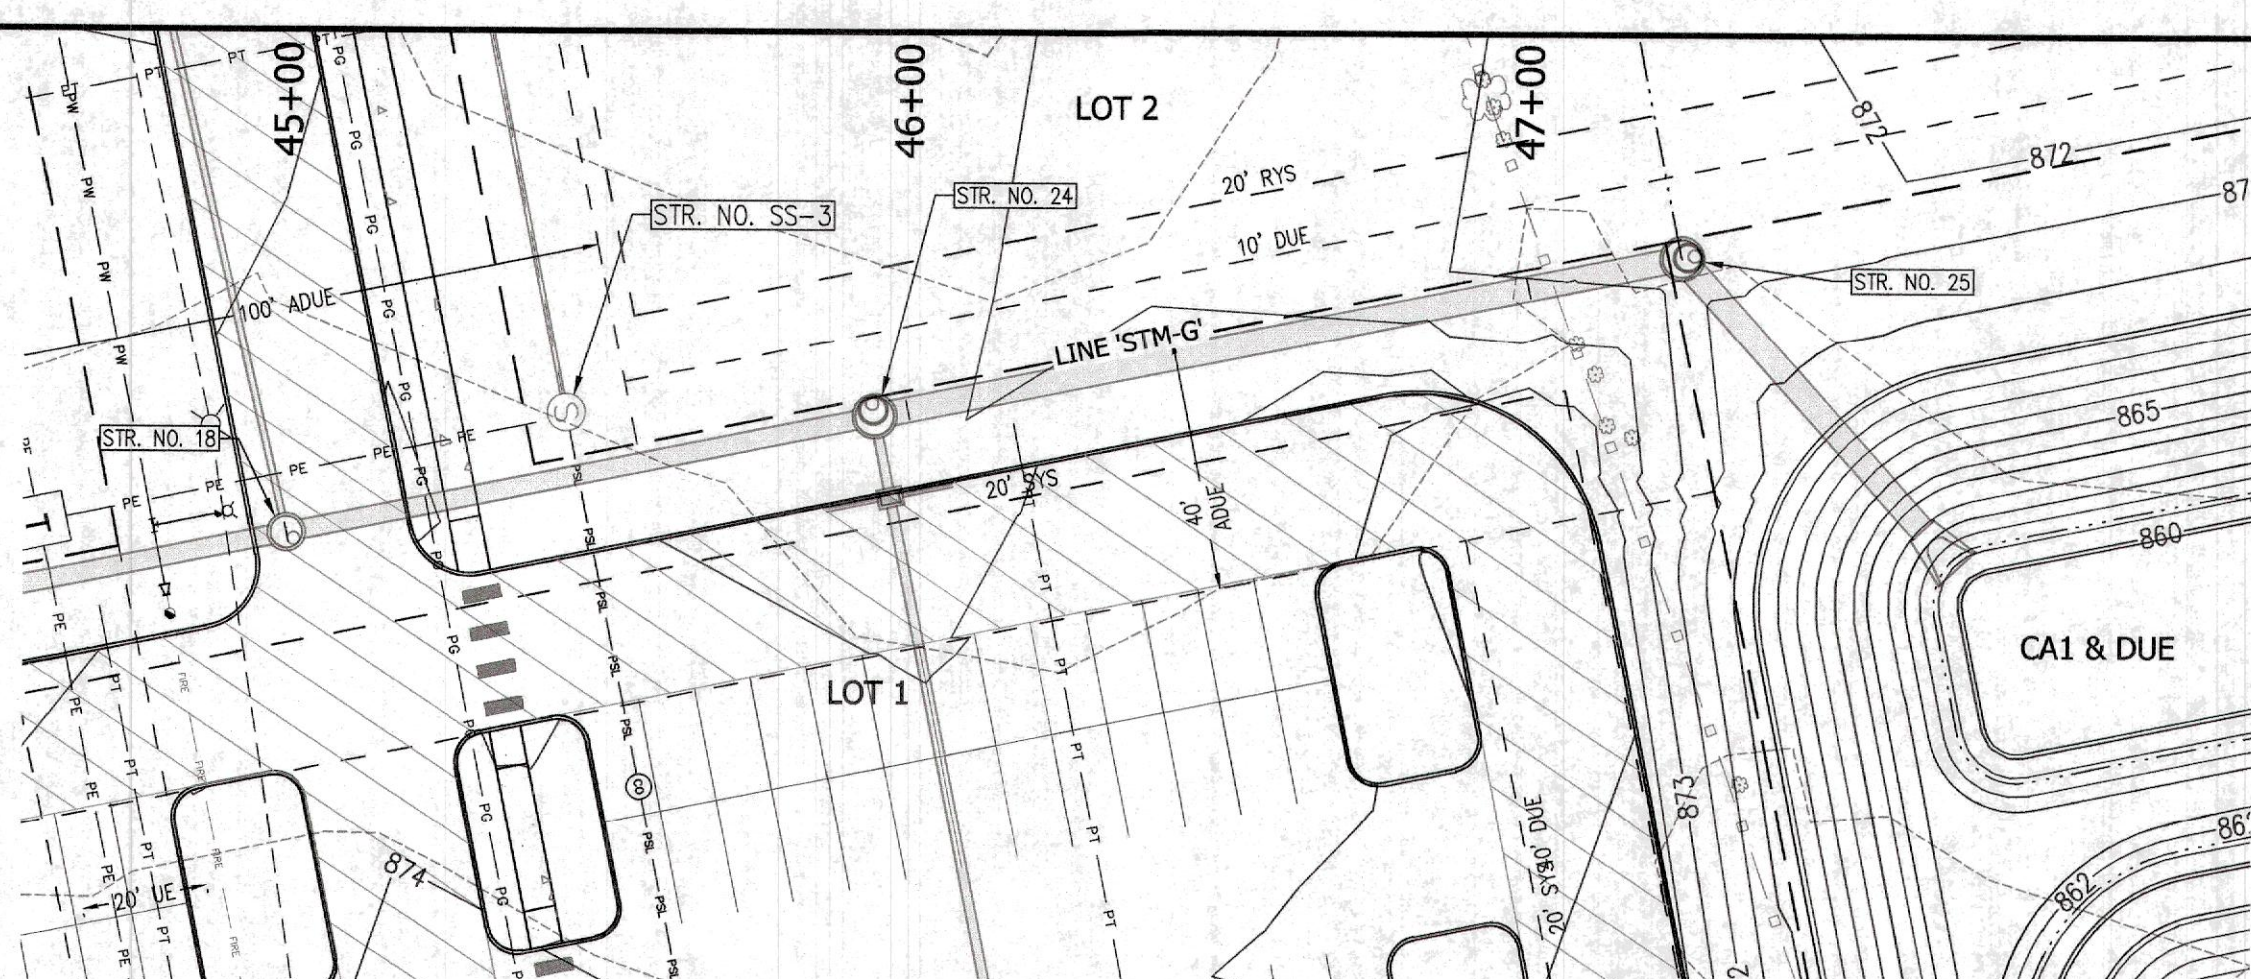

PENDLETON HEALTHPLEX

JOB No.	DRAWN	LWC	CHECKED	TEN
DATE	SEPTEMBER 10, 2018	DWS	APPR.	GJI

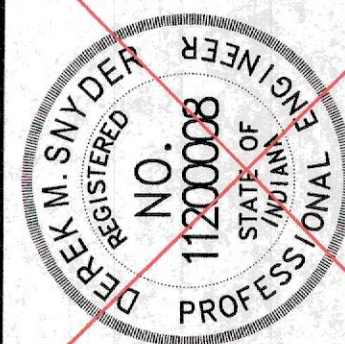

NO.	DATE	REVISIONS	BY	APPR.
9	08.05.19	REVISIONS PER CLIENT & TOWN OF PENDLETON COOPERATION		
8				
7	02.12.19	REVISED TO INCLUDE KOP-44 SEAL FLOIBLE BOOT CONNECTION TO SANITARY WH. STR. # 55-1 & ASPHALT PATH SECTION PER TOWN REQUIREMENTS	DMS	GA
6	12.10.18	RAISED ENTIRE PROJECT (TOPOGRAPHIC SURVEY AND PROPOSED IMPROVEMENTS) 0.38' FOR VERTICAL DATUM CORRECTION	DMS	GA
5	11.26.18	ADDED SANITARY LATERAL STUDS FOR FUTURE CONNECTIONS AT LOT #2 AND BLOCK A	DMS	GA
4	11.20.18	REVISIONS PER PLAN COMMISSION COMMENTS AND BANNING ENG. ROAD ALIGNMENT & PROFILE AND WATER LAYOUT PER CAD DATED 11.13.18	DMS	GA
3	10.09.18	REVISIONS PER TOWN OF PENDLETON AND MADISON CO. DRAINAGE BOARD (BANNING ENG.) REVIEWS	DMS	GA
2	10.01.18	REVISIONS TO SANITARY SEWER PER F.C.R.W.D. COMMENTS	DMS	GA
1	09.20.18	REVISIONS PER INTERNAL AND OWNER REVIEWS	DMS	GA