

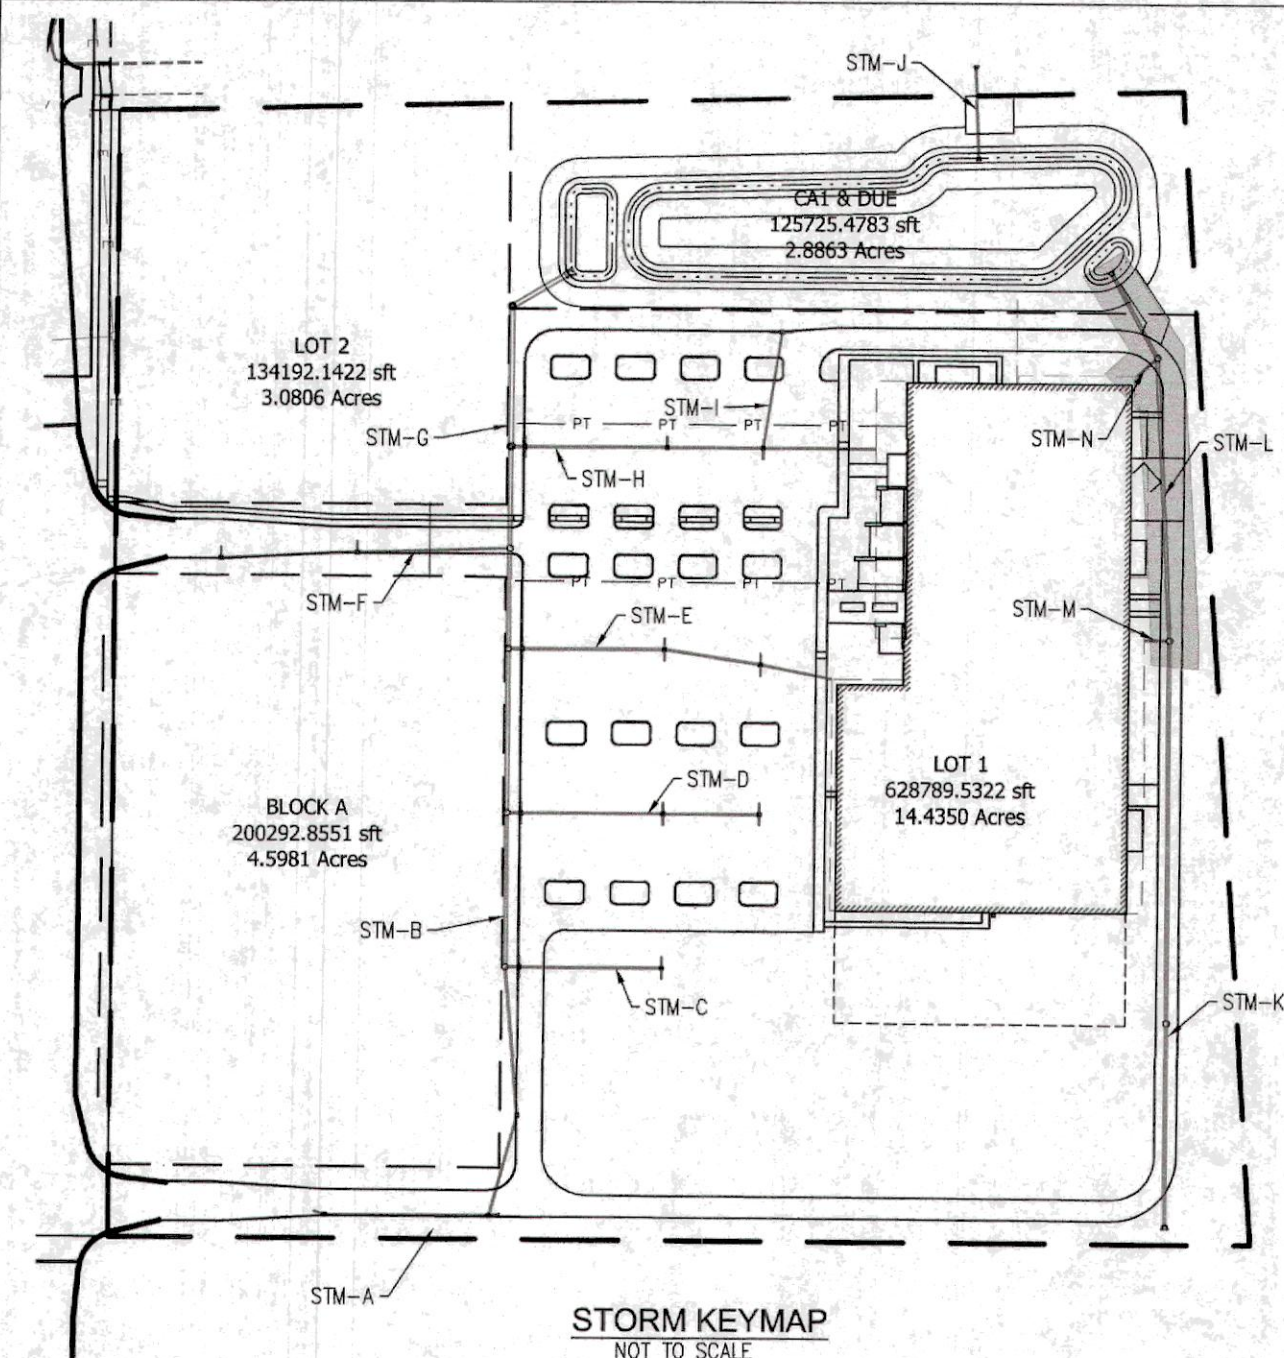
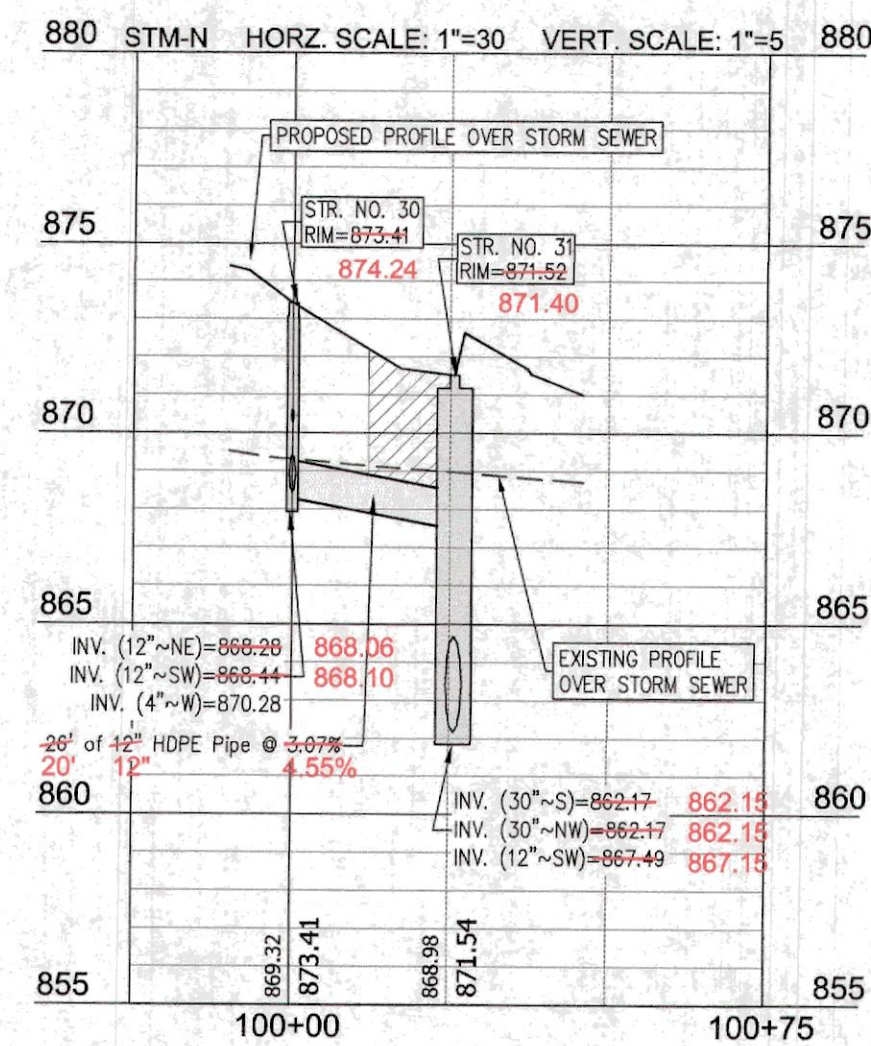
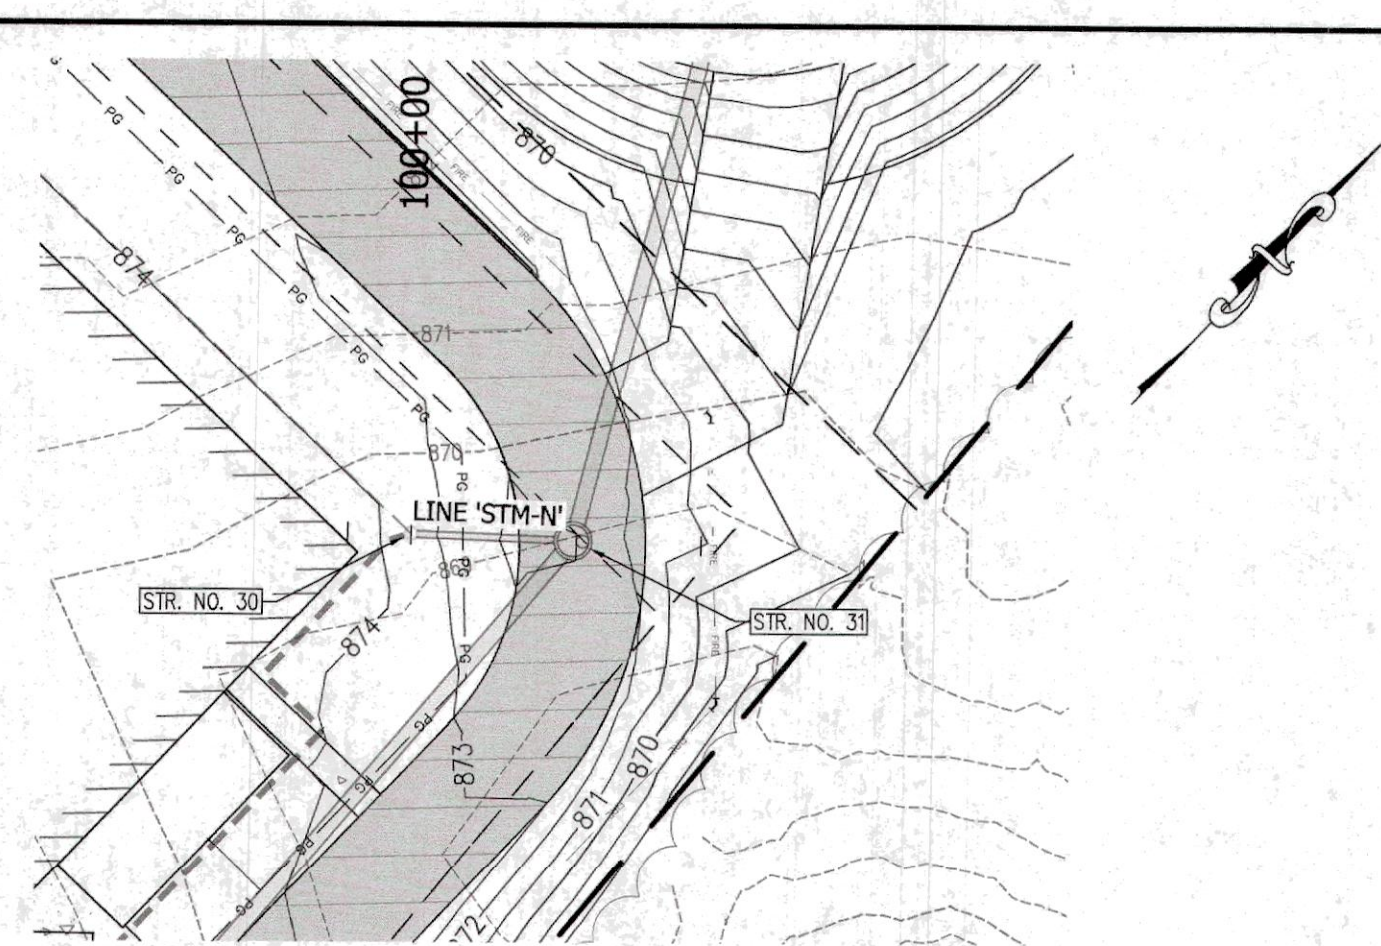
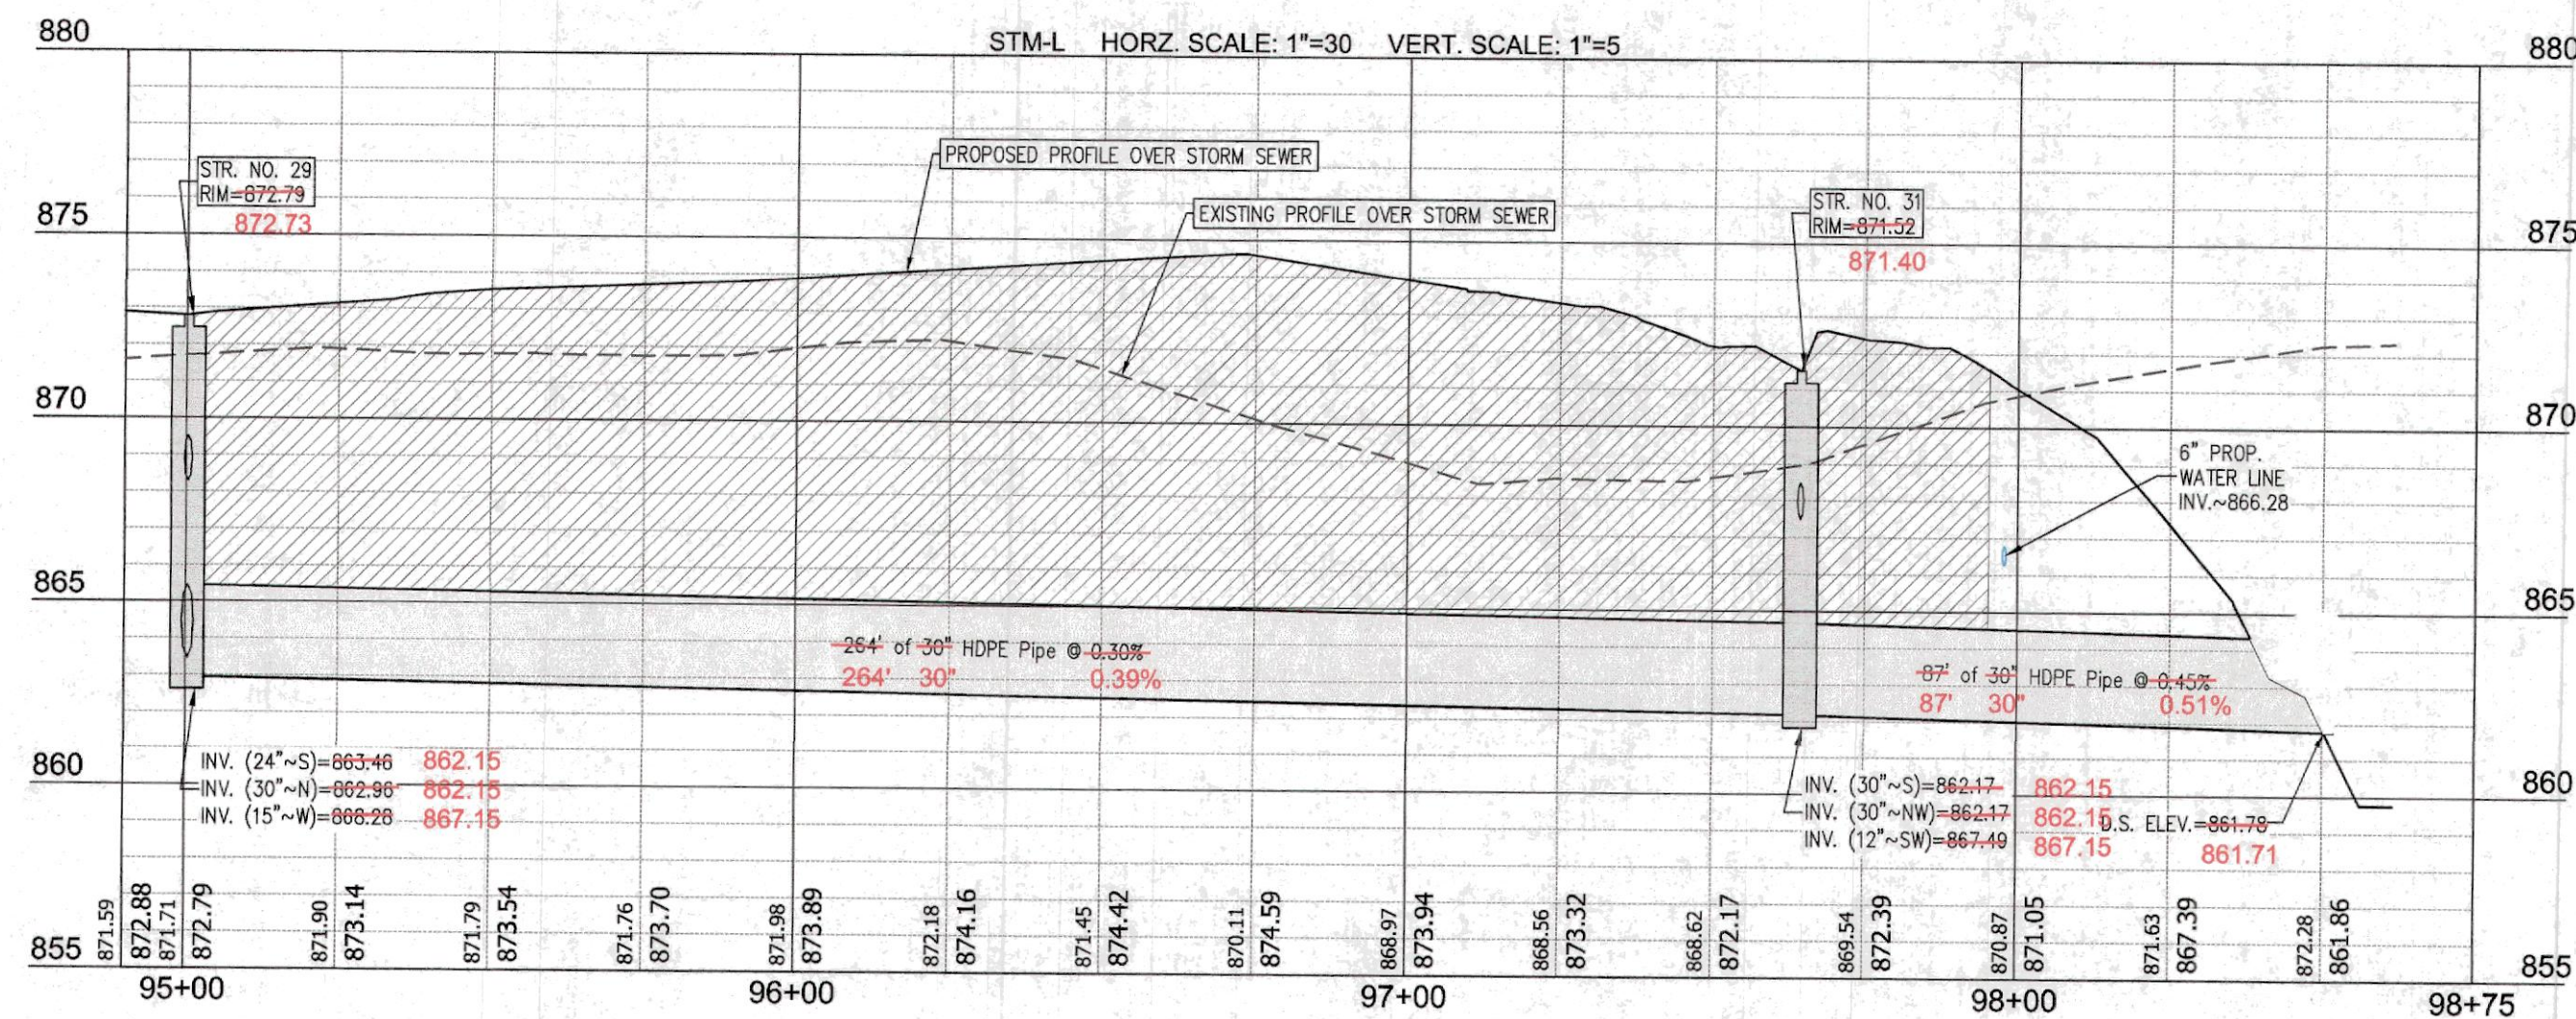
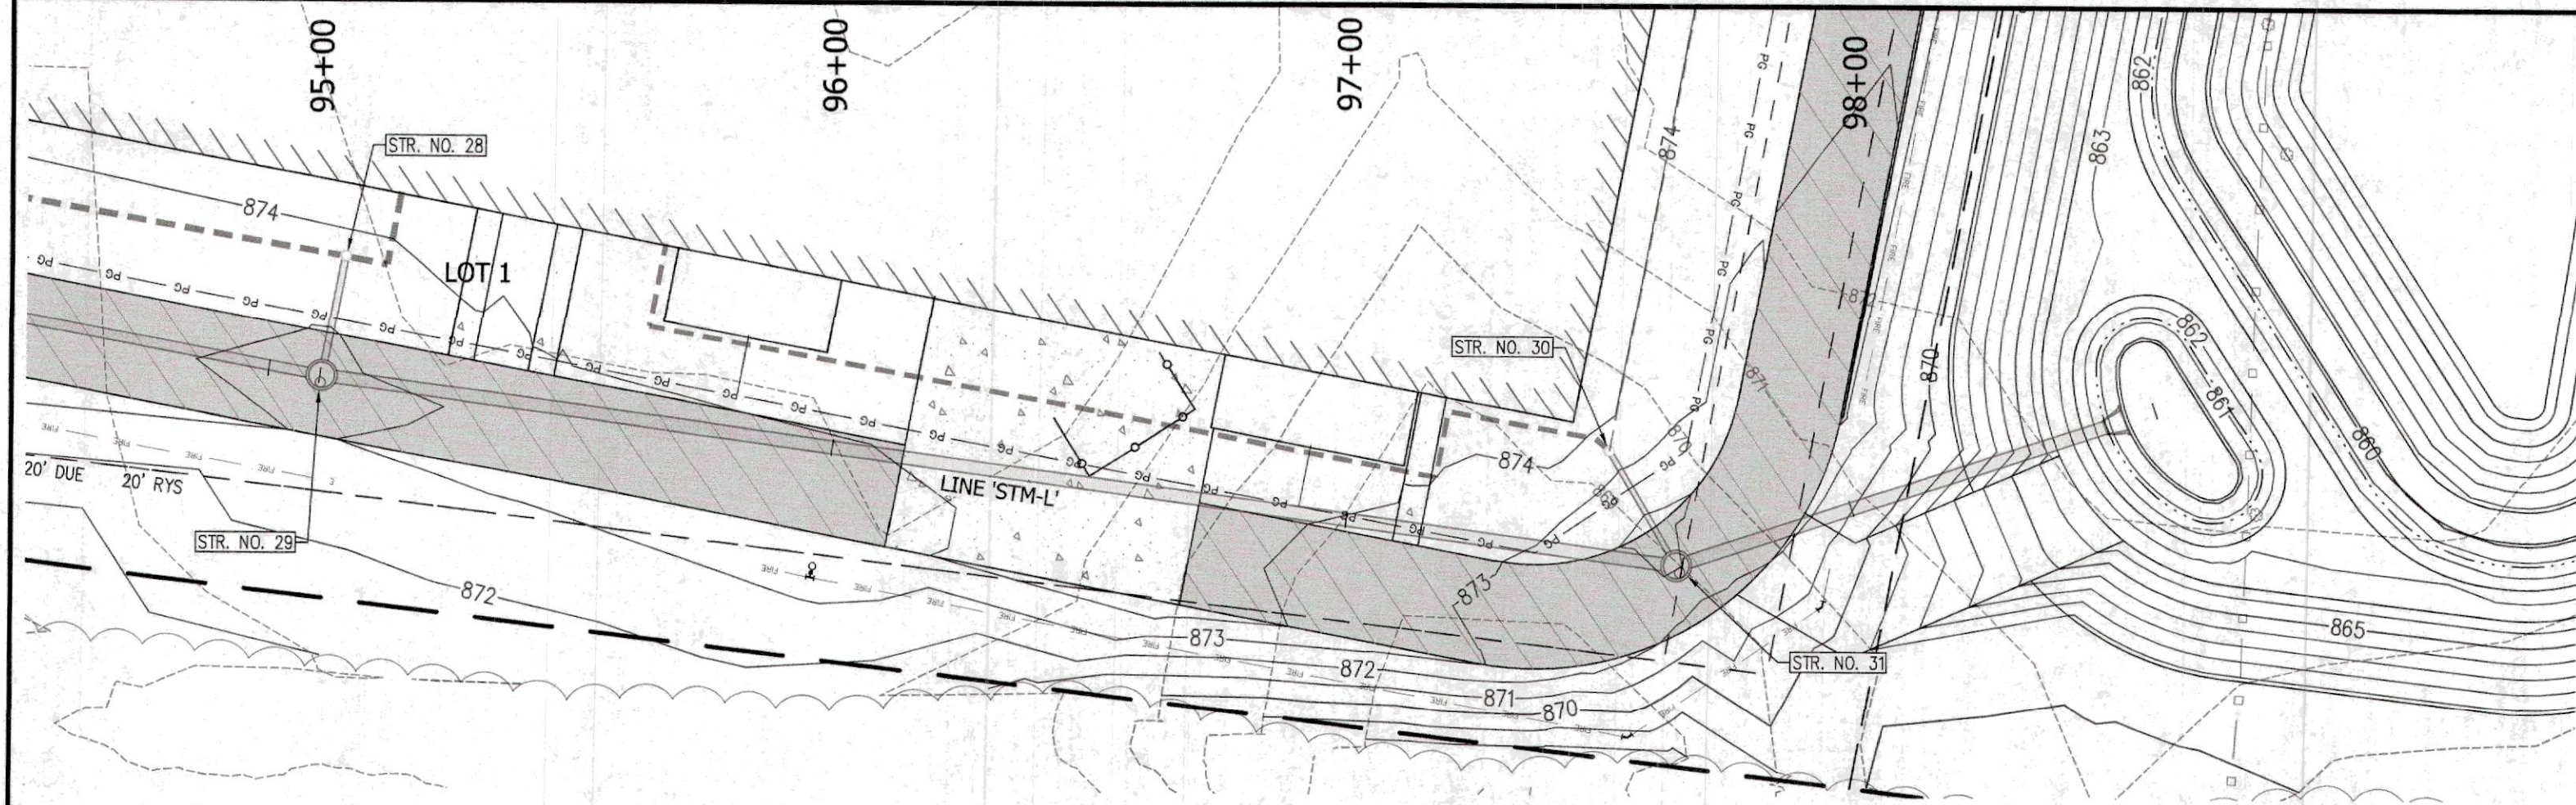
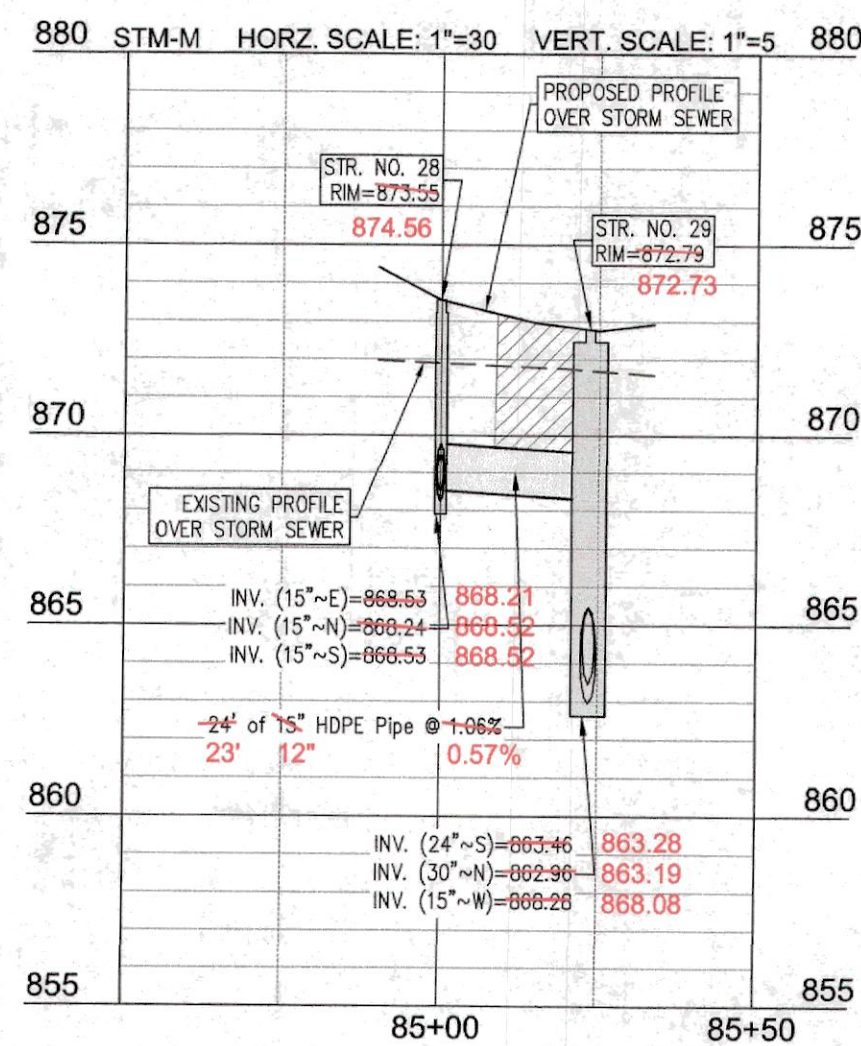


DIRECTORY PATH : P:\Active\Laurel\Penetration Wellness Center\Design\CAD\Plans
FILENAME : 703 STORM PP.dwg
DATE USER : 6/2/2019 11:59 AM / K599

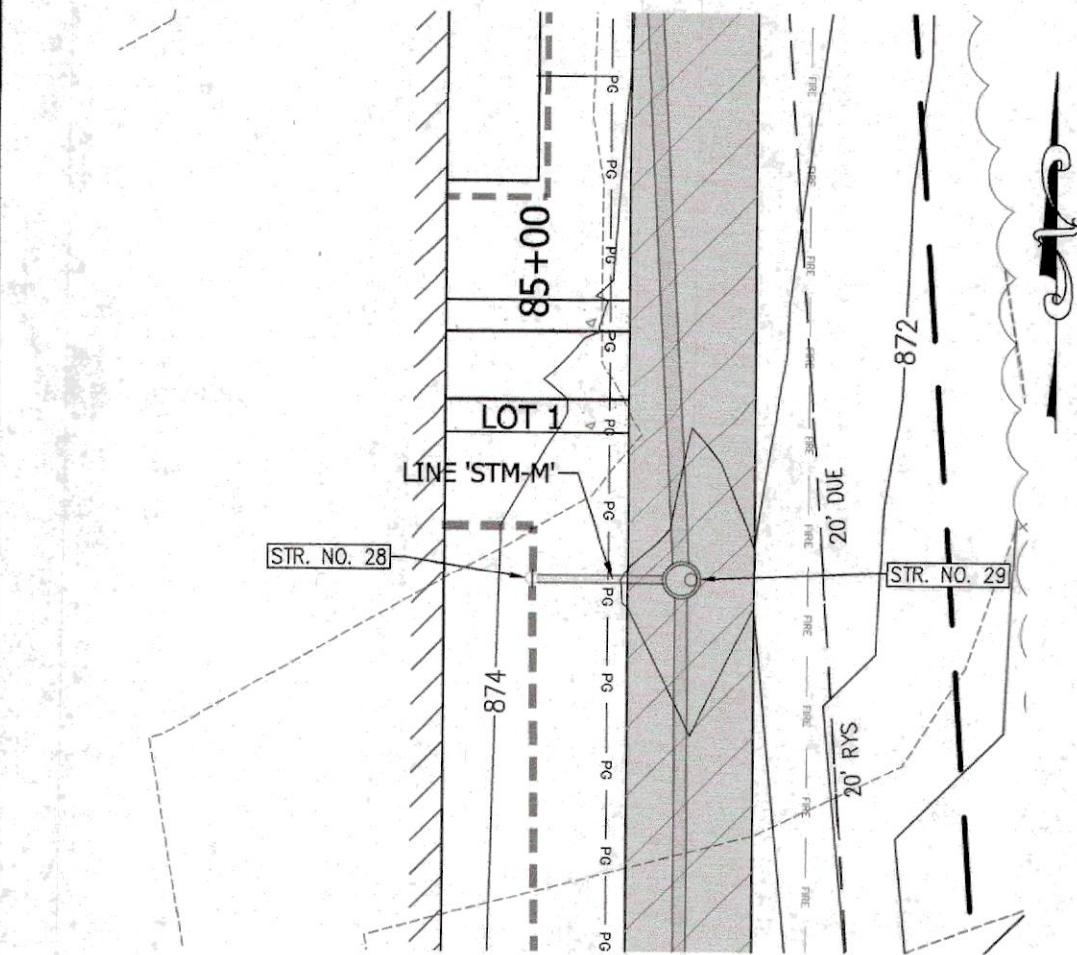

STORM KEYMAP
NOT TO SCALE

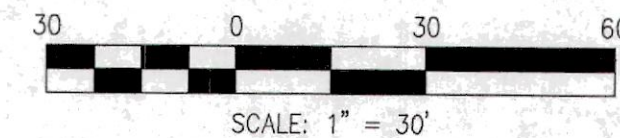

NOTE:
NO EARTHWORK
DISTURBING ACTIVITY
MAY COMMENCE UNTIL
A STORM WATER
MANAGEMENT PERMIT
IS OBTAINED.

DENOTES LIMITS OF GRANULAR BACKFILL
TO BE COMPACTED TO 95% MAX DENSITY
(ACTUAL LIMITS PER TRENCH DETAIL)

EXISTING UTILITY SIZE AND MATERIAL INFORMATION SHOWN ON THESE PLANS
ARE PER THE BEST GRAPHICAL AND VISIBLE INFORMATION AVAILABLE.
CONFLICTS MAY EXIST AND IT SHALL BE THE CONTRACTOR'S RESPONSIBILITY
TO FIELD VERIFY ALL SIZING AND MATERIAL INFORMATION PROVIDED. IF
ACTUAL CONDITIONS DIFFER FROM THAT INFORMATION SHOWN ON THE
PLANS, THE CONTRACTOR SHALL, PRIOR TO THE INSTALLATION OF ANY
PROPOSED INFRASTRUCTURE, NOTIFY THE DESIGN ENGINEER IMMEDIATELY.



STORM PLAN AND PROFILE

PENDLETON HEALTHPLEX

JOB No.	DRAWN	LWC	CHECKED	TEN	APPR.	GJJ
DATE	SEPTEMBER 10, 2018	DMS				

REGISTERED PROFESSIONAL ENGINEER
NO. 1120008
STATE OF INDIANA
Dale M. Sypul

NO.	DATE	REVISIONS	BY	APPR.
9	06.05.19	REVISIONS PER CLIENT & TOWN OF PENDLETON COORDINATION	DMS	GJJ
8	06.05.19	REVISED TO INCLUDE KOP-N SEAL FLEXIBLE BOOT CONNECTION TO SANITARY MAIN STR. # SS-1 & ASPHALT PATH SECTION PER TOWN REQUIREMENTS	DMS	GJJ
7	02.12.19	RAISED ENTIRE PROJECT (TOPOGRAPHIC SURVEY AND PROPOSED IMPROVEMENTS) 0.38' FOR VERTICAL DATUM CORRECTION	DMS	GJJ
6	12.01.18	ADDED SANITARY LATERAL STUDIES FOR FUTURE CONNECTIONS AT LOT #2 AND BLOCK A	DMS	GJJ
5	11.26.18	REVISIONS PER PLAN COMMISSION COMMENTS AND BANNING ENG. ROAD ALIGNMENT & PROFILE AND WATER LAYOUT PER CAD FILE DATED 11.13.18	DMS	GJJ
4	11.20.18	REVISIONS PER TOWN OF PENDLETON AND MADISON CO. DRAINAGE BOARD (BANNING ENG.) COMMENTS	DMS	GJJ
3	10.09.18	REVISIONS TO SANITARY SEWER PER F.C.M.D. COMMENTS	DMS	GJJ
2	10.01.18	REVISIONS PER INTERNAL AND OWNER REVIEWS	DMS	GJJ
1	09.20.18		DMS	GJJ
NO.	DATE			