


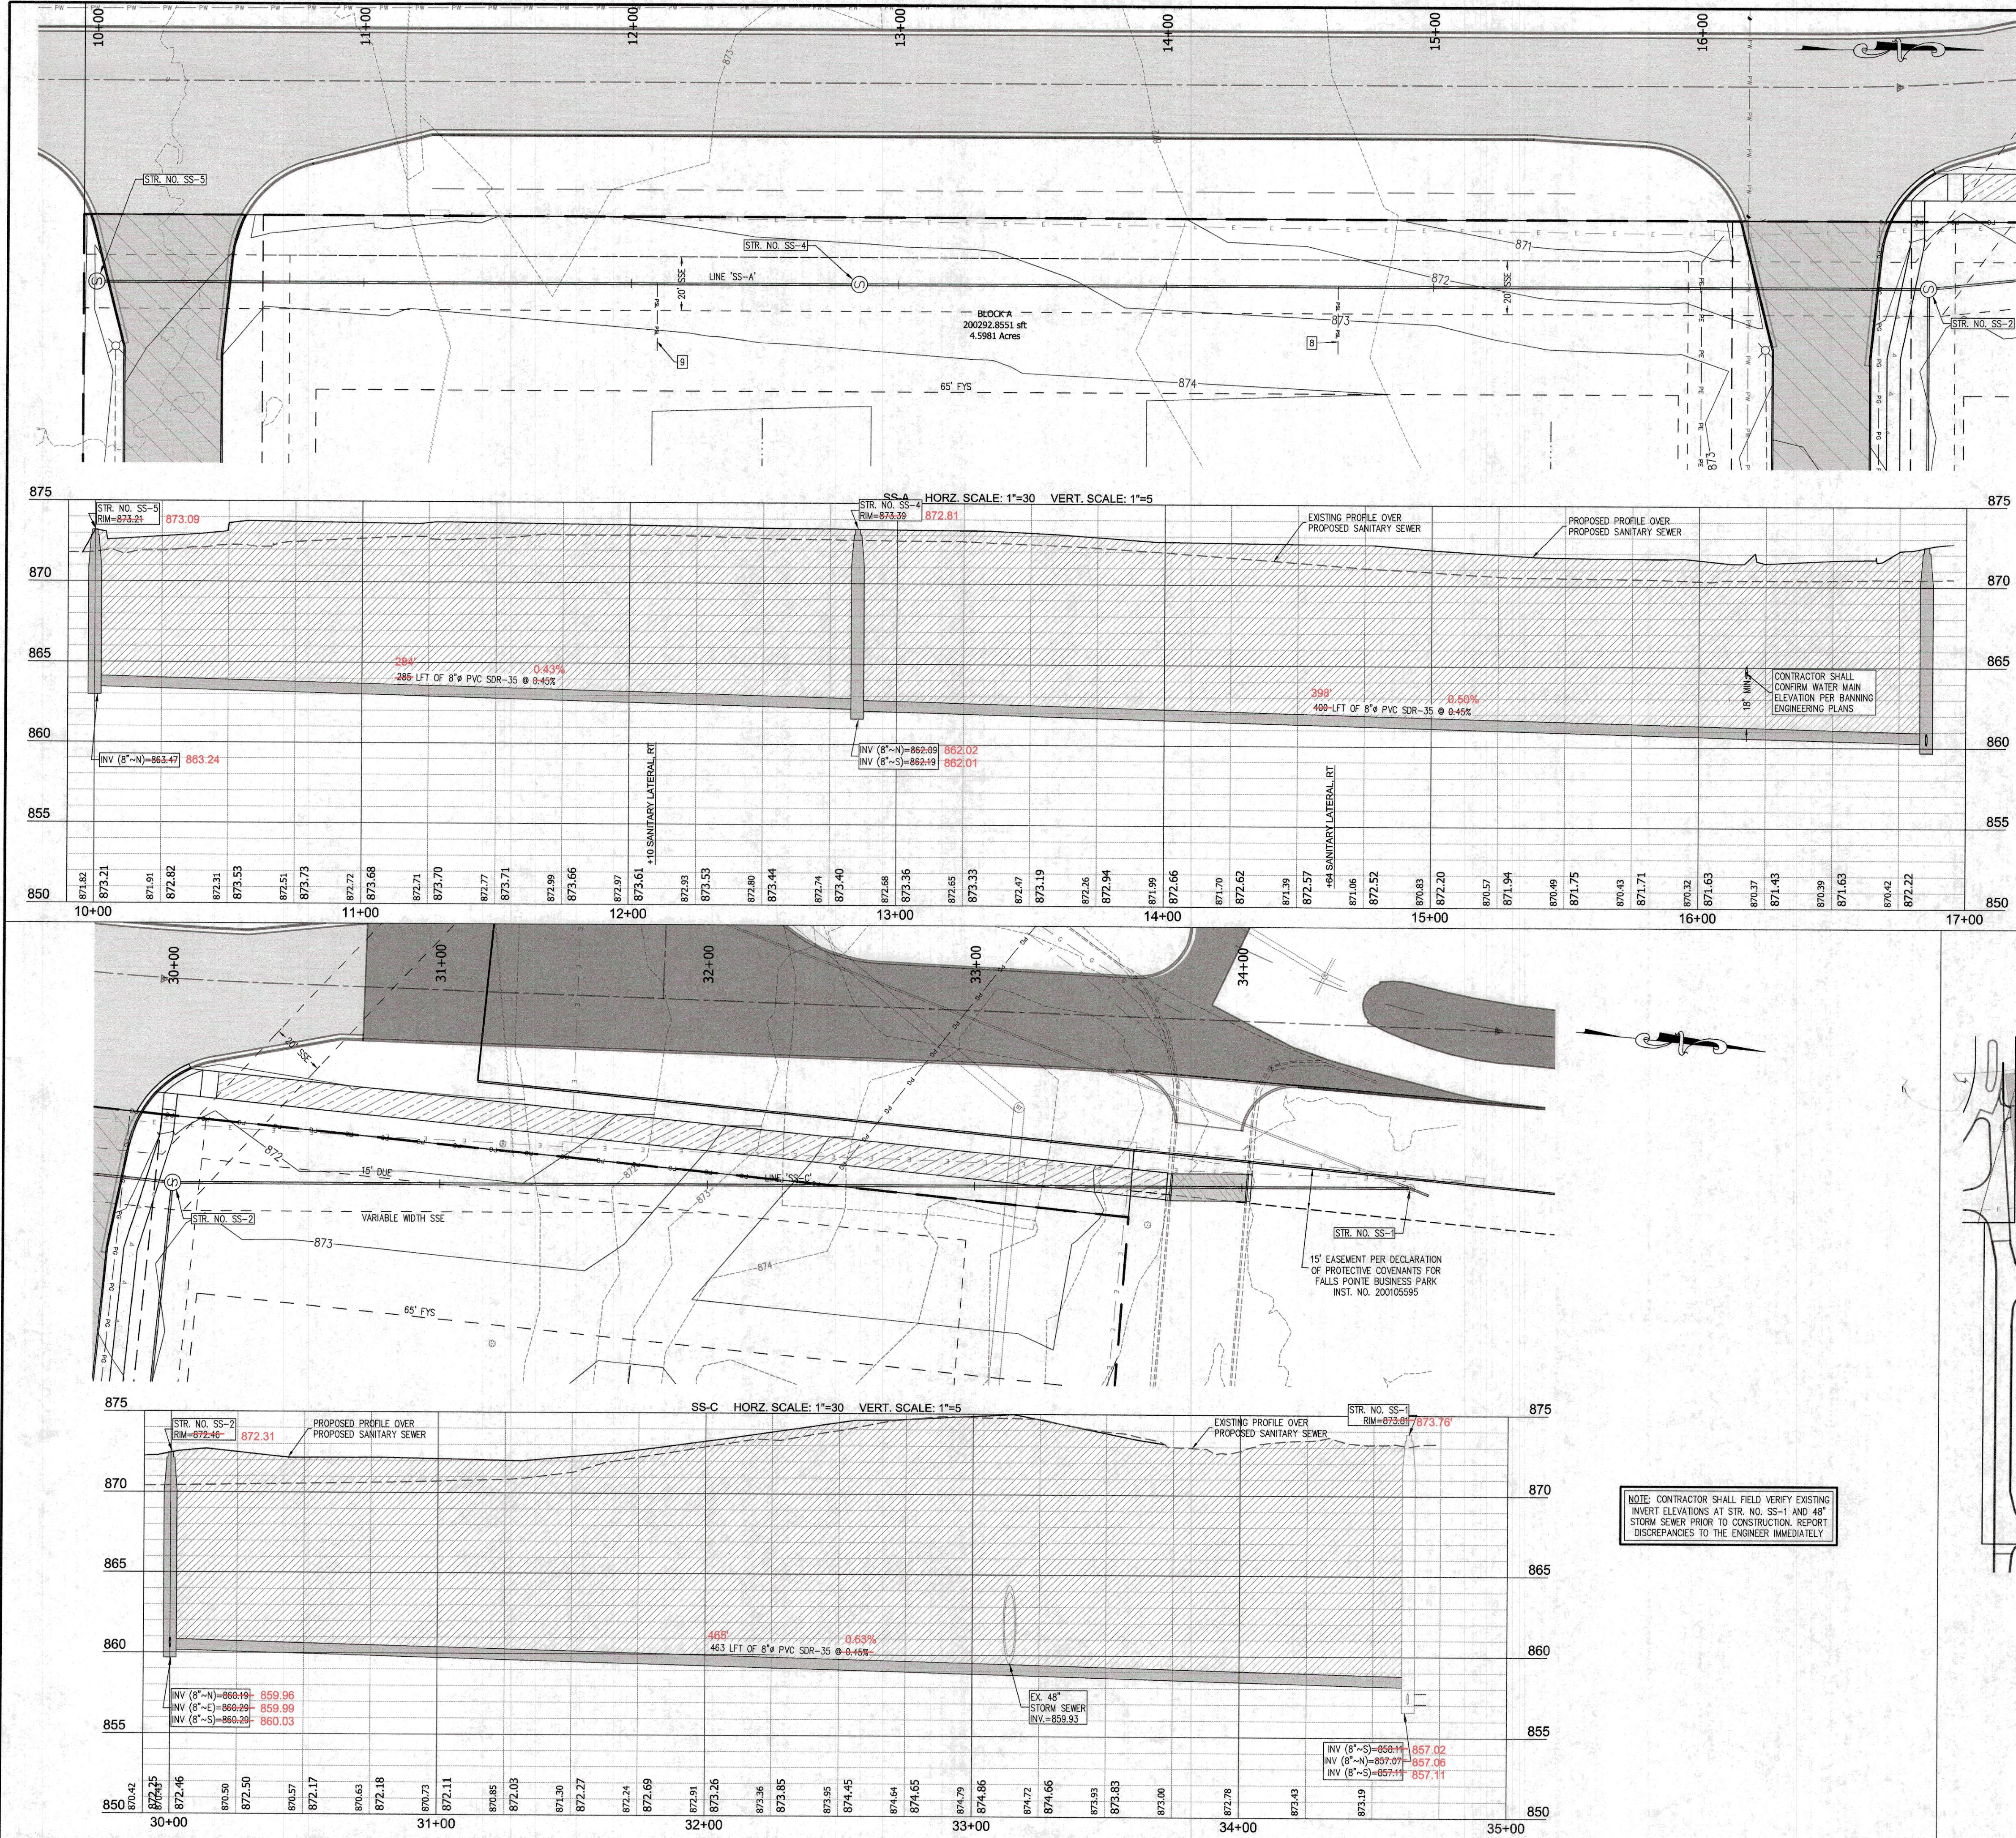

EXISTING UTILITY SIZE AND MATERIAL INFORMATION SHOWN ON THESE PLANS ARE PER THE BEST GRAPHICAL AND VISIBLE INFORMATION AVAILABLE. CONFLICTS MAY EXIST AND IT SHALL BE THE CONTRACTOR'S RESPONSIBILITY TO FIELD VERIFY ALL SIZING AND MATERIAL INFORMATION PROVIDED. IF ACTUAL CONDITIONS DIFFER FROM THAT INFORMATION SHOWN ON THE PLANS, THE CONTRACTOR SHALL, PRIOR TO THE INSTALLATION OF ANY PROPOSED INFRASTRUCTURE, NOTIFY THE DESIGN ENGINEER IMMEDIATELY.


PROPOSED LEGEND

- PROPERTY LINE
- SETBACK LINE
- SANITARY SEWER WITH MANHOLE
- SANITARY SEWER LATERAL WITH CLEANOUT
- STORM SEWER W/ MANHOLE & END SECTION
- ELECTRIC LINE
- PUBLIC WATER MAIN
- FIRE SUPPRESSION LINE
- WATER SERVICE LINE
- GAS LINE
- TELECOM SERVICE
- WATER TEE
- 45° BEND
- 11.25° BEND
- TAPPING SLEEVE
- WATER VALVE
- FIRE HYDRANT
- STORTZ FDC
- POST INDICATOR VALVE
- STORM INLETS
- SIGN
- LIGHT POLE


ABBREVIATIONS

- AUE ACCESS, DRAINAGE AND UTILITY EASEMENT
- DUE DRAINAGE AND UTILITY EASEMENT
- UE UTILITY EASEMENT
- SSE SANITARY SEWER EASEMENT
- FYS FRONT YARD SETBACK
- RYS REAR YARD SETBACK
- SYS SIDE YARD SETBACK
- CA COMMON AREA

NOTE:
NO EARTHWORK
DISTURBING ACTIVITY
MAY COMMENCE UNTIL
A STORM WATER
MANAGEMENT PERMIT
IS OBTAINED.

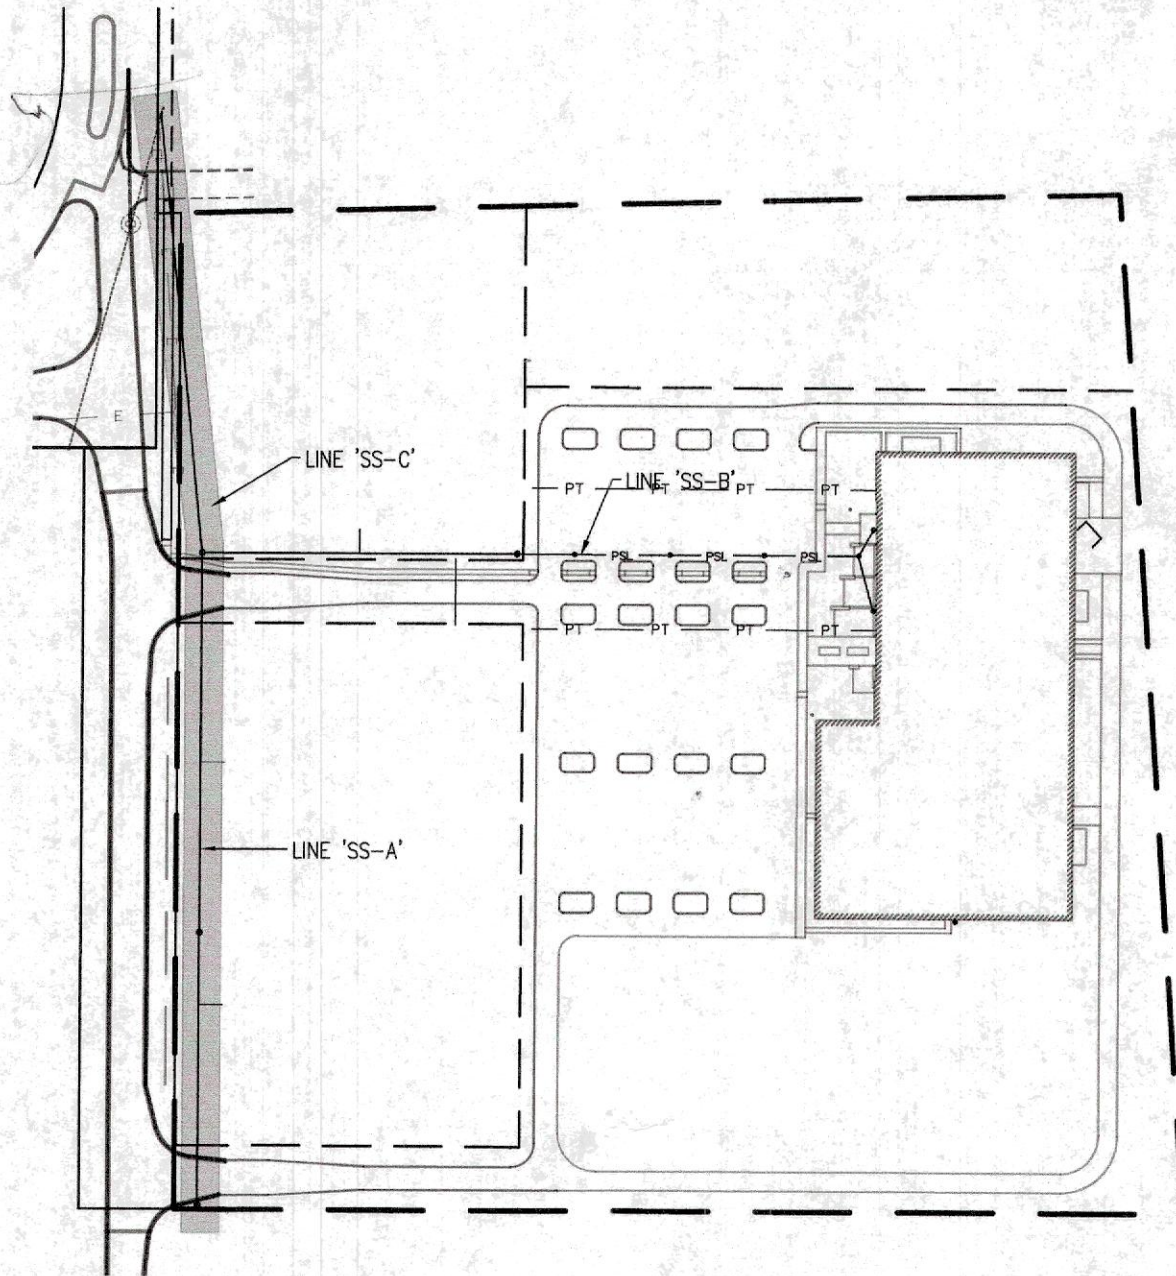

SANITARY KEYMAP
NOT TO SCALE

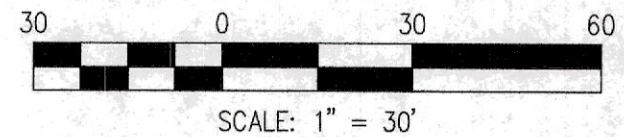


NOTES:
1. DENOTES LIMITS OF GRANULAR BACKFILL
TO BE COMPACTED TO 95% MAX DENSITY
(ACTUAL LIMITS PER TRENCH DETAIL)



SANITARY PLAN AND PROFILE

PENDLETON HEALTHPLEX

NO.	DATE	BY	REVISIONS
1	09/20/18	DMS	REVISIONS PER TOWN OF PENDLETON
2	10/01/18	DMS	REVISIONS PER TOWN OF PENDLETON
3	10/02/18	DMS	REVISIONS PER TOWN OF PENDLETON
4	11/20/18	DMS	REVISIONS PER TOWN OF PENDLETON
5	11/28/18	DMS	REVISIONS PER TOWN OF PENDLETON
6	12/10/18	DMS	REVISIONS PER TOWN OF PENDLETON
7	02/12/19	DMS	REVISIONS PER TOWN OF PENDLETON
8	06/05/19	DMS	REVISIONS PER TOWN OF PENDLETON

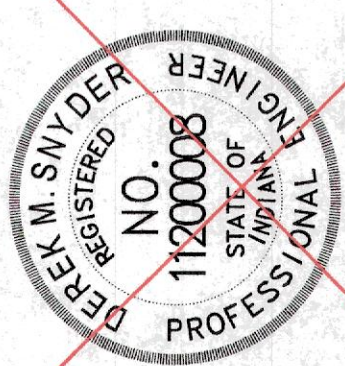

DATE: SEPTEMBER 10, 2018
JOB NO.:
DRAWN: LMC
CHECKED: TEN
DESIGNED: DMS
APPR.: GJJ

NO.	DATE	BY	REVISIONS
1	09/20/18	DMS	REVISIONS PER TOWN OF PENDLETON
2	10/01/18	DMS	REVISIONS PER TOWN OF PENDLETON
3	10/02/18	DMS	REVISIONS PER TOWN OF PENDLETON
4	11/20/18	DMS	REVISIONS PER TOWN OF PENDLETON
5	11/28/18	DMS	REVISIONS PER TOWN OF PENDLETON
6	12/10/18	DMS	REVISIONS PER TOWN OF PENDLETON
7	02/12/19	DMS	REVISIONS PER TOWN OF PENDLETON
8	06/05/19	DMS	REVISIONS PER TOWN OF PENDLETON