


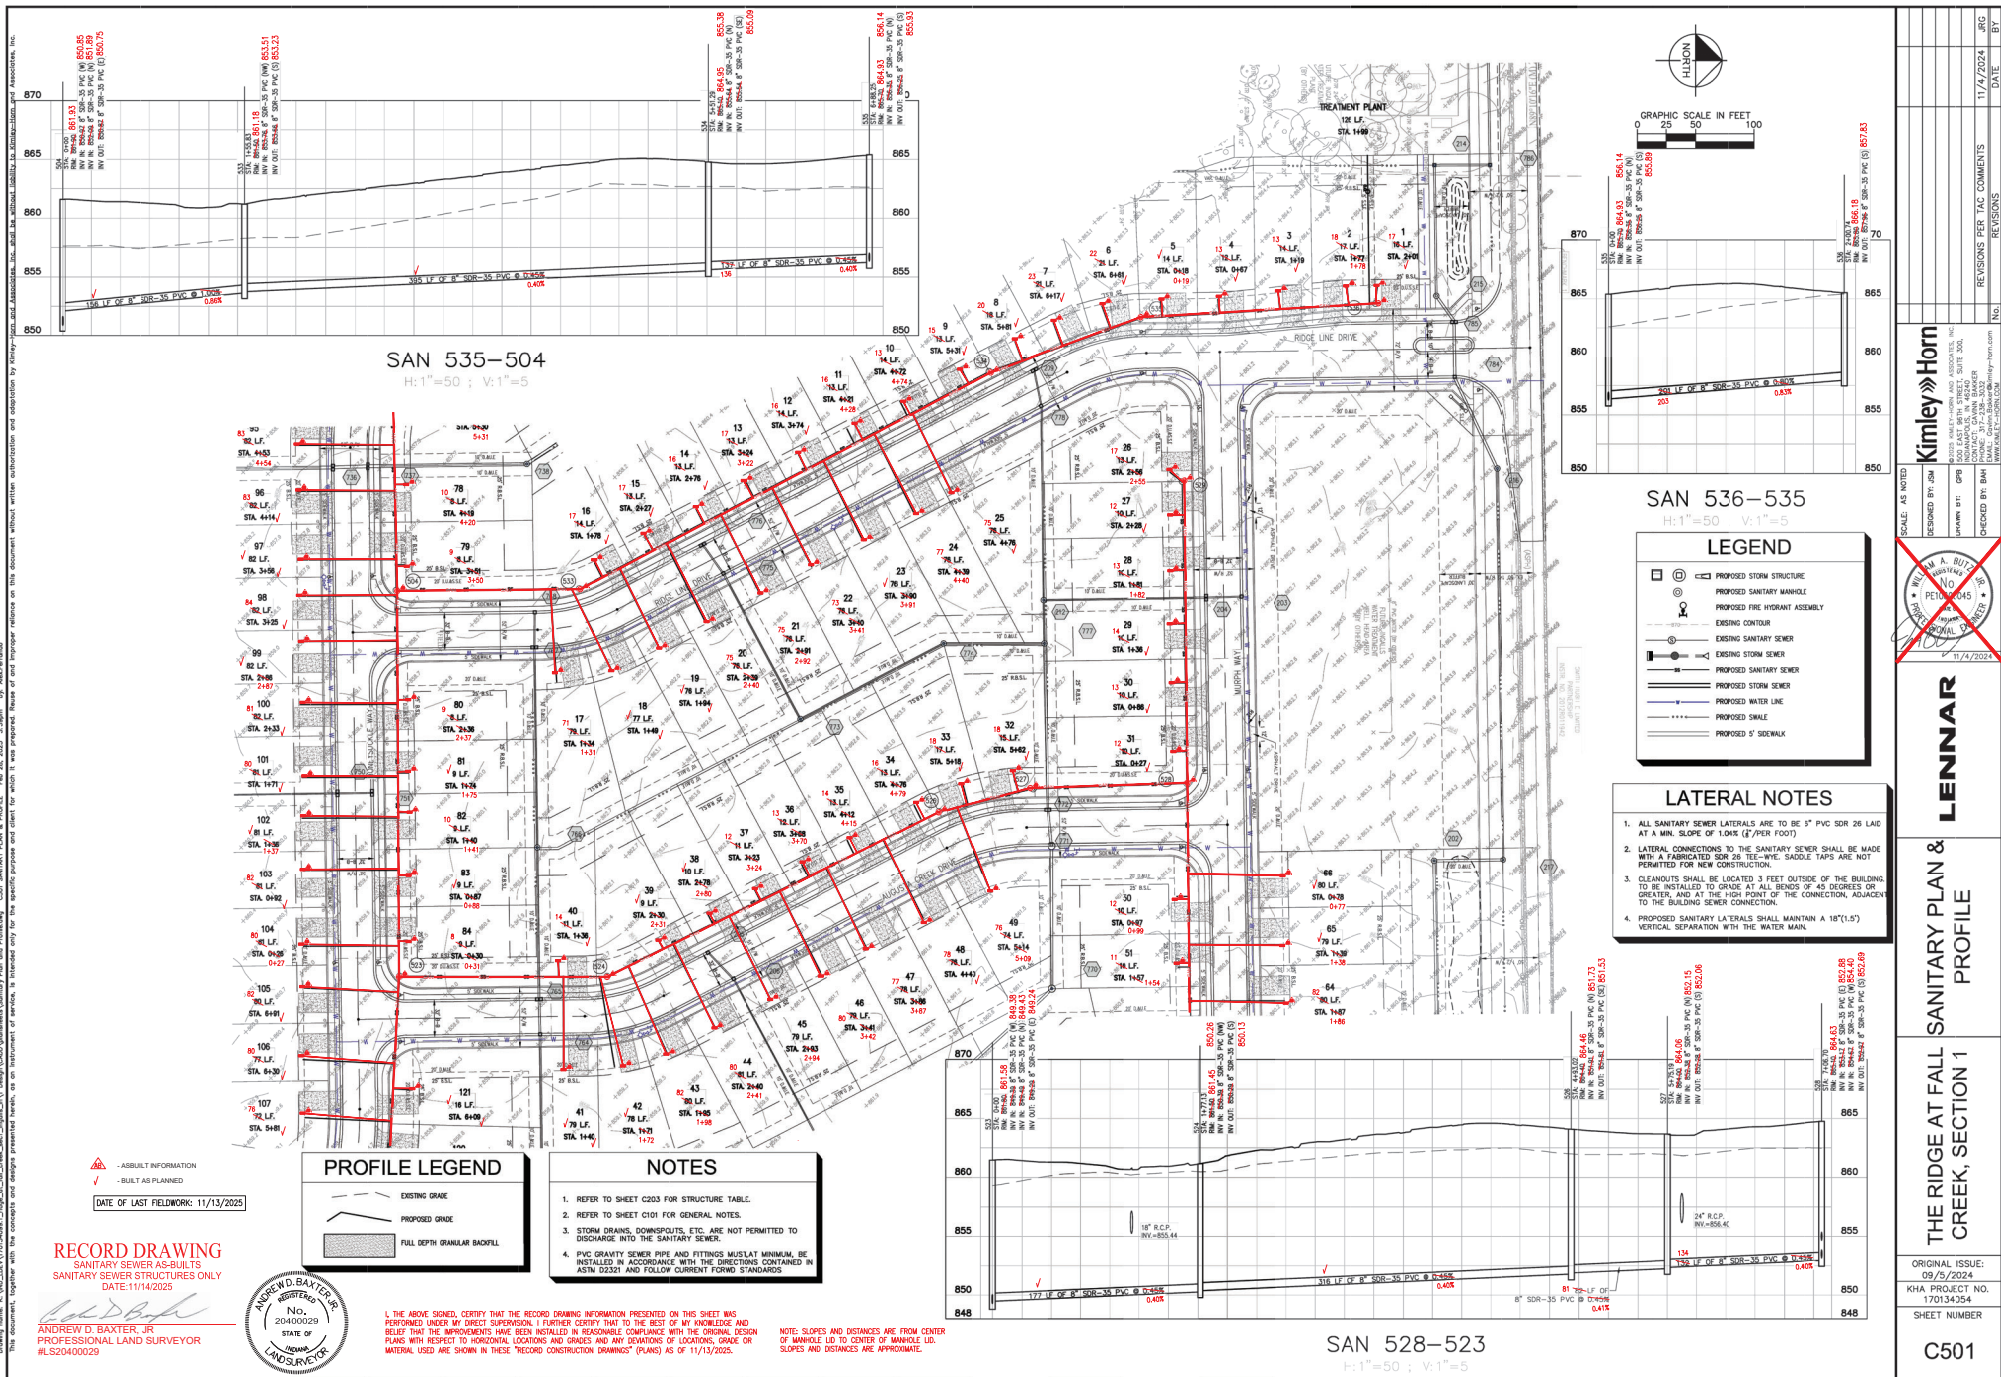

LENNAR

SANITARY PLAN & PROFILE

THE RIDGE AT FALL
CREEK, SECTION 1

ORIGINAL ISS
09/5/202
KHA PROJECT
170134354

C50: