

PLOTTED BY: Johnson

PRINTED: 12/19/2019 @ 4:47PM

FILE NAME: G:\4635-FCRWD-US 36\Working Drawings\AutoCAD\4635-C-07.dwg

THIS RECORD DOCUMENT HAS BEEN PREPARED BASED ON INFORMATION PROVIDED BY THE CONSTRUCTION CONTRACTOR. GRW ENGINEERS, INC. HAS ATTEMPTED TO VERIFY THE ACCURACY AND/OR COMPLETENESS OF THIS INFORMATION BUT SHALL NOT BE RESPONSIBLE FOR ANY ERRORS OR OMISSIONS WHICH MAY BE INCORPORATED HEREIN AS A RESULT.




engineering | architecture | geospatial


ENGINEER/ARCHITECT: GEORGE LEWIS

CONSTRUCTION COMPANY: S.C. CASE EXCAVATING


DATE: 12/2019

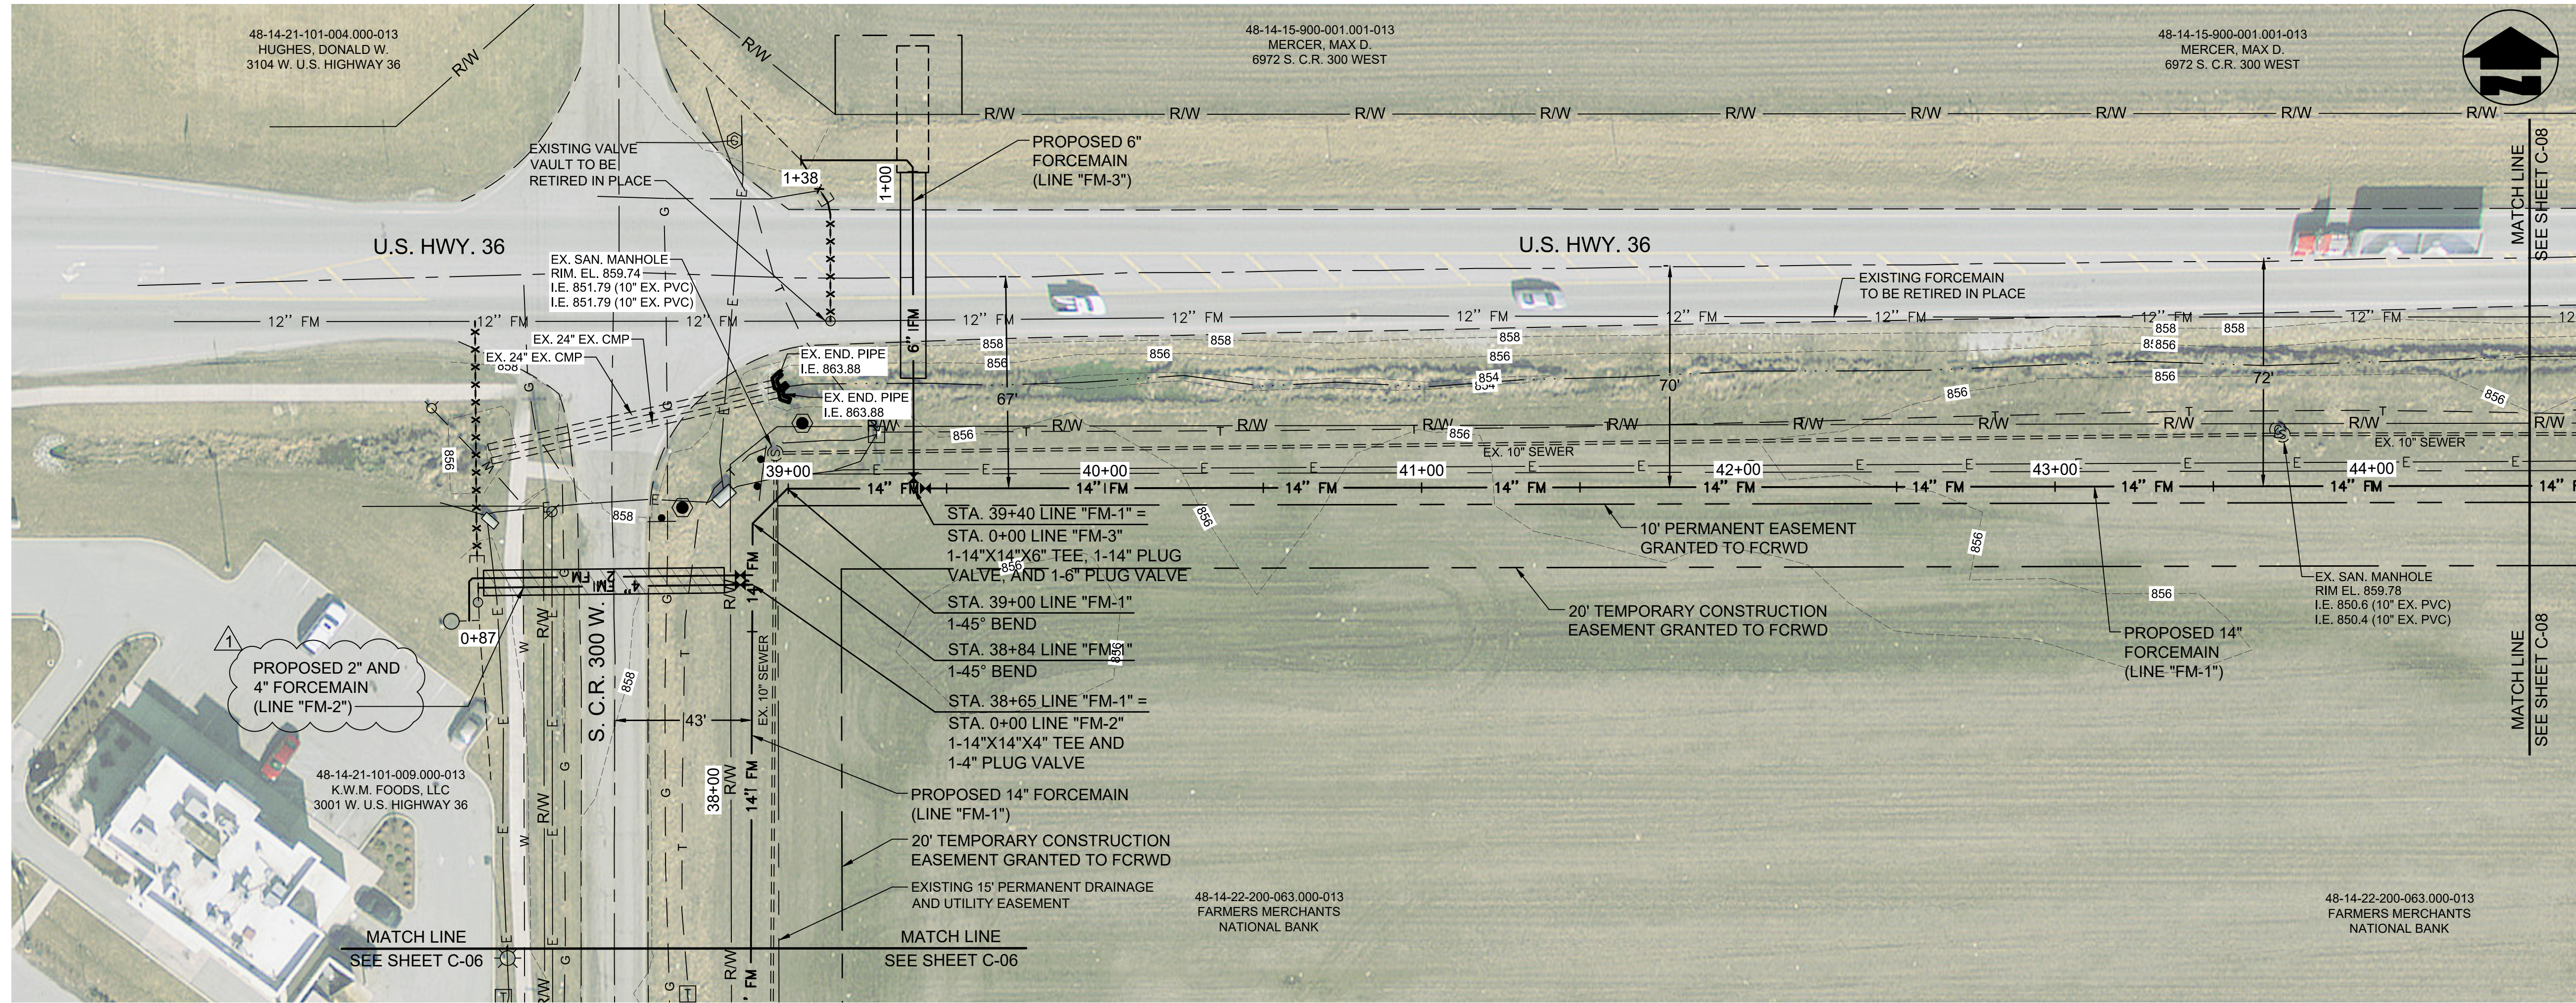

PLAN VIEW - STA. 37+50 TO STA. 44+50 LINE "FM-1"

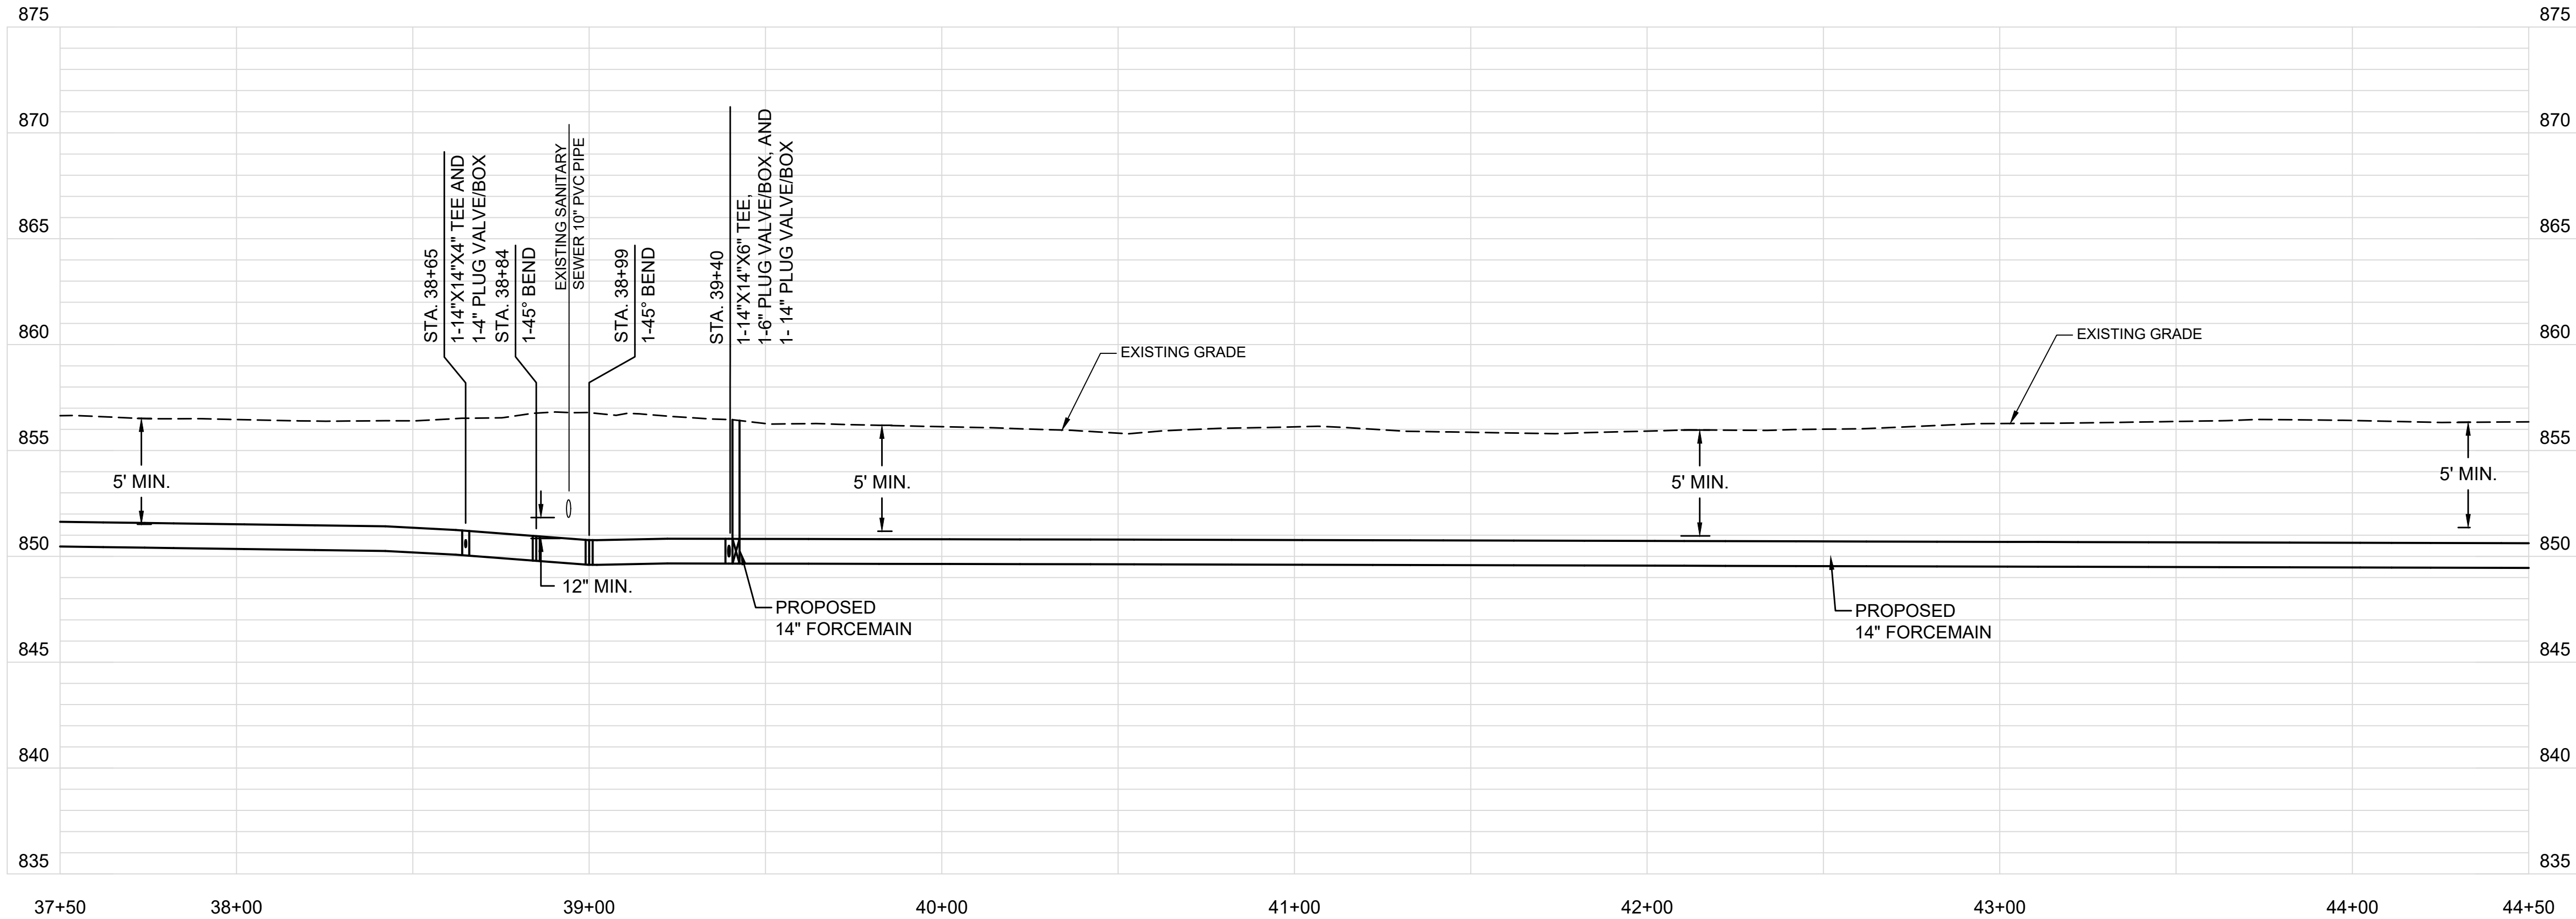

PROFILE - STA. 37+50 TO STA. 44+50 LINE "FM-1"

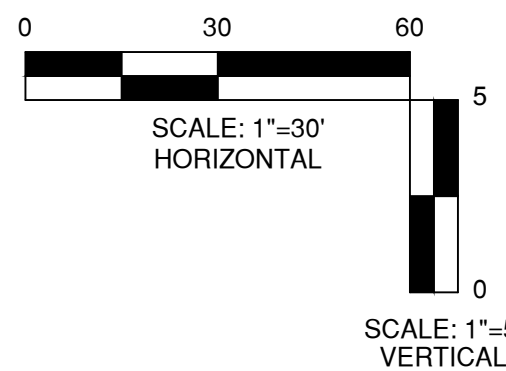


This document, originally issued, sealed, and signed by George W. Lewis, Indiana Professional Engineer, No. 10403303, on 7.2.2018, shall not be used in lieu of a certified document.

GRW PROJECT NO. 4635

CLIENT PROJECT NO. -

ALL RIGHTS RESERVED. THIS DOCUMENT IS THE PROPERTY OF GRW ENGINEERS, INC. IT IS TO BE REPRODUCED IN WHOLE OR IN PART WITHOUT WRITTEN PERMISSION.

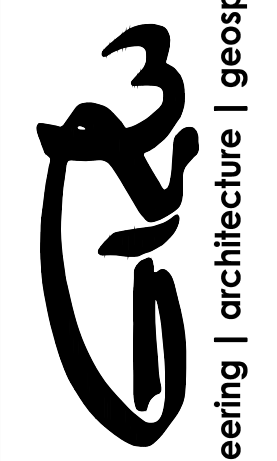

engineering | architecture | geospatial

www.grwinc.com

PLAN AND PROFILE

LINE "FM-1"

US 36 FORCEMAIN REPLACEMENT

TOWN OF PENDLETON, INDIANA

NO.	DATE	BY	DESIGNED		DRAWN		REVIEWED		APPROVED	
			GWL	JRD	GWL	GWL	GWL	GWL		
1	9/18	GWL								
REVISIONS										
DESCRIPTION										
1 PIPE SIZE REVISION										
SCALE CHECK: THIS MARK SHOULD MEASURE EXACTLY 1" WHEN PLOTTED										

DATE: JULY 2018

SCALE: 1"=30'

SHEET NO. C-07