

PLOTTED BY: Johnson

PRINTED: 12/19/2019 @ 4:48PM


FILE NAME: G:\4635-FCRWD-US 36\Working Drawings\AutoCAD\4635-C-08.dwg

THIS RECORD DOCUMENT HAS BEEN PREPARED BASED ON INFORMATION PROVIDED BY THE CONSTRUCTION CONTRACTOR. GRW ENGINEERS, INC. HAS ATTEMPTED TO VERIFY THE ACCURACY AND/OR COMPLETENESS OF THIS INFORMATION BUT SHALL NOT BE RESPONSIBLE FOR ANY ERRORS OR OMISSIONS WHICH MAY BE INCORPORATED HEREIN AS A RESULT.




engineering | architecture | geospatial


ENGINEER/ARCHITECT: GEORGE LEWIS
 CONSTRUCTION COMPANY: S.C. CASE EXCAVATING
 DATE: 12/2019

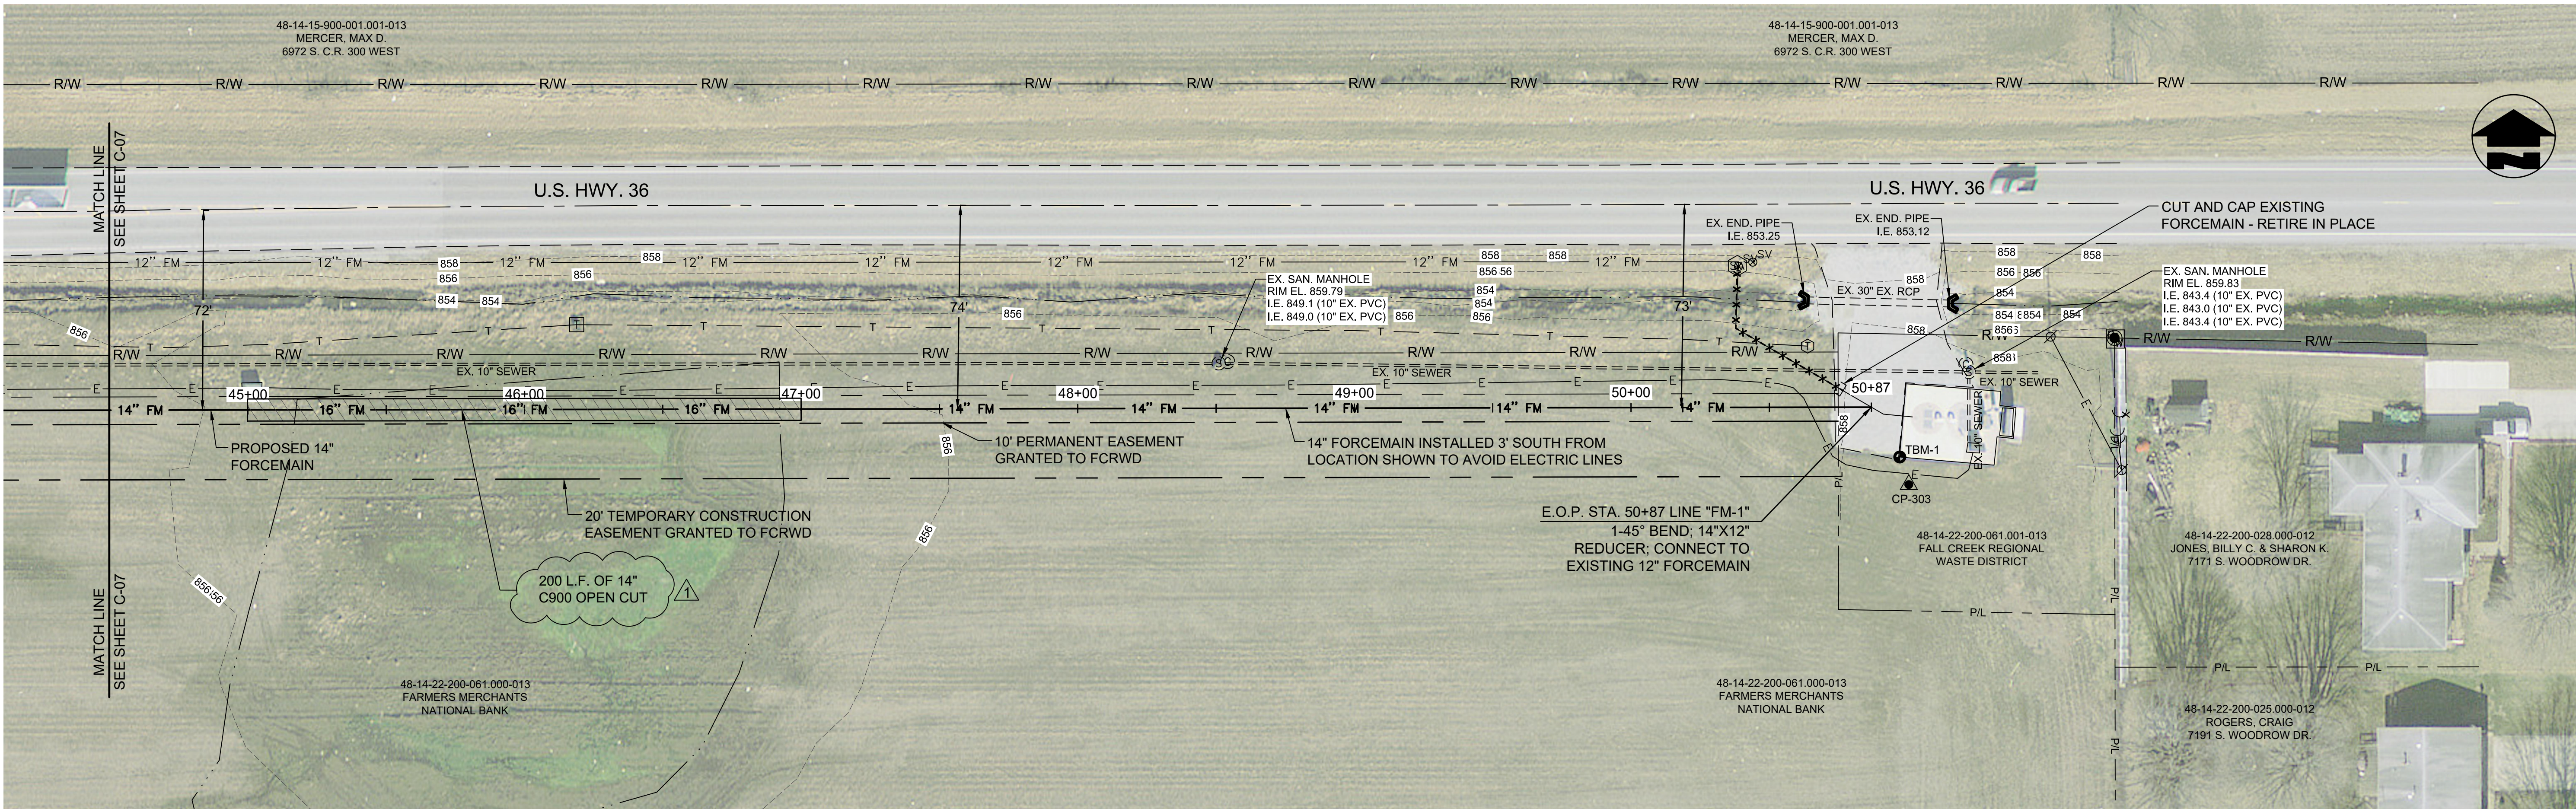

PLAN VIEW - STA. 44+50 TO E.O.P. STA. 50+87 LINE "FM-1"

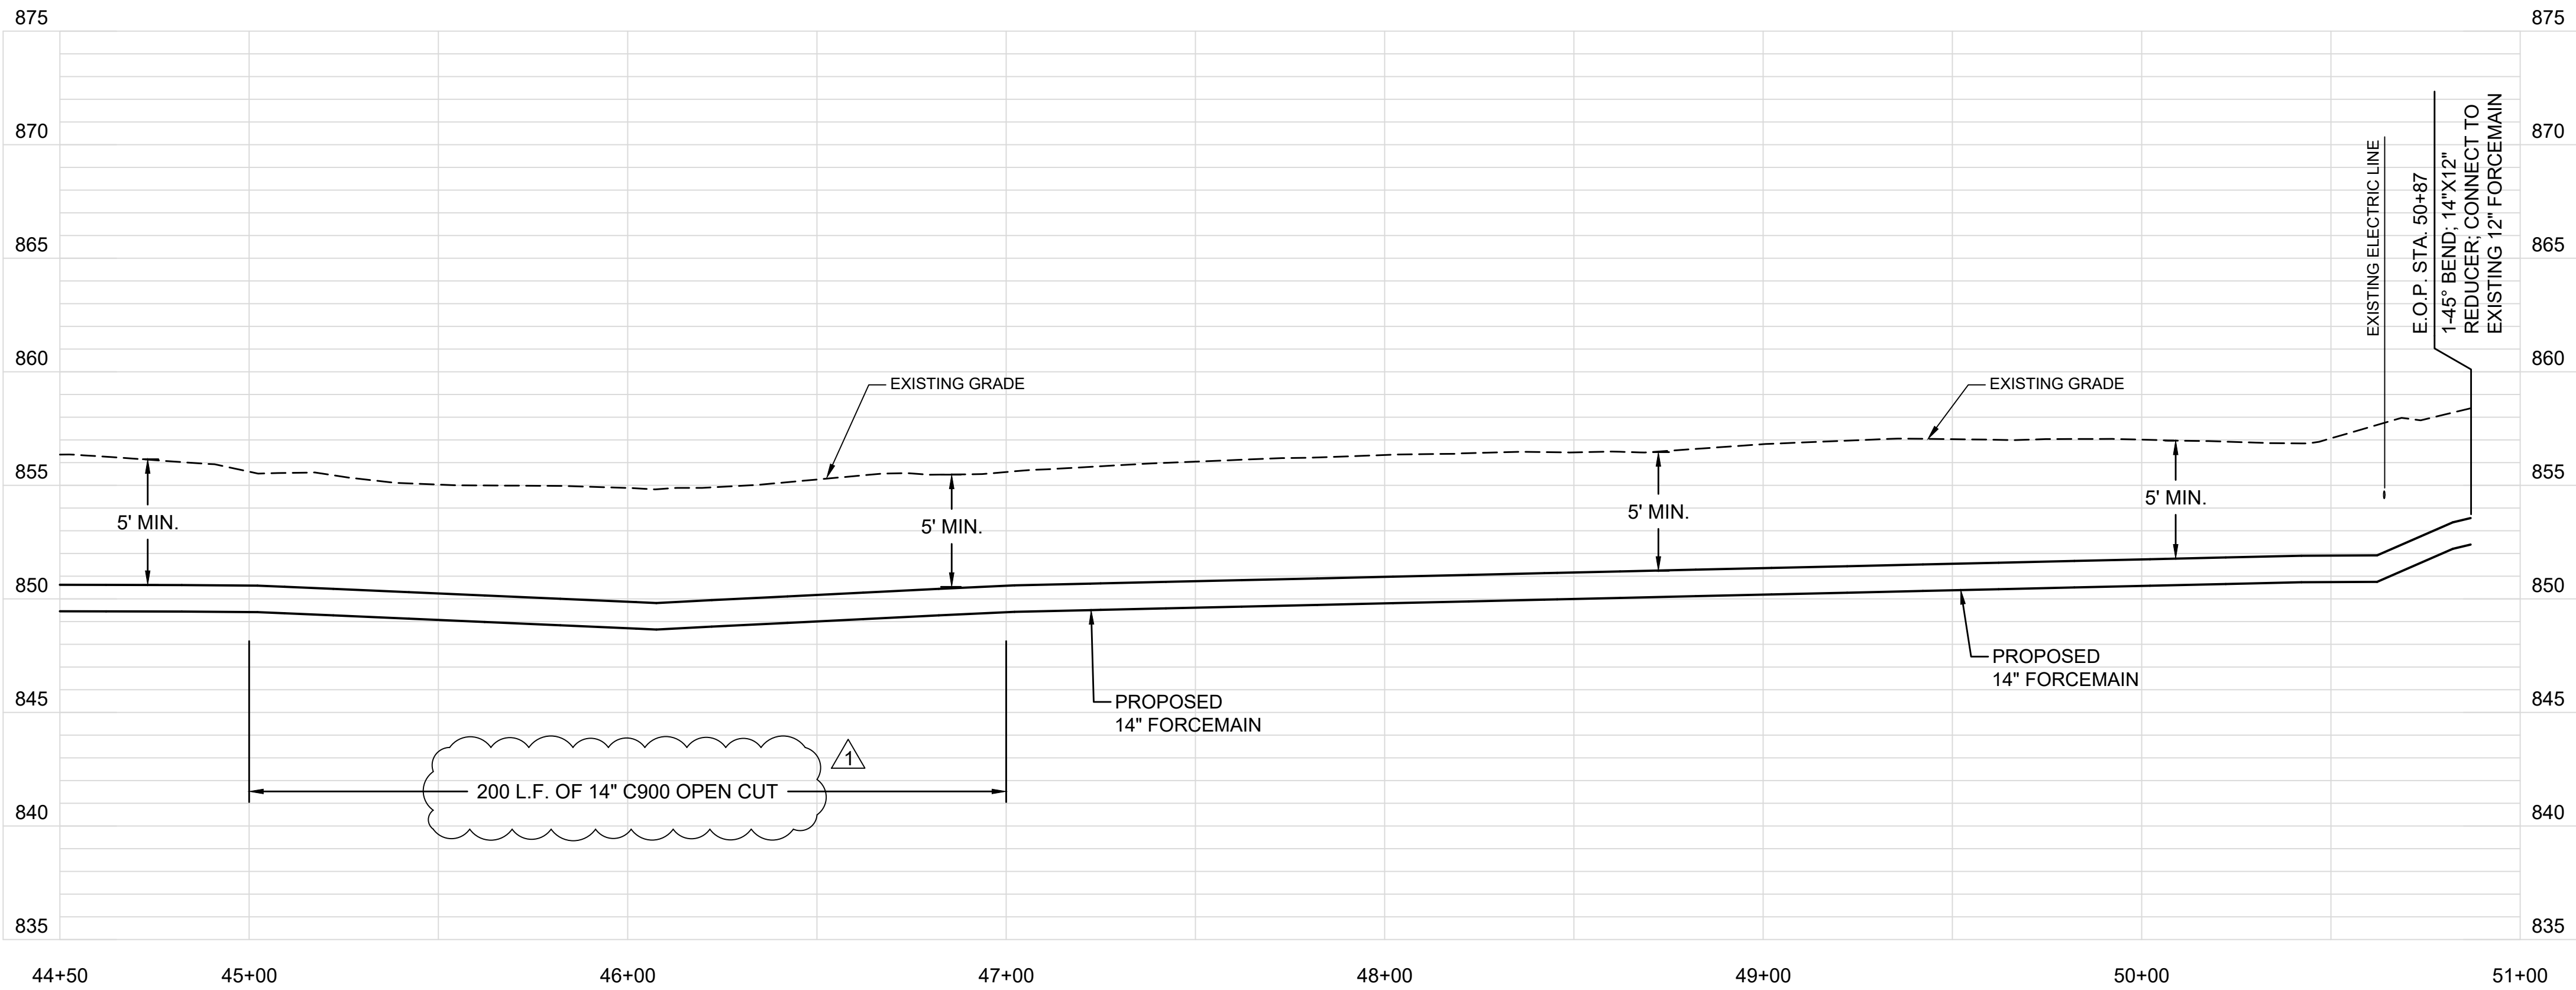


PROFILE - STA. 44+50 TO E.O.P. STA. 50+87 LINE "FM-1"

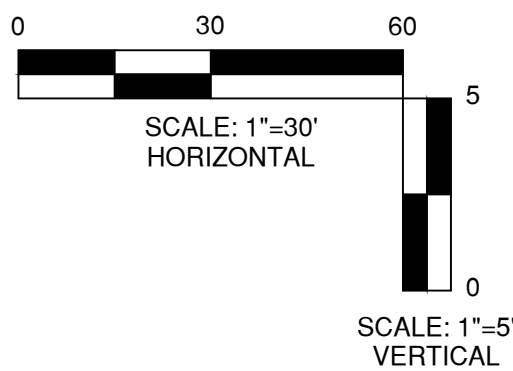

This document, originally issued, sealed, and signed by George W. Lewis, Indiana Professional Engineer, No. 10403303, on 7.2.2018, shall not be used in lieu of a certified document.

GRW PROJECT NO. 4635
 CLIENT PROJECT NO. -
 ALL RIGHTS RESERVED. THIS DOCUMENT IS THE PROPERTY OF GRW ENGINEERS, INC. AND SHALL BE REPRODUCED IN WHOLE OR IN PART WITHOUT WRITTEN PERMISSION.

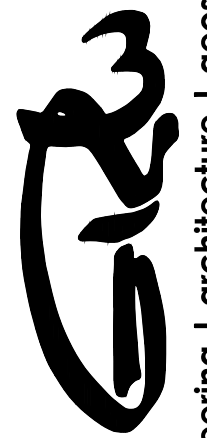

engineering | architecture | geospatial

www.grwinc.com

PLAN AND PROFILE
 LINE "FM-1"
 US 36 FORCEMAIN REPLACEMENT
 TOWN OF PENDLETON, INDIANA

DESIGNED		BY		DATE	
GWL		GWL		9-18	

DRAWN		REVIEWED		APPROVED	
JRD		GWL		GWL	

REVISIONS		DESCRIPTION	
NO.	DATE	DESCRIPTION	BY
1	9-18	PIPE SIZE REVISION	GWL

DATE: JANUARY 2018
 SCALE: 1"=30'
 SHEET NO.

C-08