

PLOTTED BY: Johnson

PRINTED: 12/19/2019 @ 4:48PM

FILE NAME: G:\4635-FRWD-US 36\Working Drawings\AutoCAD\4635-C-09.dwg

THIS RECORD DOCUMENT HAS BEEN PREPARED BASED ON INFORMATION PROVIDED BY THE CONSTRUCTION CONTRACTOR. GRW ENGINEERS, INC. HAS ATTEMPTED TO VERIFY THE ACCURACY AND/OR COMPLETENESS OF THIS INFORMATION BUT SHALL NOT BE RESPONSIBLE FOR ANY ERRORS OR OMISSIONS WHICH MAY BE INCORPORATED HEREIN AS A RESULT.




engineering | architecture | geospatial


ENGINEER/ARCHITECT: GEORGE LEWIS

CONSTRUCTION COMPANY: S.C. CASE EXCAVATING


DATE: 12/2019

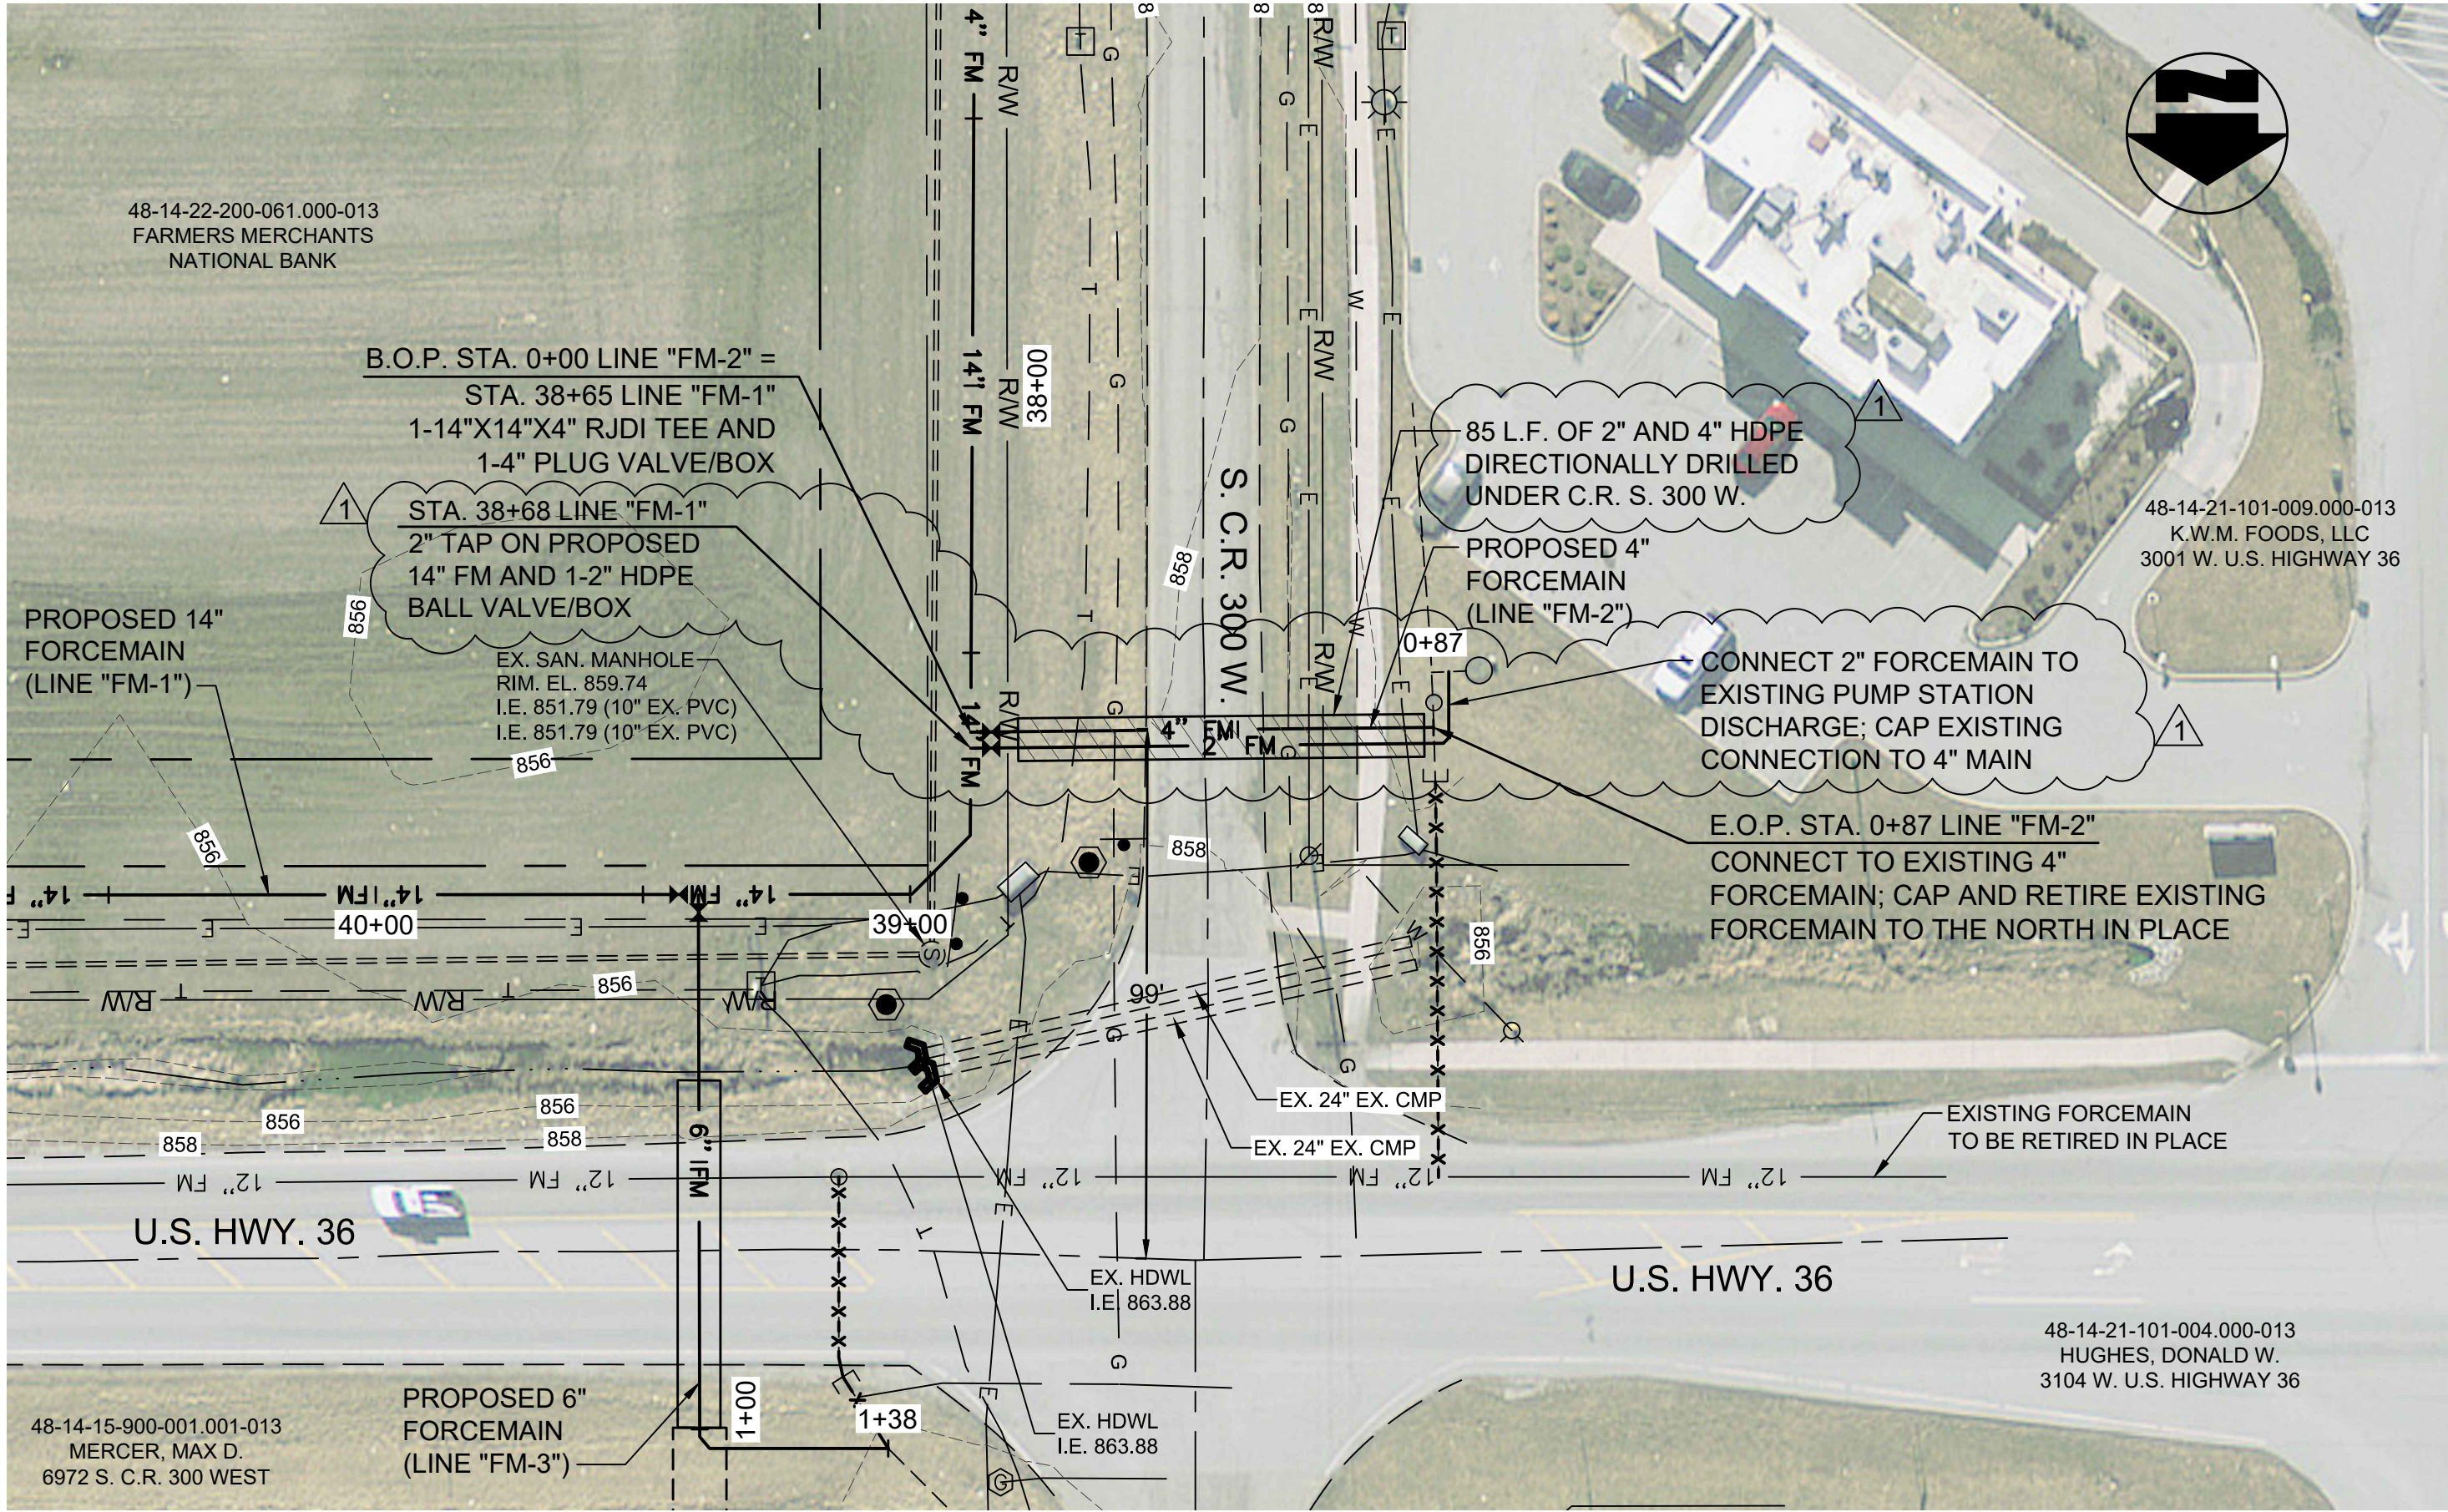


PLAN VIEW - B.O.P. STA. 0+00 TO E.O.P. STA. 0+87 LINE "FM-2"

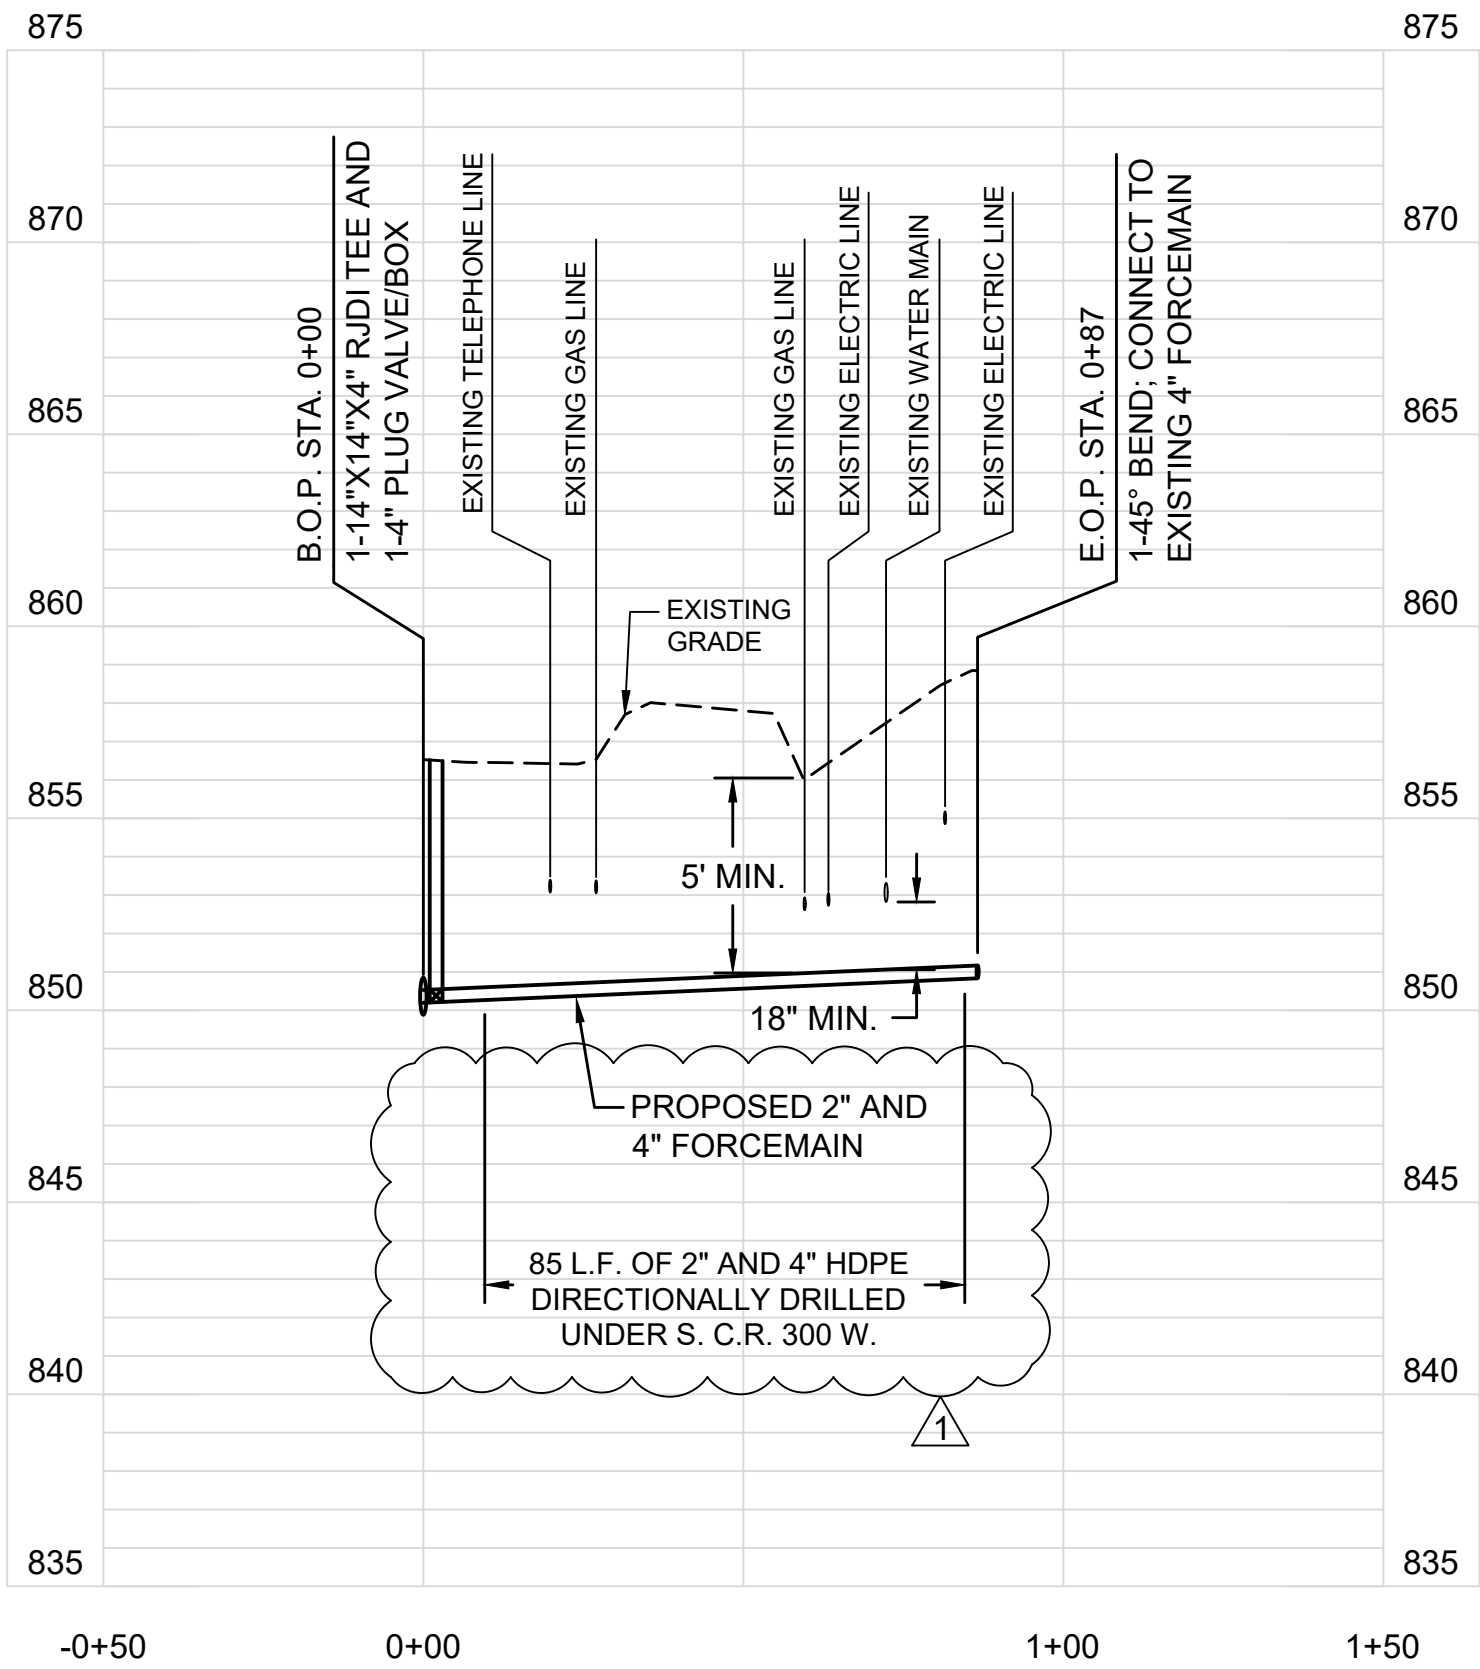


PROFILE - B.O.P. STA. 0+00 TO E.O.P. STA. 0+87 LINE "FM-2"

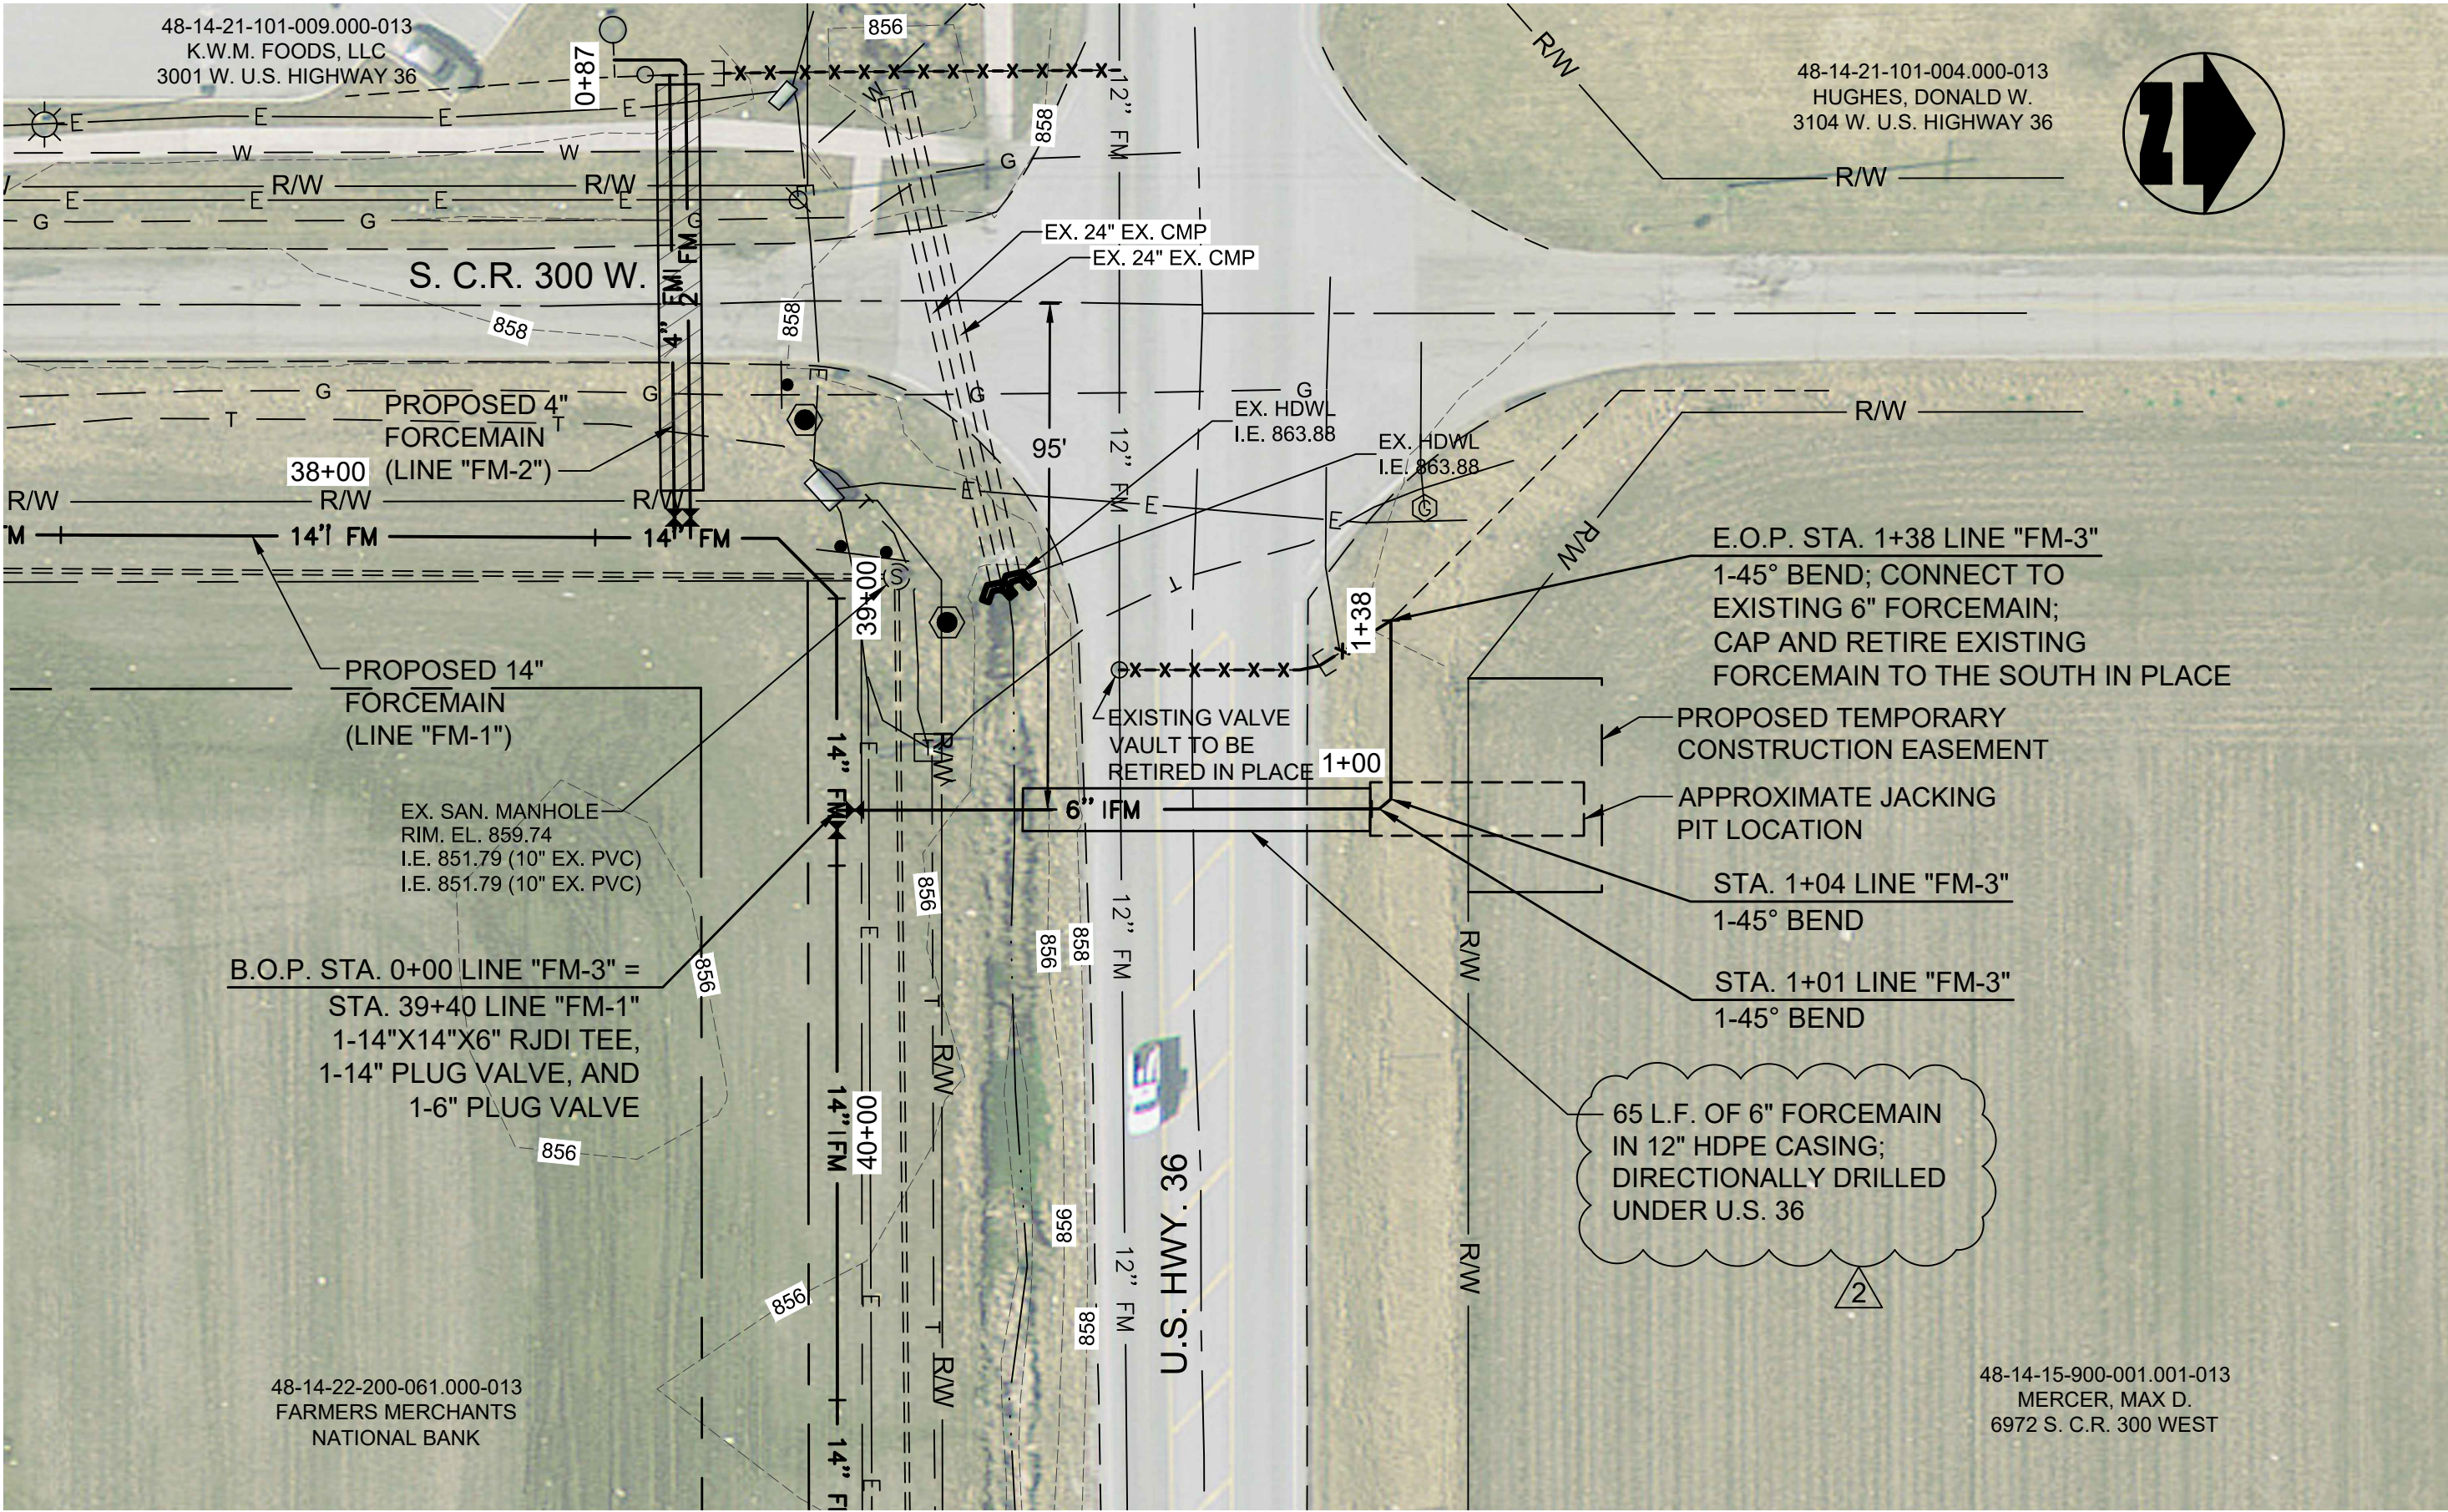

PLAN VIEW - B.O.P. STA. 0+00 TO E.O.P. STA. 1+38 LINE "FM-3"

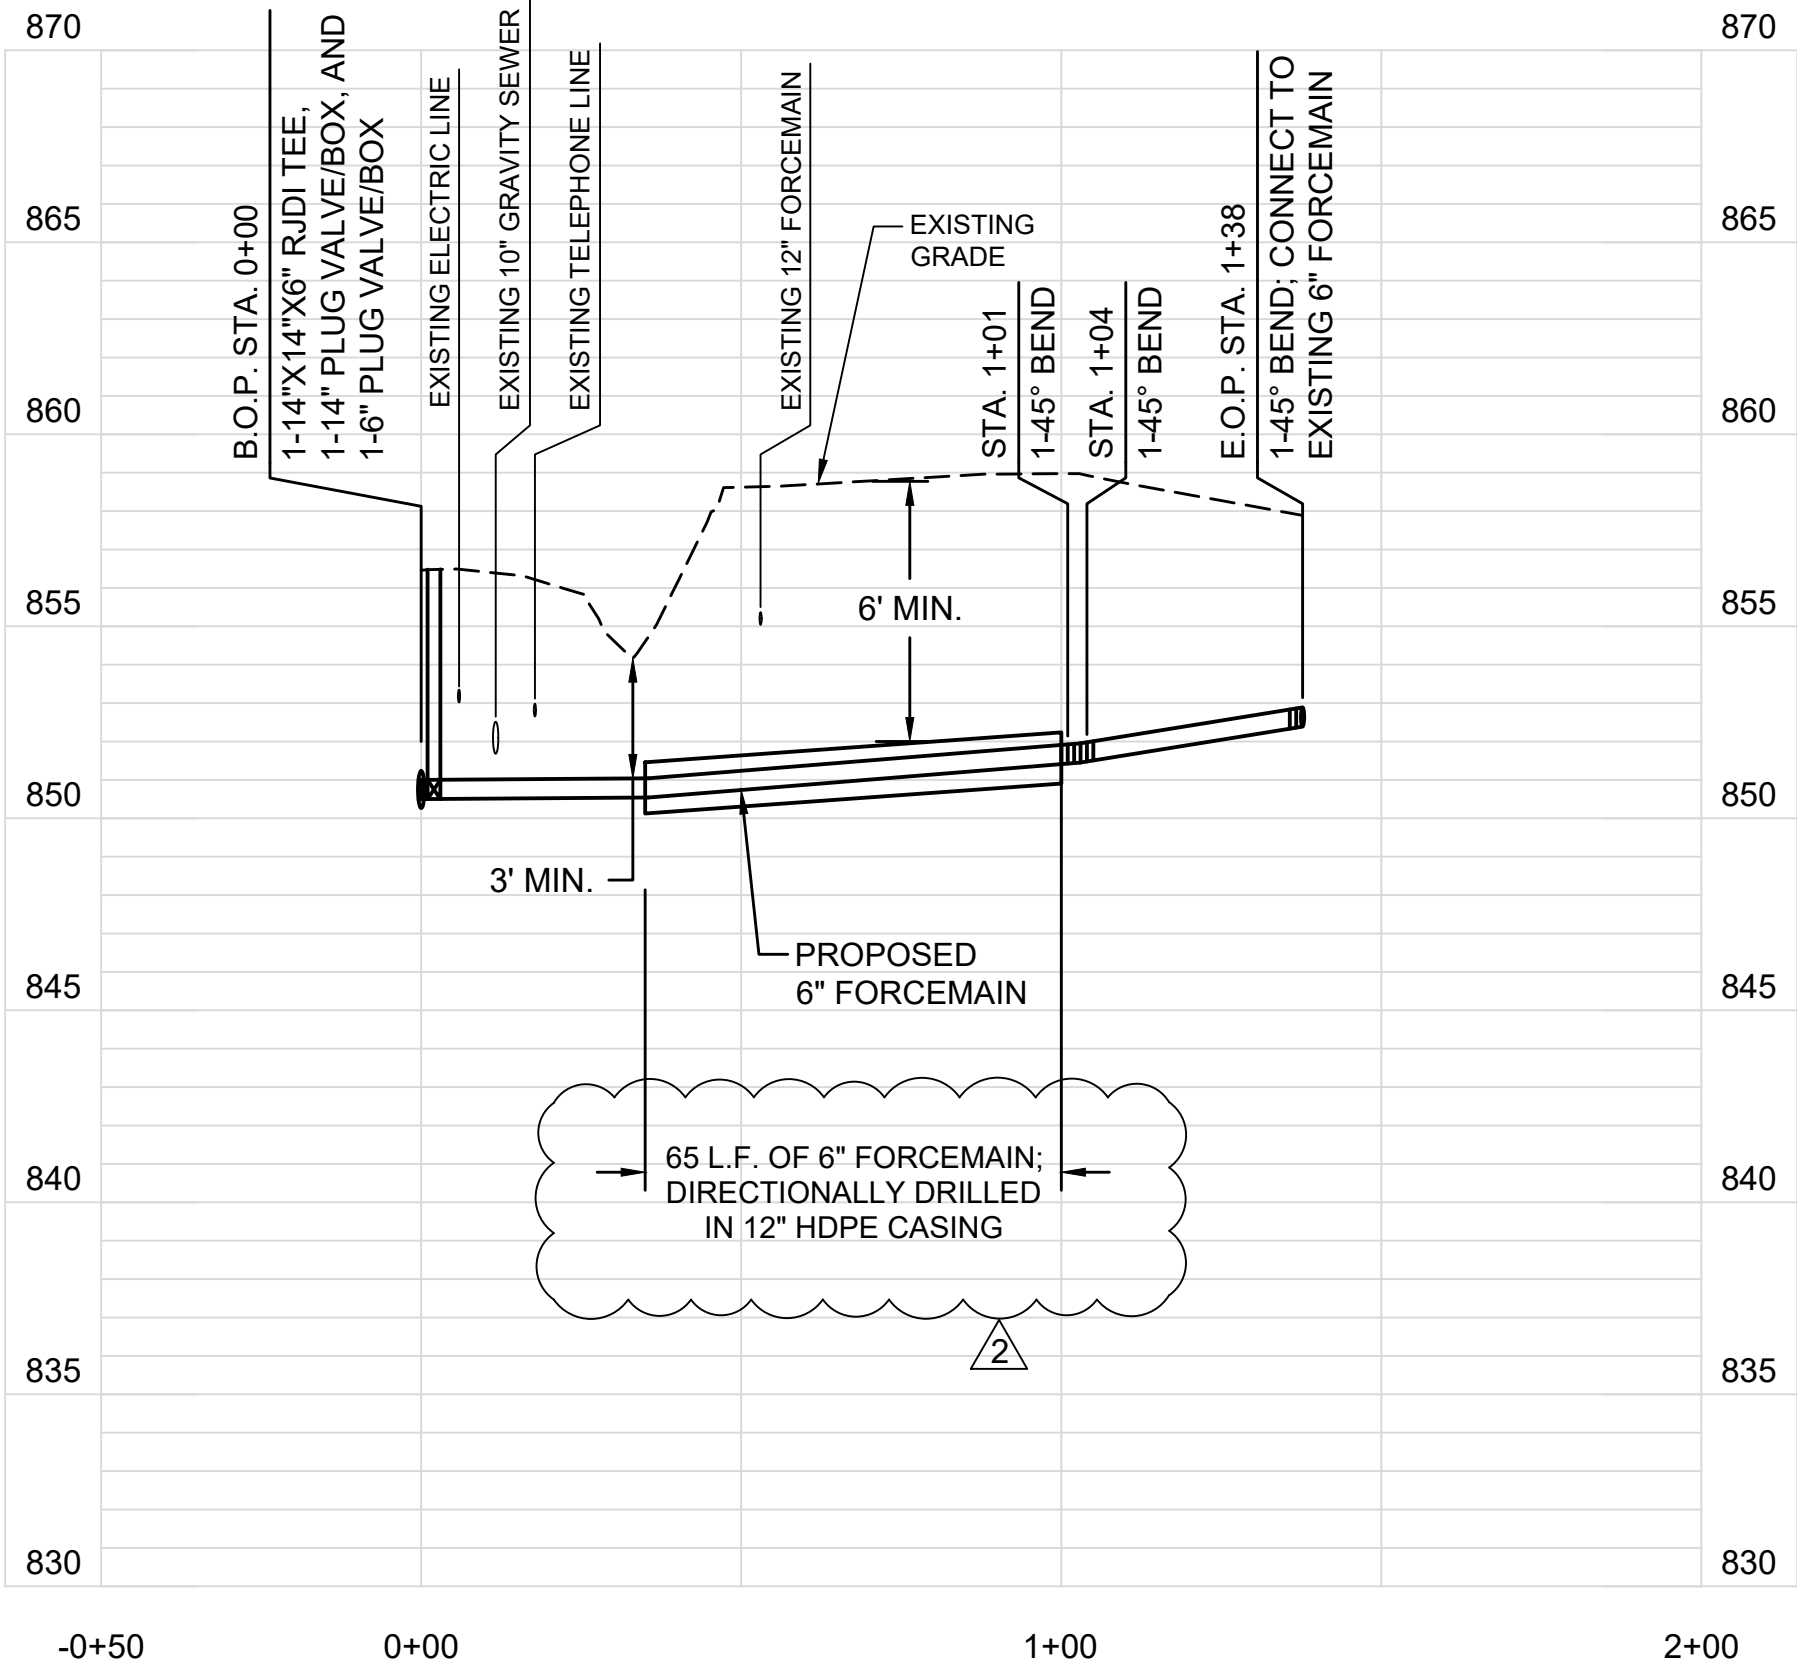

PROFILE - B.O.P. STA. 0+00 TO E.O.P. STA. 1+38 LINE "FM-3"

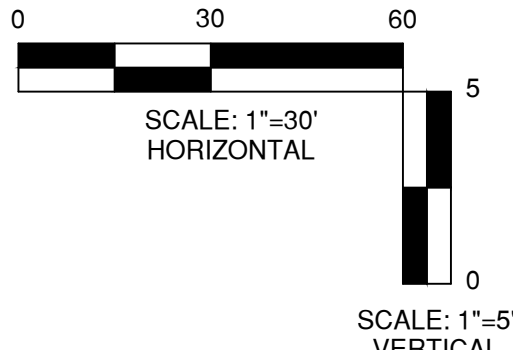


This document, originally issued, sealed, and signed by George W. Lewis, Indiana Professional Engineer, No. 10403303, on 7.2.2018, shall not be used in lieu of a certified document.

GRW PROJECT NO. 4635

CLIENT PROJECT NO. -

ALL RIGHTS RESERVED. THIS DOCUMENT IS THE PROPERTY OF GRW ENGINEERS, INC. AND SHALL BE REPRODUCED IN WHOLE OR IN PART WITHOUT WRITTEN PERMISSION.

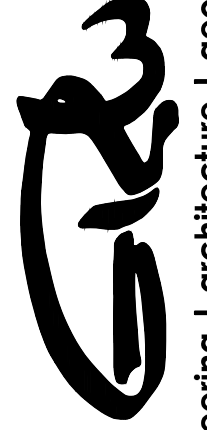

engineering | architecture | geospatial

www.grwinc.com

PLAN AND PROFILE

LINE "FM-2" AND "FM-3"

US 36 FORCEMAIN REPLACEMENT

TOWN OF PENDLETON, INDIANA

NO.	DATE	BY	DESCRIPTION	DESIGNED	BY	DATE	DESCRIPTION	REVIEWED	BY	DATE	DESCRIPTION
1	7/2018	GWL	ADDENDUM #1	GWL	GWL	7/2018	PIPE SIZE REVISION	GWL	GWL	7/2018	PIPE SIZE REVISION
2											

DATE: JULY 2018

SCALE: 1"=30'

SHEET NO. C-09