

PLOTTED BY: Johnson

PRINTED: 12/19/2019 @ 4:09PM

FILE NAME: G:\4635-FORWD-US 36\Working Drawings\AutoCAD\4635-C-14.dwg

THIS RECORD DOCUMENT HAS BEEN PREPARED BASED ON INFORMATION PROVIDED BY THE CONSTRUCTION CONTRACTOR, GRW ENGINEERS, INC. HAS ATTEMPTED TO VERIFY THE ACCURACY AND/OR COMPLETENESS OF THIS INFORMATION BUT SHALL NOT BE RESPONSIBLE FOR ANY ERRORS OR OMISSIONS WHICH MAY BE INCORPORATED HEREIN AS A RESULT.




engineering | architecture | geospatial


ENGINEER/ARCHITECT: GEORGE LEWIS

CONSTRUCTION COMPANY: S.C. CASE EXCAVATING


DATE: 12/2019

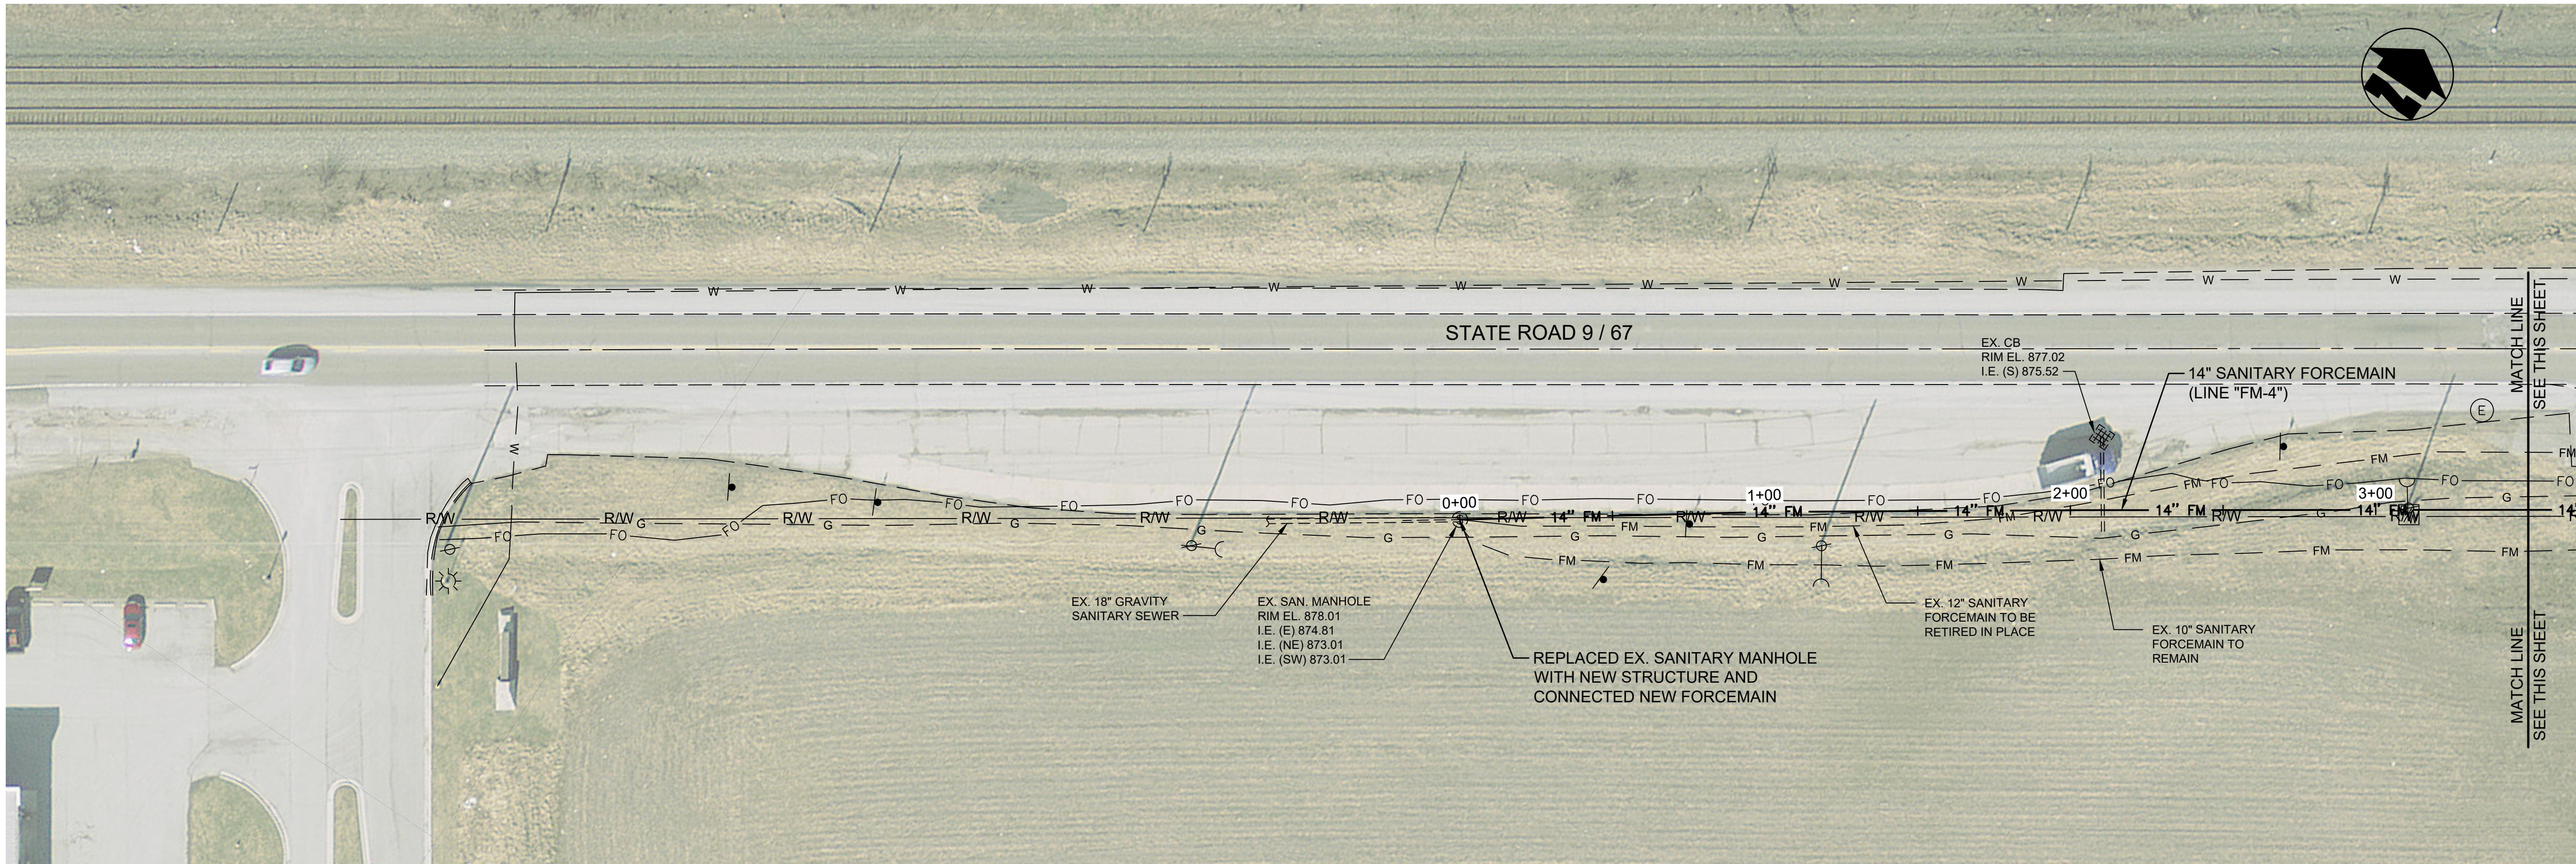

PLAN VIEW - B.O.P. STA. 0+00 TO STA. 3+50 LINE "FM-4"

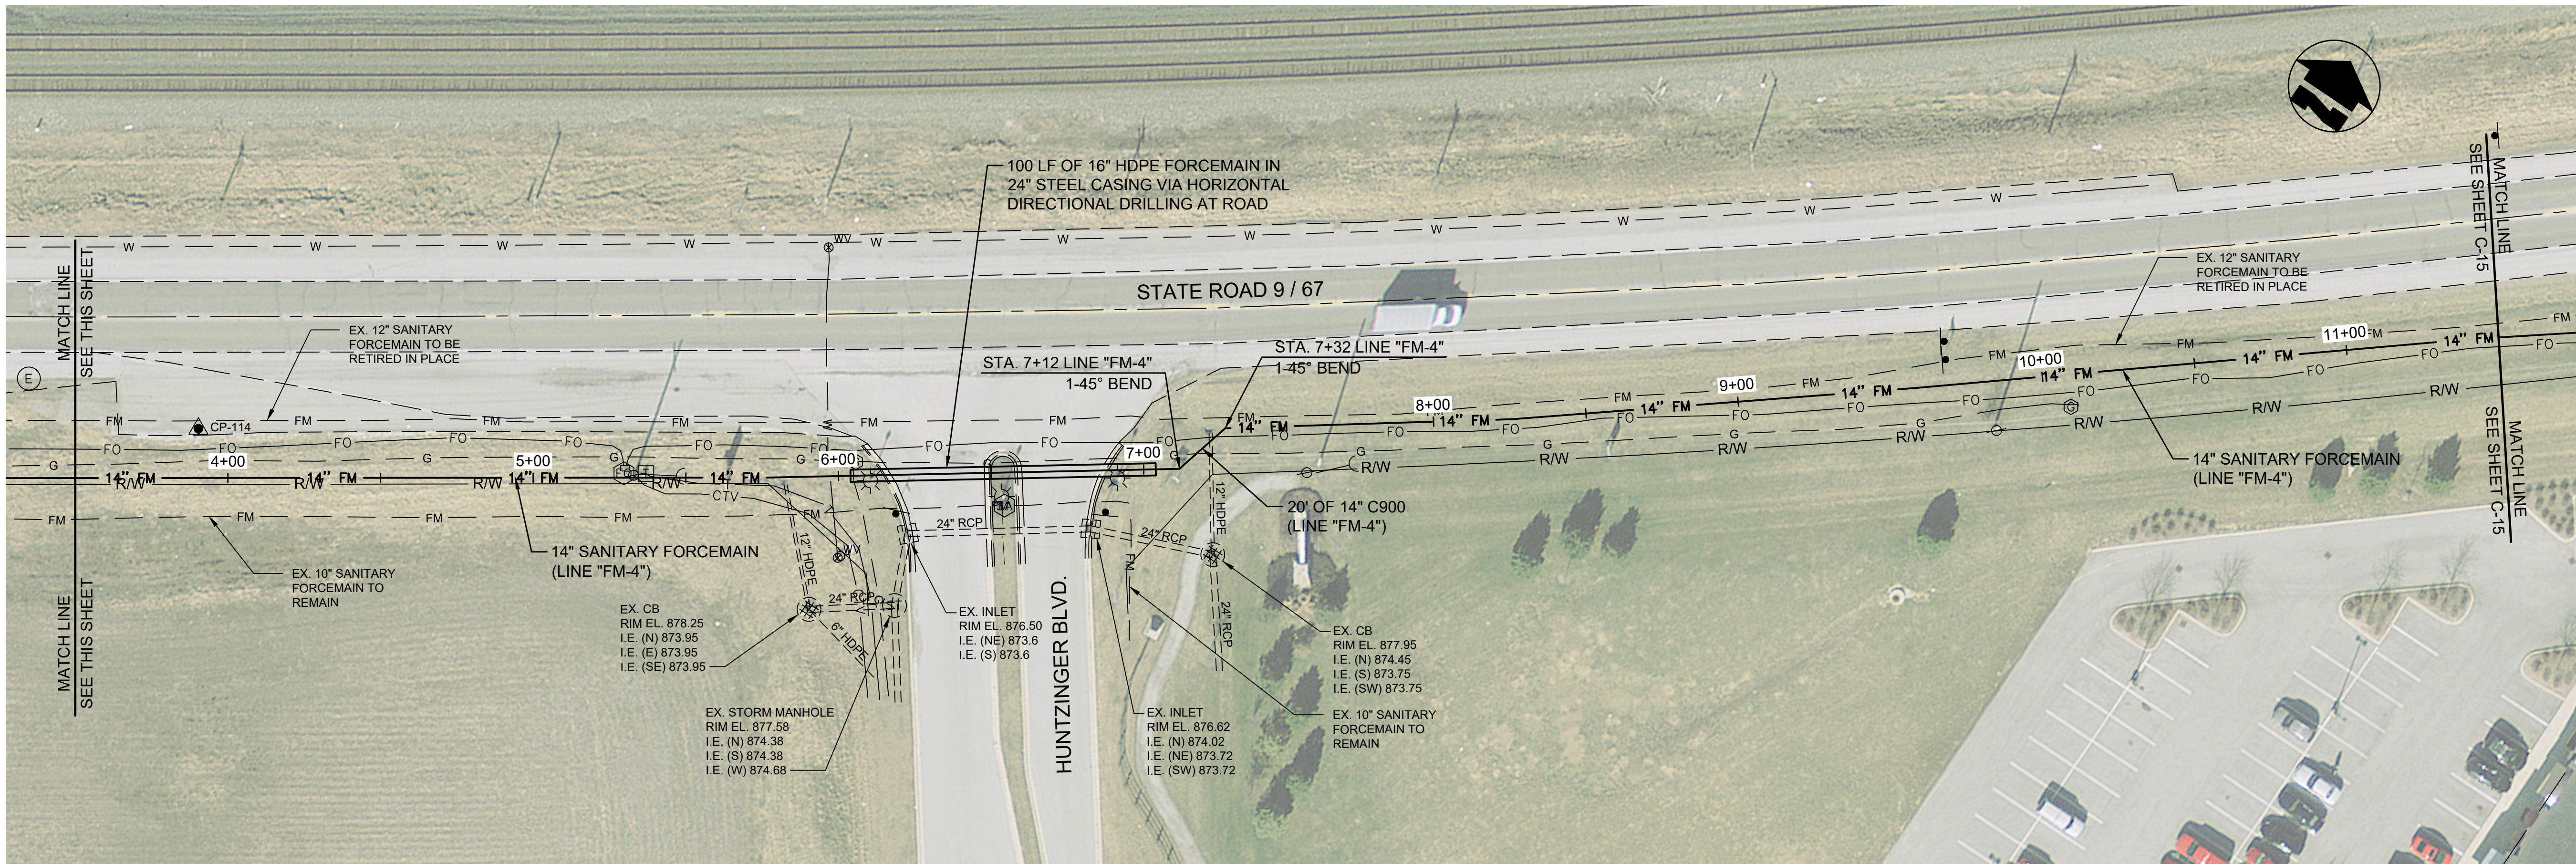

PLAN VIEW - STA. 3+50 TO STA. 11+50 LINE "FM-4"

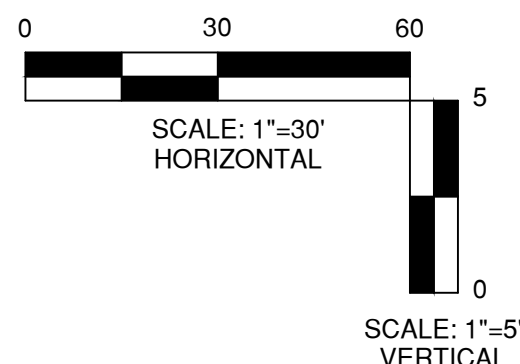

This document, originally issued, sealed, and signed by George W. Lewis, Indiana Professional Engineer, No. 10403303, on 7.2.2018, shall not be used in lieu of a certified document.

GRW PROJECT NO. 4635	CLIENT PROJECT NO. -	ALL RIGHTS RESERVED. THIS DOCUMENT IS THE PROPERTY OF GRW ENGINEERS, INC. IT IS TO BE REPRODUCED IN WHOLE OR IN PART WITHOUT WRITTEN PERMISSION.
 engineering architecture geospatial www.grwinc.com		

PLAN

US 36 FORCEMAIN REPLACEMENT

TOWN OF PENDLETON, INDIANA

DESIGNED	BY	DATE	REVIEWED	DATE	APPROVED
GWL			JAU		GWL

REVISIONS

NO.	DESCRIPTION

DATE: JULY 2018

SCALE: 1"=30'

SHEET NO. C-14

SCALE CHECK: ☐ THIS MARK SHOULD MEASURE EXACTLY 1" WHEN PLOTTED