



PLOTTED BY: Johnson

PRINTED: 12/19/2019 @ 4:46PM

FILE NAME: G:\4635-FCRWD-US 36\Working Drawings\AutoCAD\4635-C-03.dwg

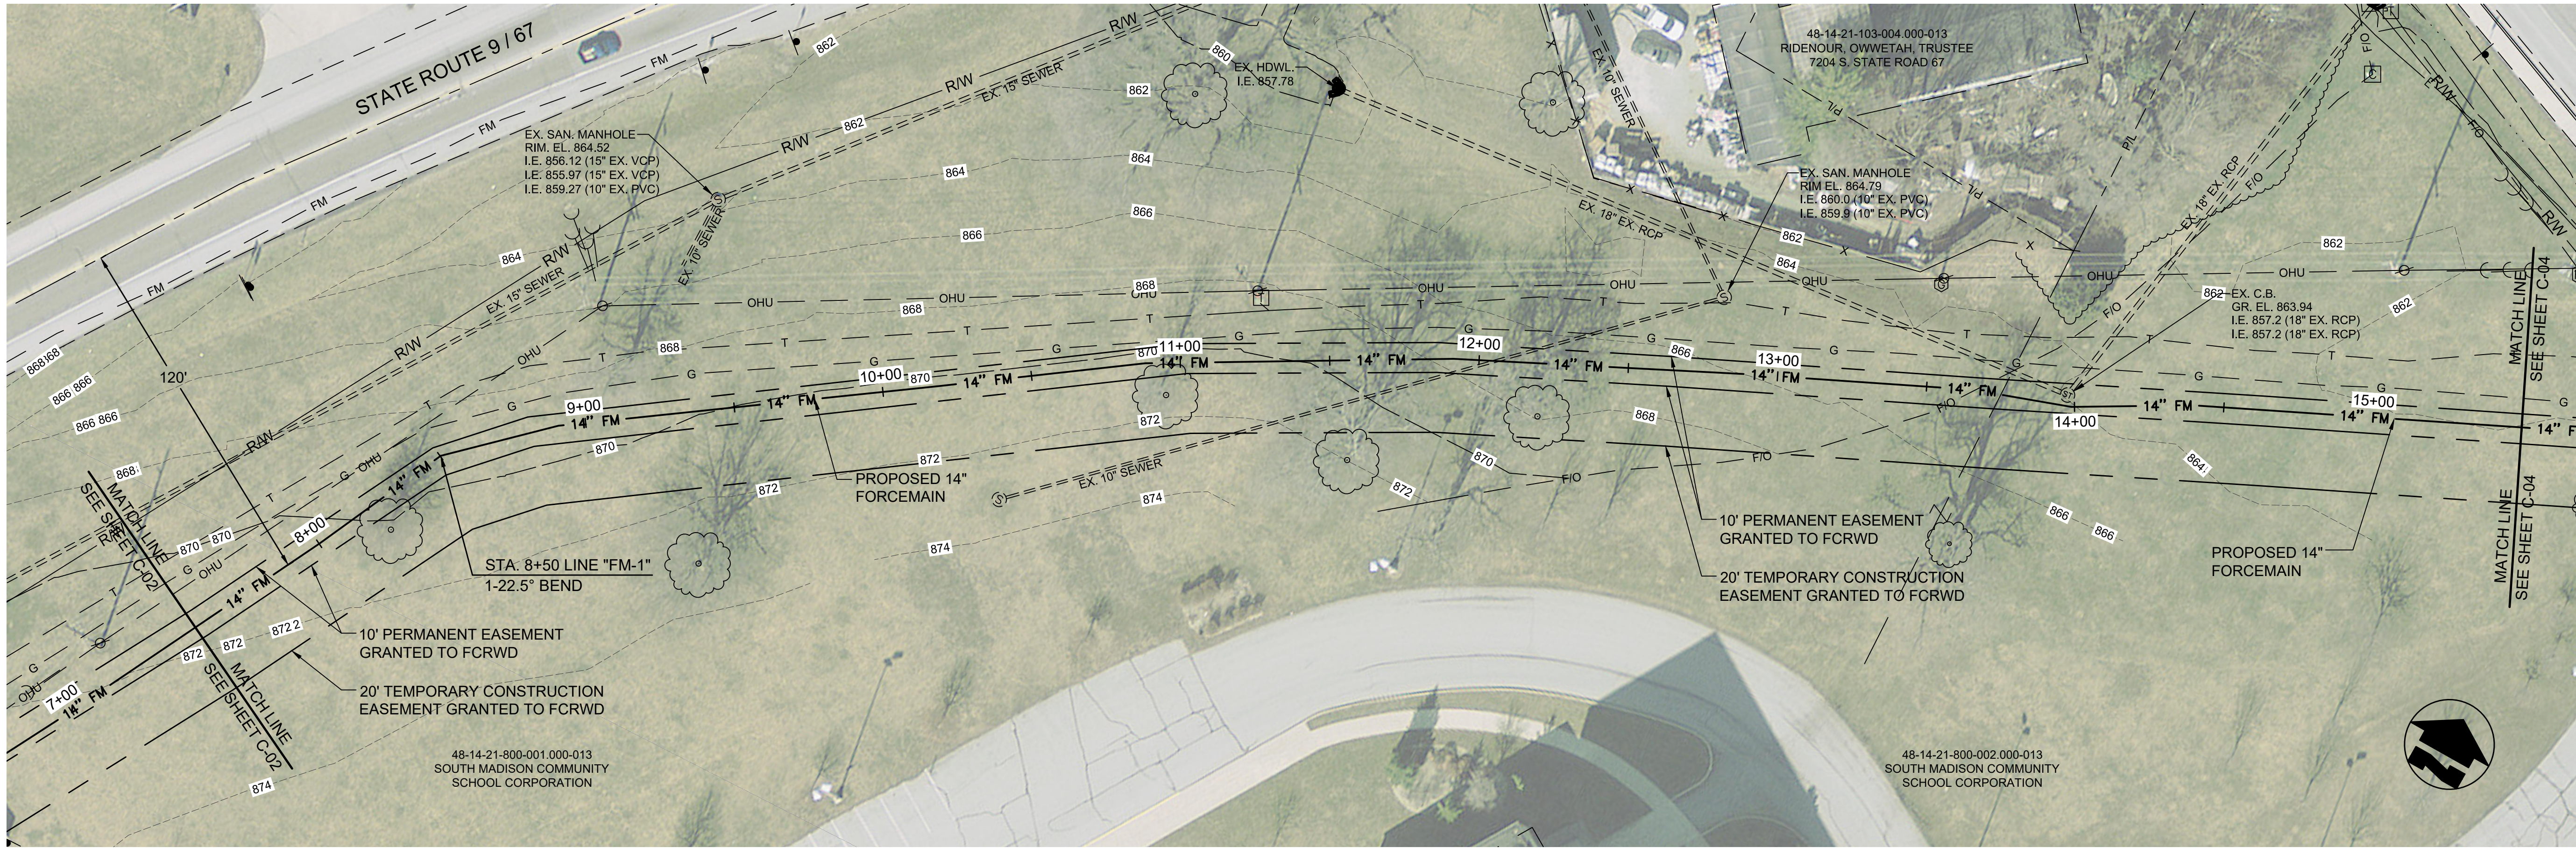

PLAN VIEW - STA. 7+50 TO STA. 15+50 LINE "FM-1"

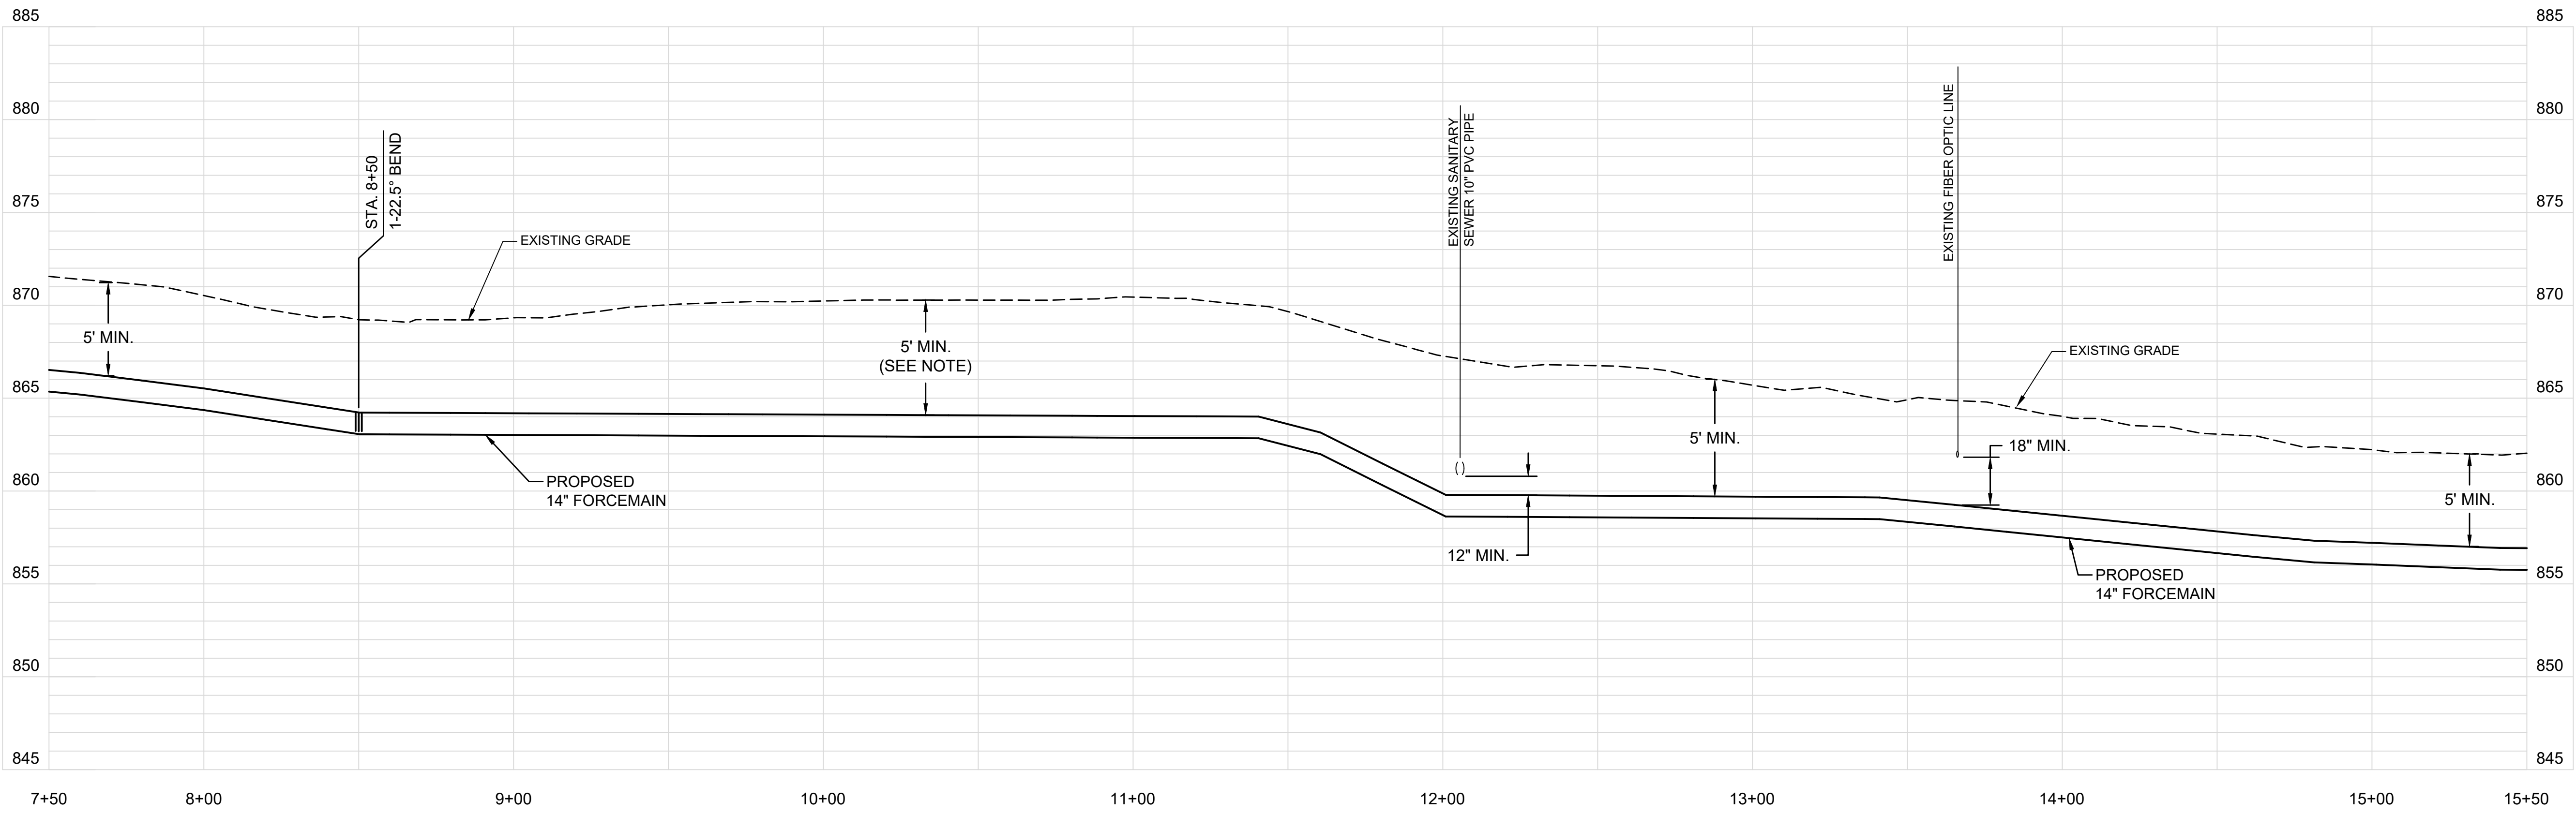

PROFILE - STA. 7+50 TO STA. 15+50 LINE "FM-1"

NOTE:
INSTALL FORCEMAIN ON EVEN
GRADE TO PREVENT HIGH POINT


THIS RECORD DOCUMENT HAS BEEN PREPARED BASED ON INFORMATION PROVIDED BY THE CONSTRUCTION CONTRACTOR. GRW ENGINEERS, INC. HAS ATTEMPTED TO VERIFY THE ACCURACY AND/OR COMPLETENESS OF THIS INFORMATION BUT SHALL NOT BE RESPONSIBLE FOR ANY ERRORS OR OMISSIONS WHICH MAY BE INCORPORATED HEREIN AS A RESULT.

engineering | architecture | geospatial

ENGINEER/ARCHITECT: GEORGE LEWIS

CONSTRUCTION COMPANY: S.C. CASE EXCAVATING

DATE: 12/2019

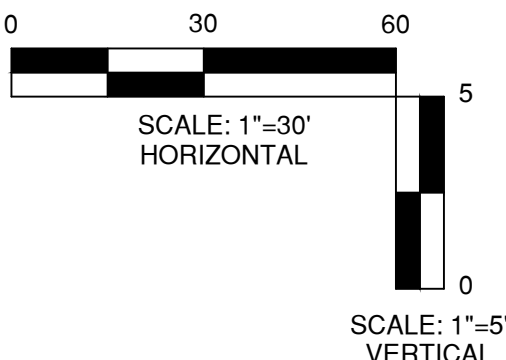

This document, originally issued, sealed, and signed by George W. Lewis, Indiana Professional Engineer, No. 10403303, on 7.2.2018, shall not be used in lieu of a certified document.

GRW PROJECT NO. 4635	CLIENT PROJECT NO. -
ALL RIGHTS RESERVED. THIS DOCUMENT IS THE PROPERTY OF GRW ENGINEERS, INC. AND SHALL BE REPRODUCED IN WHOLE OR IN PART WITHOUT WRITTEN PERMISSION.	

engineering | architecture | geospatial

www.grwinc.com

PLAN AND PROFILE
LINE "FM-1"
US 36 FORCEMAIN REPLACEMENT
TOWN OF PENDLETON, INDIANA

DESIGNED: GWL	DRAWN: JRD	REVIEWED: GWL	APPROVED: GWL
DATE	DATE	DATE	DATE
NO.	NO.	NO.	NO.
REVISIONS DESCRIPTION			
DATE			
SCALE: 1"=30'			
SHEET NO.			

C-03