



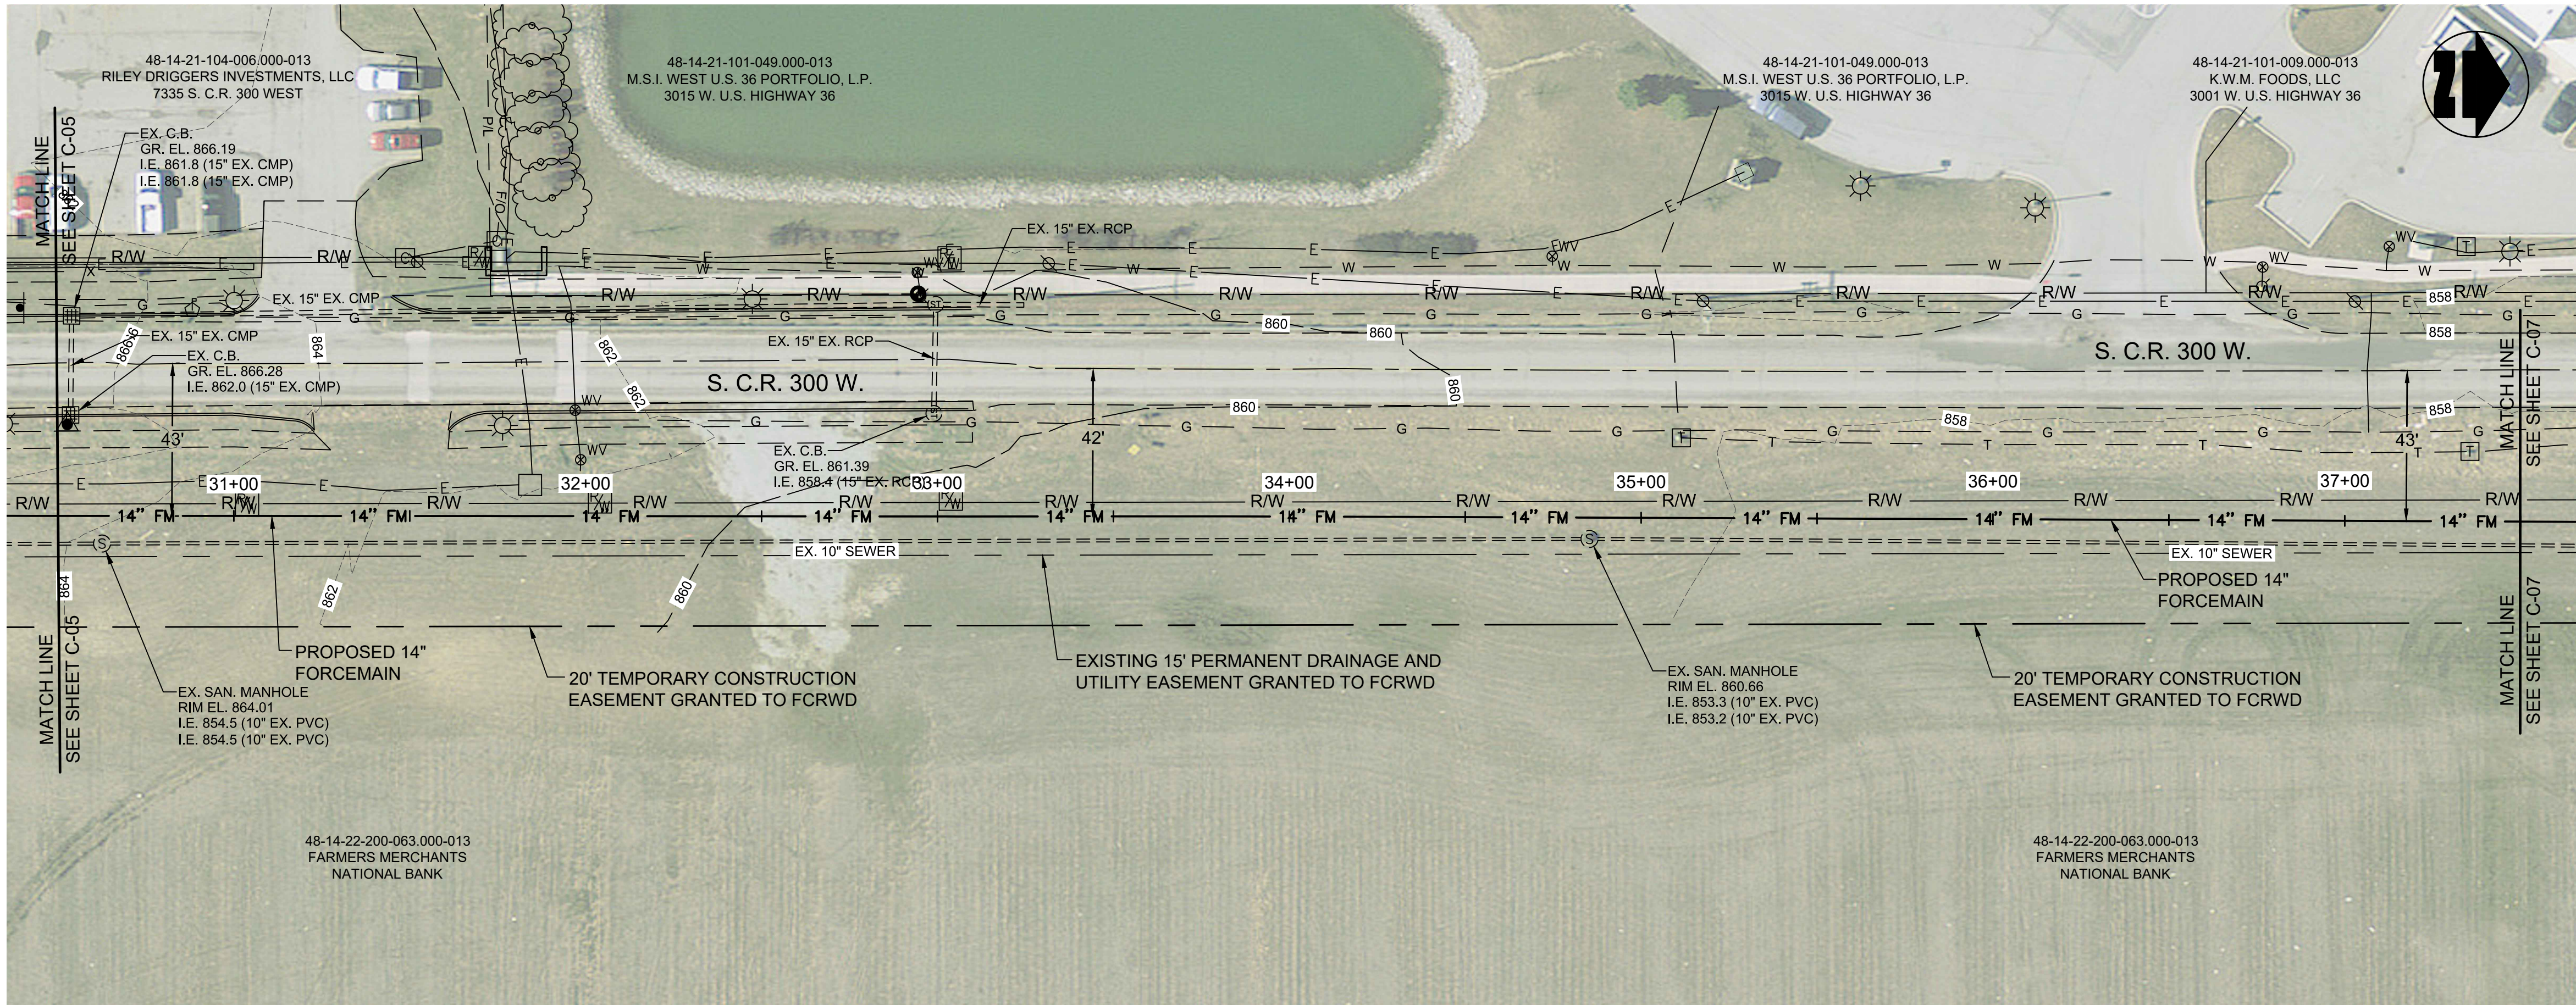

PLAN VIEW - STA. 30+50 TO STA. 37+50 LINE "FM-1"

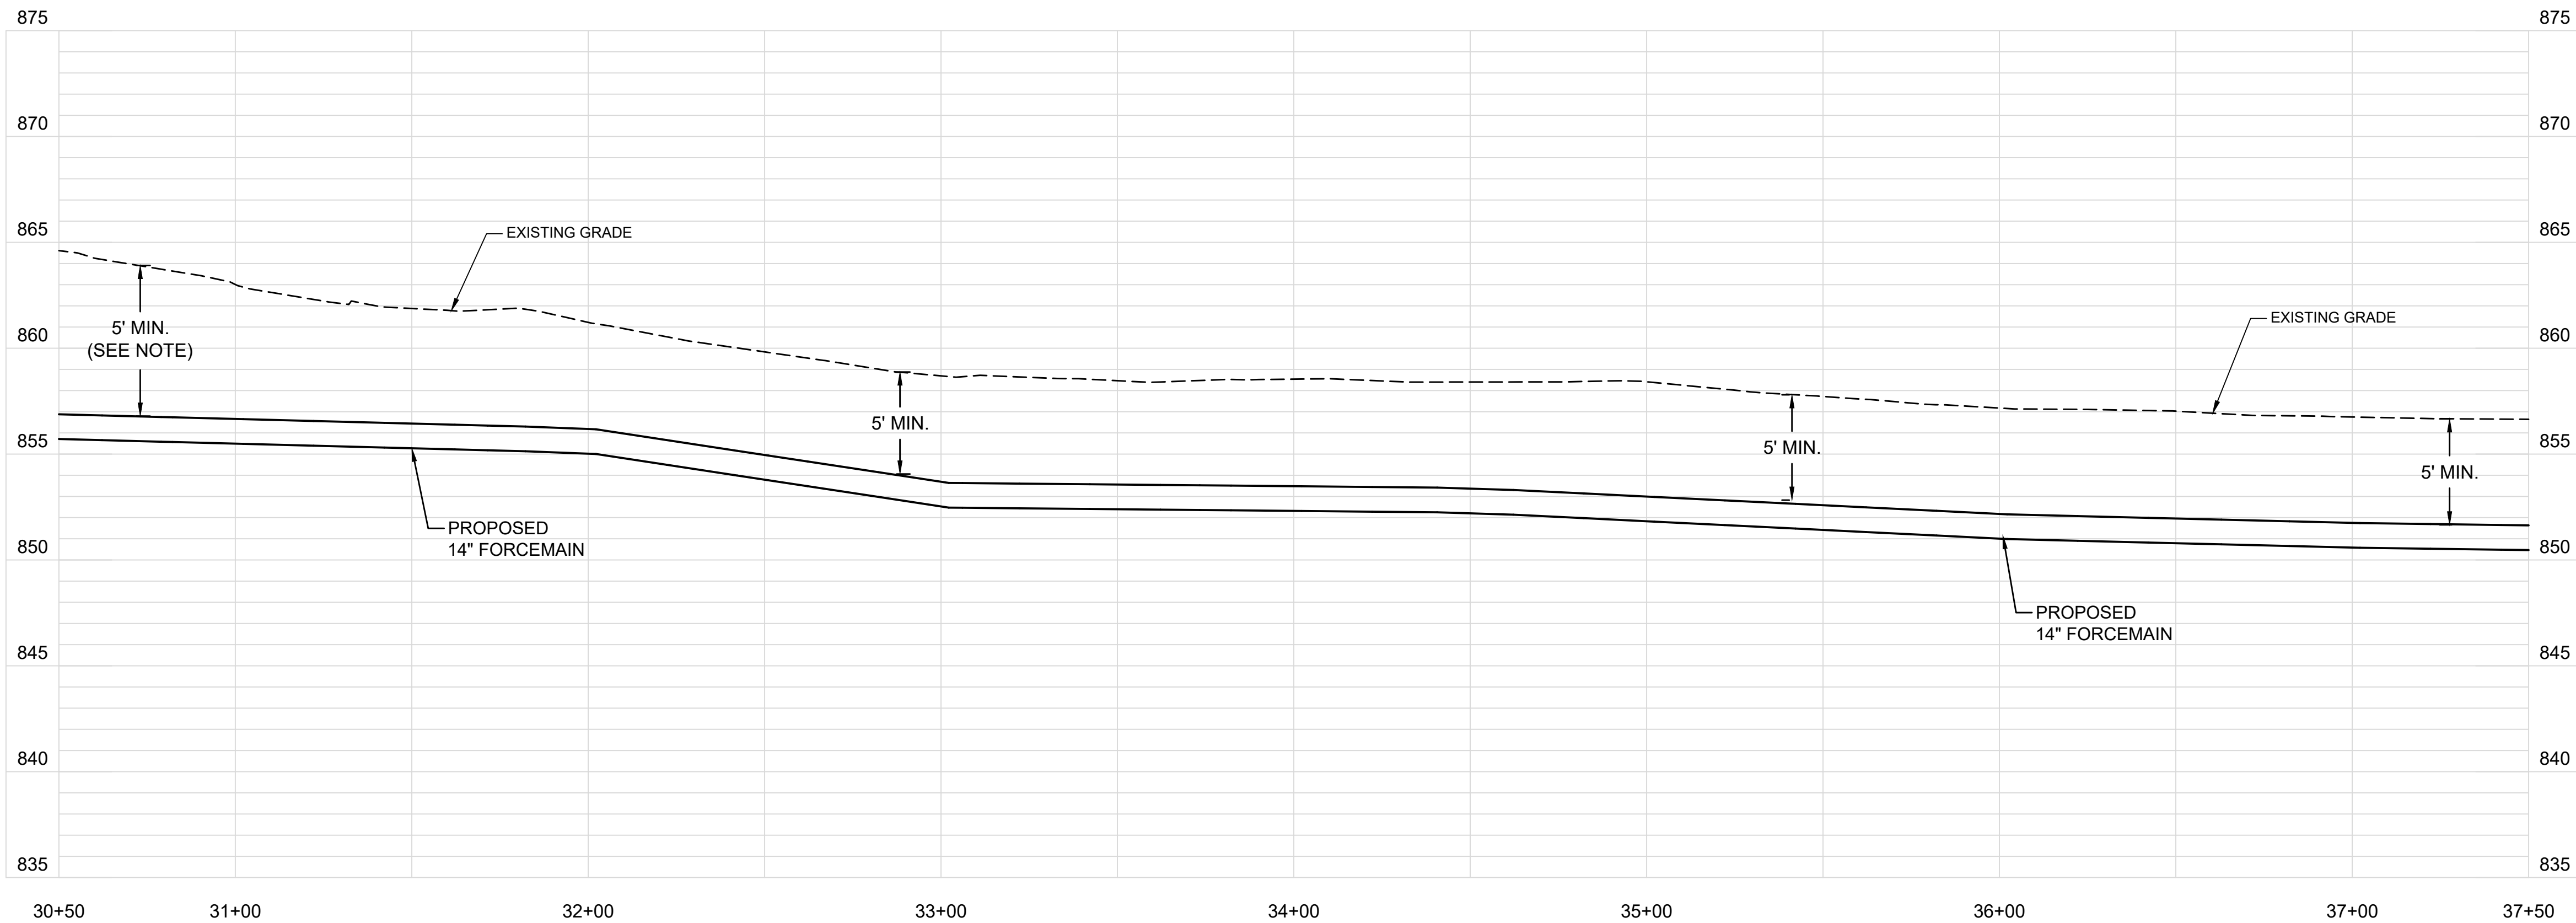

PROFILE - STA. 30+50 TO STA. 37+50 LINE "FM-1"

NOTE:

INSTALL FORCEMAIN ON EVEN GRADE TO PREVENT HIGH POINT

THIS RECORD DOCUMENT HAS BEEN PREPARED BASED ON INFORMATION PROVIDED BY THE CONSTRUCTION CONTRACTOR. GRWV ENGINEERS, INC. HAS ATTEMPTED TO VERIFY THE ACCURACY AND/OR COMPLETENESS OF THIS INFORMATION BUT SHALL NOT BE RESPONSIBLE FOR ANY ERRORS OR OMISSIONS WHICH MAY BE INCORPORATED HEREIN AS A RESULT.




engineering | architecture | geospatial

ENGINEER/ARCHITECT: GEORGE LEWIS

CONSTRUCTION COMPANY: S.C.S. CASE EXCAVATING

DATE: 12/2019

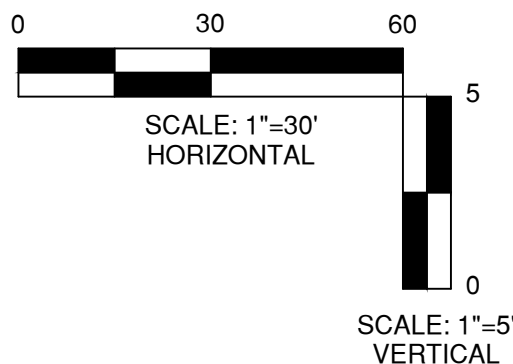

This document, originally issued, sealed, and signed by George W. Lewis, Indiana Professional Engineer, No. 10403303, on 7.2.2018, shall not be used in lieu of a certified document.

GRWV PROJECT NO. 4635

CLIENT PROJECT NO. -

ALL RIGHTS RESERVED. THIS DOCUMENT IS THE PROPERTY OF GRWV ENGINEERS, INC. IT IS TO BE REPRODUCED IN WHOLE OR IN PART WITHOUT WRITTEN PERMISSION.



engineering | architecture | geospatial

www.grwv.com

PLAN AND PROFILE  
 LINE "FM-1"  
 US 36 FORCEMAIN REPLACEMENT  
 TOWN OF PENDLETON, INDIANA

| NO. | DATE | BY | DESIGNED |     |     |     |
|-----|------|----|----------|-----|-----|-----|
|     |      |    | GWL      | JRD | GWL | GWL |
|     |      |    |          |     |     |     |

REVISIONS  
 DESCRIPTION

DATE

BY

THIS MARK SHOULD MEASURE EXACTLY 1" WHEN PLOTTED

SCALE CHECK

DATE: JULY 2018

SCALE: 1"=30'

SHEET NO.

C-06