


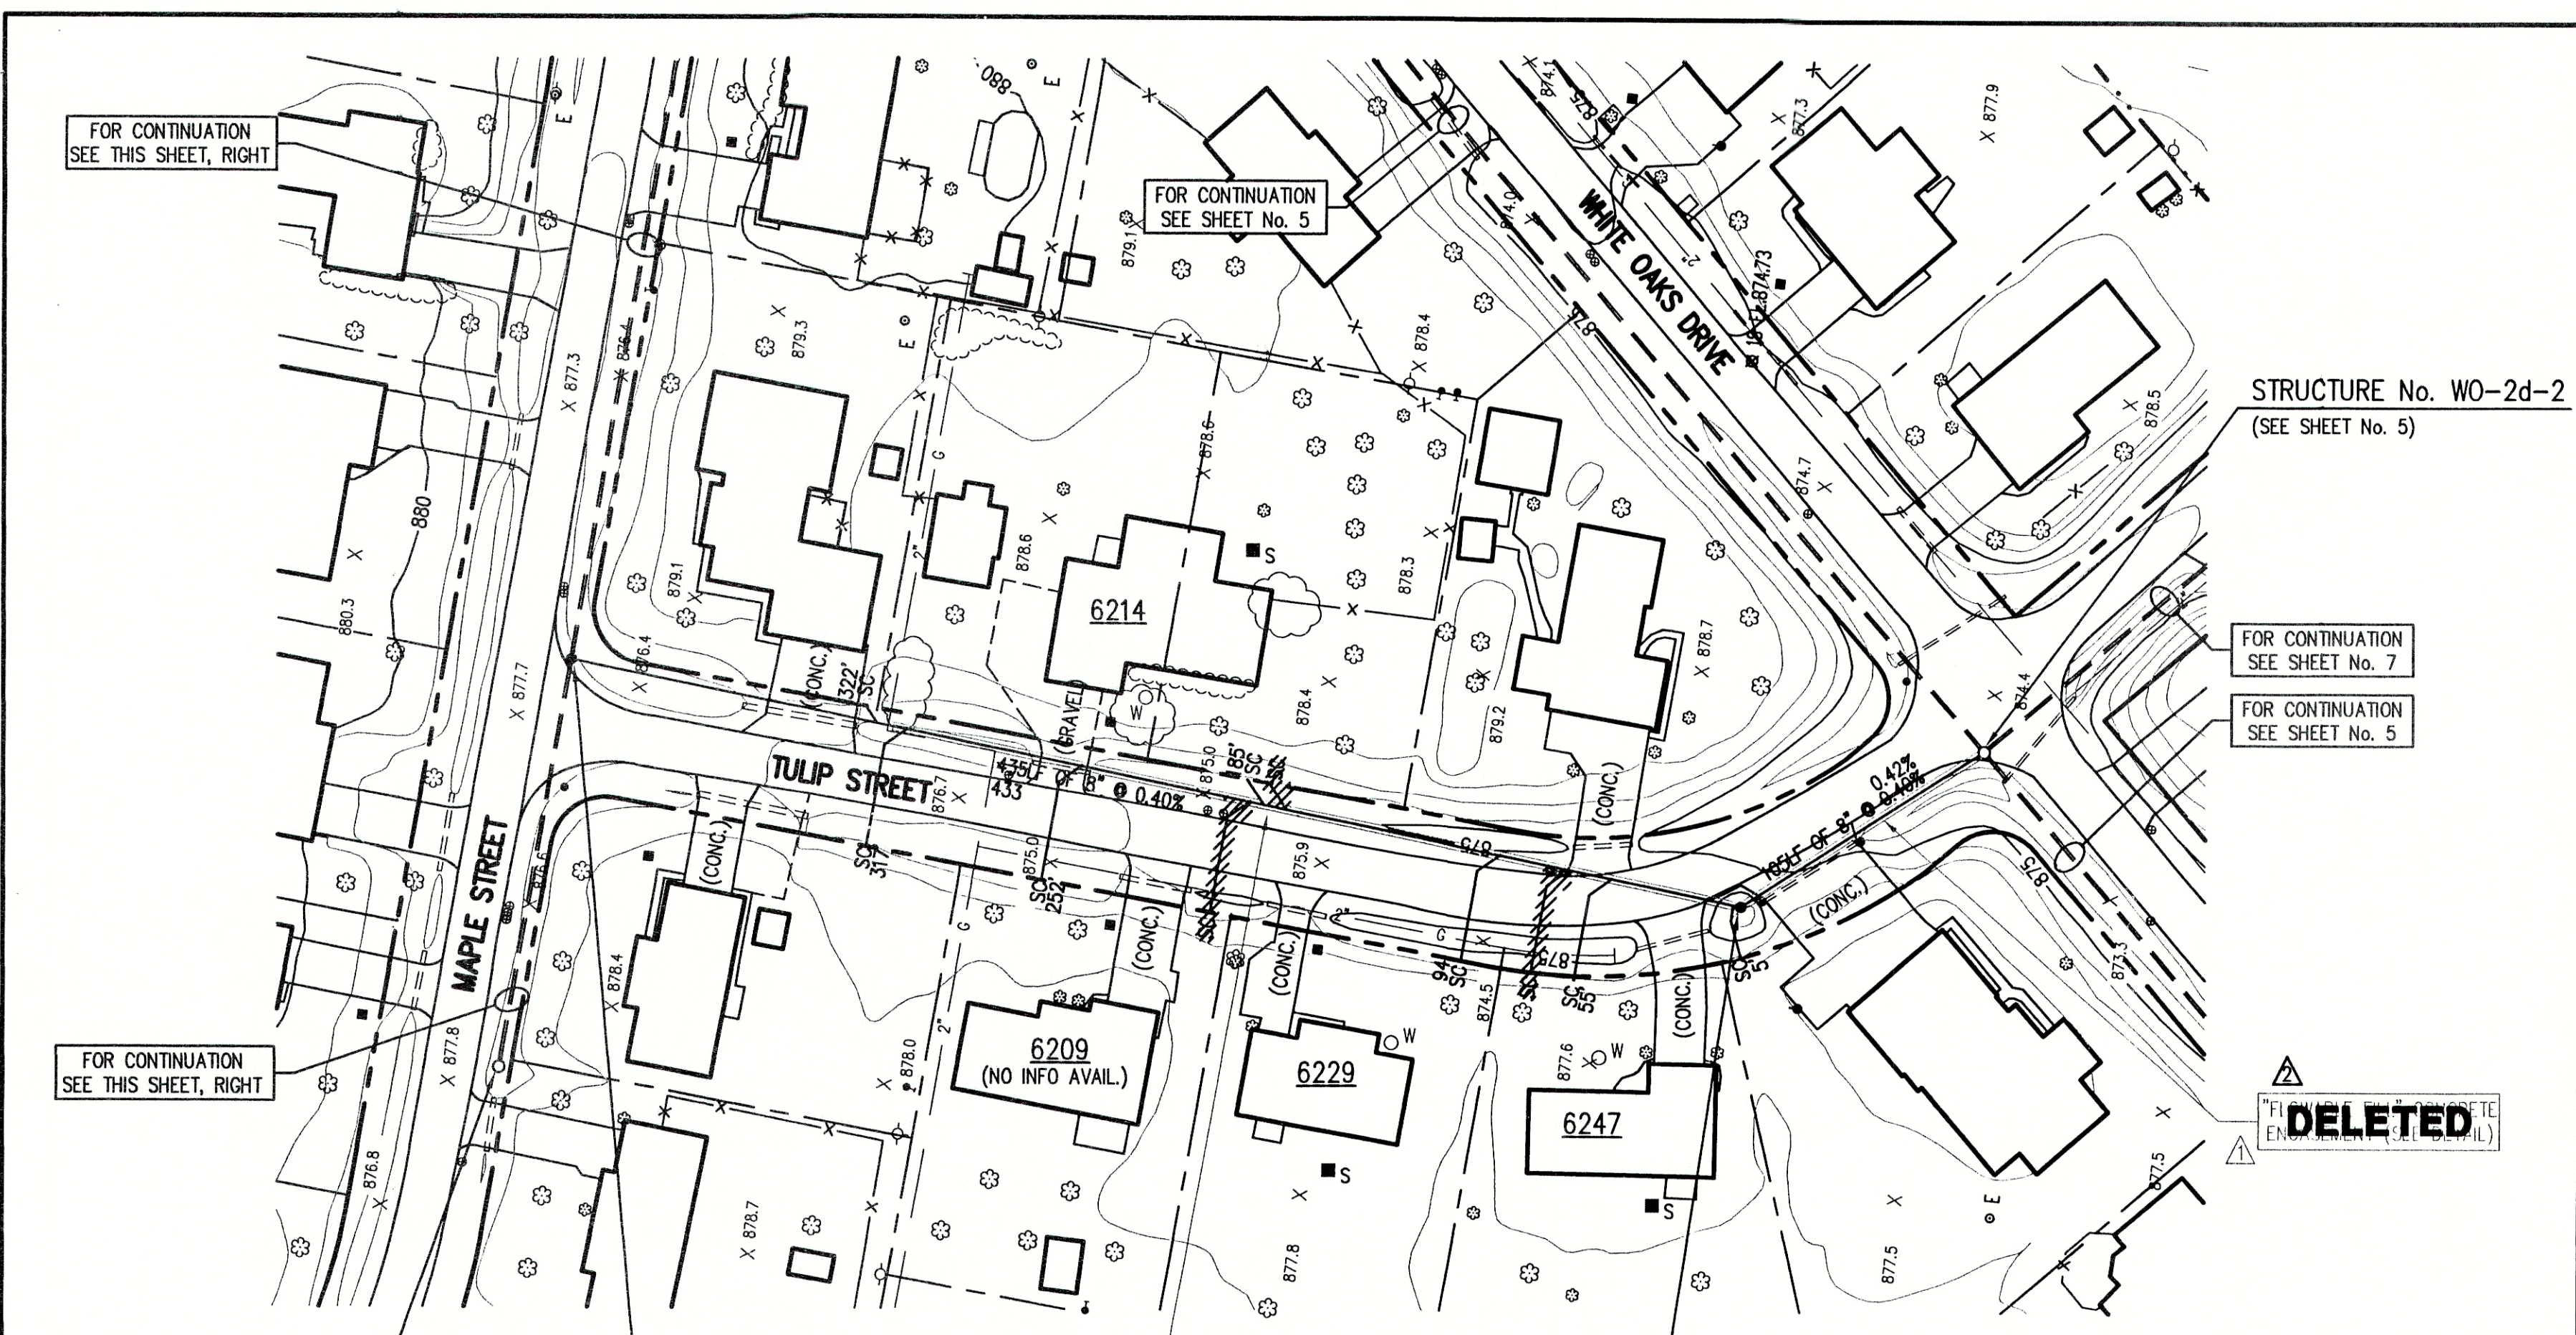

STRUCTURE No. WO-2d-2c1
STANDARD MANHOLE
T.C. = 877.54 877.51
INV.(E&W) = 873.04 870.96 870.94
INV.(S) = 873.02 870.94 870.93

STRUCTURE No. WO-2d-2c
STANDARD MANHOLE
T.C. = 875.44 874.84
INV.(N) = 871.20 869.20 869.19
INV.(SE) = 871.20 869.10 869.09

STRUCTURE No. WO-2d-2b
STANDARD MANHOLE
T.C. = 875.44 874.84
INV.(N) = 871.20 869.20 869.19
INV.(SE) = 871.20 869.10 869.09

STRUCTURE No. WO-2d-2
(SEE SHEET No. 5)


GENERAL NOTES:

- ALL UTILITY LOCATIONS ARE APPROXIMATE. THE CONTRACTOR SHALL HAVE ALL UTILITIES FIELD VERIFIED AND MARKED PRIOR TO CONSTRUCTION.
- CONTRACTOR SHALL MAINTAIN A MINIMUM 10'-0" HORIZONTAL AND 18" VERTICAL SEPARATION BETWEEN SEWER AND WATER MAINS.
- ALL PROPOSED TOP OF CASTING ELEVATIONS ARE APPROXIMATE. THE CONTRACTOR SHALL ADJUST FINAL ELEVATIONS AS REQUIRED TO BE FLUSH WITH PAVEMENT.
- ALL SEWER TRENCHES SHALL BE BACKFILLED WITH FULL DEPTH COMPACTED GRANULAR BACKFILL ("B" BORROW) UNDER OR WITHIN 5' OF EDGE OF PAVEMENT.
- THE CONTRACTOR SHALL VISIT THE SITE PRIOR TO BID TO BECOME FAMILIAR WITH ALL SITE CONDITIONS.
- THE CONTRACTOR SHALL PROVIDE THE REQUIRED MEANS FOR MAINTAINING SAFE TRAFFIC AT ALL TIMES.
- CONTRACTOR SHALL RESTORE ALL DISTURBED LAWN AREAS, STREETS, WALKS, DRIVES, ETC. AS SHOWN ON DRAWINGS, IN THE SPECIFICATIONS, OR TO AT LEAST PRE-EXISTING CONDITIONS.
- ALL UTILITY CROSSINGS SHALL BE PROTECTED AND SUPPORTED WITH GRANULAR FILL OR CONCRETE AS REQUIRED PER THE DETAIL SHEET.

NOTE: CONTRACTOR TO VERIFY ALL UTILITY LOCATIONS PRIOR TO THE START OF CONSTRUCTION

PER INDIANA STATE LAW IS-69-1991, IT IS AGAINST THE LAW TO EXCAVATE WITHOUT NOTIFYING THE UNDERGROUND LOCATION SERVICE TWO (2) WORKING DAYS BEFORE COMMENCING WORK.


NOTE: CONTRACTOR TO VERIFY ALL UTILITY LOCATIONS PRIOR TO THE START OF CONSTRUCTION

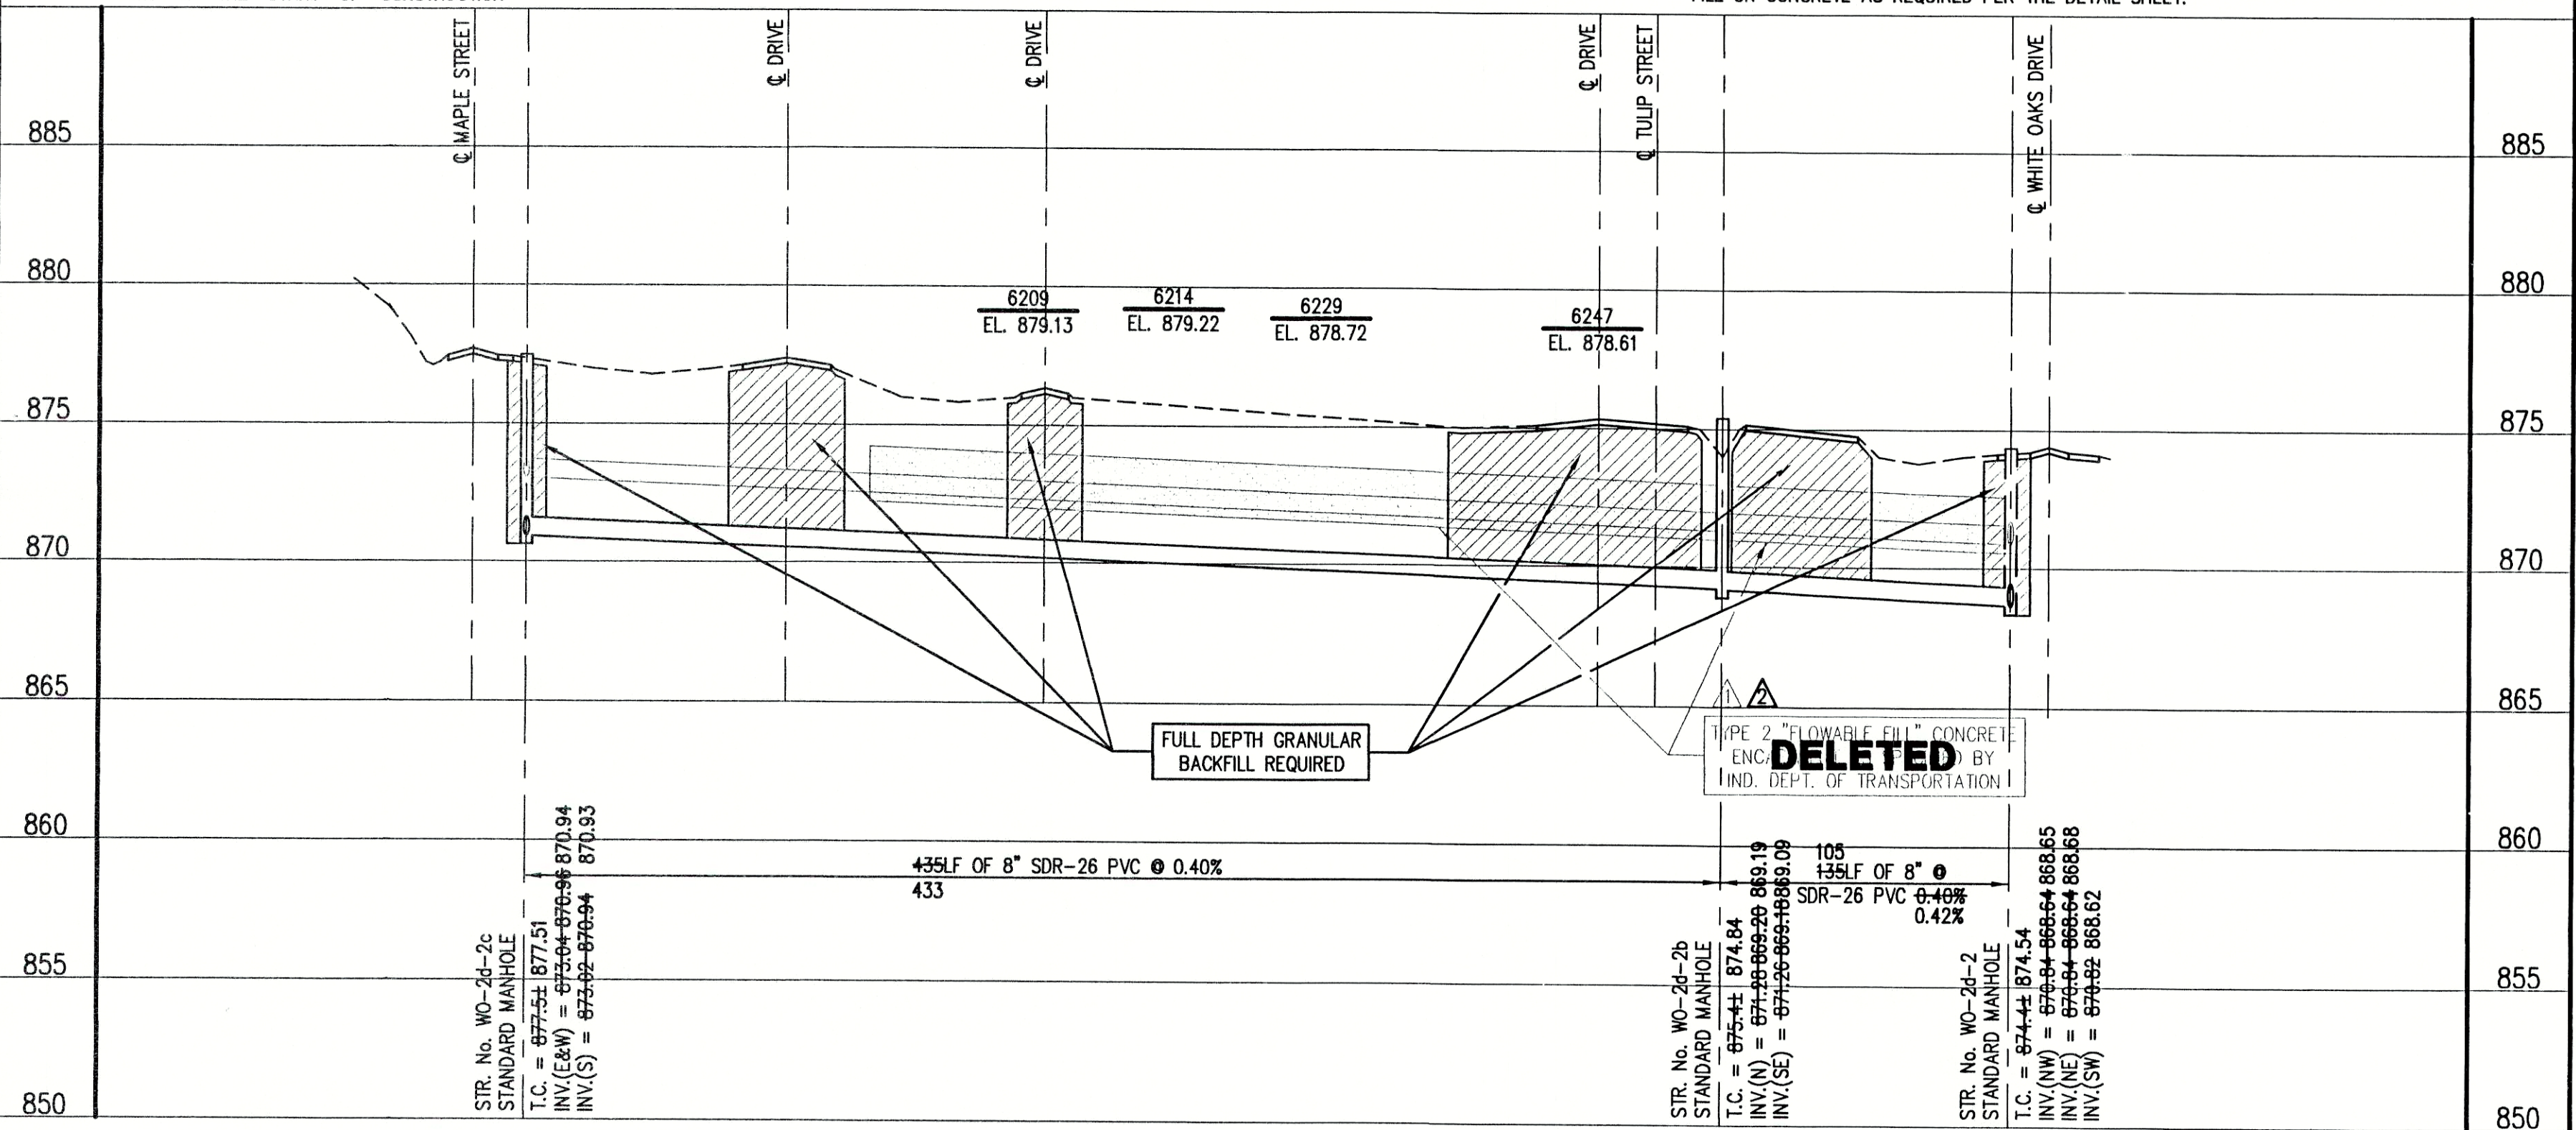

RECORD DRAWING

February 15, 2001

NOTE:
THE CONTRACTOR SHALL INCLUDE IN THE COSTS FOR SANITARY PIPE, ALL WATER SERVICE RECONNECTIONS, STORM SEWER RECONNECTION, WATER MAIN RELOCATIONS, CONCRETE RECONSTRUCTION, AND SIDEWALK RECONSTRUCTION AS REQUIRED TO INSTALL NEW WORK AS SHOWN ON THE DRAWINGS.

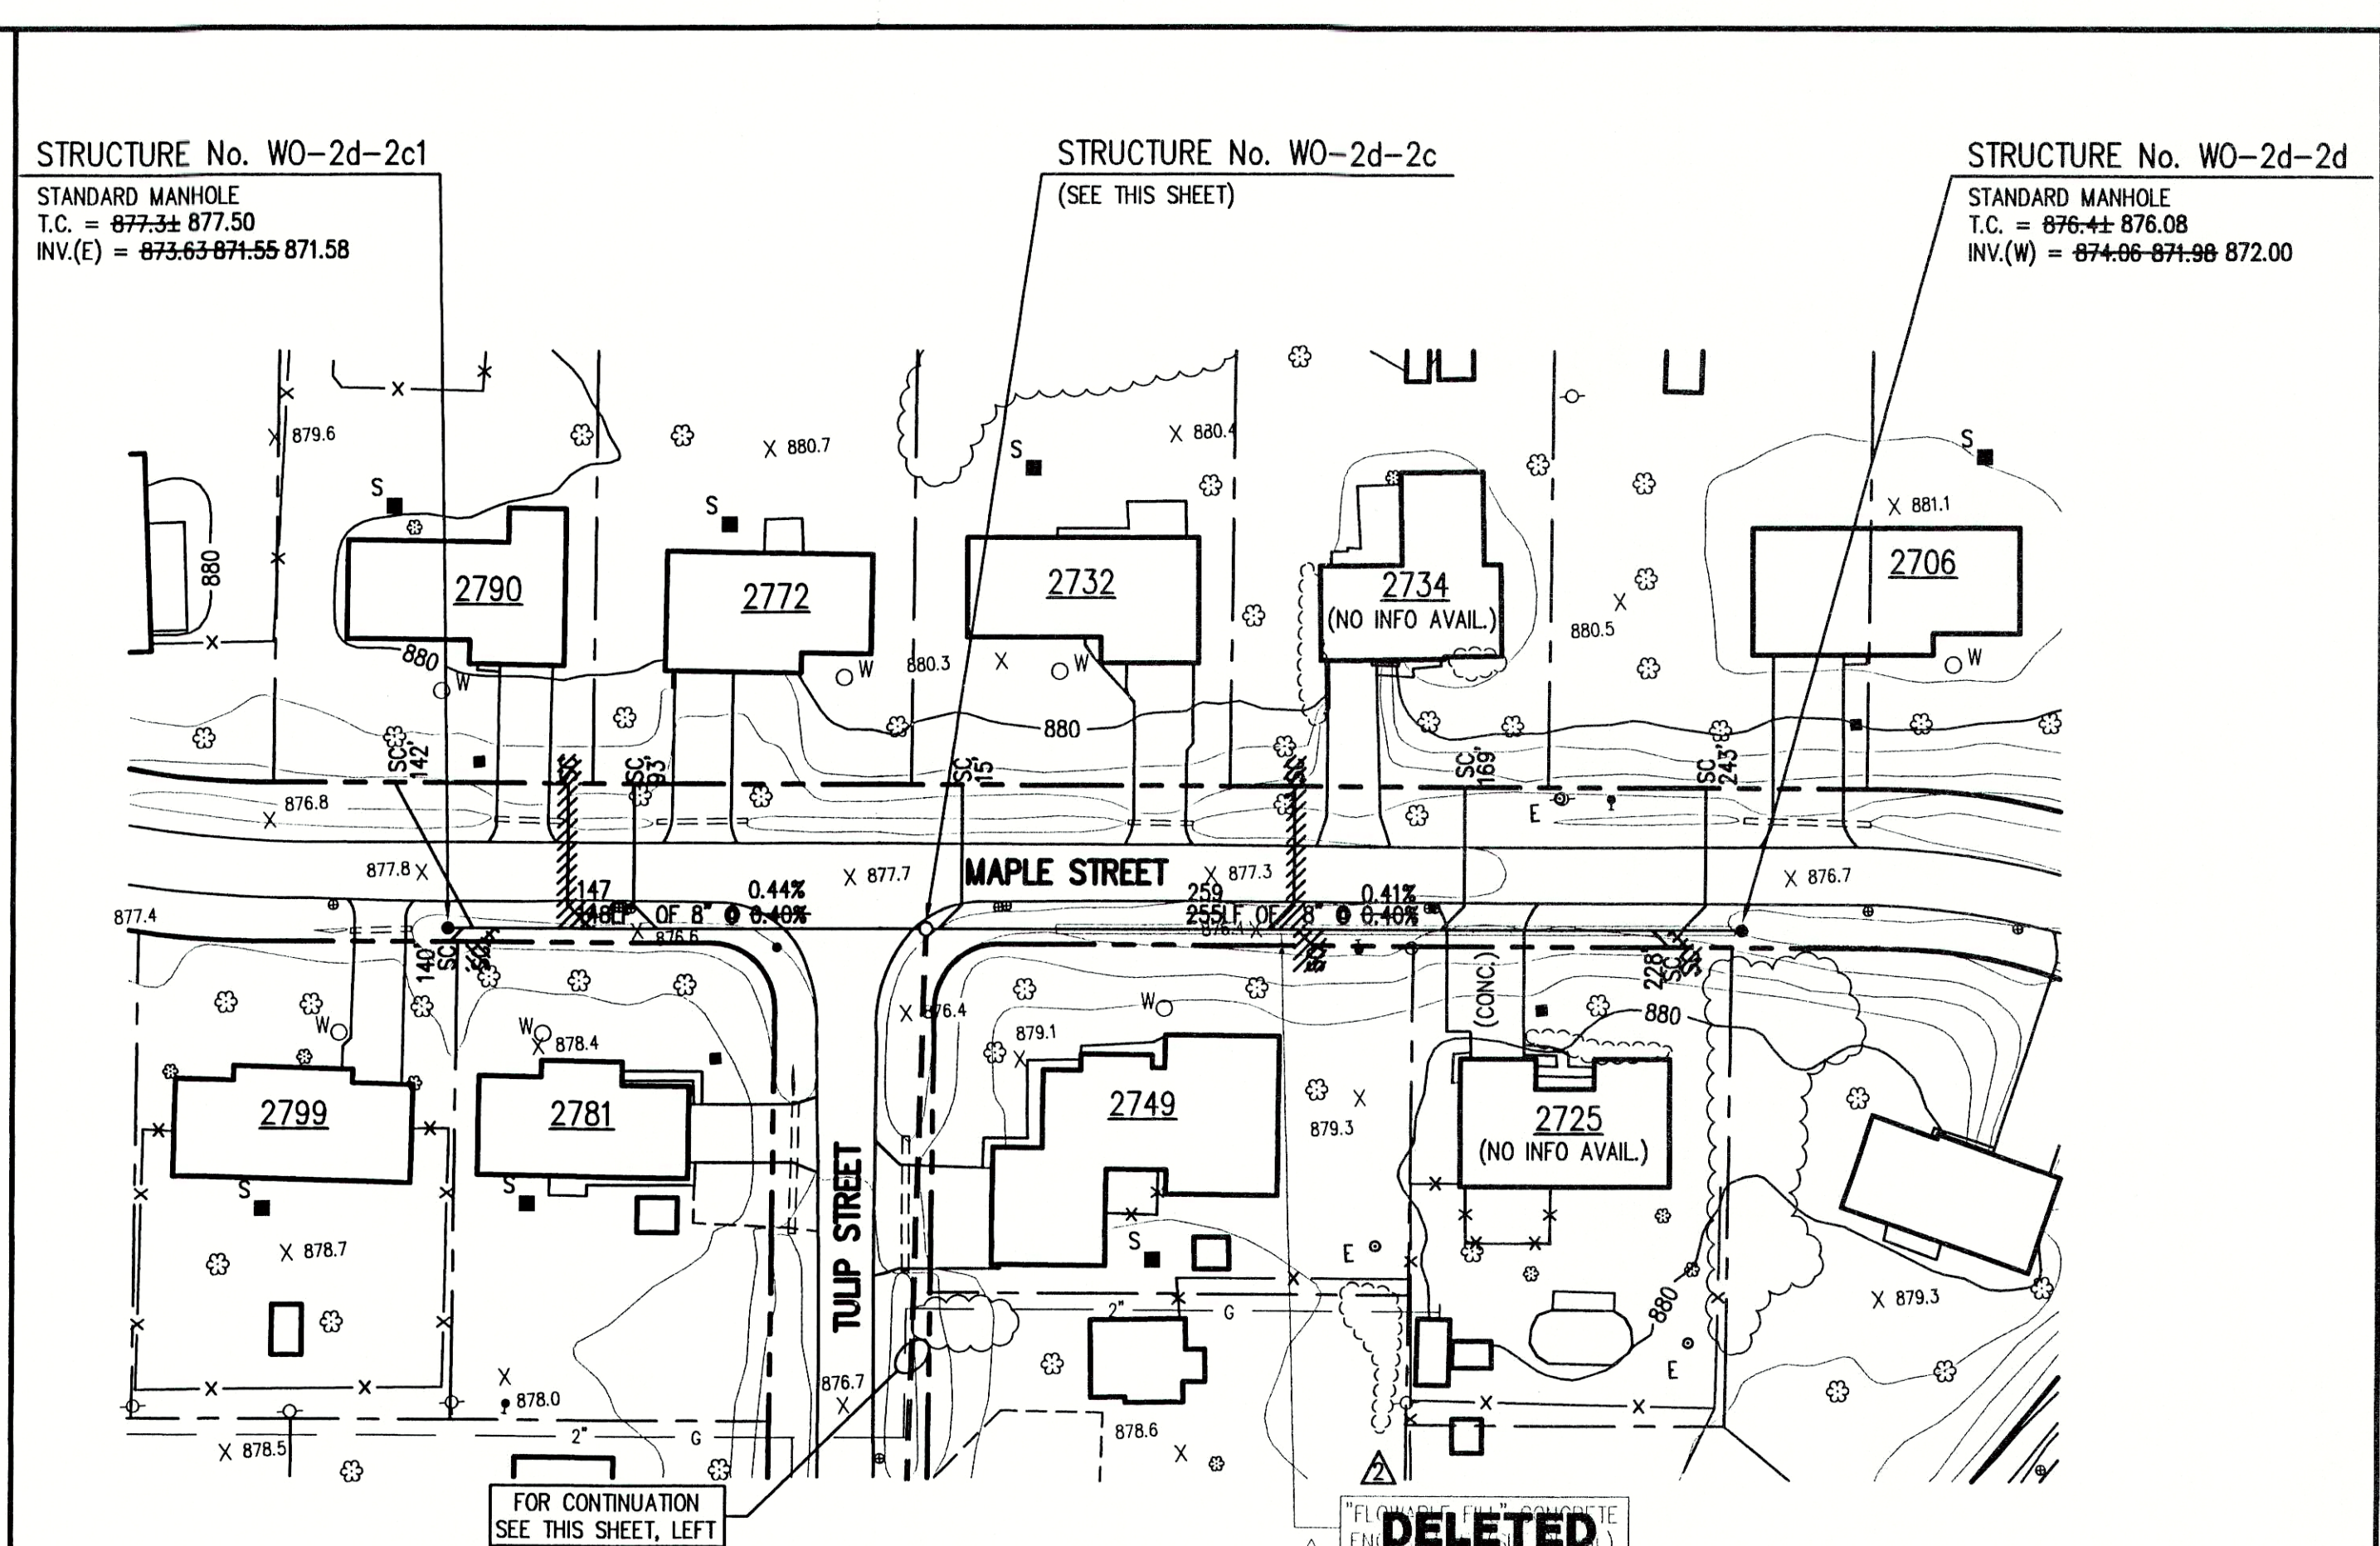

STRUCTURE No. WO-2d-2c1
STANDARD MANHOLE
T.C. = 877.54 877.51
INV.(E) = 873.04 871.55 871.58


STRUCTURE No. WO-2d-2c
(SEE THIS SHEET)

STRUCTURE No. WO-2d-2d
STANDARD MANHOLE
T.C. = 876.44 876.08
INV.(W) = 874.06 871.98 872.00

LEGEND:

- TREE
- POWER POLE
- GUY WIRE
- FIRE HYDRANT
- MAILBOX
- FLAGPOLE
- SPOT SHOT
- CONTOUR
- FENCE
- EXIST. SANITARY SEWER w/ MANHOLE
- NEW SANITARY SEWER w/ MANHOLE
- NEW SANITARY SERVICE CONNECTION
- WATER LINE
- GAS LINE
- UNDERGROUND ELECTRIC LINE
- UNDERGROUND TELEPHONE LINE
- APPROX. RIGHT-OF-WAY
- APPROX. CORPORATE LIMITS
- APPROX. PROPERTY LINE
- EXISTING WATER WELL
- EXISTING SEPTIC TANK

SCALE:
HORIZONTAL 1" = 50'
VERTICAL 1" = 5'

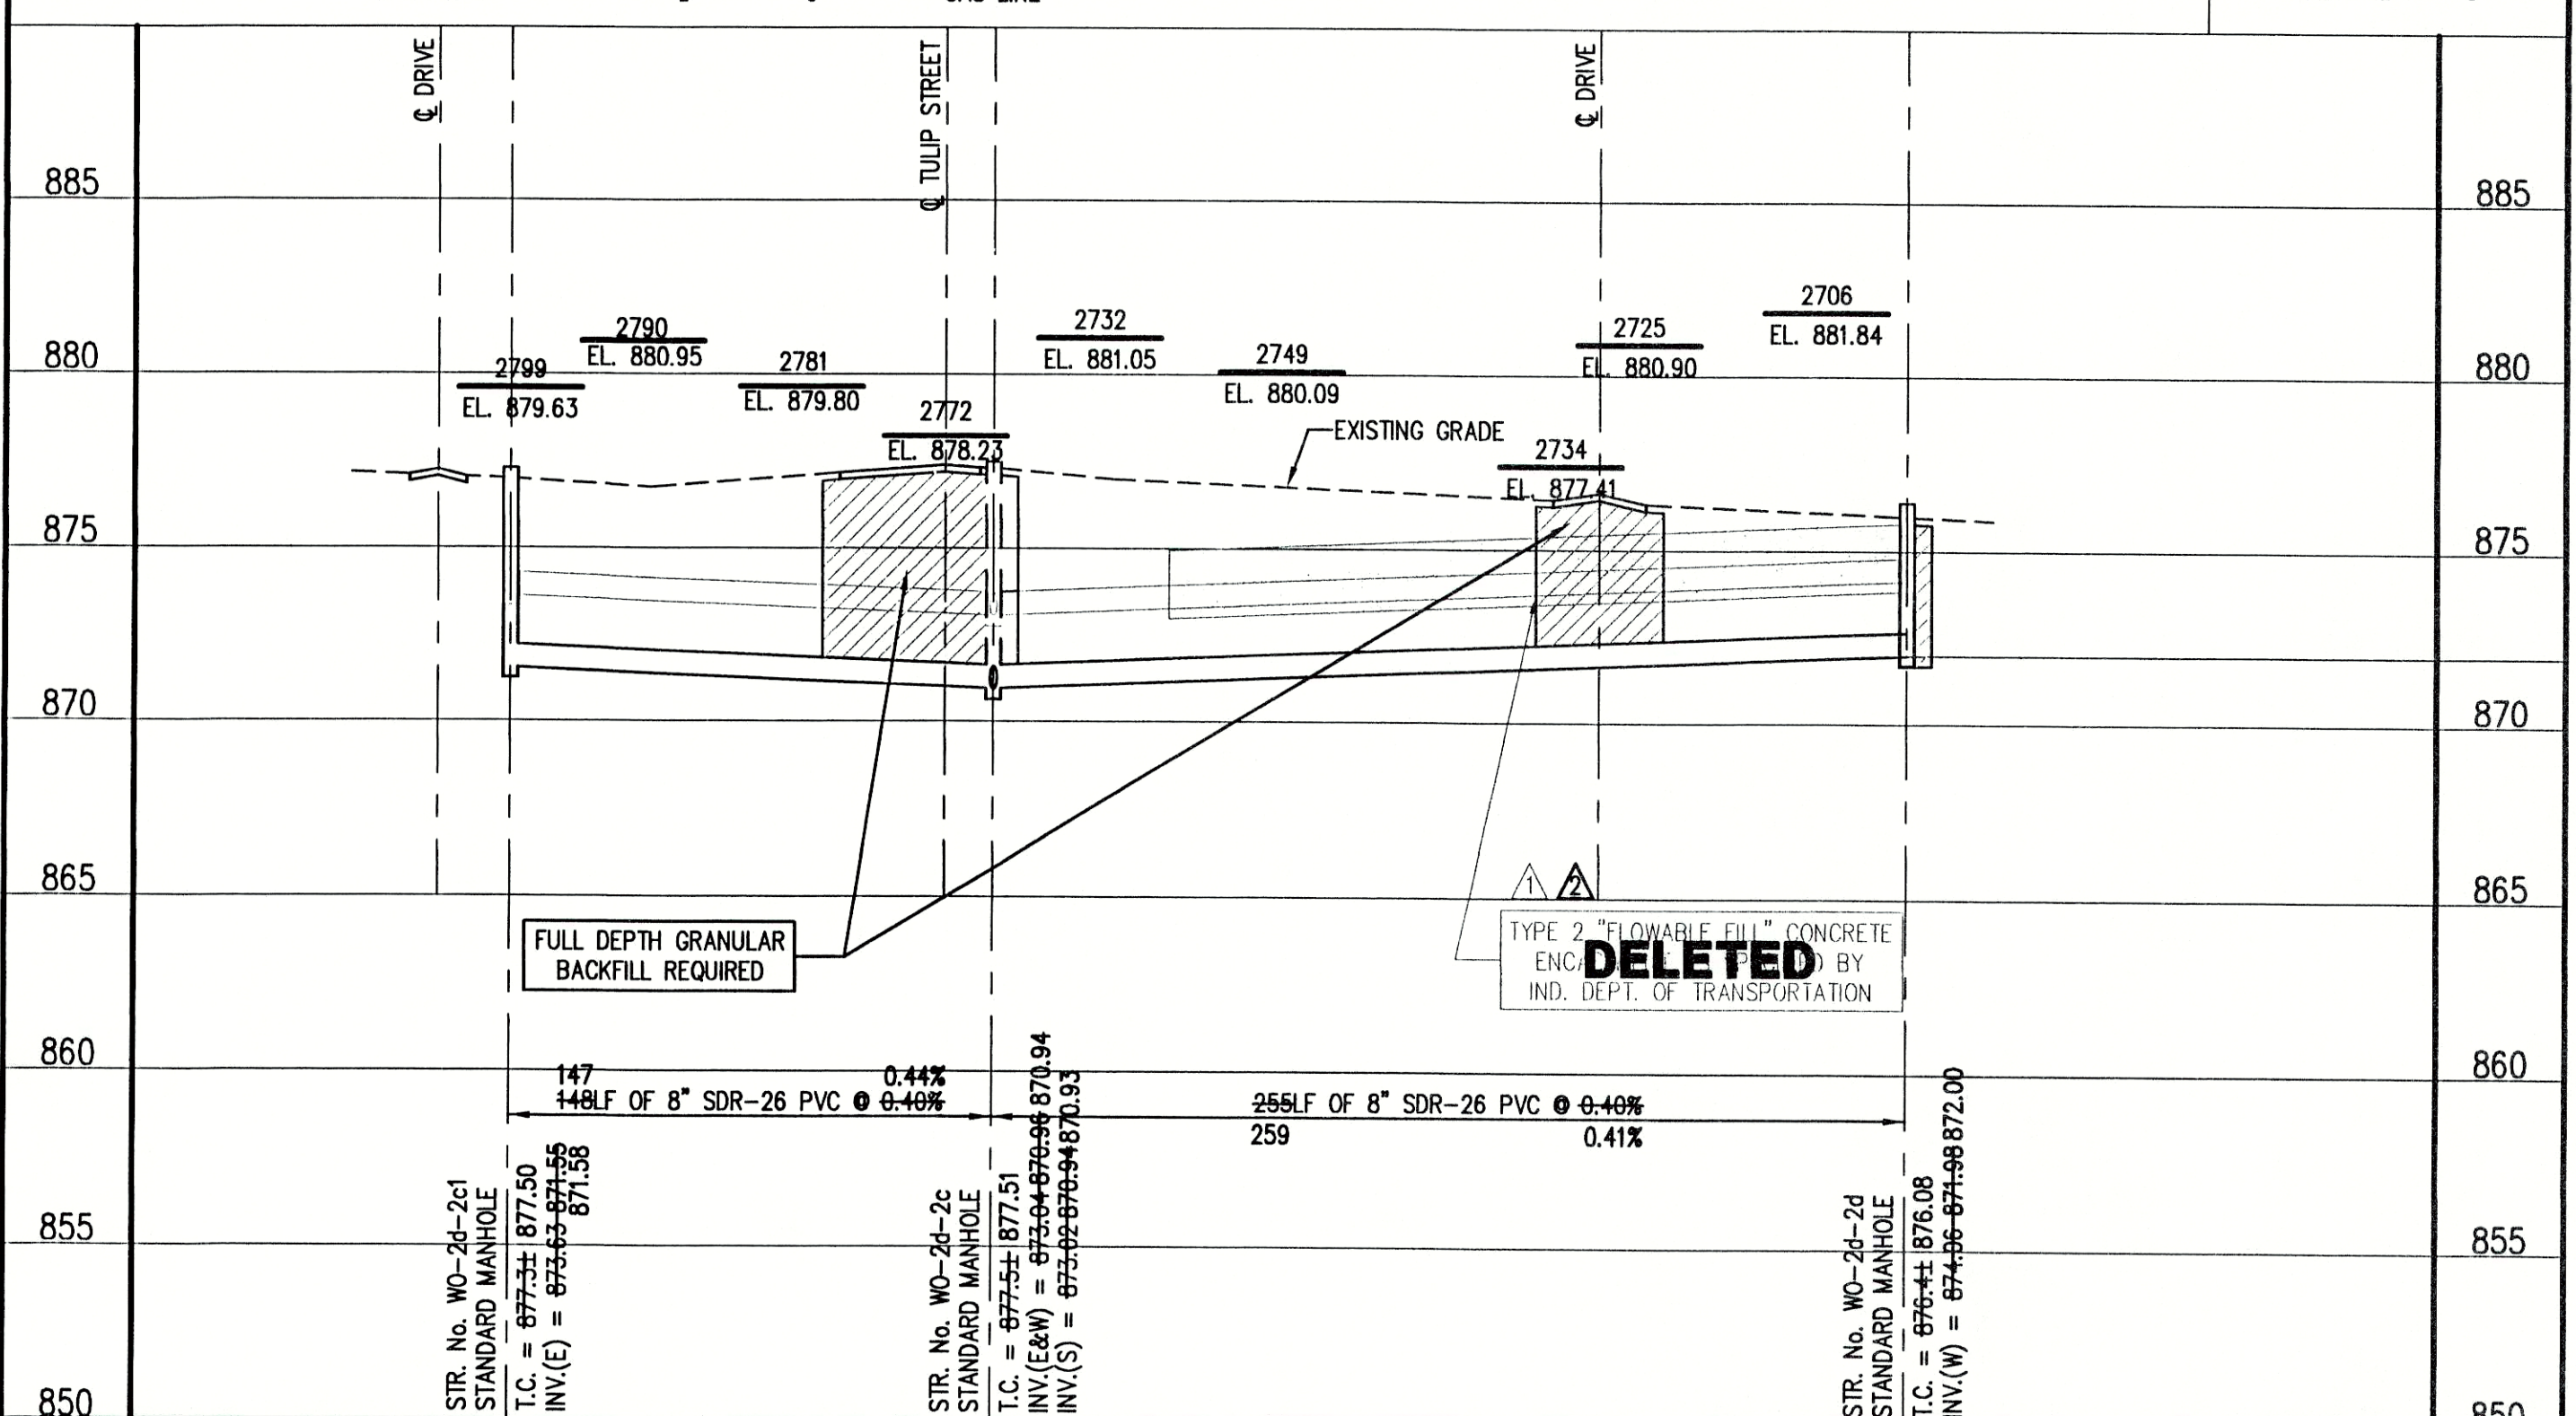

FILE NAME: WHITOK_9R2-RD PLOT SCALE: 1"=50' PLOT DATE: 12/3		APPROVED BY: THOMAS M. SCHUBERT, P.E.	
12/29/99	ADDED CONCRETE ENCASUREMENT	D.A.P.	
07/26/00	REMOVED CONCRETE ENCASUREMENT	D.A.P.	
NO. DATE DESCRIPTION BY		INDIANAPOLIS, INDIANA	

TRIAD ASSOCIATES INC.

INDIANAPOLIS, INDIANA

WHITE OAKS SUBDIVISION
FALL CREEK REGIONAL WASTE DISTRICT

PLAN AND PROFILE

DESIGNED BY: D.A. Pauling
CHECKED BY: James W. Frazell, P.E.