


GR. ELEV. 990±
MAX. STATIC PRES. 73 PSI

GR. ELEV. 990±
MAX. STATIC PRES. 73 PSI


SPADES ROAD

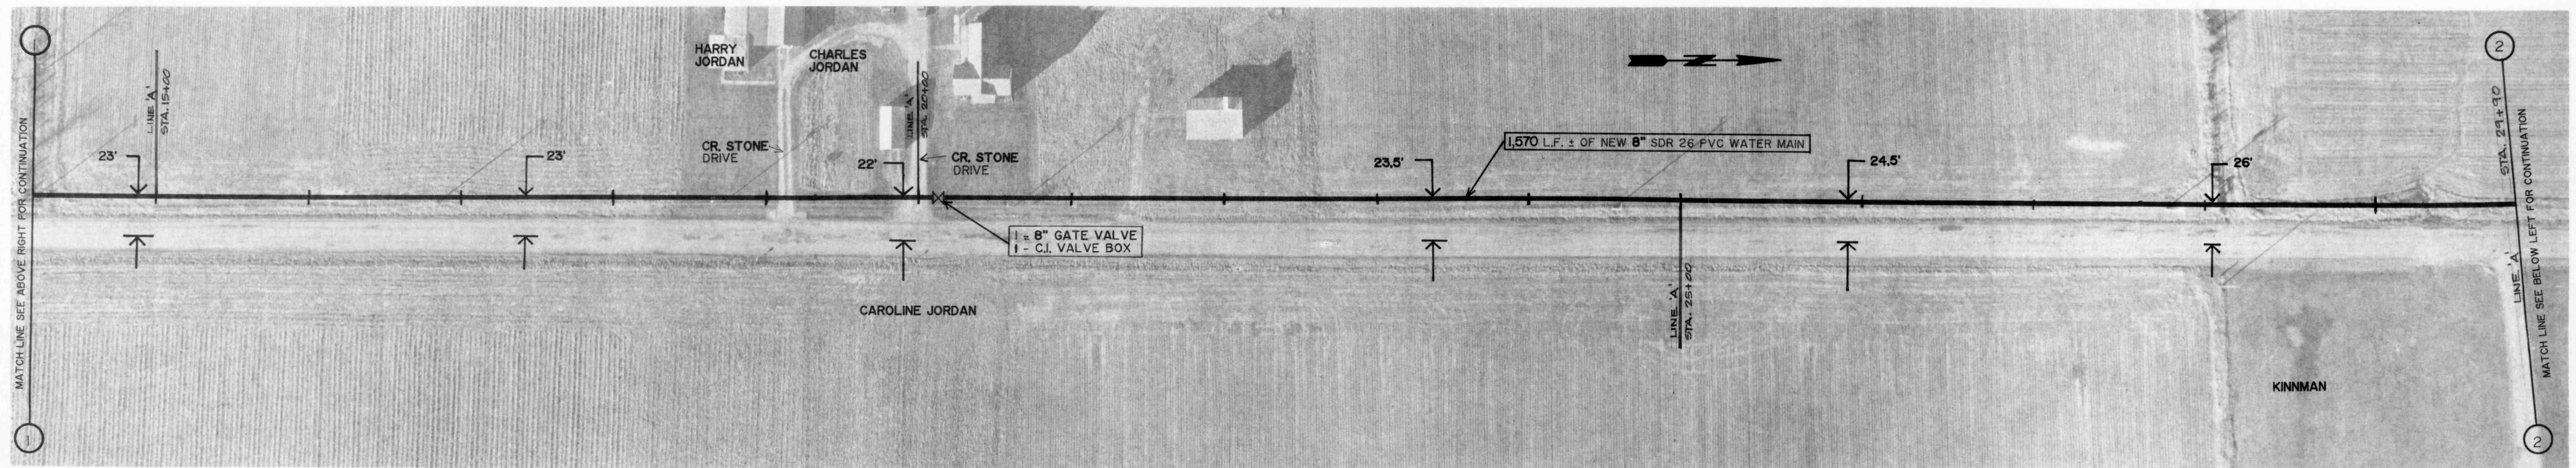

GR. ELEV. 990±
MAX. STATIC PRES. 73 PSI

GR. ELEV. 990±
MAX. STATIC PRES. 73 PSI

SPADES ROAD

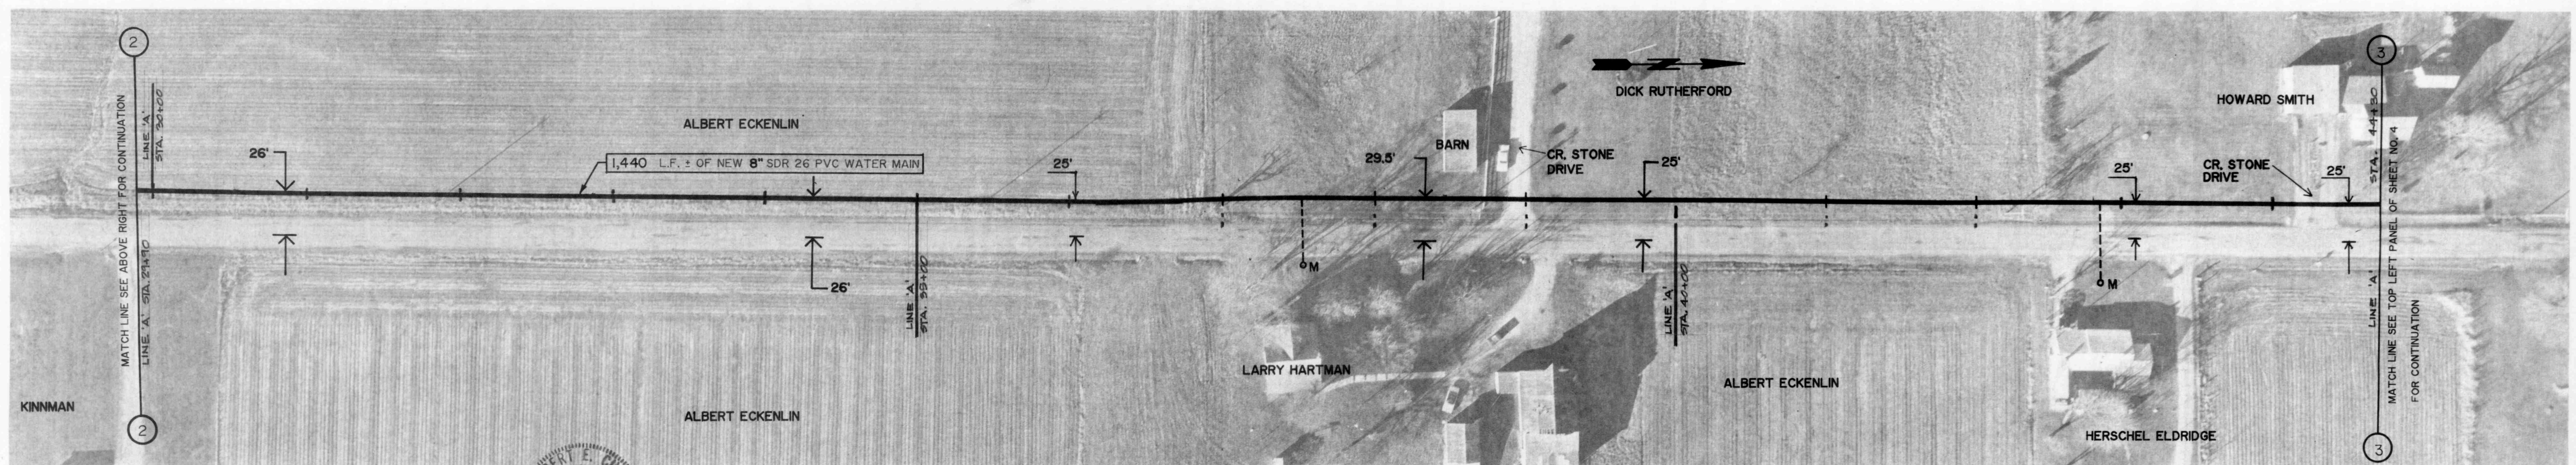

GR. ELEV. 990±
MAX. STATIC PRES. 73 PSI

GR. ELEV. 990±
MAX. STATIC PRES. 73 PSI

SPADES ROAD



AS BUILT 10-17-88

REV. 10-17-88	DRAWN BY DATE CERTIFIED BY DATE	ROBERT E. CURRY & ASSOCIATES, INC. CONSULTING ENGINEERS 3346 AVON ROAD PLAINFIELD, INDIANA 46168	ELROD WATER COMPANY, INC. RIPLEY COUNTY, INDIANA	WATER MAIN EXTENSIONS TO COMMUNITIES OF CLINTON, SPADES & MORRIS	JOB NO. SCALE 1" = 50' SHT. 3 OF 24
----------------------	--	---	---	---	--